



AS-BUILT

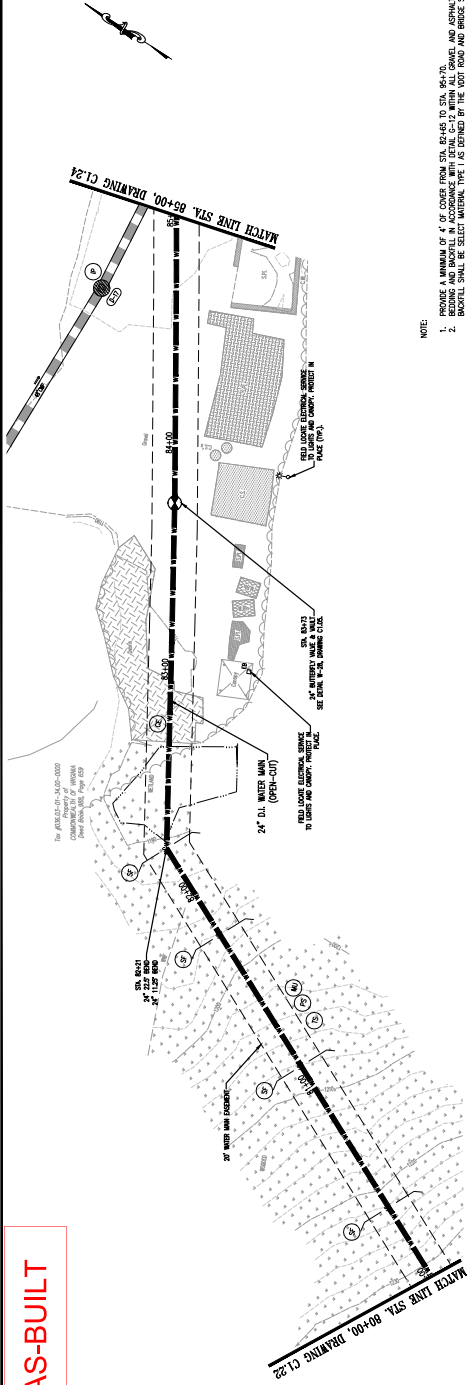

NOTES

1. PROVIDE A MINIMUM OF 4' OF COVER FROM STA. 84+00 TO STA. 84+70.
2. BOWTIE SHALL BE SELECT MATERIAL TYPE 1 AS DEFINED BY THE VDOT ROAD AND BRIDGE SPECIFICATIONS.

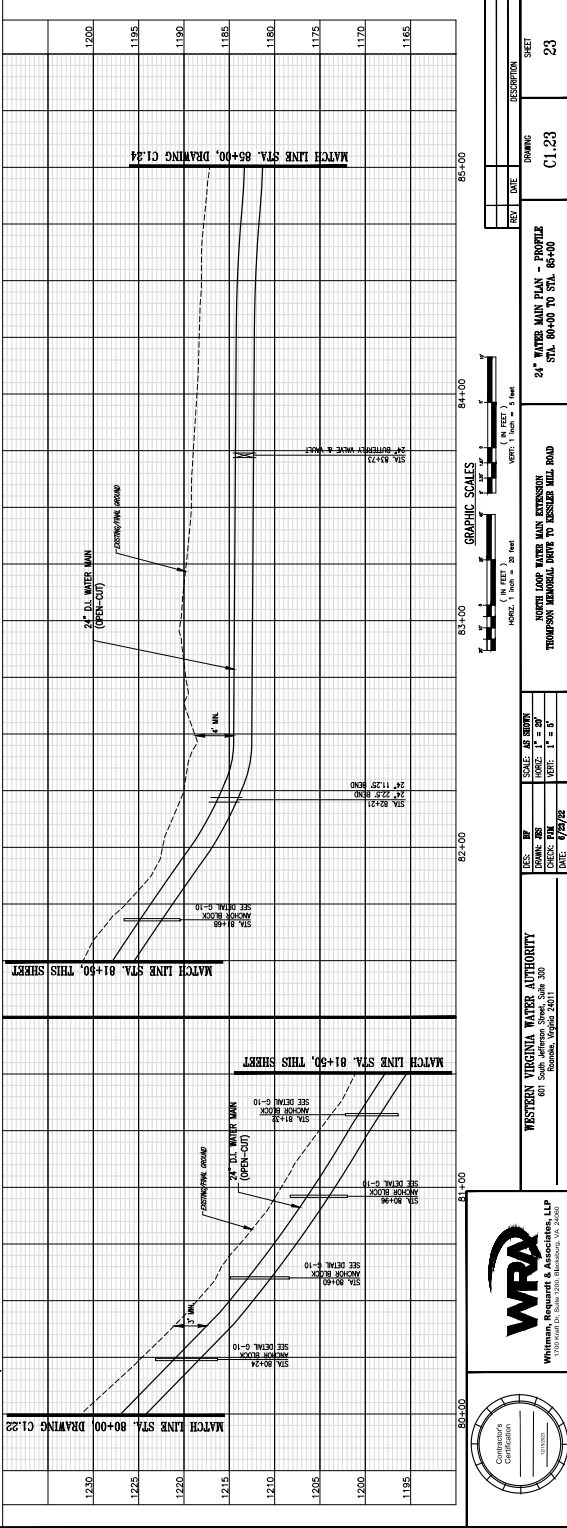

Western Virginia Water Authority  
601 South Jefferson Street, Suite 300  
Roanoke, Virginia 24011

DES. BY SCALE: AS SHOWN  
DRAWN BY HORIZ. 1" = 80'  
CHECKED BY VERT. 1" = 5'  
DATE: 12/28/21

NORTH LOOK WATER MAIN EXTENSION  
THOMPSON MEMORIAL PARK TO KESSLER HILL ROAD

24" WATER MAIN PLAN - PROFILE  
STA. 80+00 TO STA. 85+00

DRAWING C1.23  
SHEET 23