


AS-BUILT



- NOTE:
1. THE WATER MAIN SHALL BE 24\"/>
  2. THE WATER MAIN SHALL BE 24\"/>

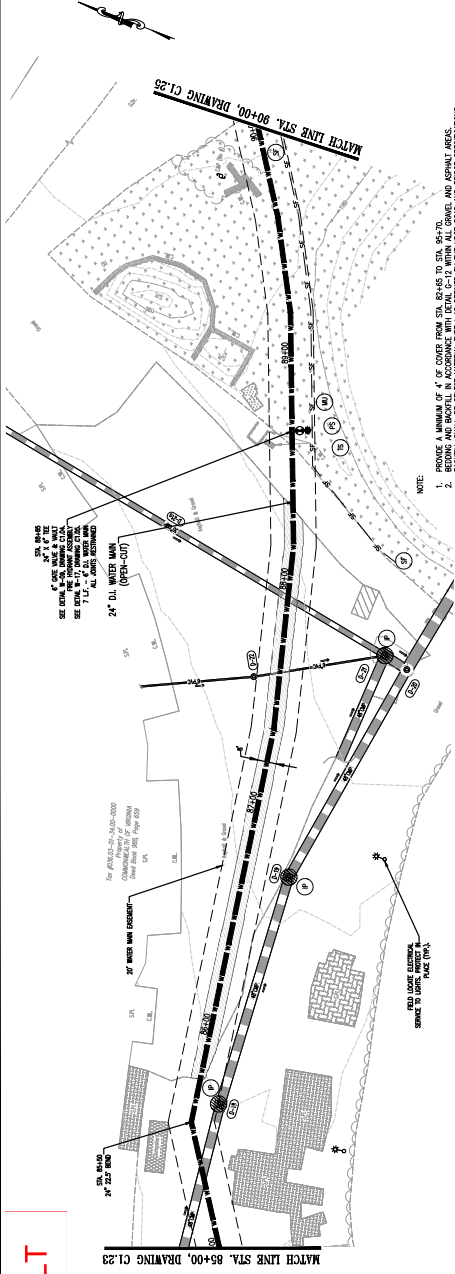