



AS-BUILT

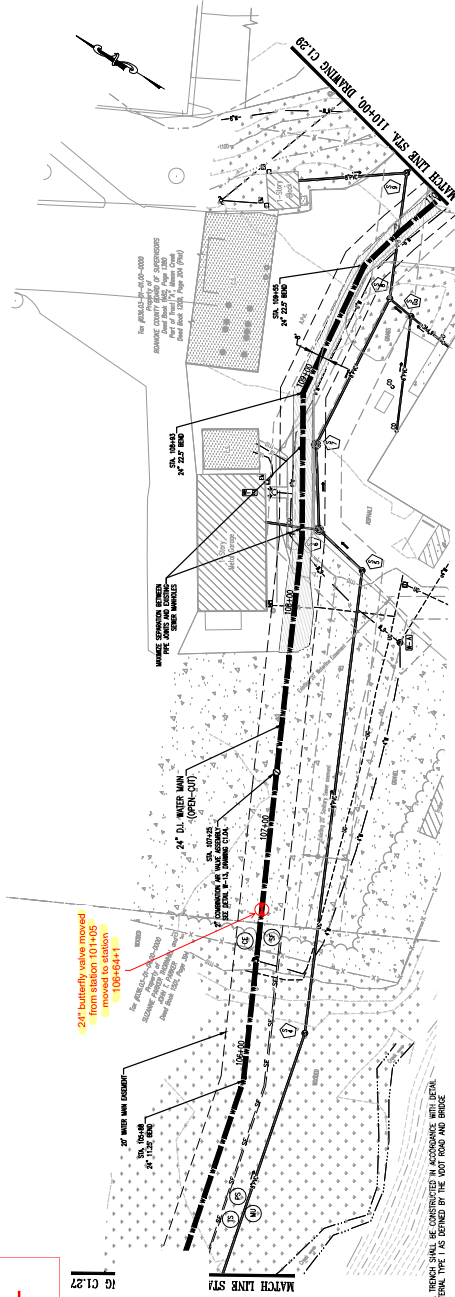

NOTE:  
1. ALL CHANGES AND REVISIONS SHALL BE INDICATED BY A RED LINE OR A RED CIRCLE. ALL CHANGES SHALL BE INDICATED BY A RED LINE OR A RED CIRCLE. ALL CHANGES SHALL BE INDICATED BY A RED LINE OR A RED CIRCLE.

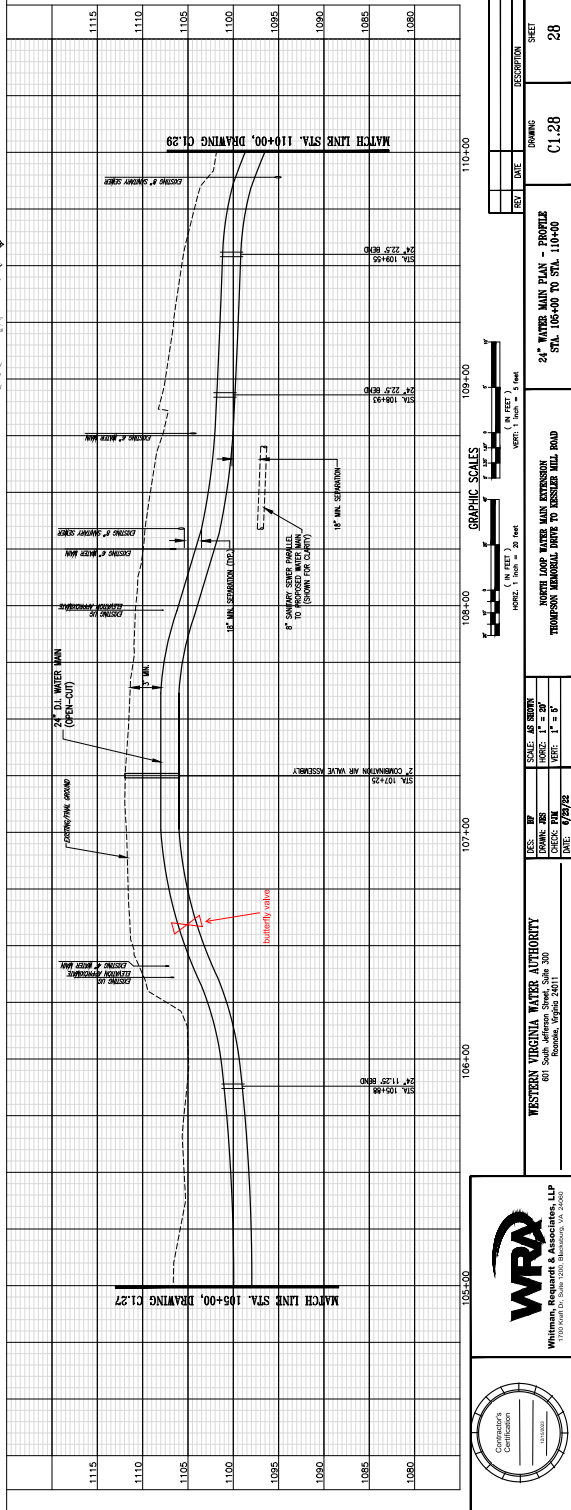

Western Virginia Water Authority  
607 South Jefferson Street, Suite 300  
Roanoke, Virginia 24011

Whitman, Beckwith & Associates, LLP  
1700 North Du Sable Road, Suite 100, Blacksburg, VA 24060

DES. BY: [Redacted]  
DRAWN BY: [Redacted]  
CHECKED BY: [Redacted]  
DATE: 6/28/23

SCALE: AS SHOWN  
HORIZ. 1" = 50'  
VERT. 1" = 5'

24" WATER MAIN PLAN - PROFILE  
STL 106+00 TO STL 110+00

DATE: [Redacted]  
DRAWING: C1.28  
SHEET: 28