


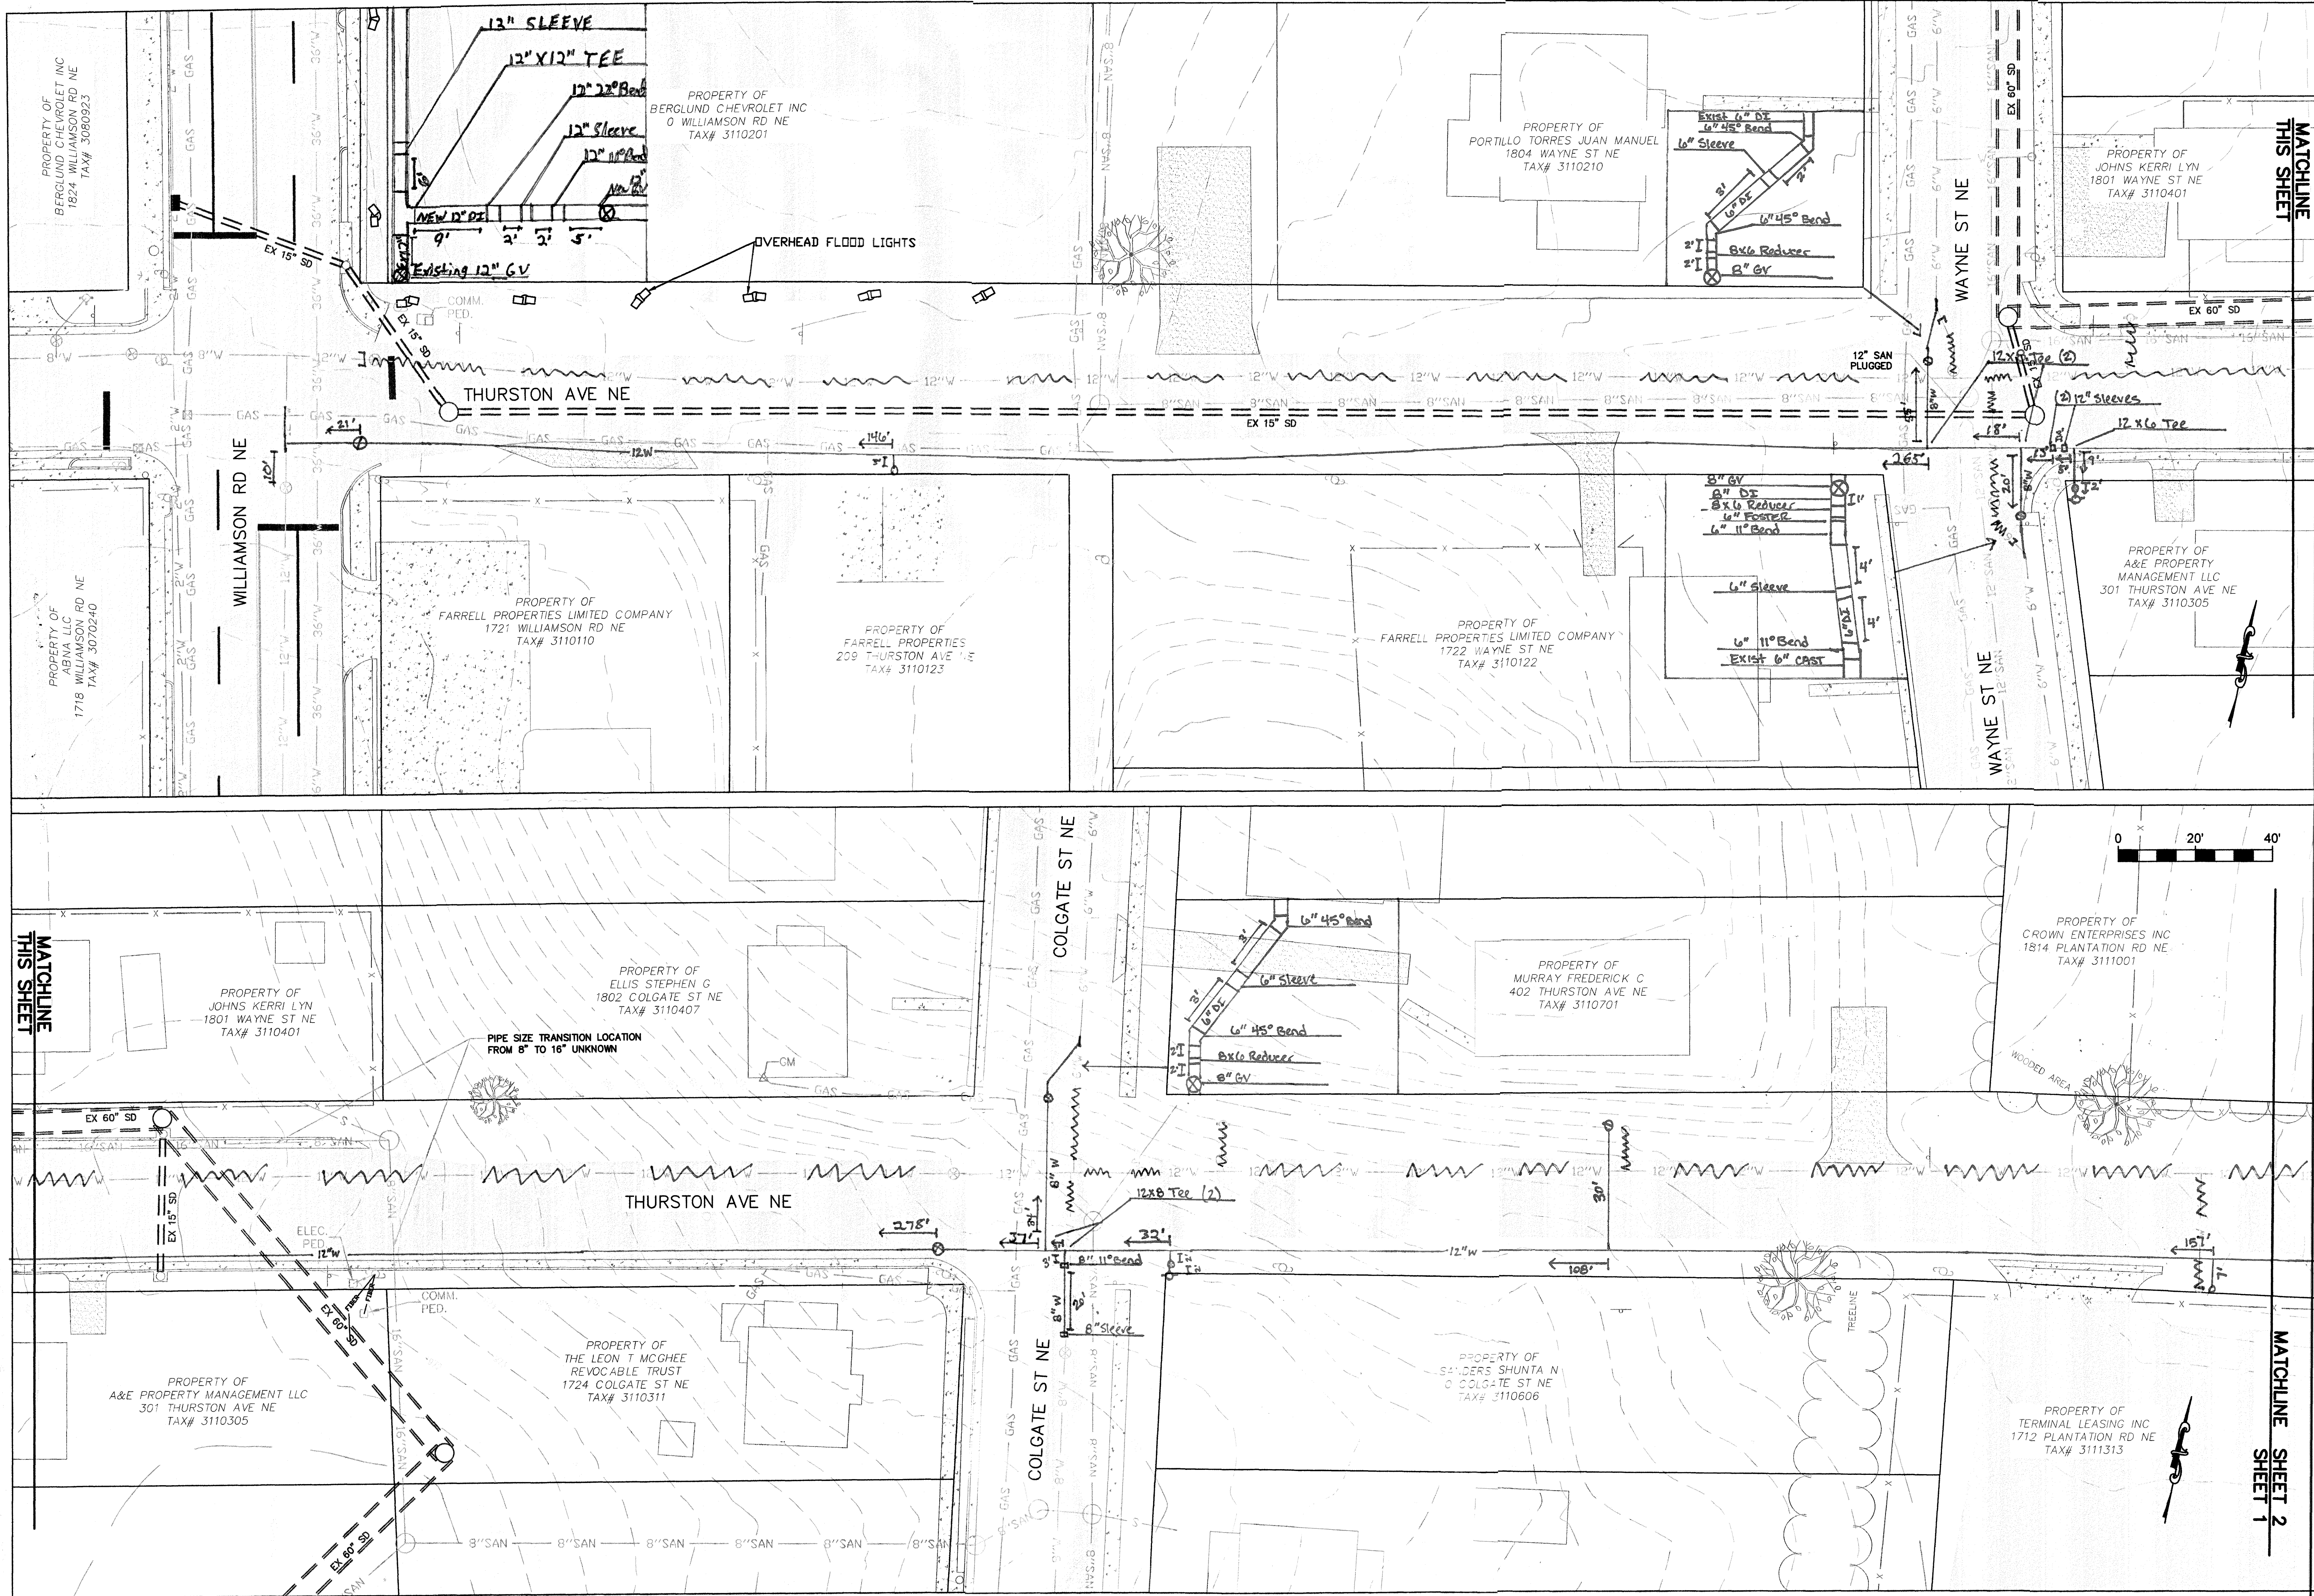

WATER AUTHORITY

ENGINEERING SERVICES
601 S JEFFERSON ST, SUITE 300
ROANOKE, VA 24011
540-853-5700

PRELIMINARY
(NOT FOR CONSTRUCTION)

BASEMAP

No.	Description	Date	By
1	Construction Completed	11/14/24	RC
2	Redline	11/14/24	RC

Matchline
THIS SHEET

Matchline
SHEET 2
SHEET 1

THURSTON AVE NE 12"
WATERLINE REPLACEMENT

BASEMAP

Designed: WWA- RC

Drawn: NSS

Checked: AJC

Approved:

Date: FY-25 PAVING

Project: WCIP-459

1
Sheet 1 of 2