


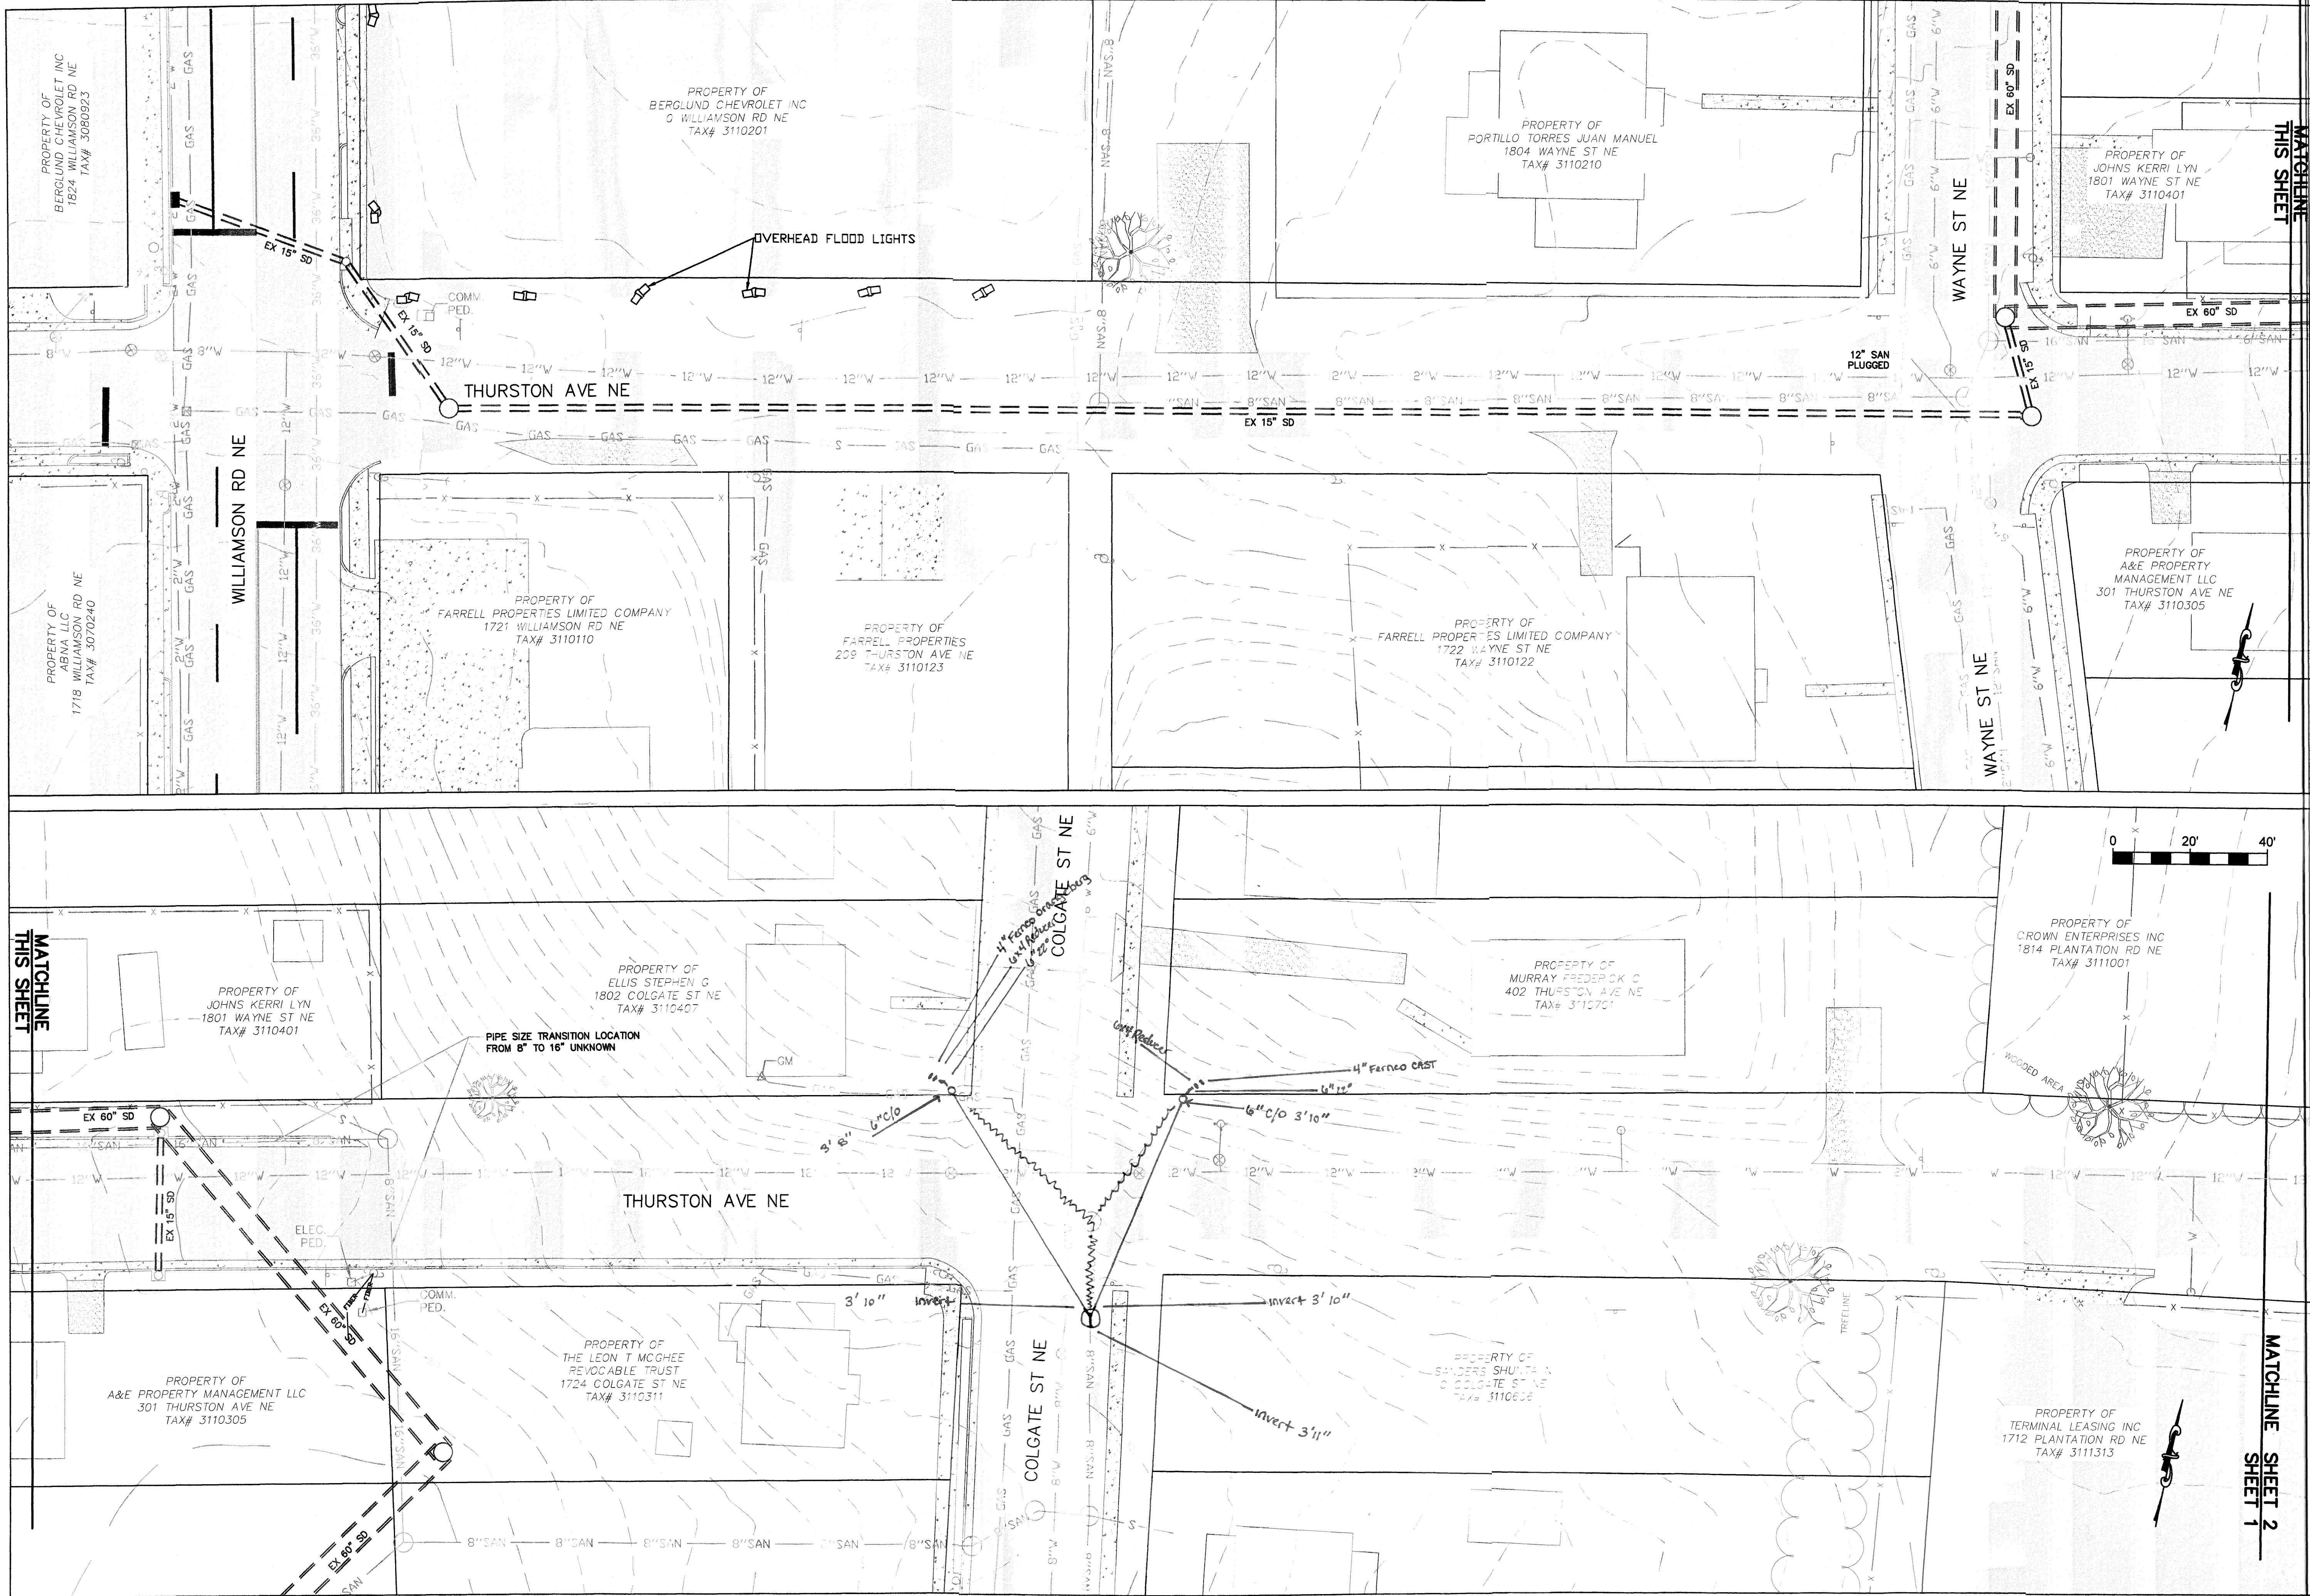

WATER AUTHORITY
ENGINEERING SERVICES
601 S JEFFERSON ST, SUITE 300
ROANOKE, VA 24011
540-853-5700

PRELIMINARY
(NOT FOR CONSTRUCTION)

THURSTON AVE NE 12"
WATERLINE REPLACEMENT
BASEMAP

No.	Description	Date	By
1	Construction Completed	10/5/24	RC
2	Red line	11/14/24	RC

Designed: ~~WVA~~ RC
Drawn: NSS
Checked: AJC
Approved:
Date: FY-25 PAVING
Project: WCIP-459

1
Sheet 1 of 2