

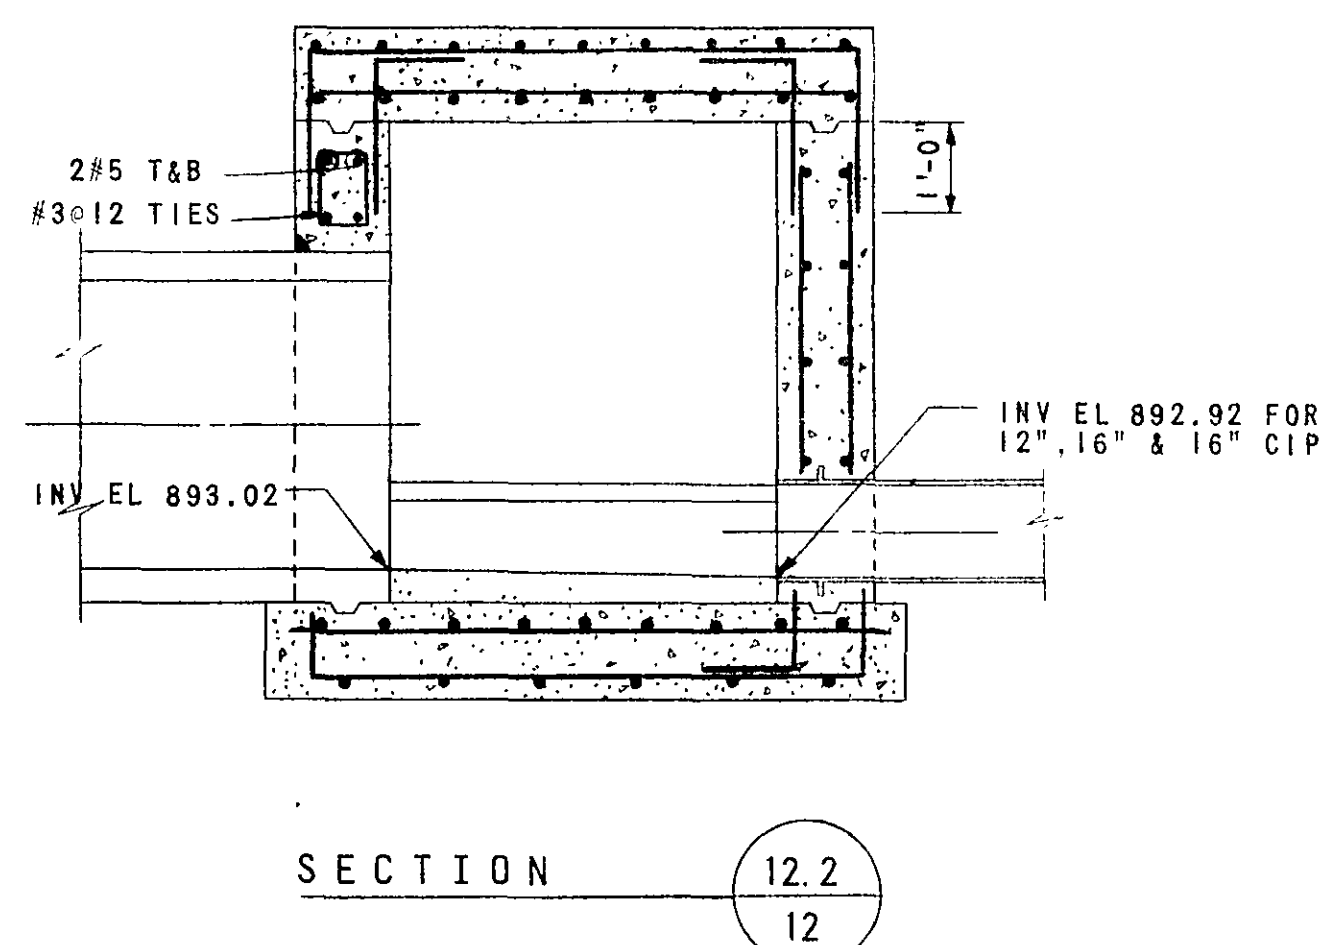
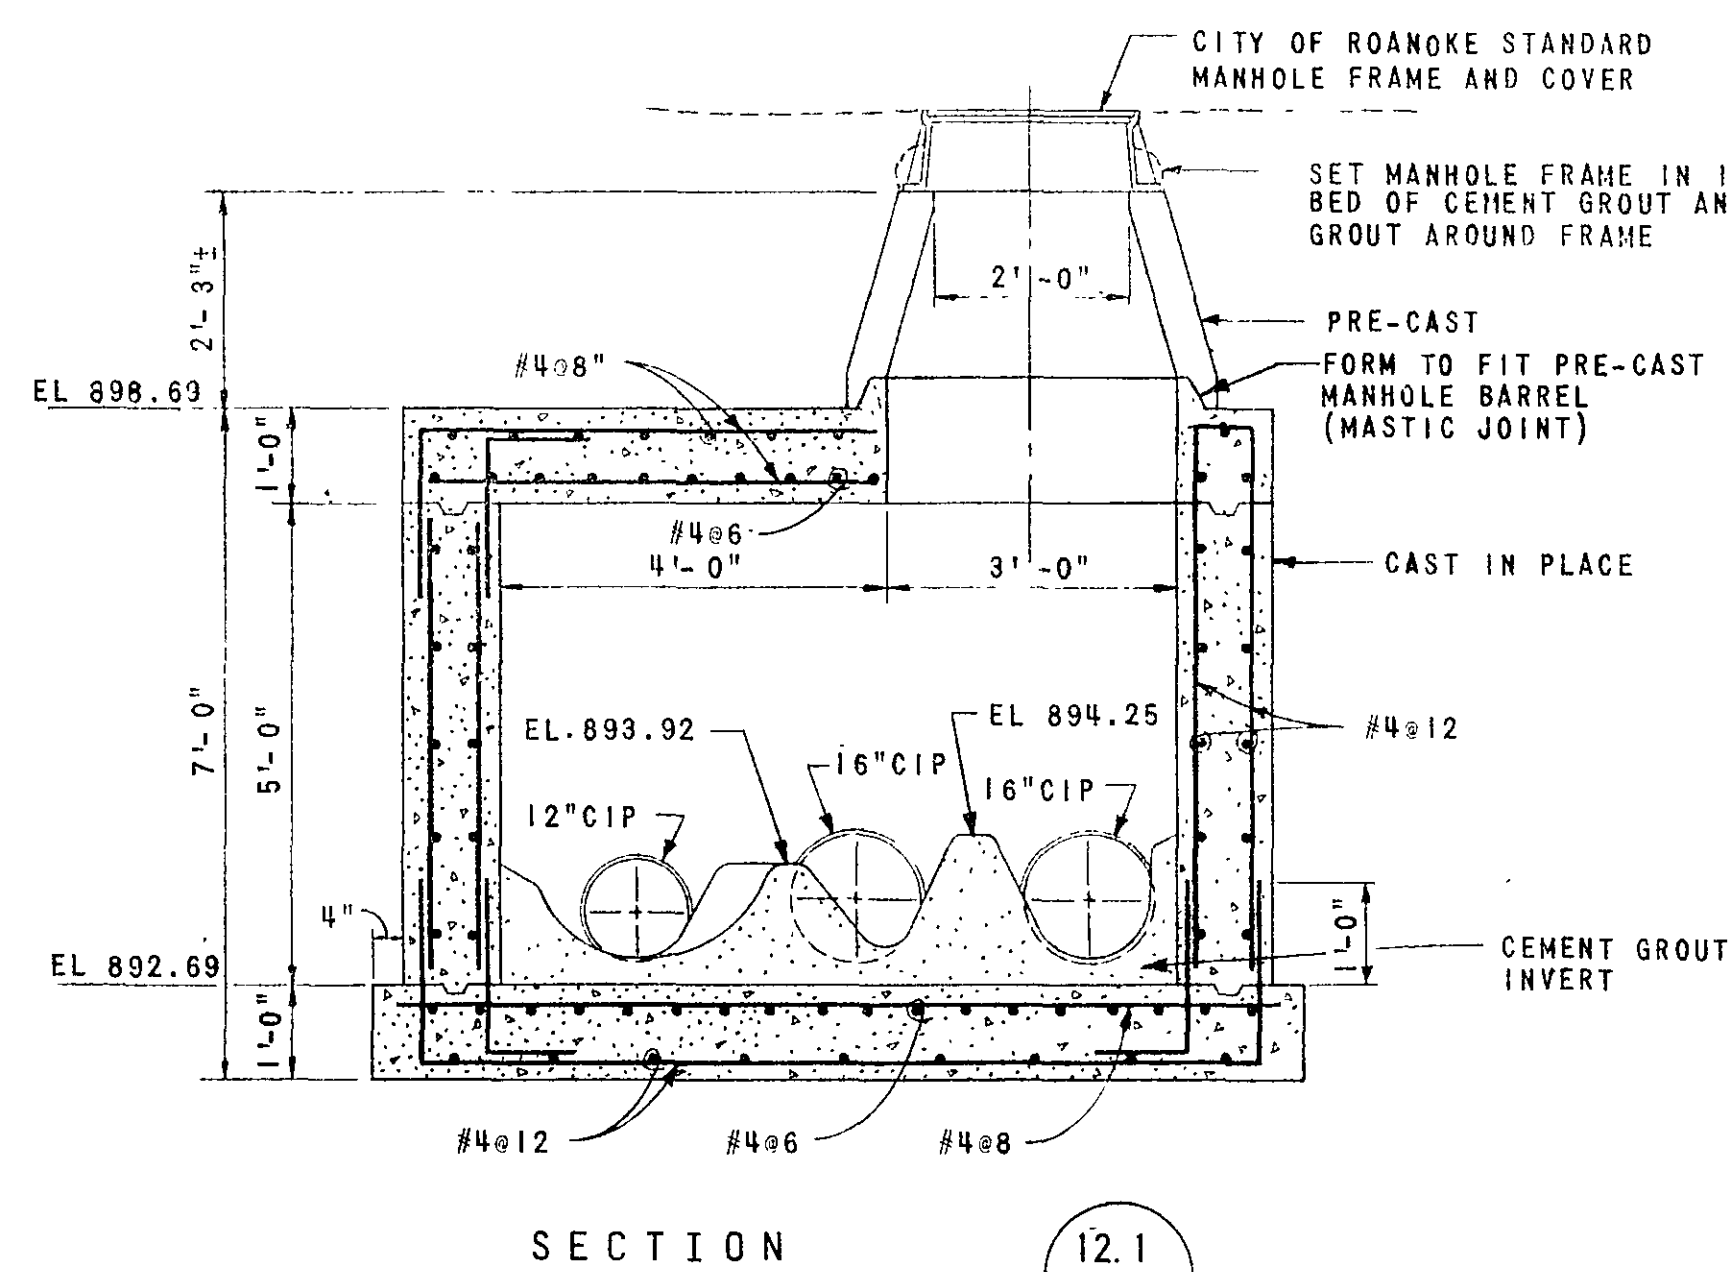
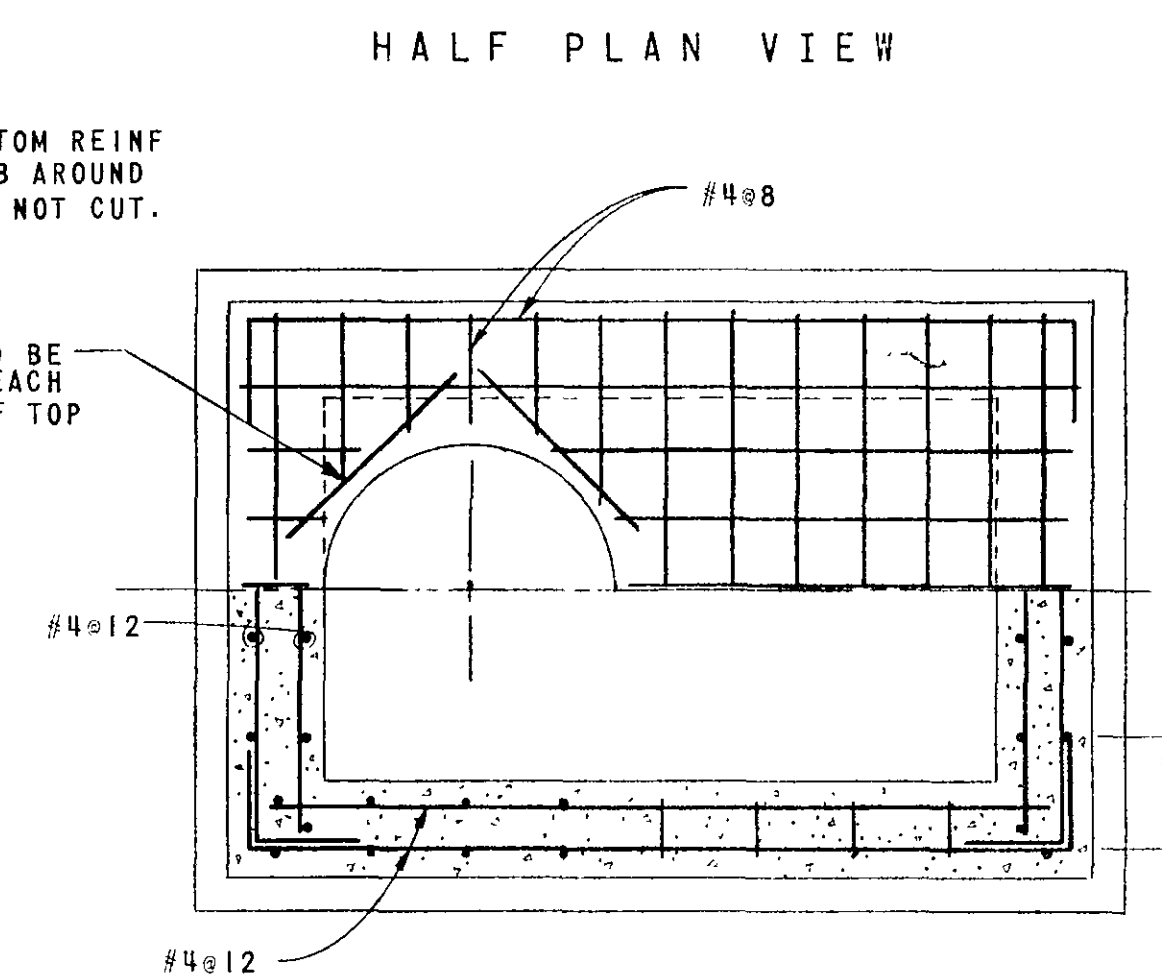
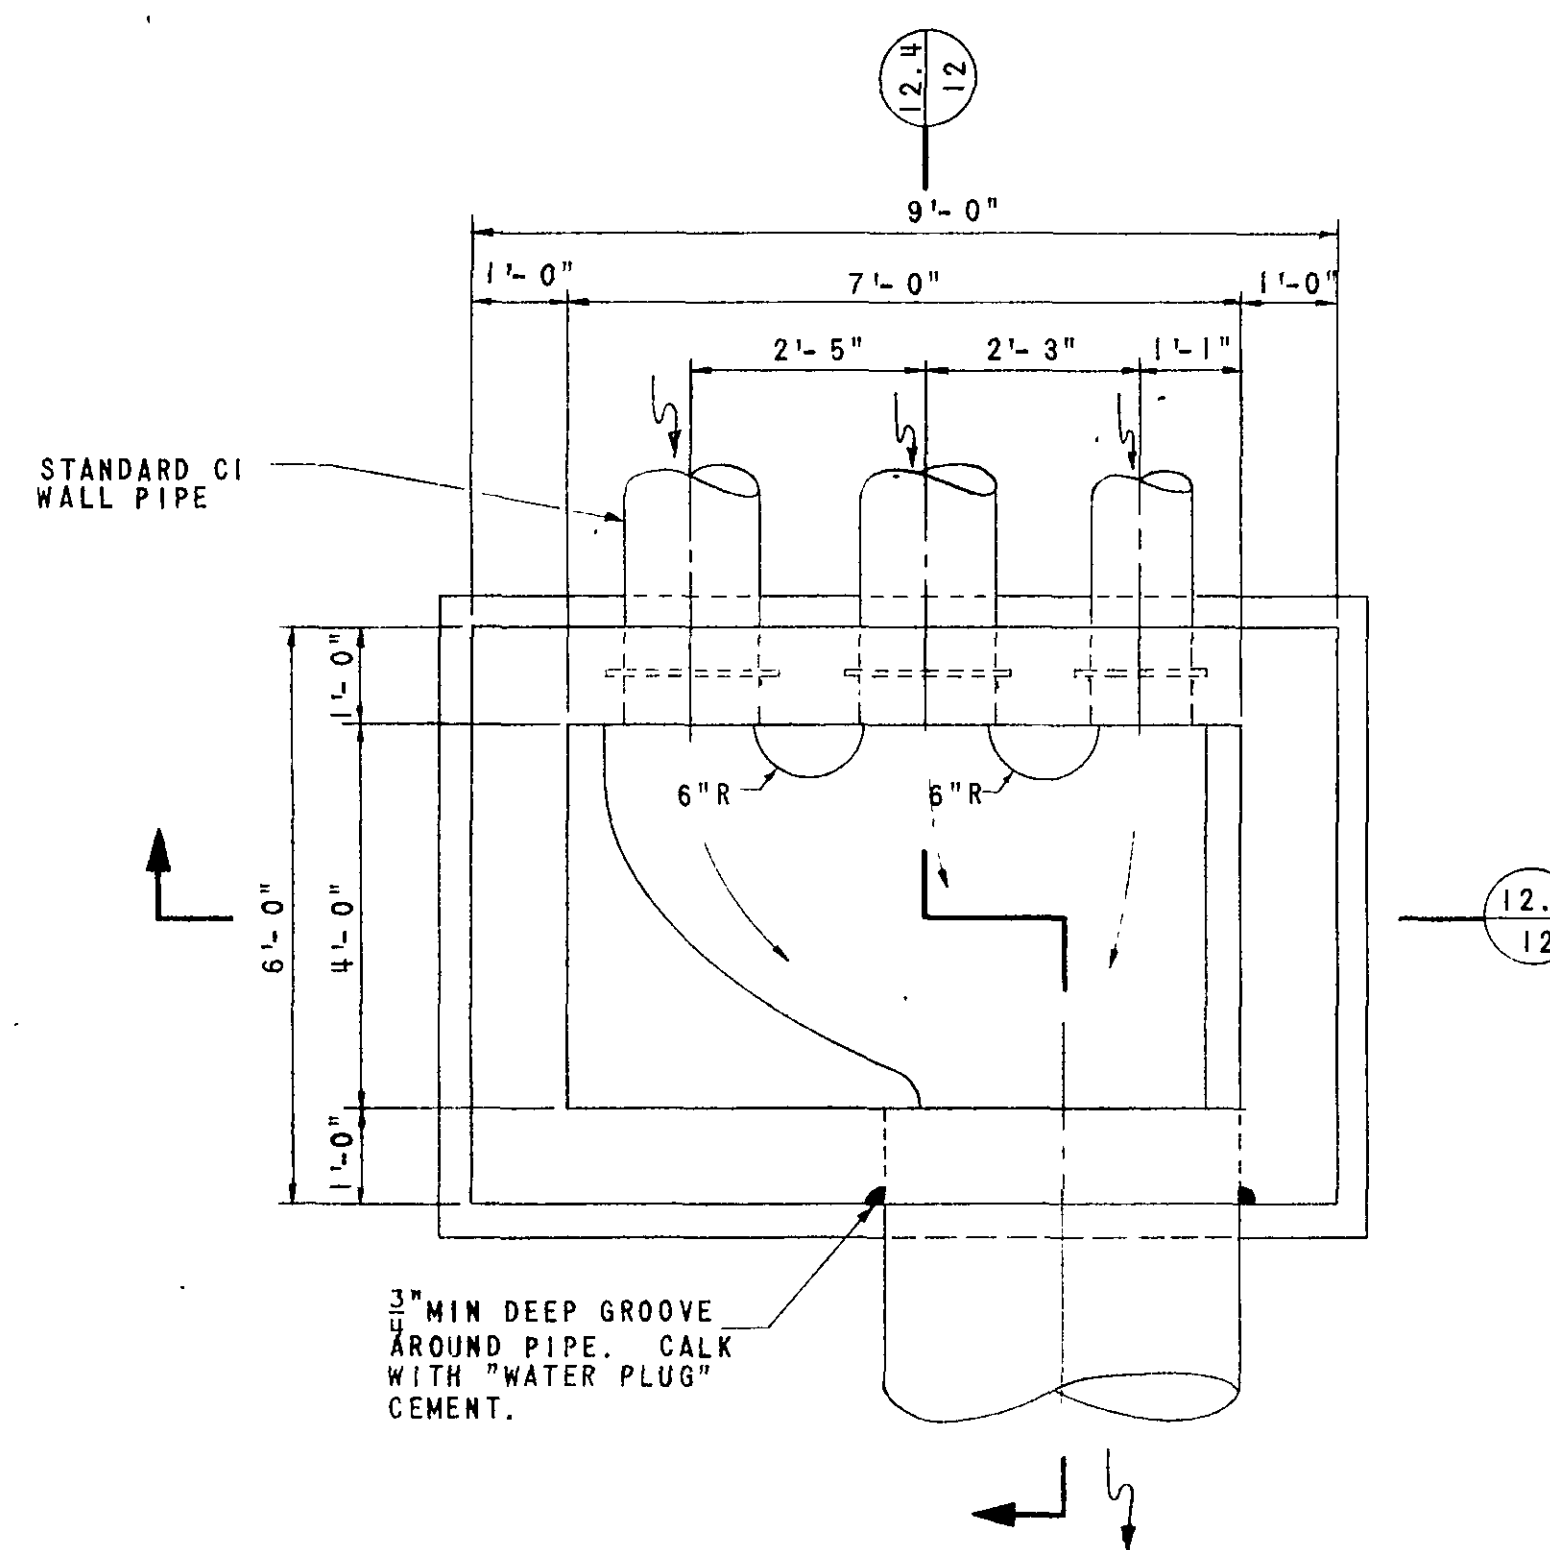
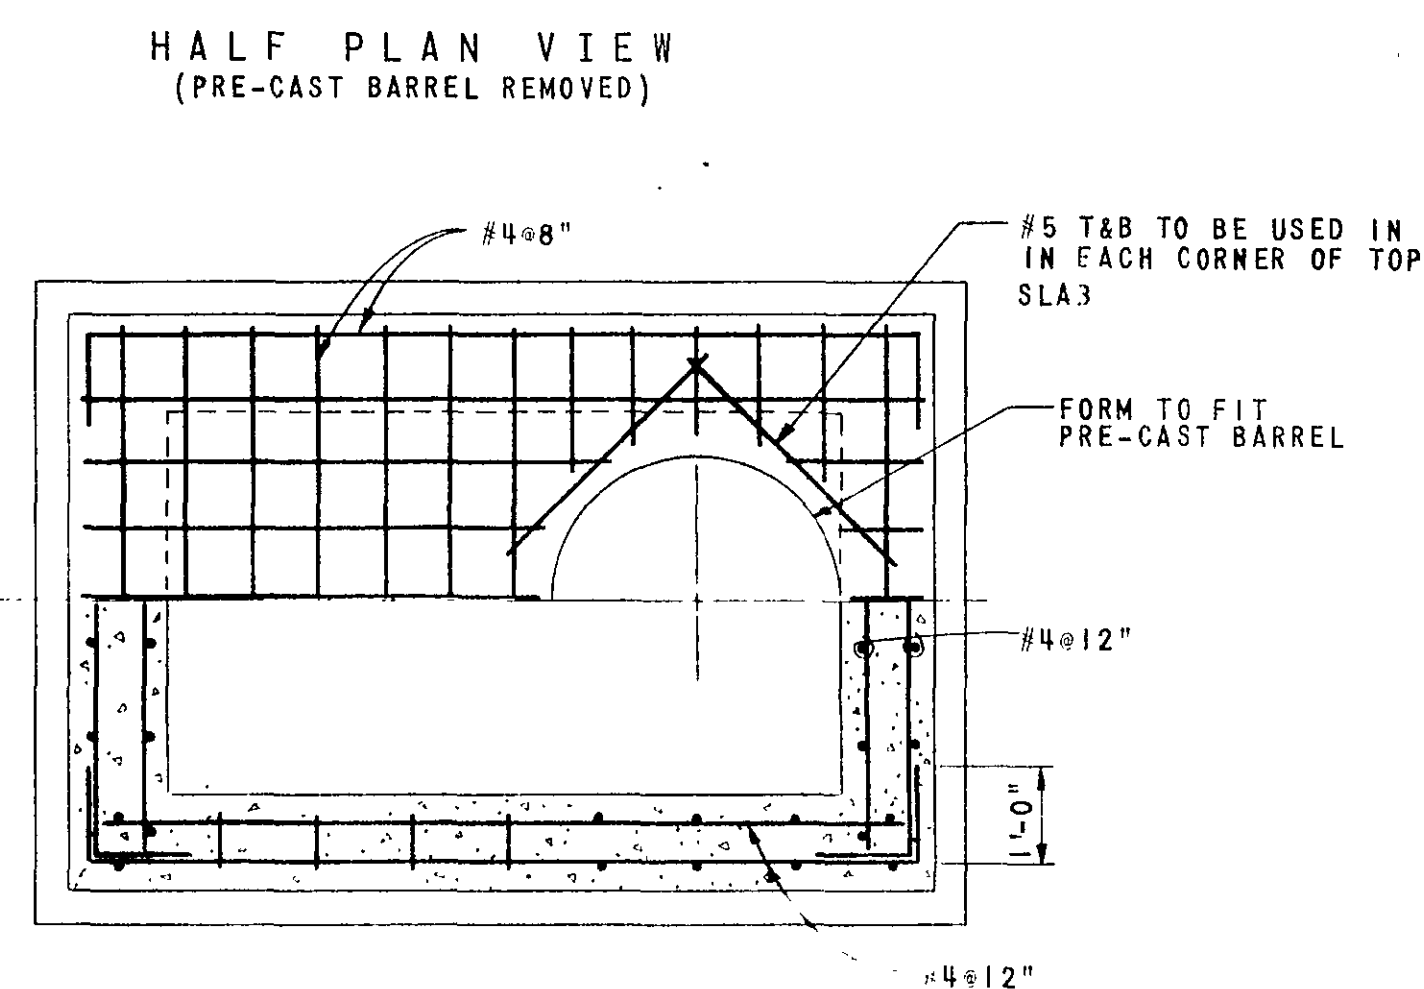
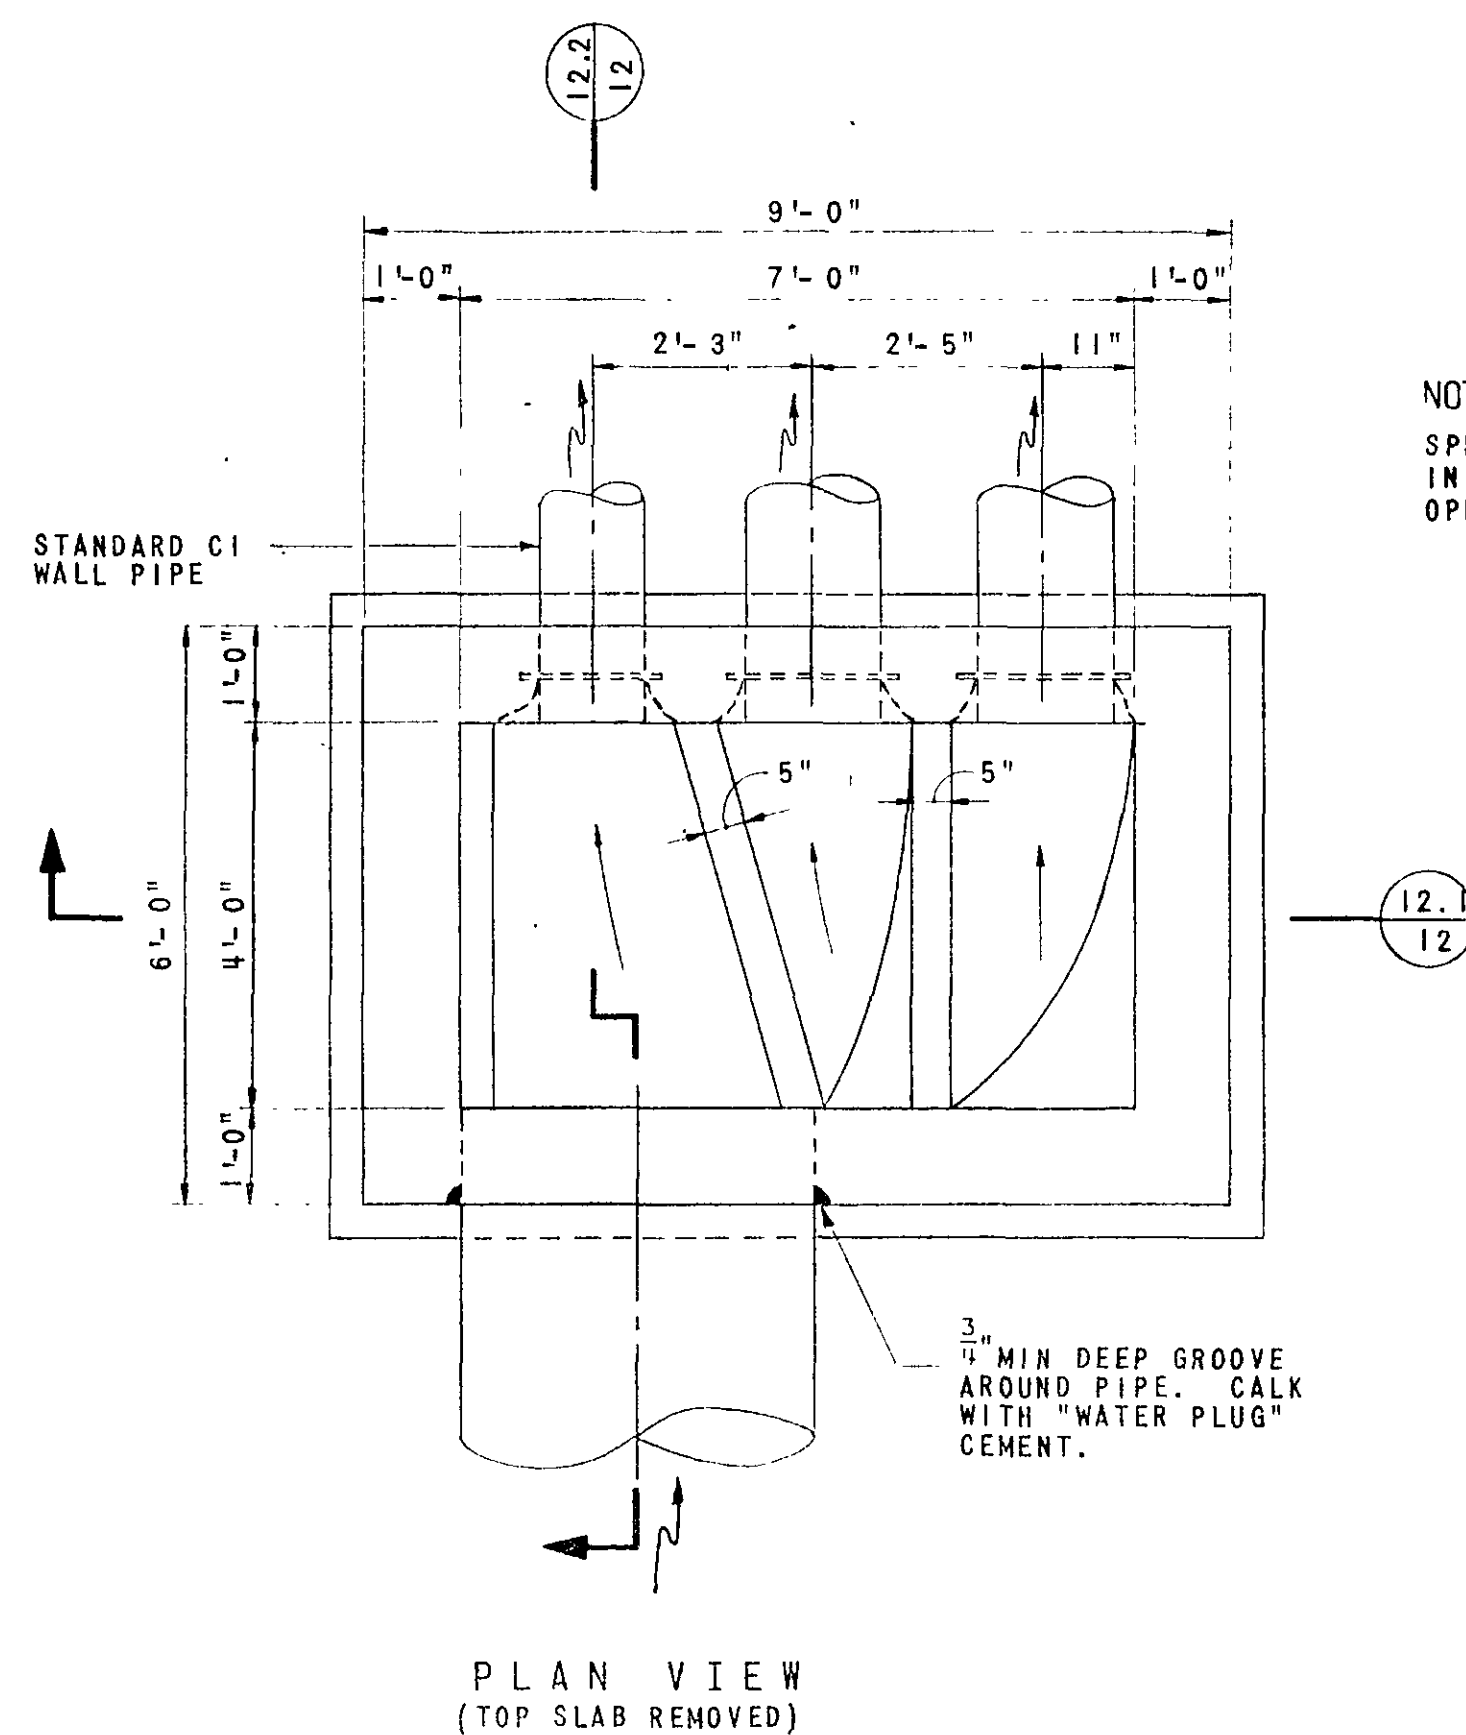


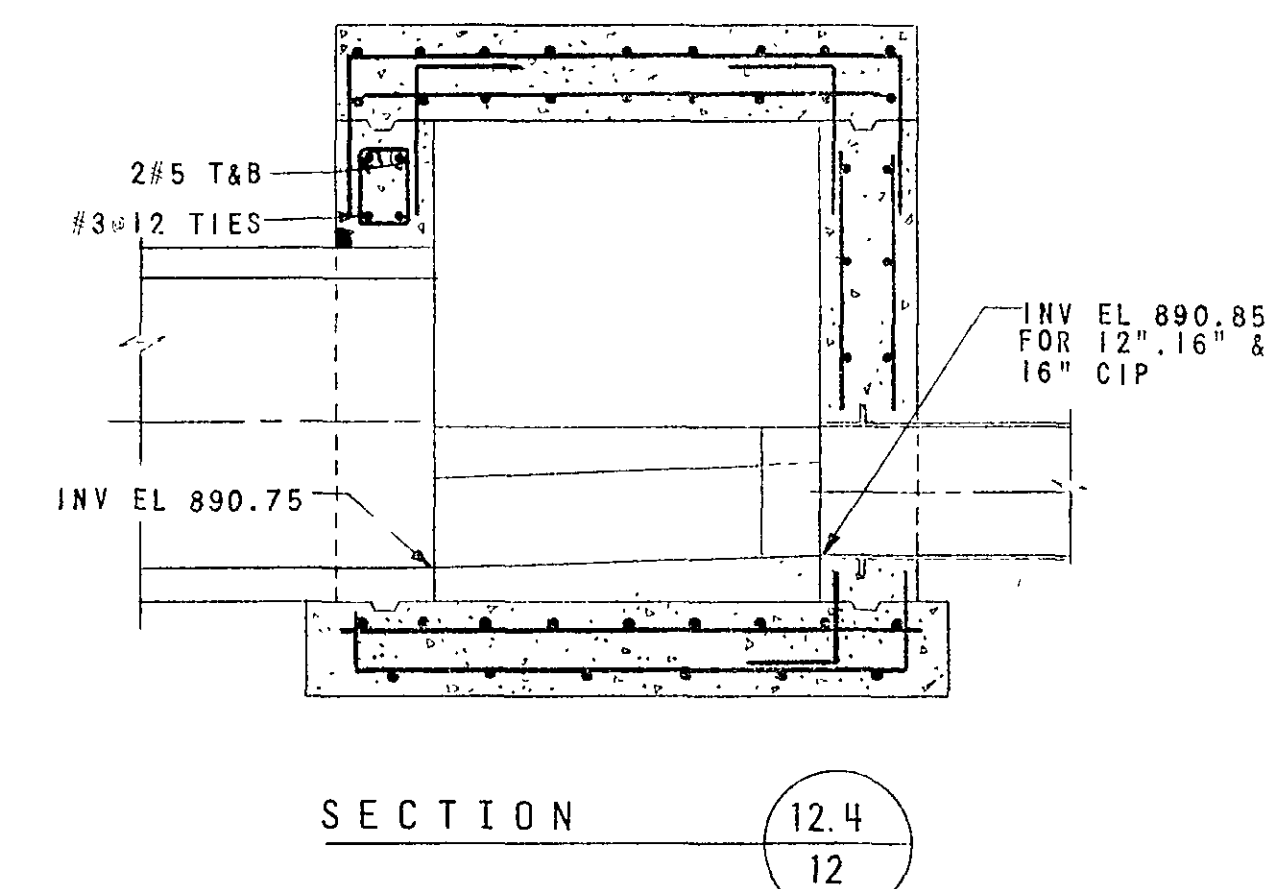

SIPHON NO. 1 INLET CHAMBER
SCALE: 1/2" = 1'-0"

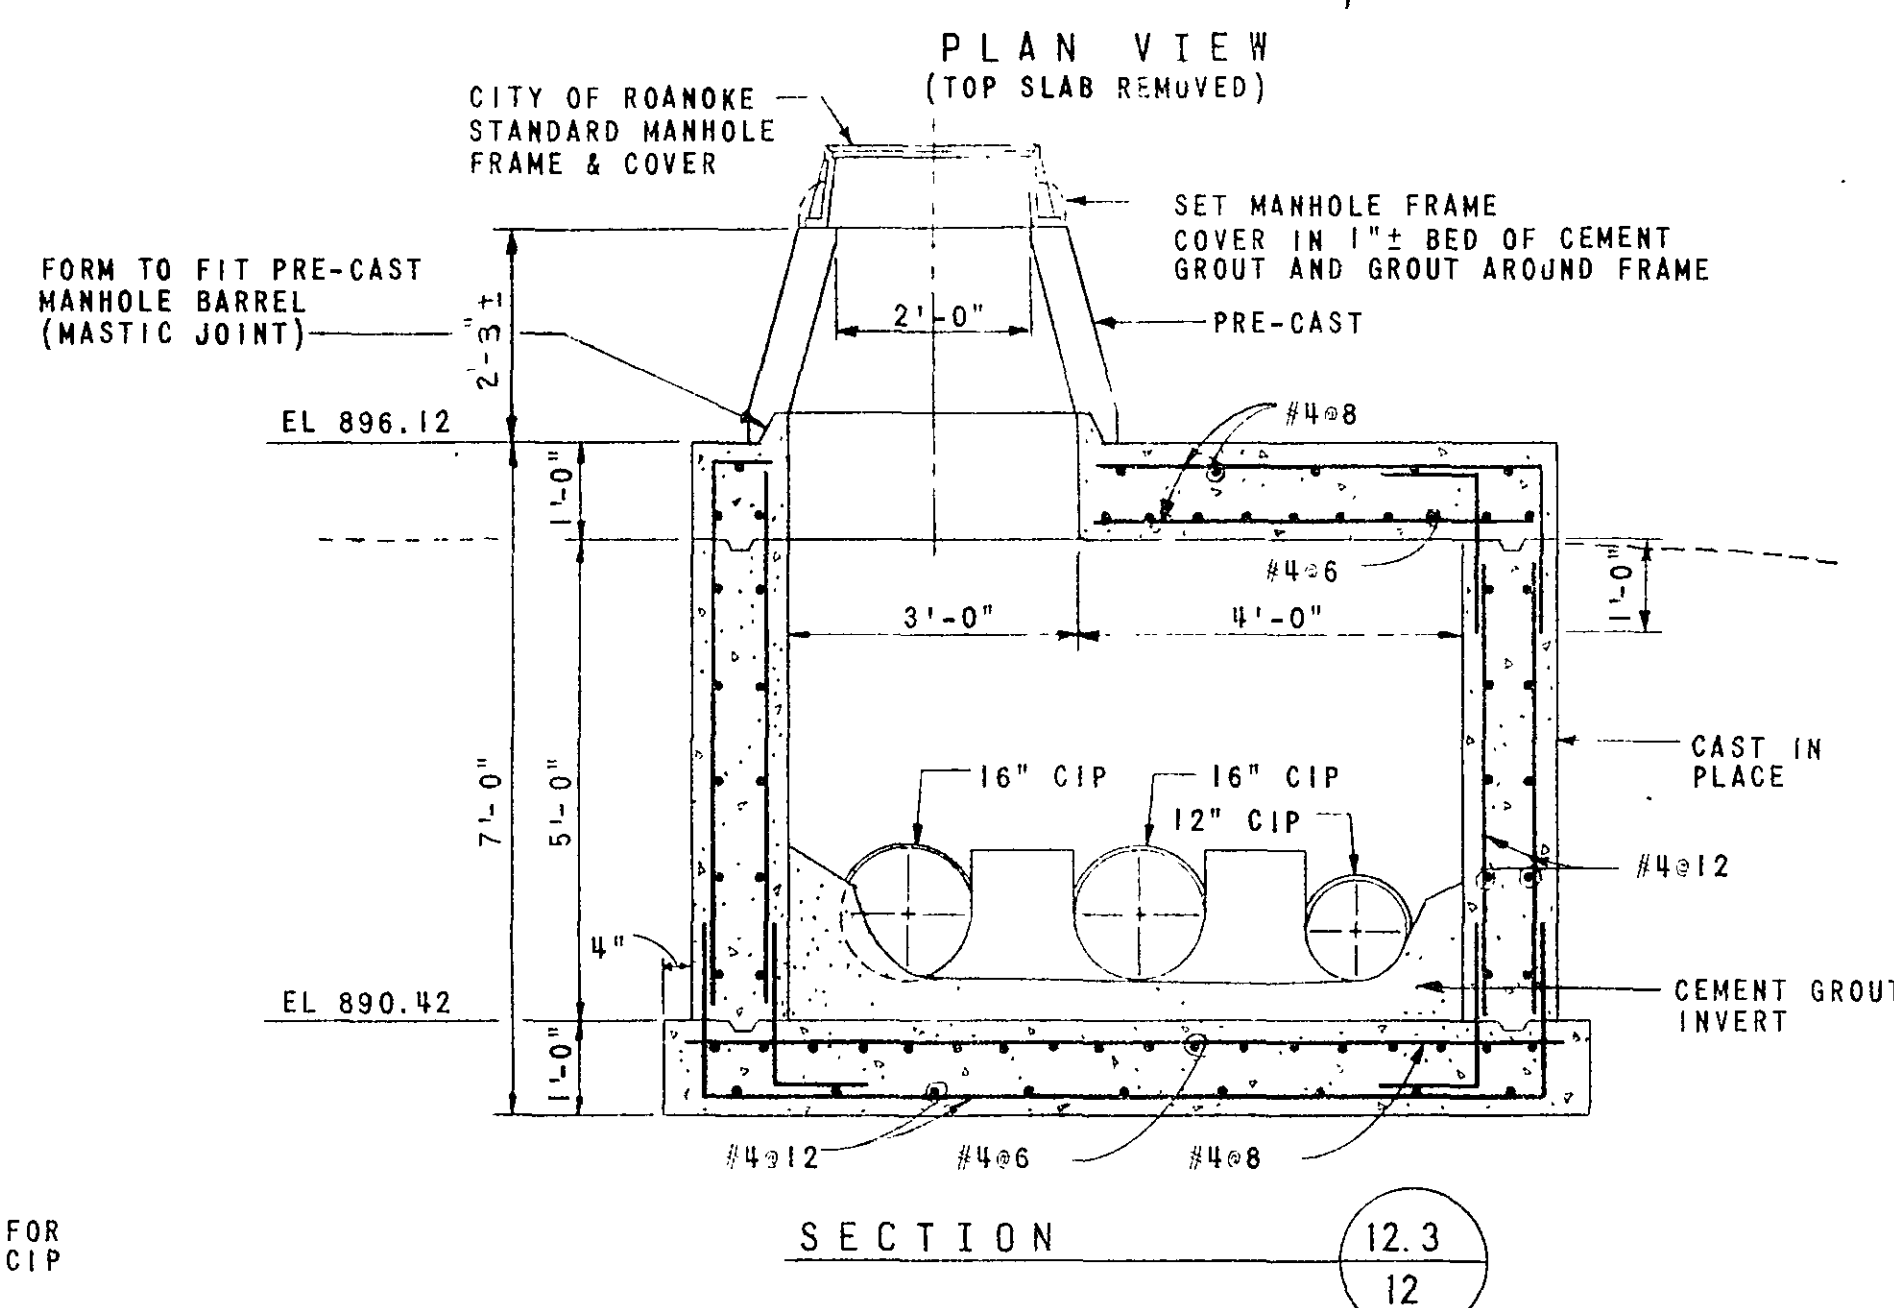

SIPHON NO. 1 OUTLET CHAMBER
SCALE: 1/2" = 1'-0"

AS BUILT

DIVISION I			
1	6-21-71	AS BUILT	DMC JHR
REVISION	DATE	DESCRIPTION	BY
DESIGNED	Red		
DRAWN	JT		
CHECKED	ML		
APPROVED	Ind		
SUBMITTED	GOS		
HAYES, SEAY, MATTERN & MATTERN ARCHITECTS - ENGINEERS		SCALE AS SHOWN DATE DEC. 1967	COMM. NO. 3262 SHEET 12 OF 18
INTERCEPTOR SEWERS PROJECT NO. 1 TINKER CREEK DETAILS		CITY OF ROANOKE VIRGINIA	