



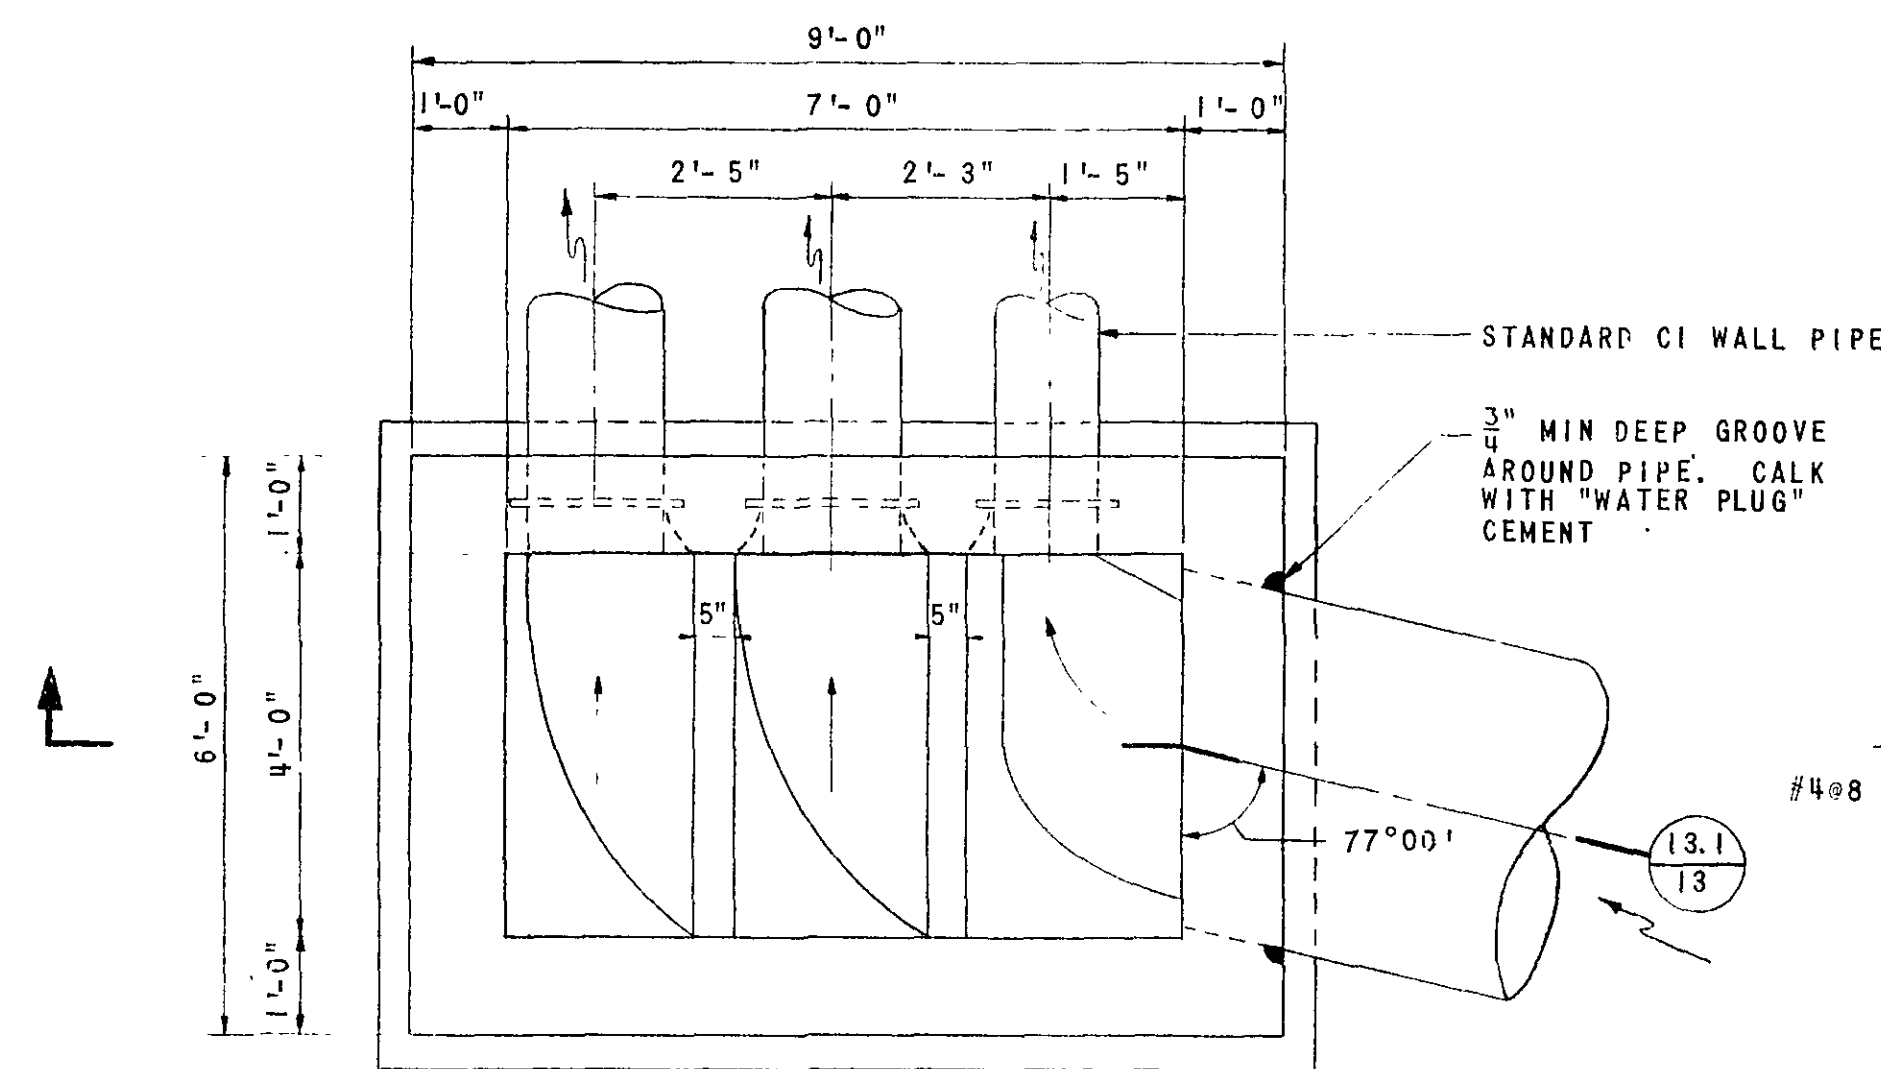


NOTE:
SPREAD BOTTOM REINF
IN TOP SLAB AROUND
OPENING. DO NOT CUT.

HALF PLAN VIEW
(PRE-CAST BARREL REMOVED)

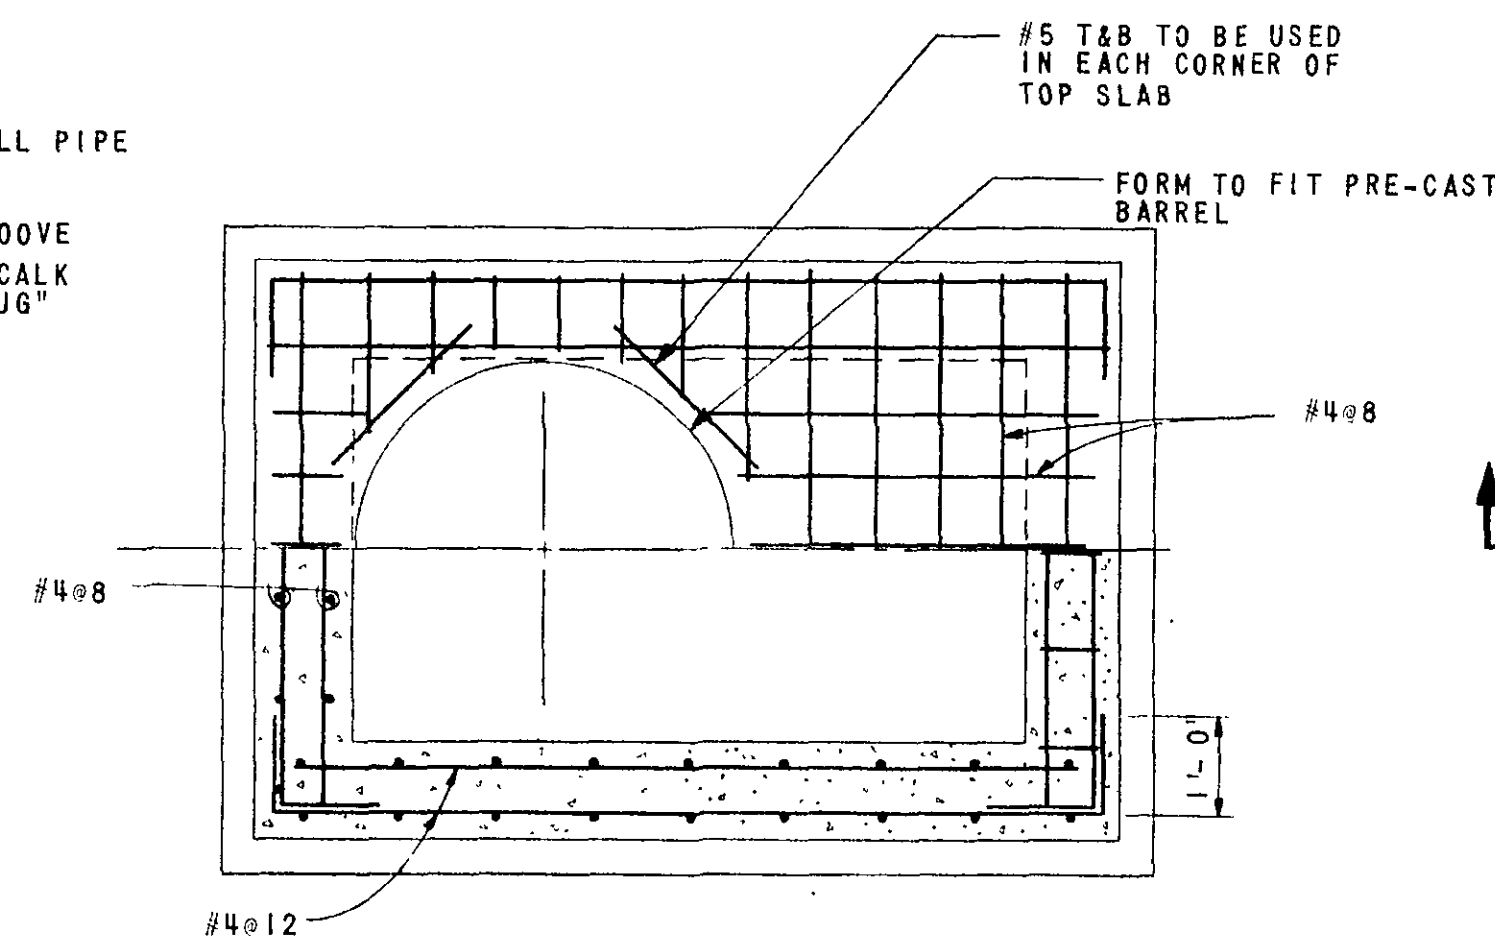

PLAN VIEW
(TOP SLAB REMOVED)


HALF PLAN VIEW
(TOP SLAB REMOVED)

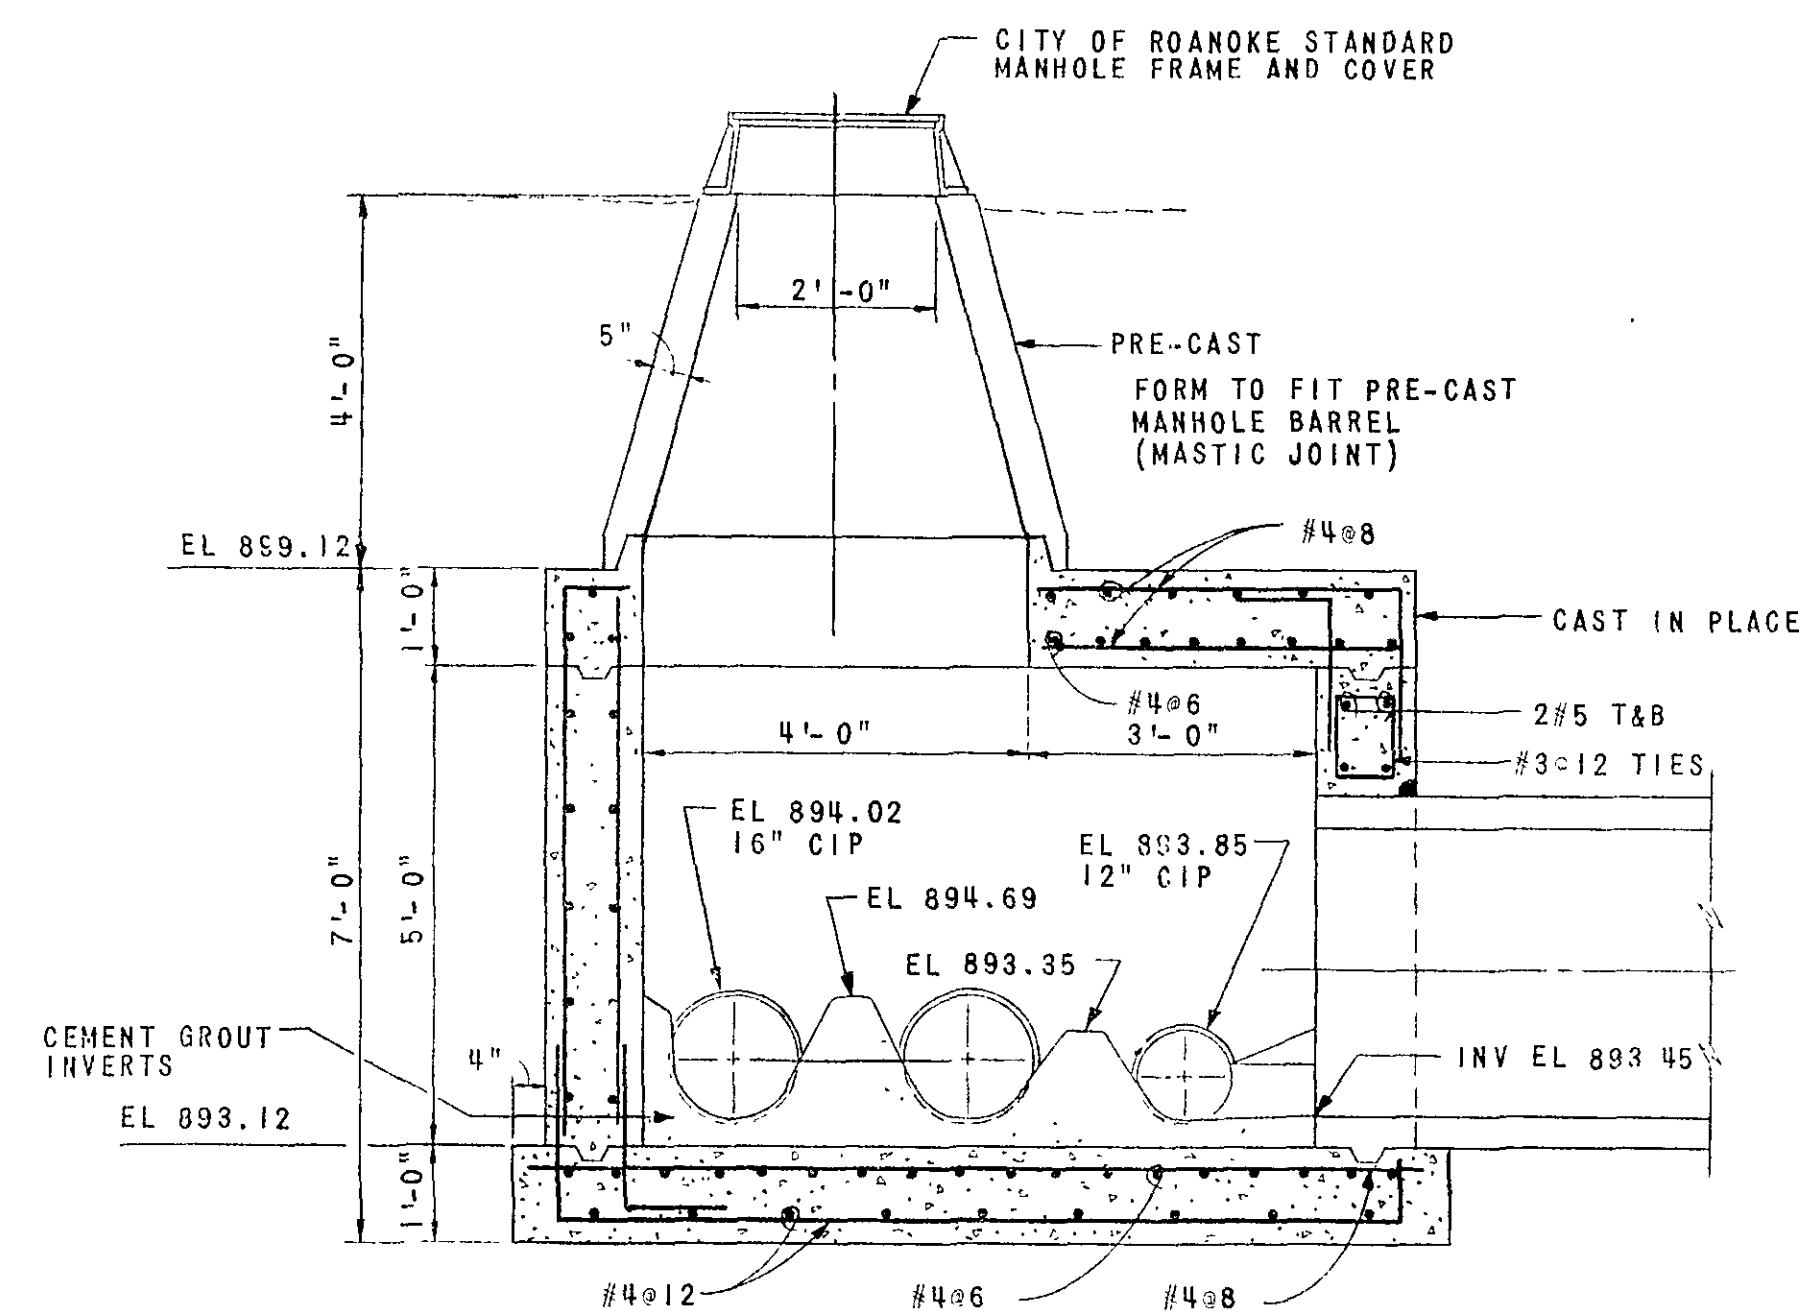

SECTION


SIPHON NO. 1A INLET CHAMBER

SCALE: $\frac{1}{2}" = 1'-0"$

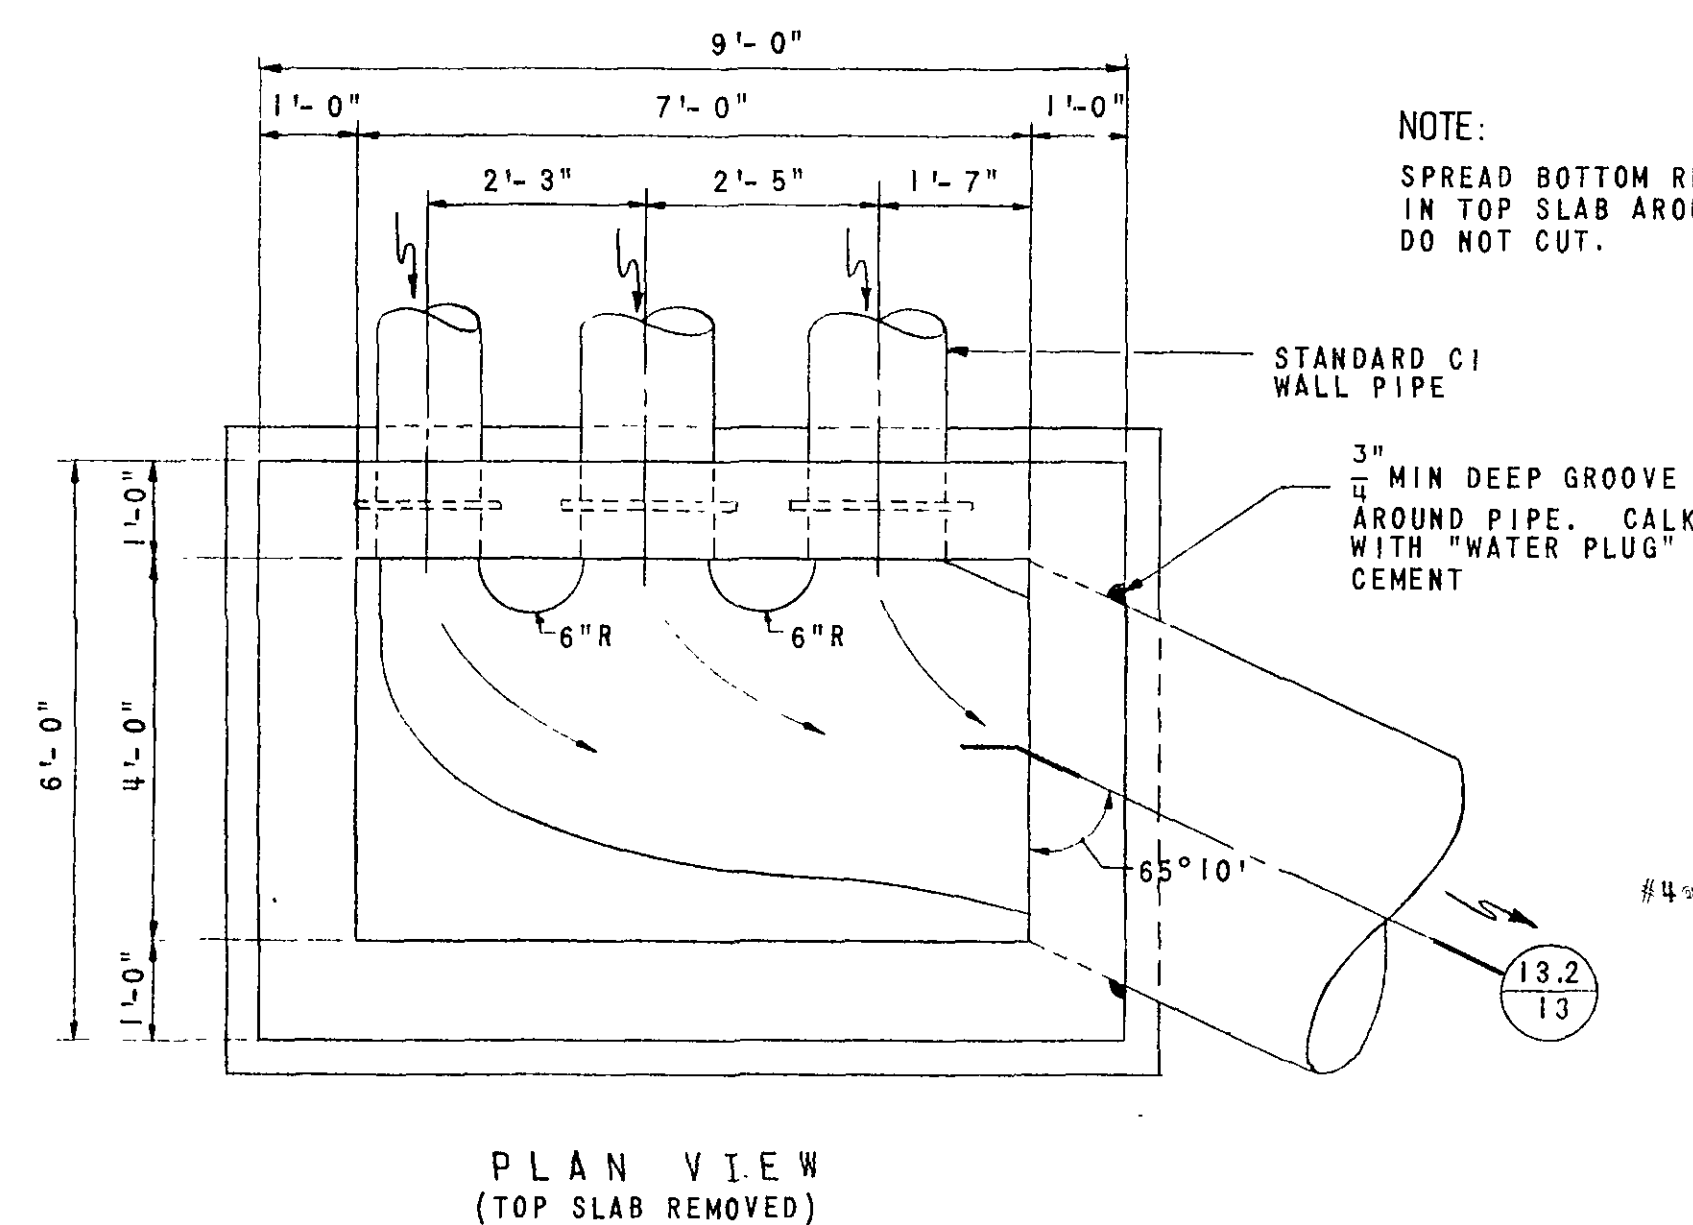


NOTE:
SPREAD BOTTOM REINF
IN TOP SLAB AROUND
OPENING.
DO NOT CUT.

HALF PLAN VIEW

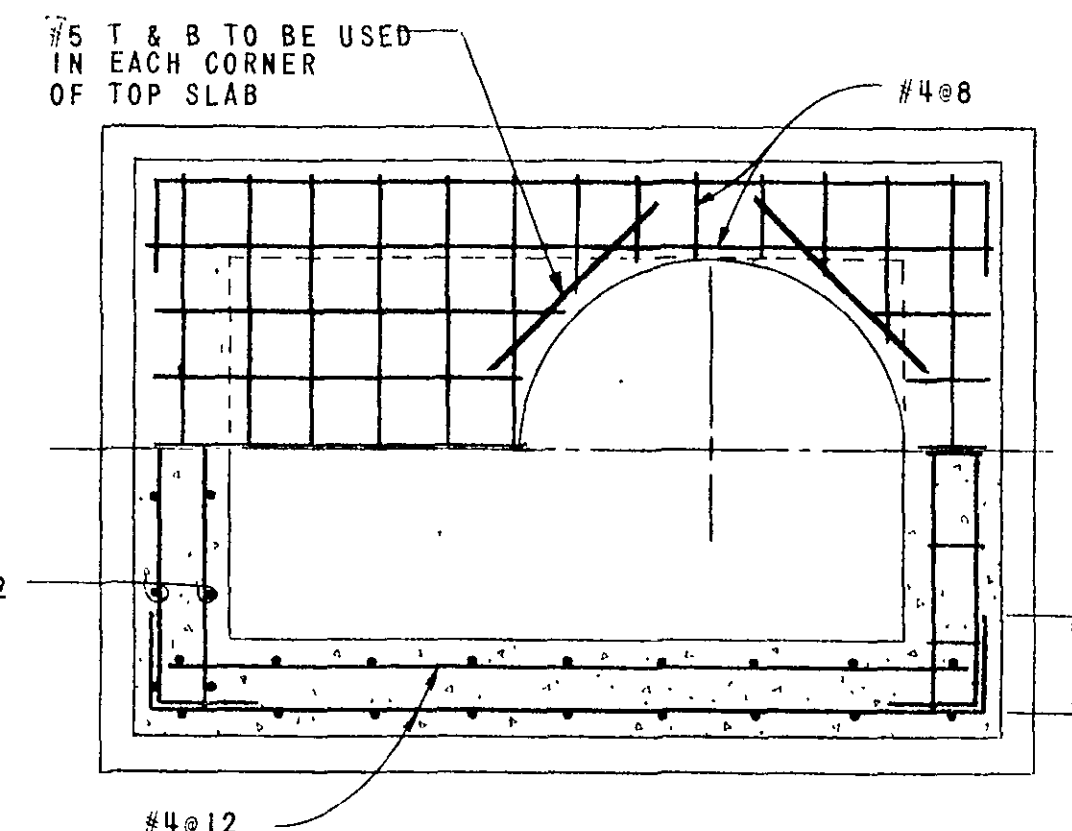

PLAN VIEW
(TOP SLAB REMOVED)

HALF PLAN VIEW
(TOP SLAB REMOVED)

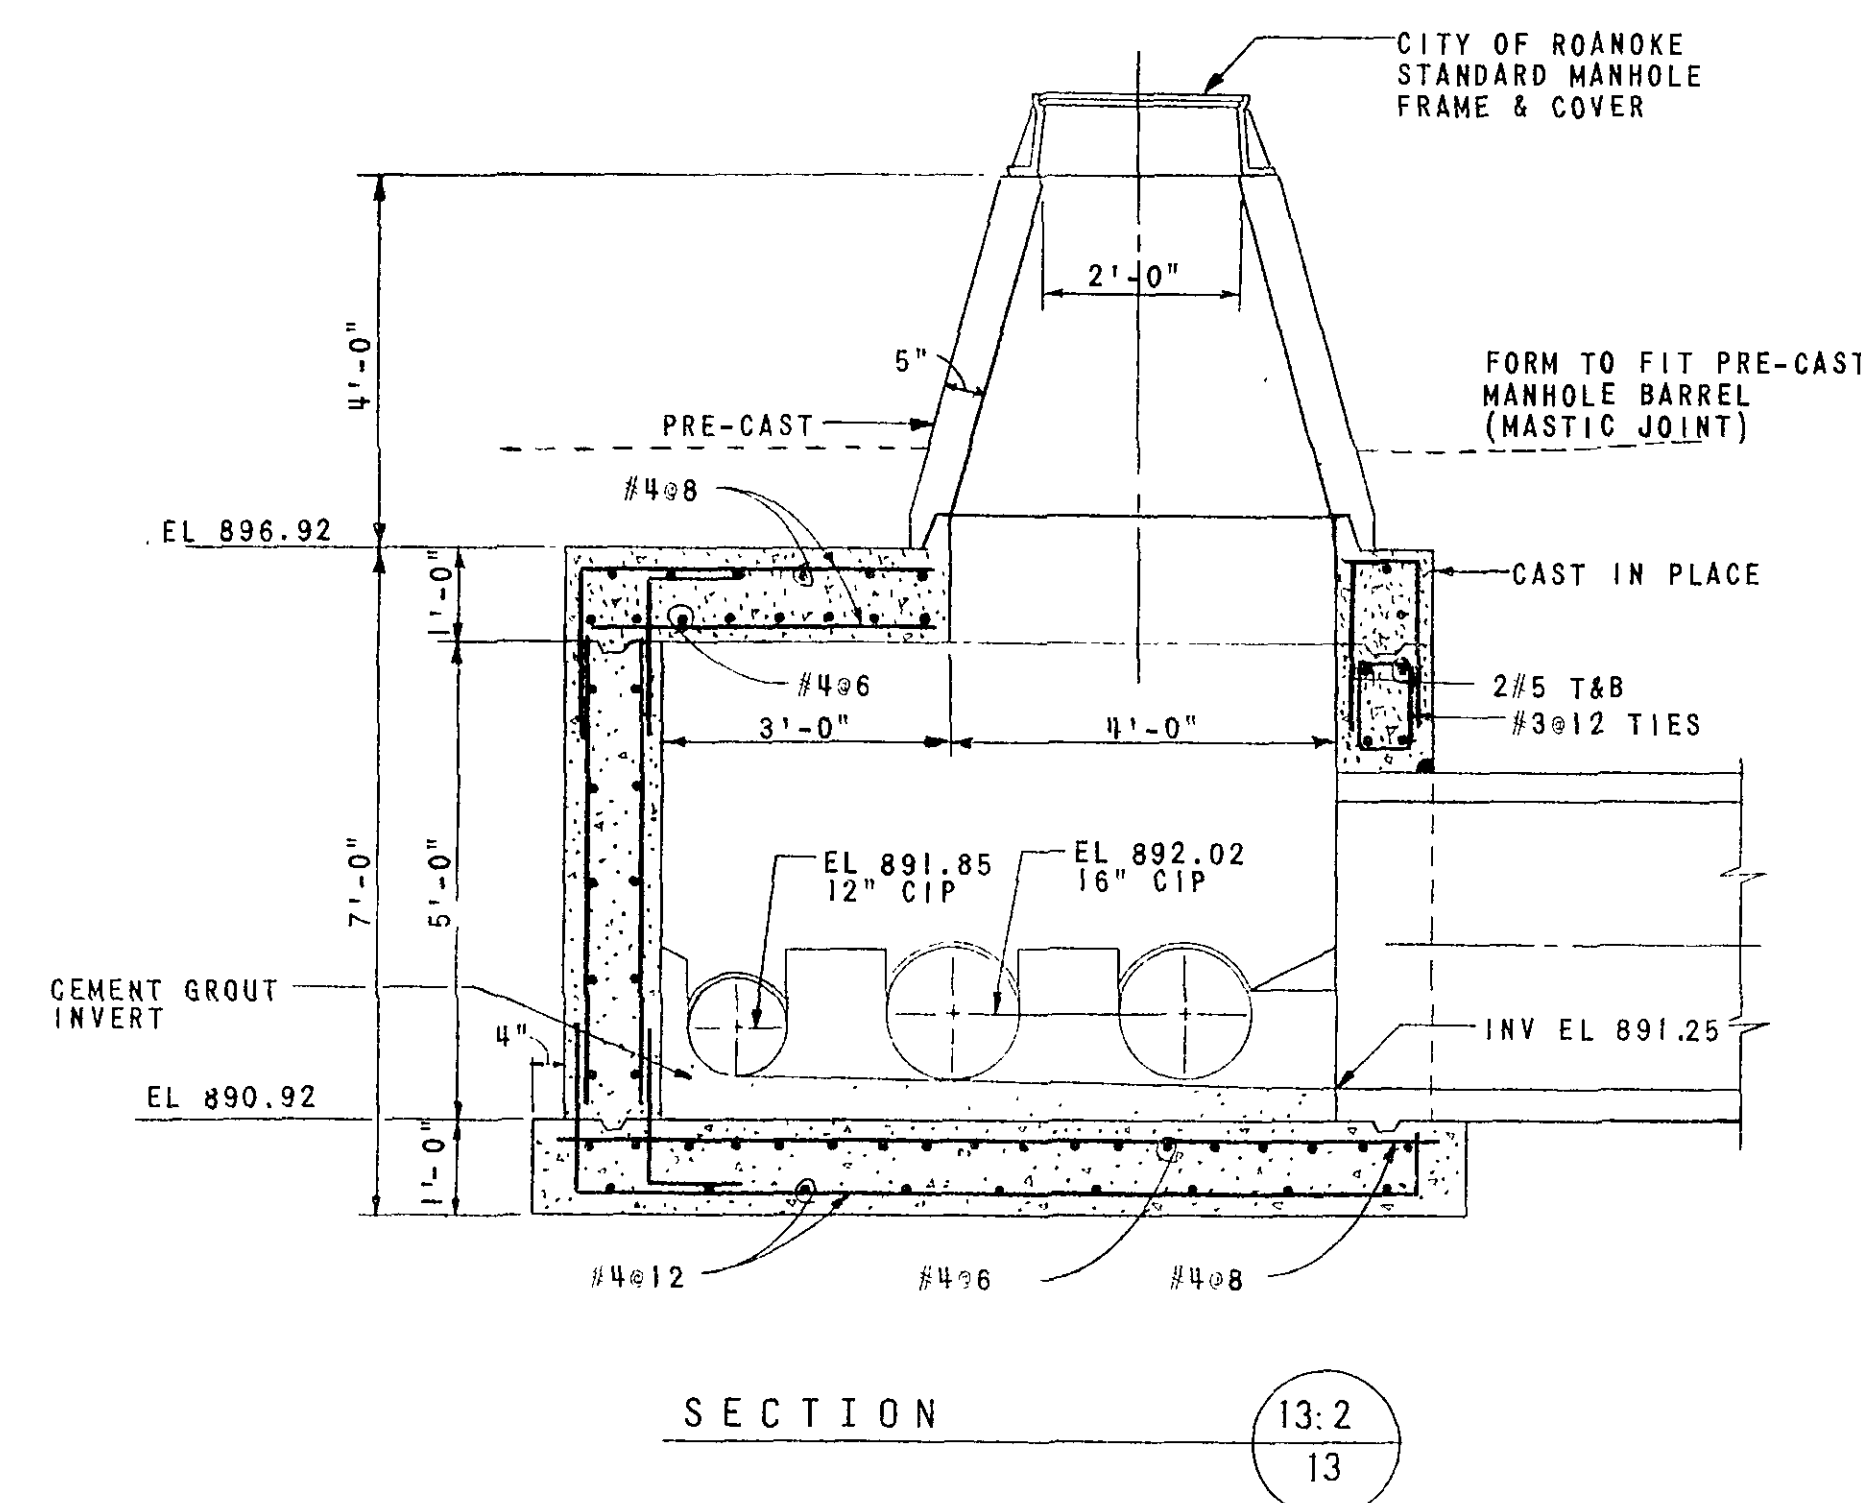

SECTION

SIPHON NO. 1A OUTLET CHAMBER

SCALE: $\frac{1}{2}" = 1'-0"$

DIVISION I

AS BUILT

DESIGNED	DATE	DESCRIPTION	BY	APPROVED
6-21-71	AS BUILT		DMC	JHR
DRAWN	CHECKED	APPROVED	SUBMITTED	
JT	MLB	JHR	GOS	
INTERCEPTOR SEWERS PROJECT NO. 1				
TINKER CREEK DETAILS				
CITY OF ROANOKE VIRGINIA				
HAYES, SEAY, MATTERN & MATTERN ARCHITECTS-ENGINEERS		SCALE AS SHOWN	COMM. NO.	3262
		DATE	DEC. 1967	SHEET 13 OF 18