




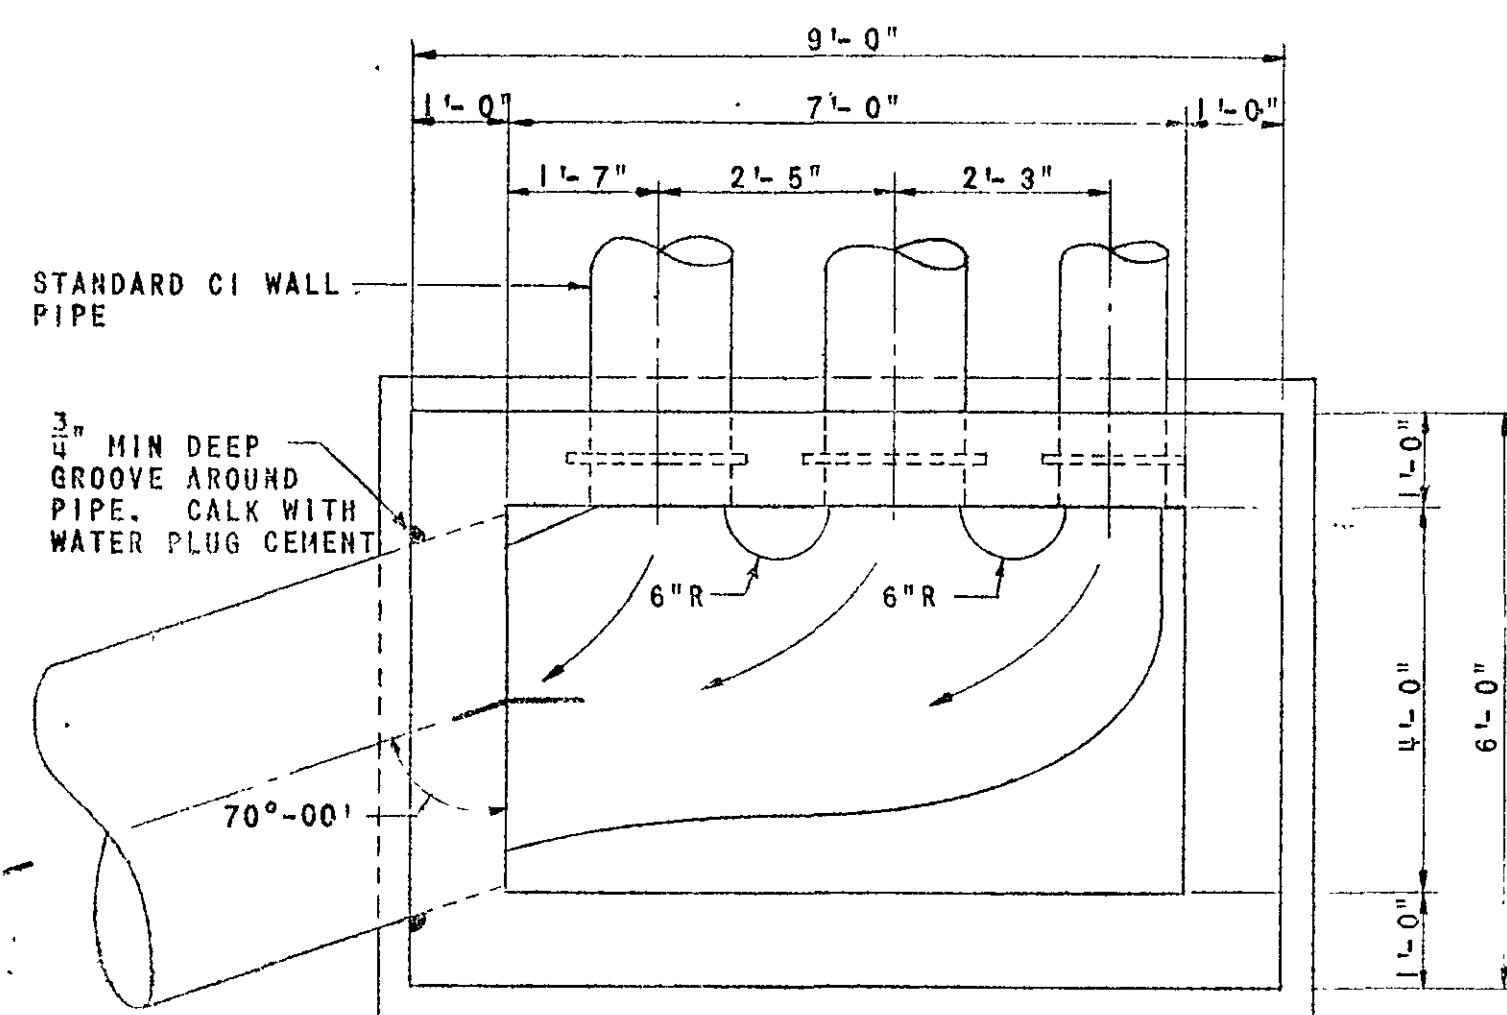

PLAN VIEW
(TOP SLAB REMOVED)

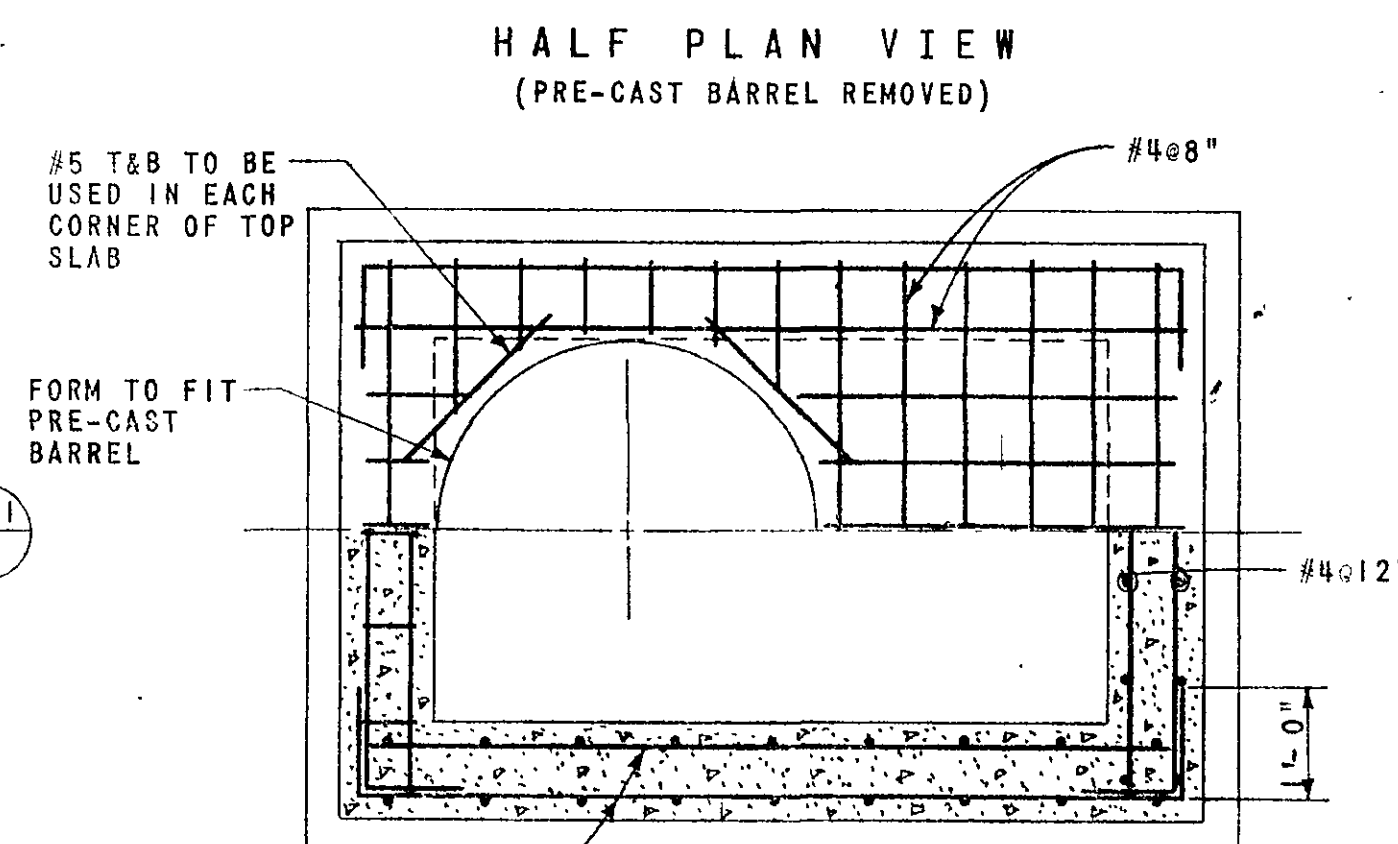


HALF PLAN VIEW
(TOP SLAB REMOVED)

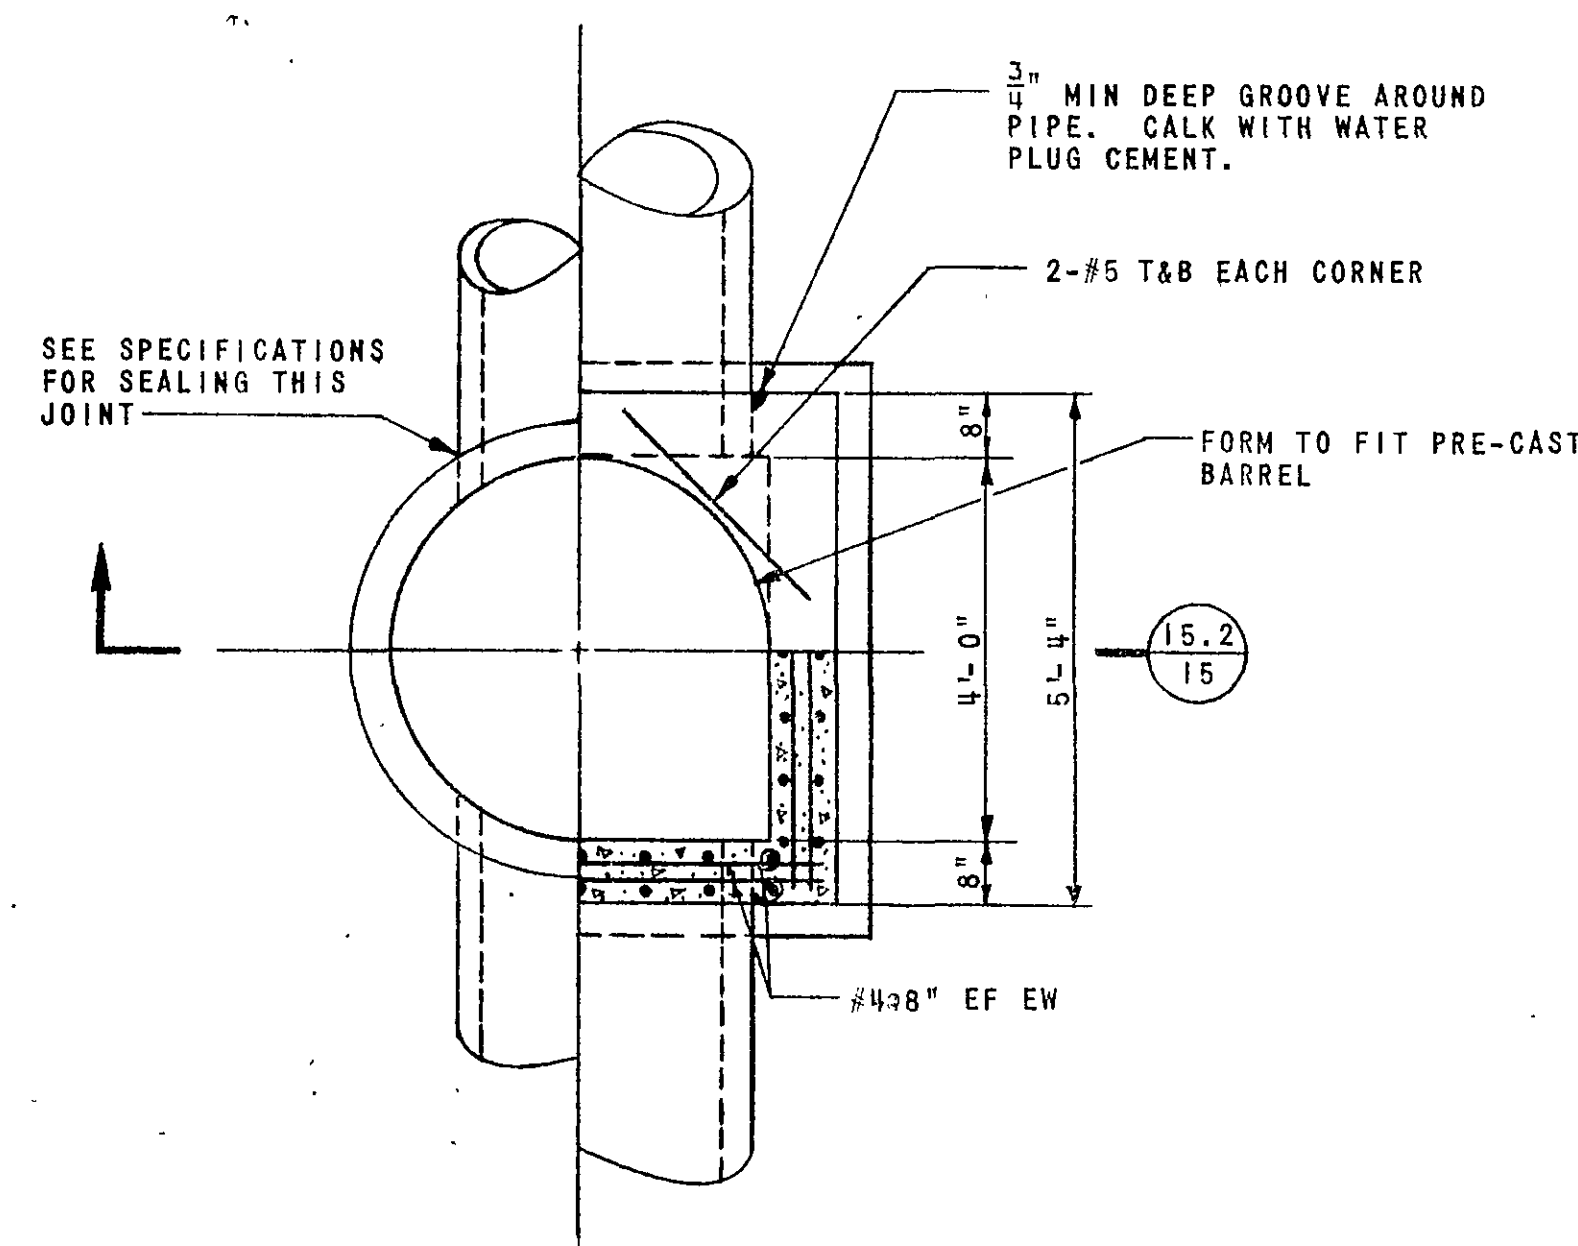


HALF PLAN VIEW

- NOTE:
1. WATERTIGHT MANHOLE FRAMES & COVERS SHALL BE SIMILAR TO "HEENAH" R-1919 WITH "O" RING RUBBER GASKETS & ANCHOR BOLTS.
 2. PROVIDE SHALLOW MANHOLE TOP IF DEPTH IS LESS THAN 3'-10". SEE STD. DETAIL C-2.2.

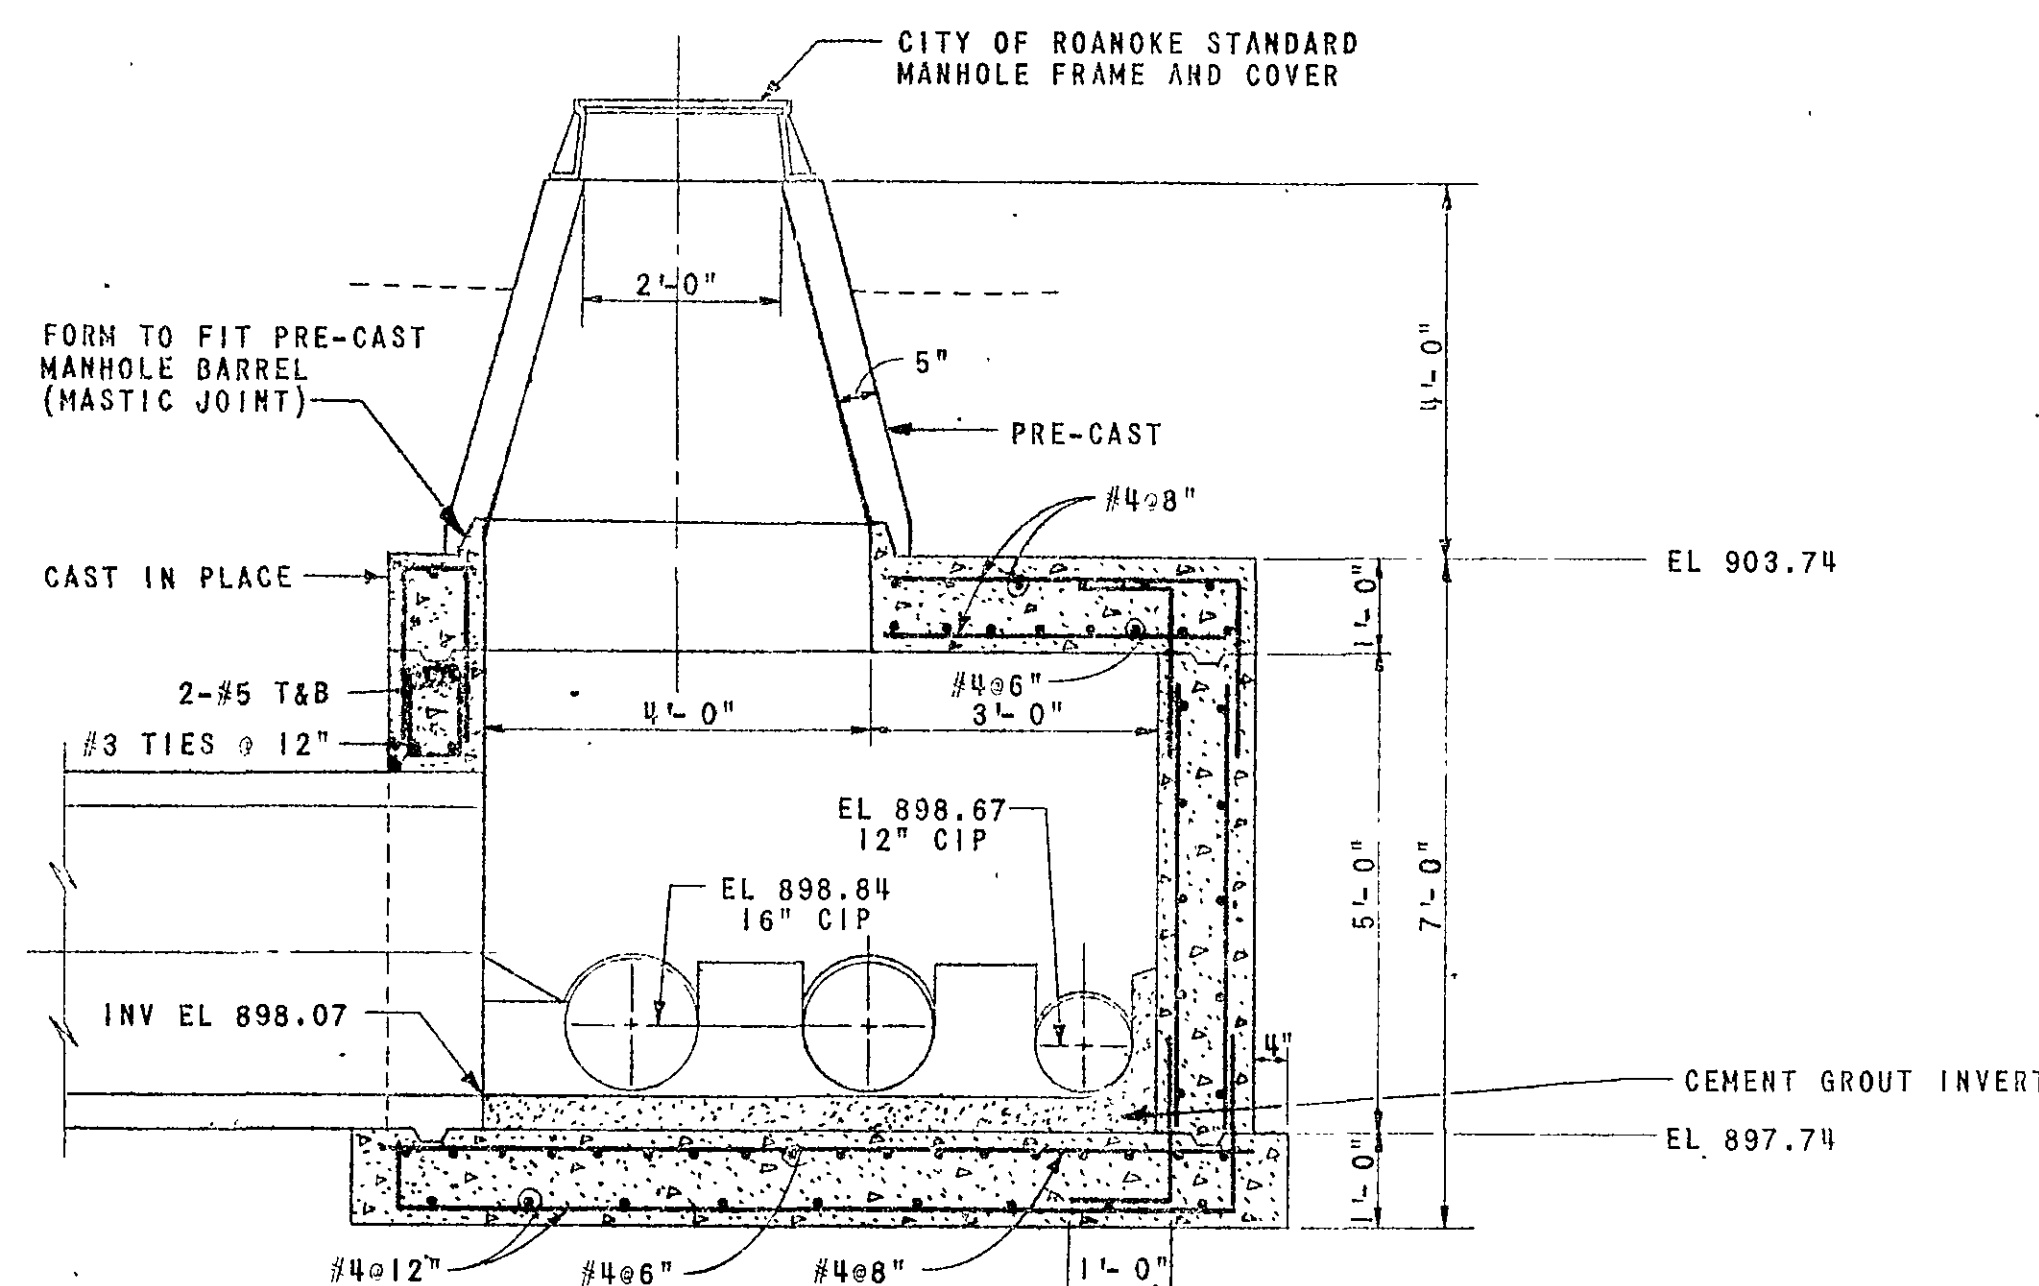

SECTION

SIPHON NO. 2 OUTLET CHAMBER
(DIVISION I)
SCALE: 1/2" = 1'-0"

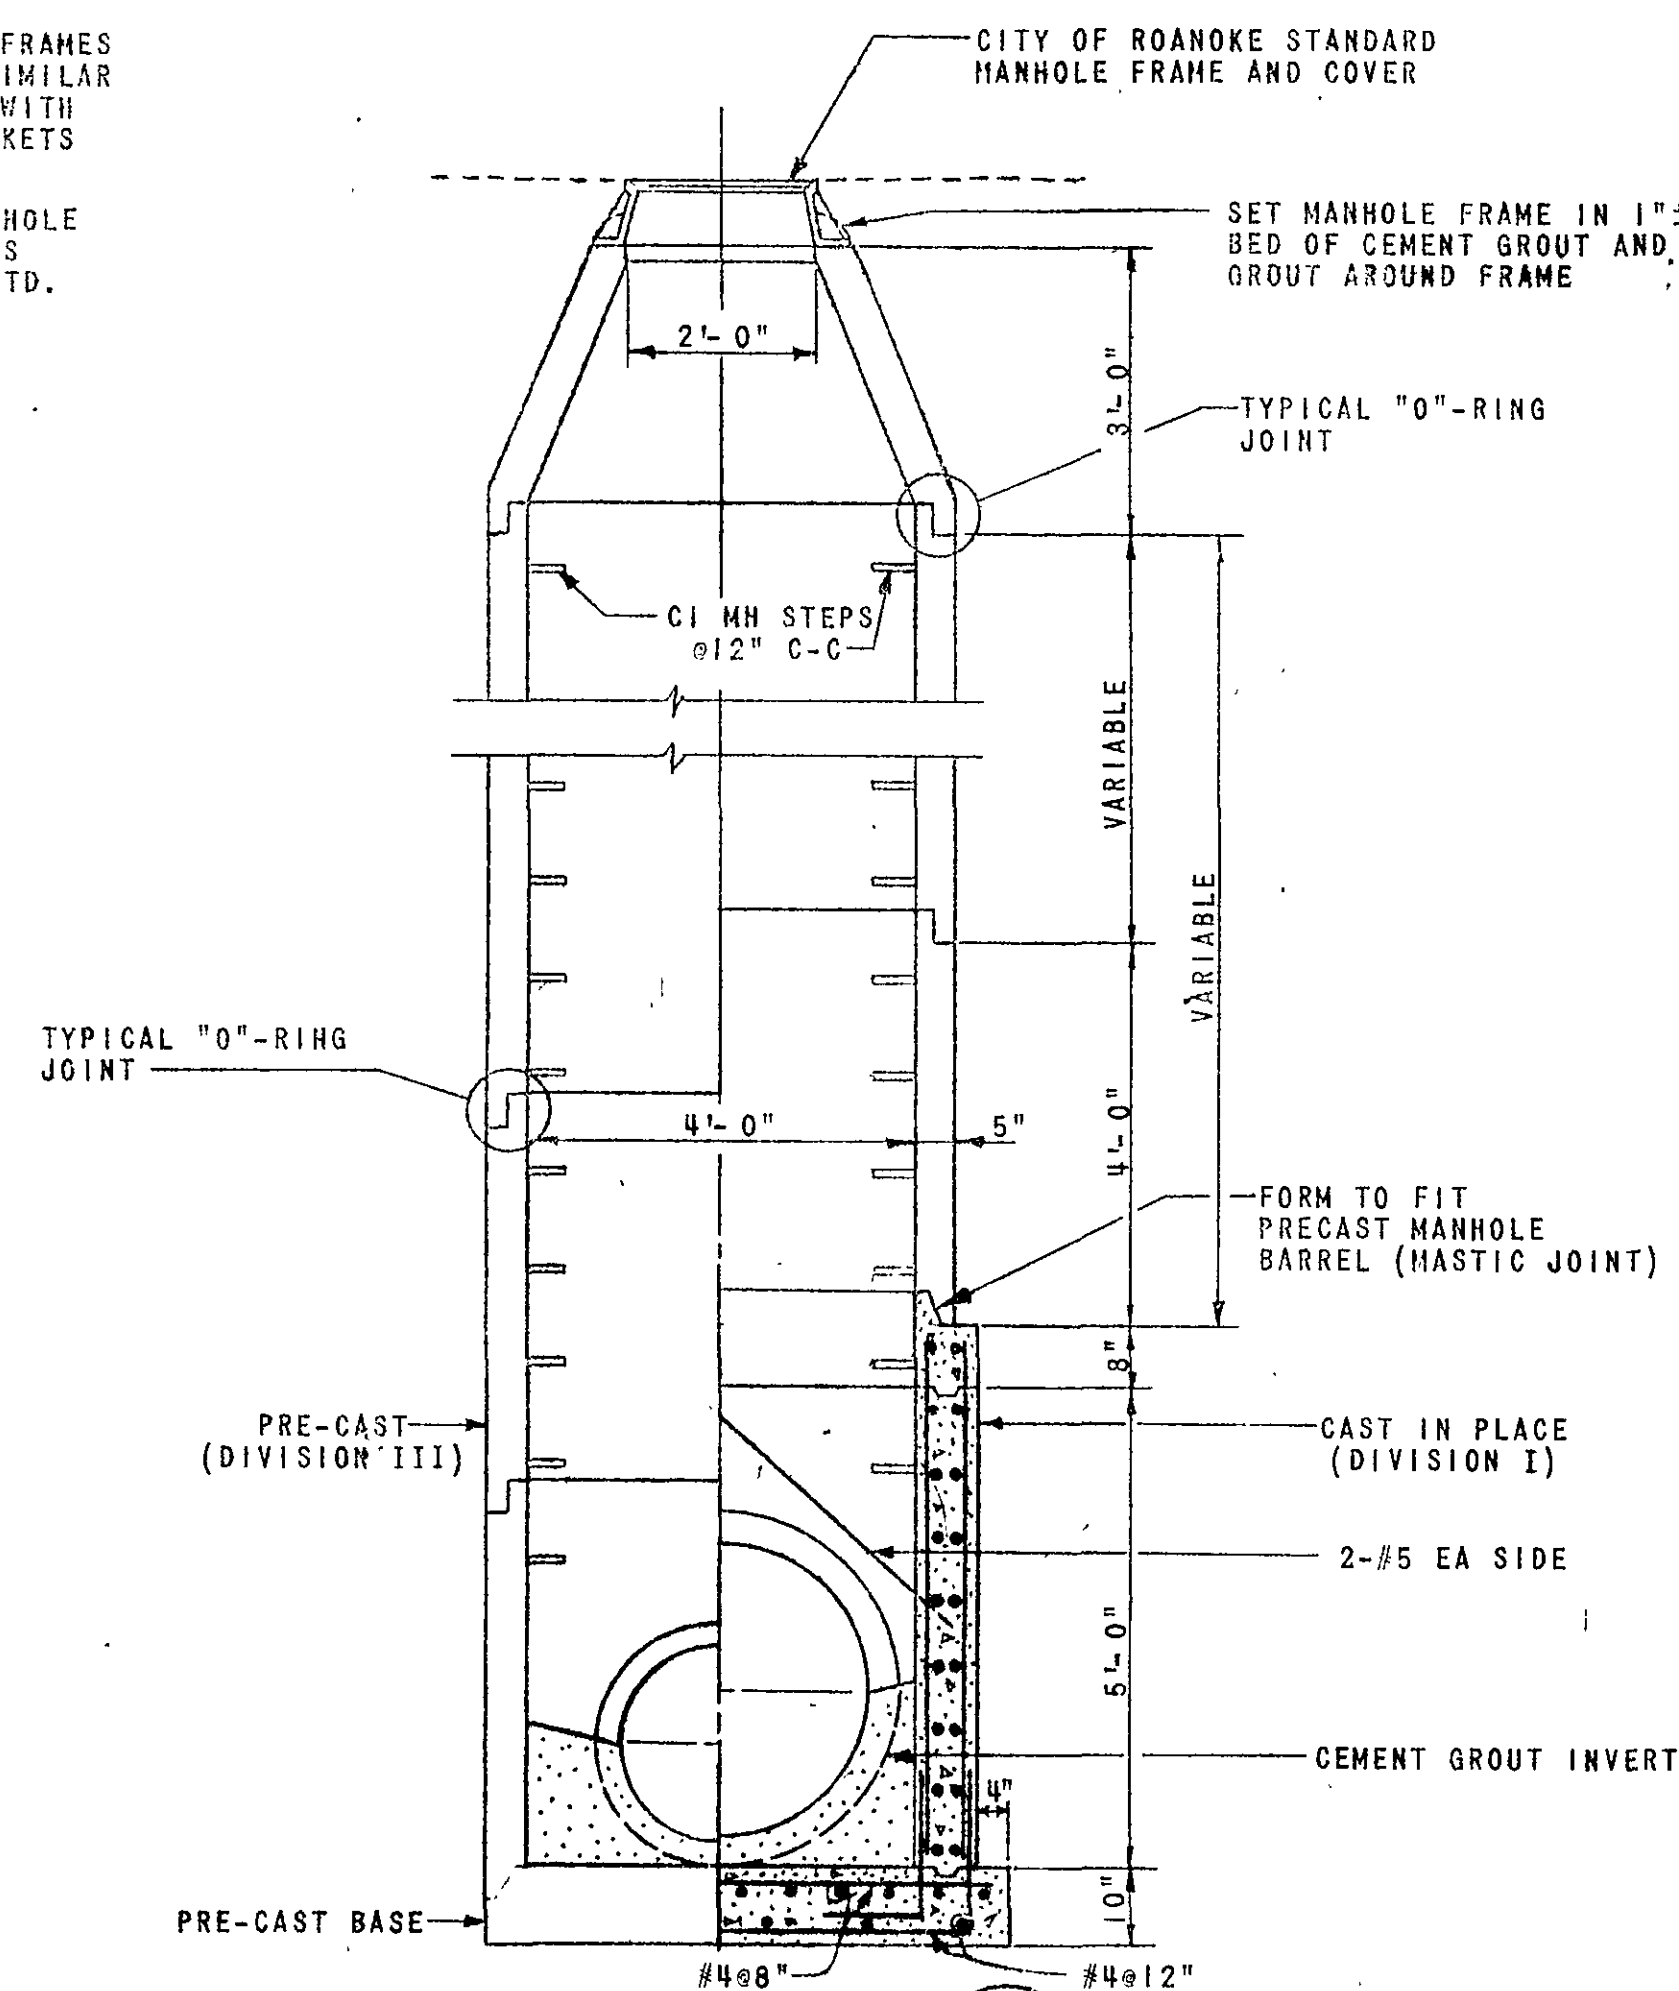

SECTION

TYPICAL MANHOLE DETAIL
SCALE: 1/2" = 1'-0"

AS BUILT

DIVISION I AND III			
1	6-21-71	AS BUILT	DMC JHR
REVISION	DATE	DESCRIPTION	BY
DESIGNED	RAJ	INTERCEPT SEWERS PROJECT NO: 1 TINKER CREEK AND LICK RUN DETAILS CITY OF ROANOKE VIRGINIA	
DRAWN	AJP		
CHECKED	MLH		
APPROVED	JMD		
SUBMITTED	GDB		
HAYES, SEAY, MATTERN & MATTERN		SCALE AS SHOWN	COMM. NO. 3262
ARCHITECTS-ENGINEERS		DATE DEC. 1967	SHEET 15 OF 18