




INDEX OF SHEETS

Sheet No.	Description
1	Title Sheet
2	Quantity Sheet
3	Index Map
4	Abbreviations & Legend
5	Sta 9 + 50 - Sta 22 + 00
6	Sta 22 + 00 - Sta 34 + 00
7	Sta 34 + 00 - Sta 49 + 00
8	Sta 49 + 00 - Sta 61 + 70
9	Sta 61 + 70 - Sta 70 + 00
10	Sta 70 + 00 - Sta 80 + 00
11	Sta 80 + 00 - Sta 91 + 00
12	Sta 91 + 00 - Sta 105 + 00
13	Sta 105 + 00 - Sta 116 + 00
14	Sta 116 + 00 - E.O.L.
15	Junction Diversion Box
16	Junction Diversion Box Sections
17	Tinker Creek Dam Sections & Details
18	MH - 31 & MH - 50 Plans & Sections
19	Siphon Outlet Chamber
20	Siphon Inlet Chamber
21	Typical Details

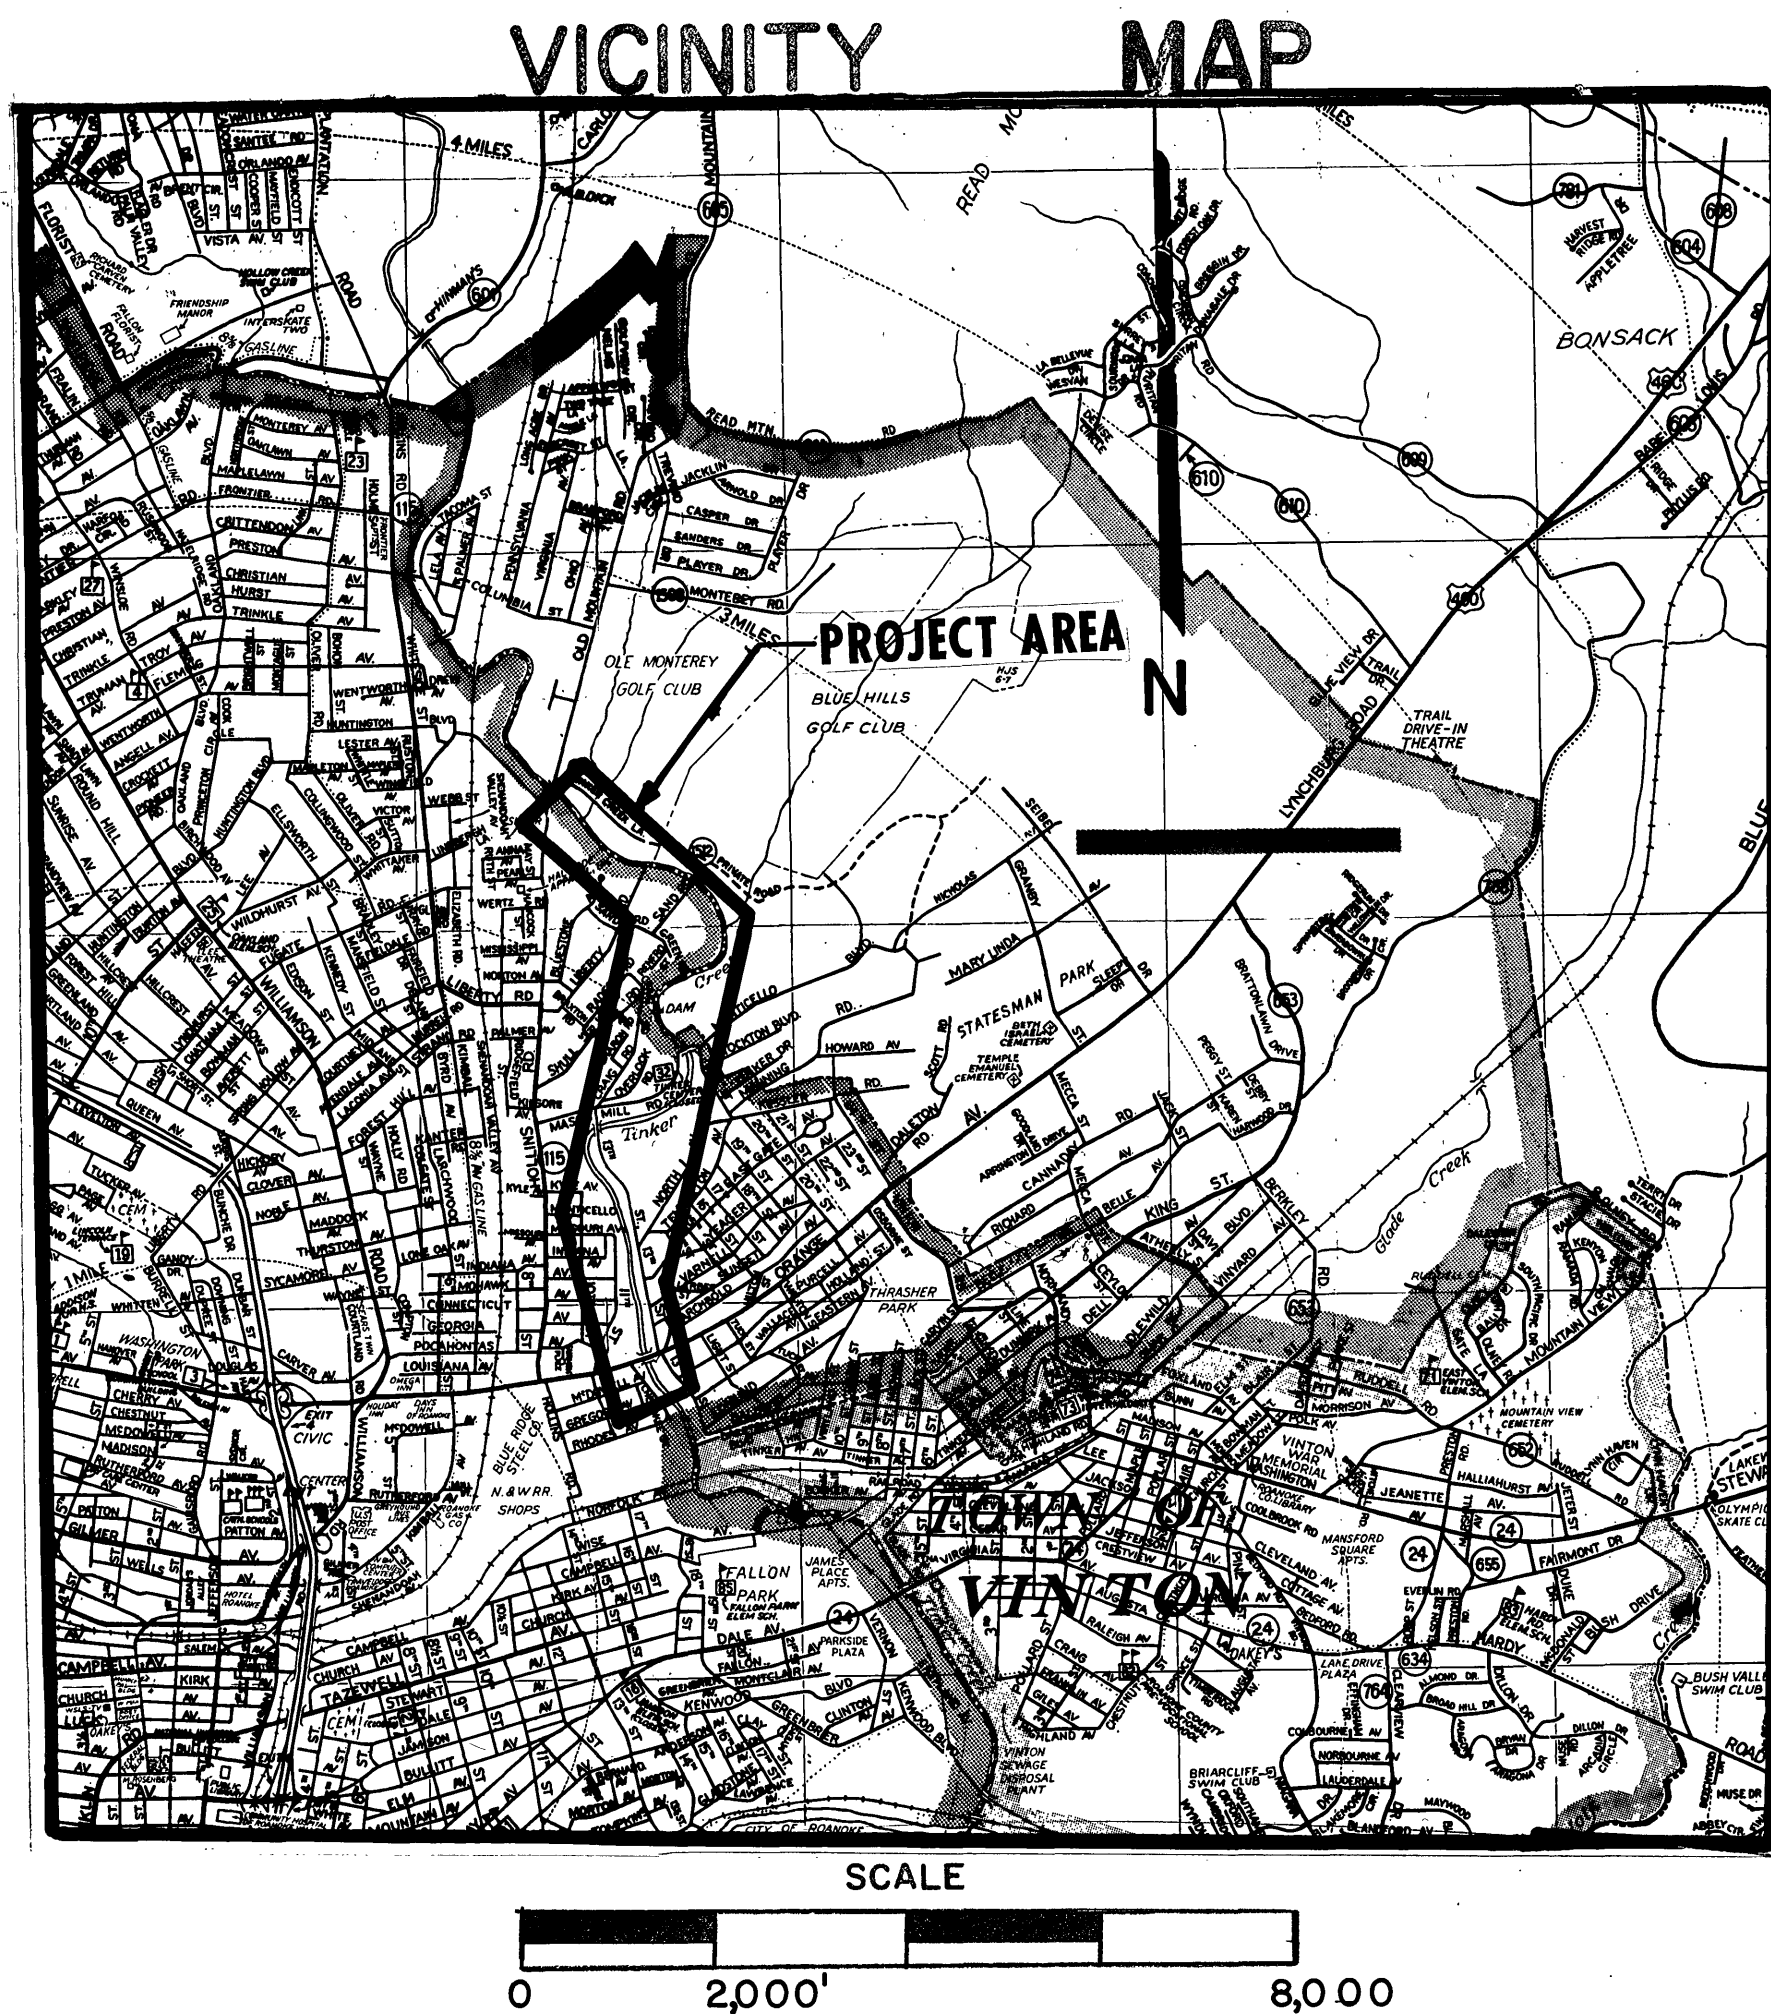

ROANOKE, VIRGINIA

OFFICE OF CITY ENGINEER
CONSTRUCTION PLAN

TINKER CREEK SANITARY SEWER INTERCEPTOR

PREPARED BY

MATTERN & CRAIG


CONSULTING ENGINEERS

ROANOKE, VIRGINIA

AS BUILT

MAY 1982

SHEET NO.	DATE	SHEET NO.	DATE
PLANS REVISED			

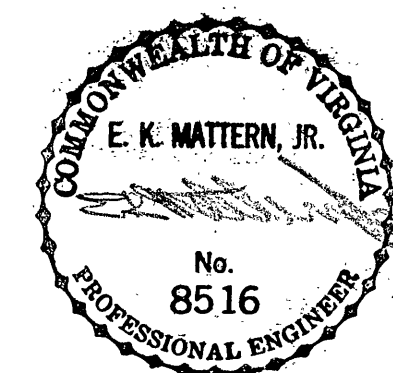

APPROVED FOR CONSTRUCTION	
DATE	CITY ENGINEER
DATE	
DATE	
APPROVED
DATE
APPROVED
DATE