




INDEX MAP

SCALE: 1"=1,000'

AS BUILT
MAY 1982

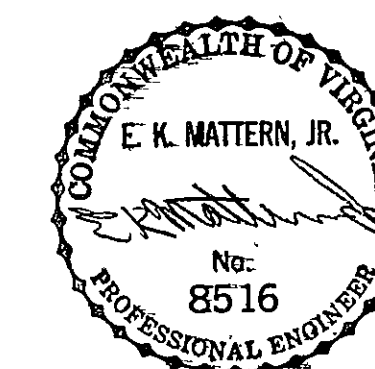

REVISION	DATE	DESCRIPTION		BY APP
DESIGNED	MTA	TINKER CREEK SANITARY SEWER INTERCEPTOR INDEX MAP CITY OF ROANOKE, VIRGINIA		
DRAWN	MTA			
CHECKED				
APPROVED	<i>[Signature]</i>			
SUBMITTED	<i>[Signature]</i>			
Mattern and Craig		SCALE: NONE	COMM. NO. 347	
CONSULTING ENGINEERS ROANOKE, VIRGINIA		DATE: OCT. 1980	SHEET 3	