


PLAN	DATE	BY	DATE	BY
SURVEYED				
NOTED				
NOTE BOOK				
NO. 1				

PROFILE	DATE	BY	DATE	BY
SURVEYED				
NOTED				
NOTE BOOK				
NO. 1				

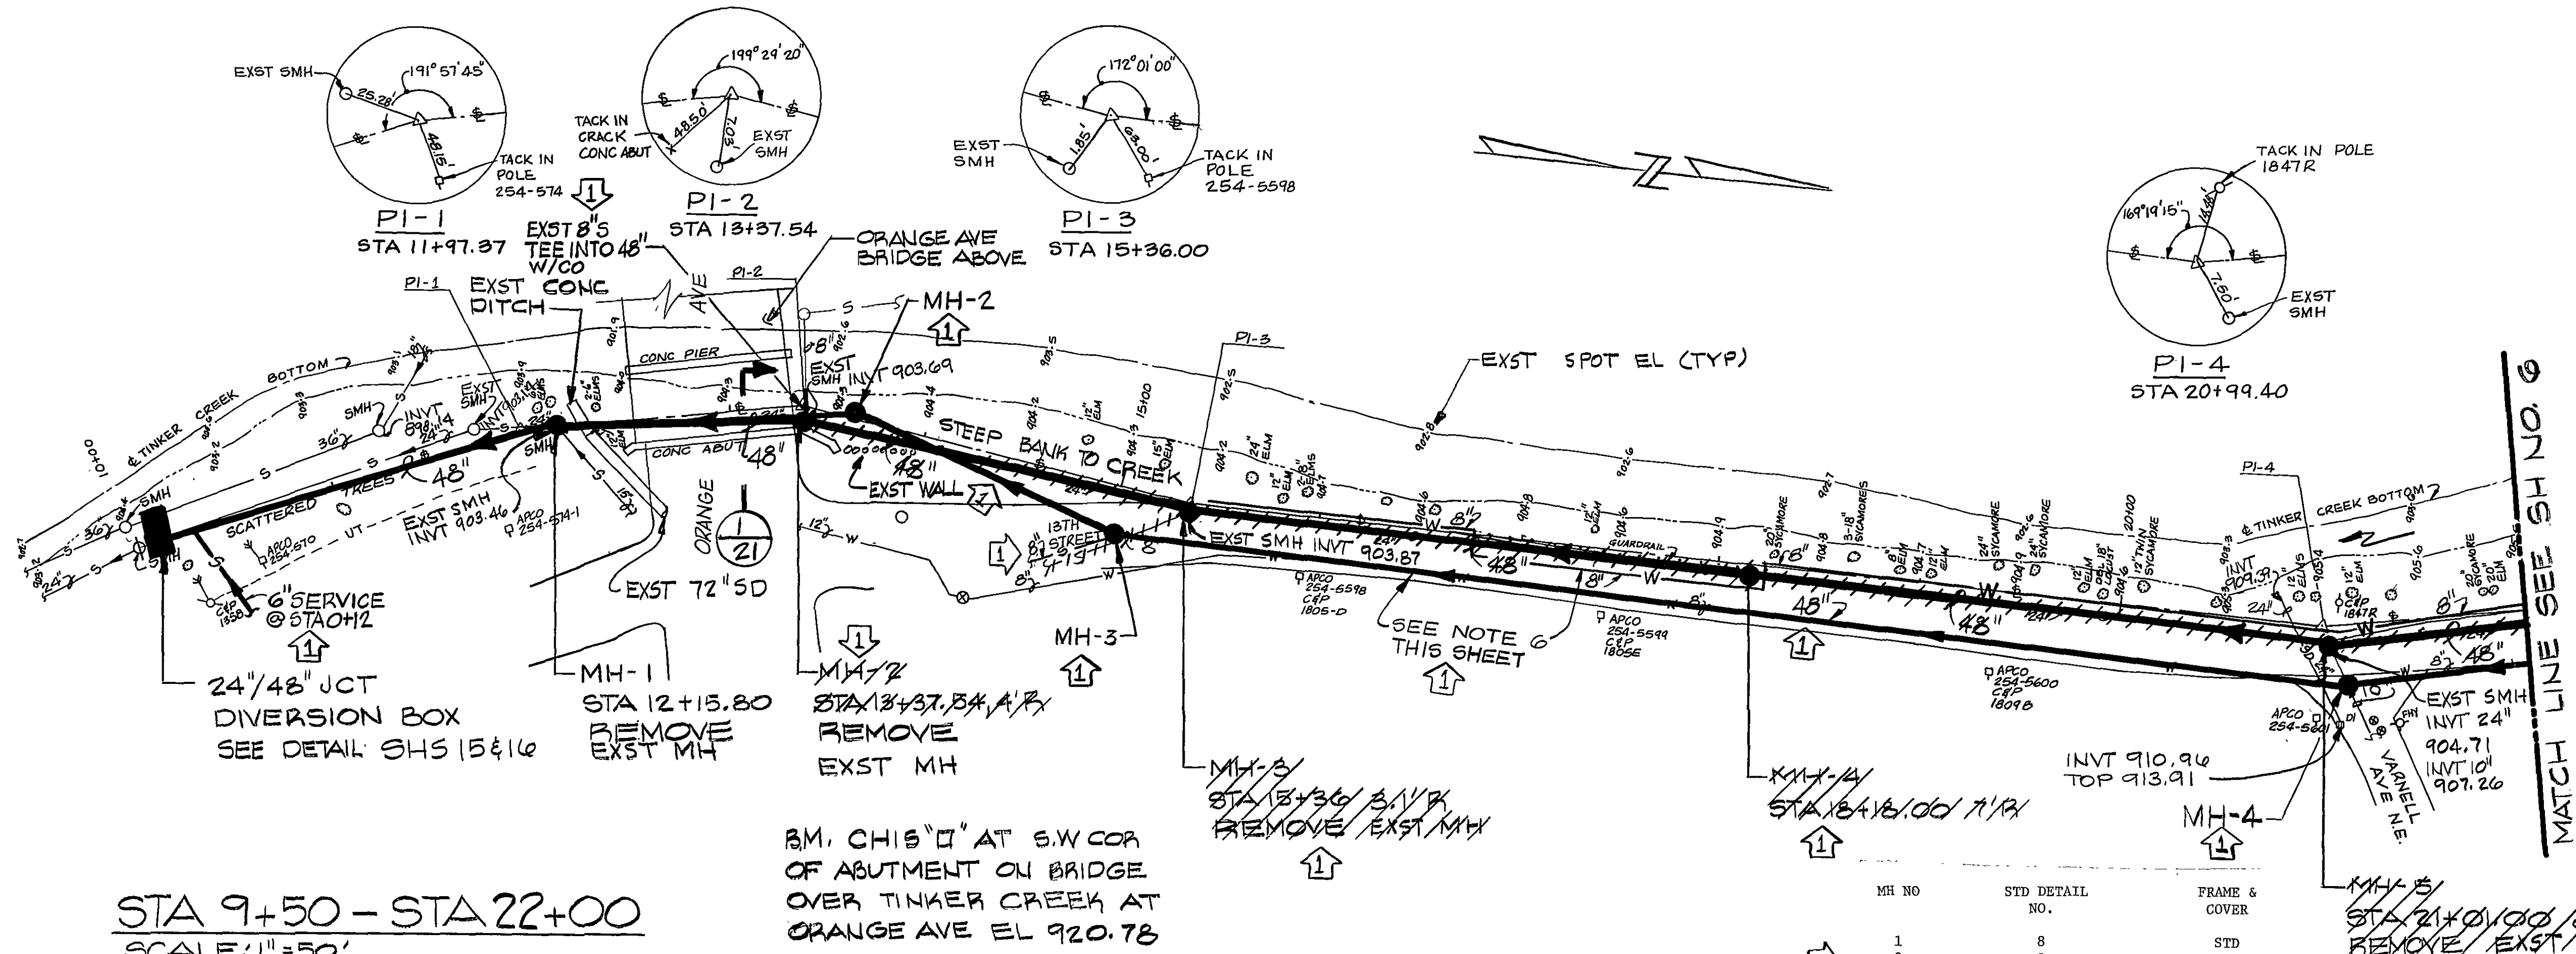


STA 9+50 - STA 22+00
SCALE: 1"=50'

BM. CHIS "O" AT S.W. COR
OF ABUTMENT ON BRIDGE
OVER TINKER CREEK AT
ORANGE AVE EL 920.78

Notes:


- (1) Exst 24" sanitary sewer shall be abandoned or removed as required for construction from just down stream of MH 1 to just upstream of MH 12. Exst manholes in this reach shall be abandoned or removed as required for construction.
- (2) The Contractor shall be required, at all times, to maintain the sewage flow and any service connections to this reach of the Tinker Creek interceptor. Bypass of sewage to adjacent waterways shall not be allowed.
- (3) 13th Street between Orange Avenue and Mason Mill Road shall be closed and Type III barricades shall be placed at Orange Avenue, Archbold Street, Varnell Avenue, East Gate Avenue, North Avenue and Mason Mill Road. Access for residences and businesses shall be maintained.
- (4) Service connections shown are based on available records. Exact number and location shall be field verified.
- (5) The surface of 13th Street, from Orange Avenue to the 13th Street Bridge, that is not disturbed by trenching, shall be provided with a bituminous surface overlay. Surface course over entire pavement width shall be placed after bituminous base course over trench has been placed flush with exst pavement surface.

(6) EXST 8" WATER LINE REMOVED FROM EAST SIDE OF 13TH STREET AND RELOCATED TO THE WEST SIDE.

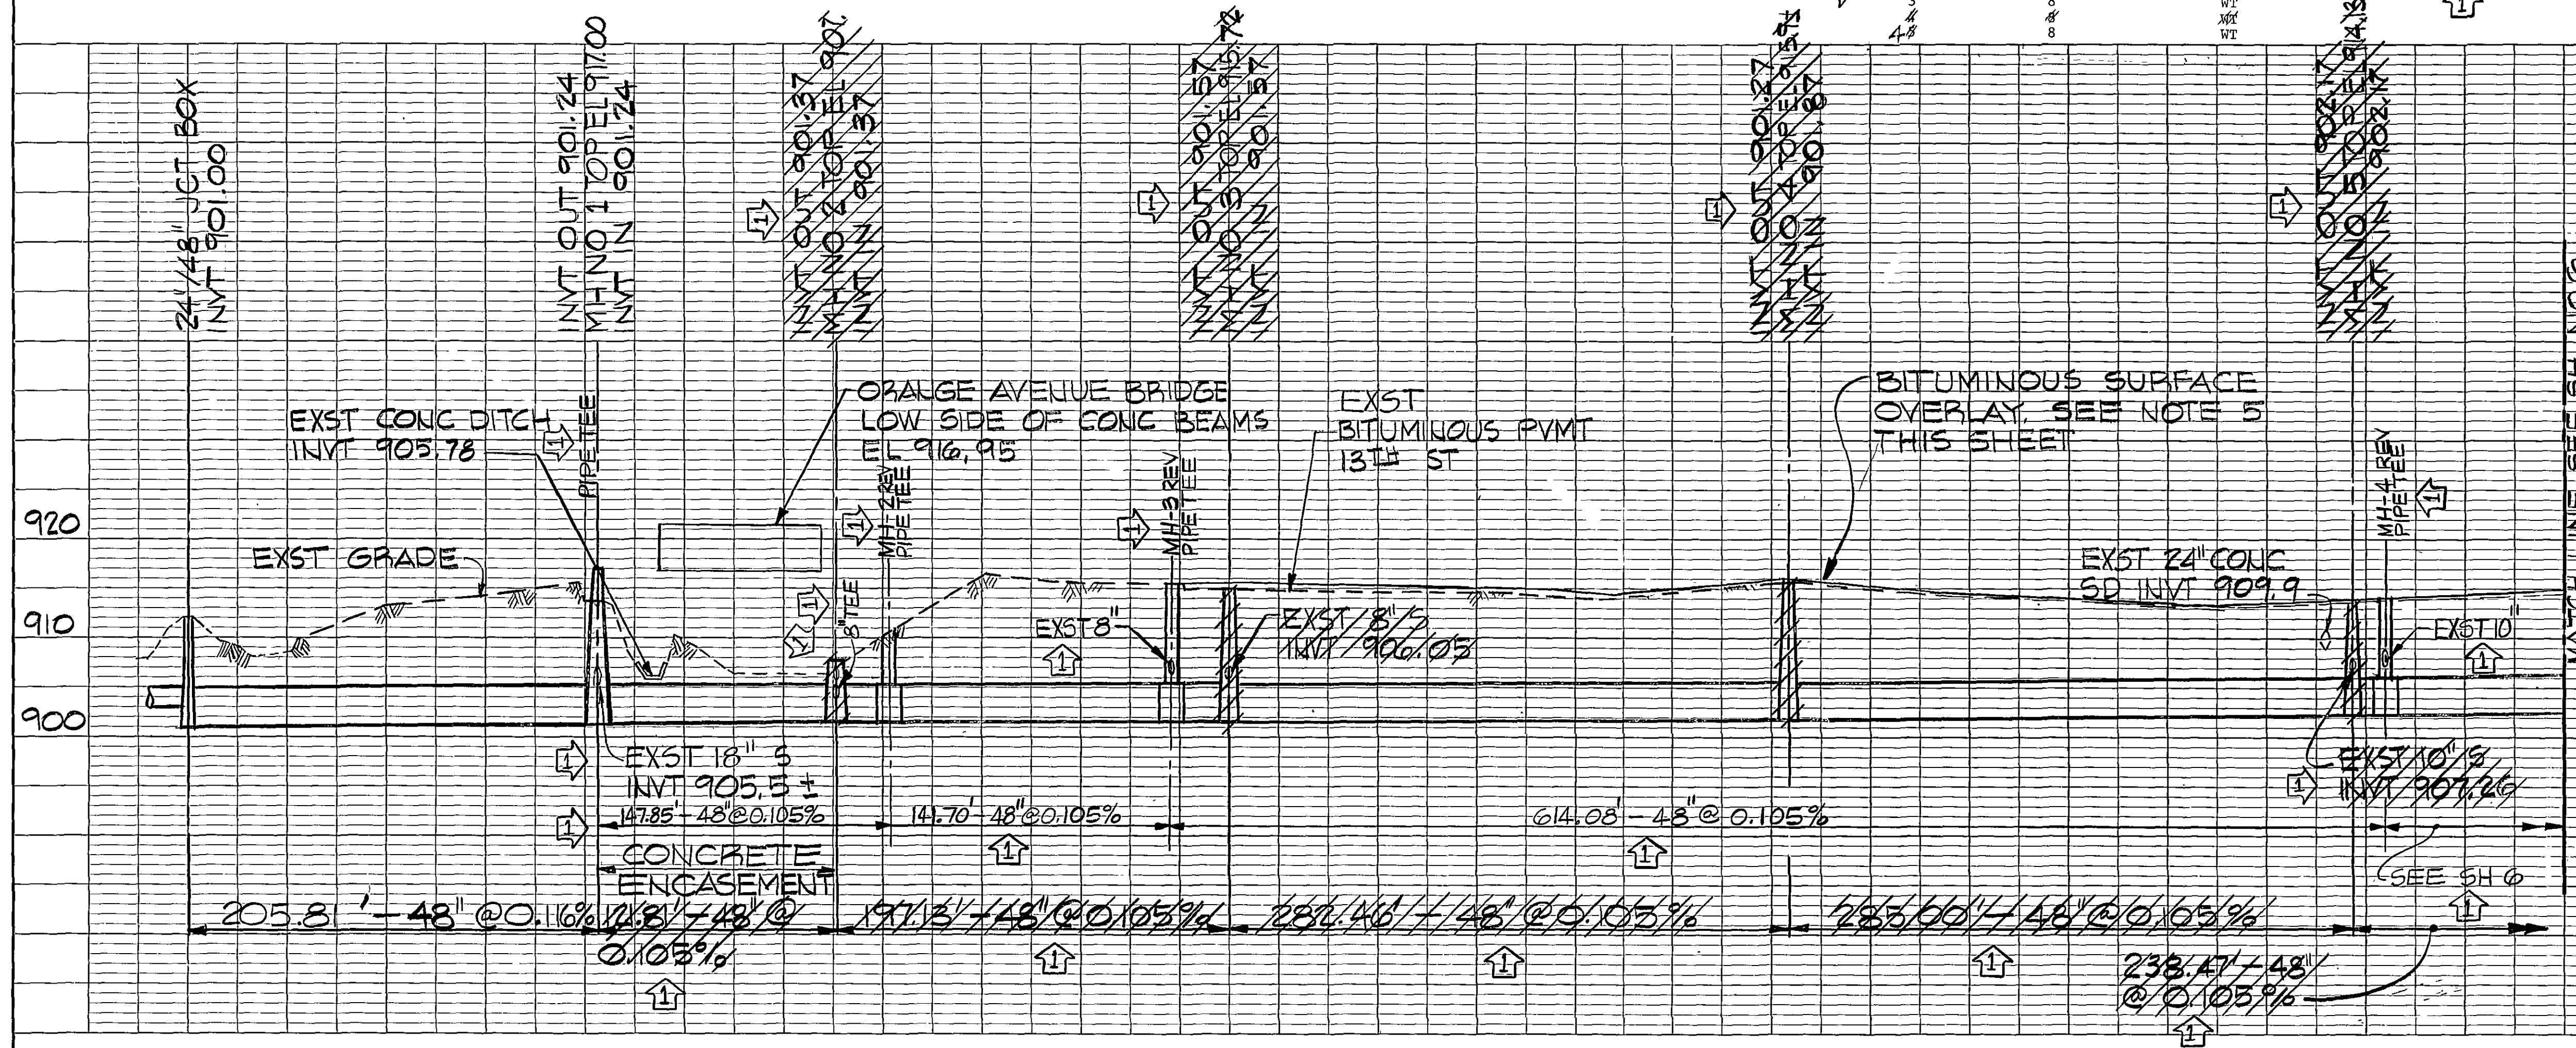

AS BUILT

MAY 1982

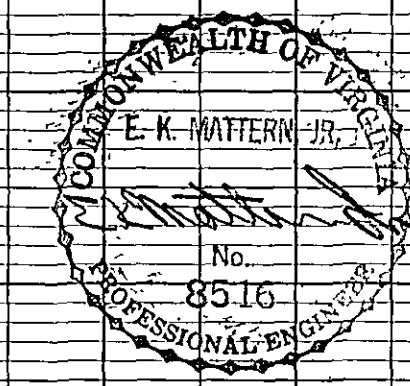

REVISION	DATE	DESCRIPTION	BY	APP
1	MAY '82	A5 BUILT	DMC	SWH
DESIGNED SWH				
DRAWN MTA				
CHECKED OMB				
APPROVED JWC				
SUBMITTED EWH				
TINKER CREEK SANITARY SEWER INTERCEPTOR				
STA 9+50-STA 22+00				
CITY OF ROANOKE, VIRGINIA				
Mattern and Craig			SCALE: AS NOTED	COMM. NO. 347
CONSULTING ENGINEERS ROANOKE, VIRGINIA			DATE: OCT 1980	SHEET 5