



PLAN	DATE
BY	
CHECKED	
NOTED	
APPROVED	
DATE	

PROFILE	DATE
BY	
CHECKED	
NOTED	
APPROVED	
DATE	

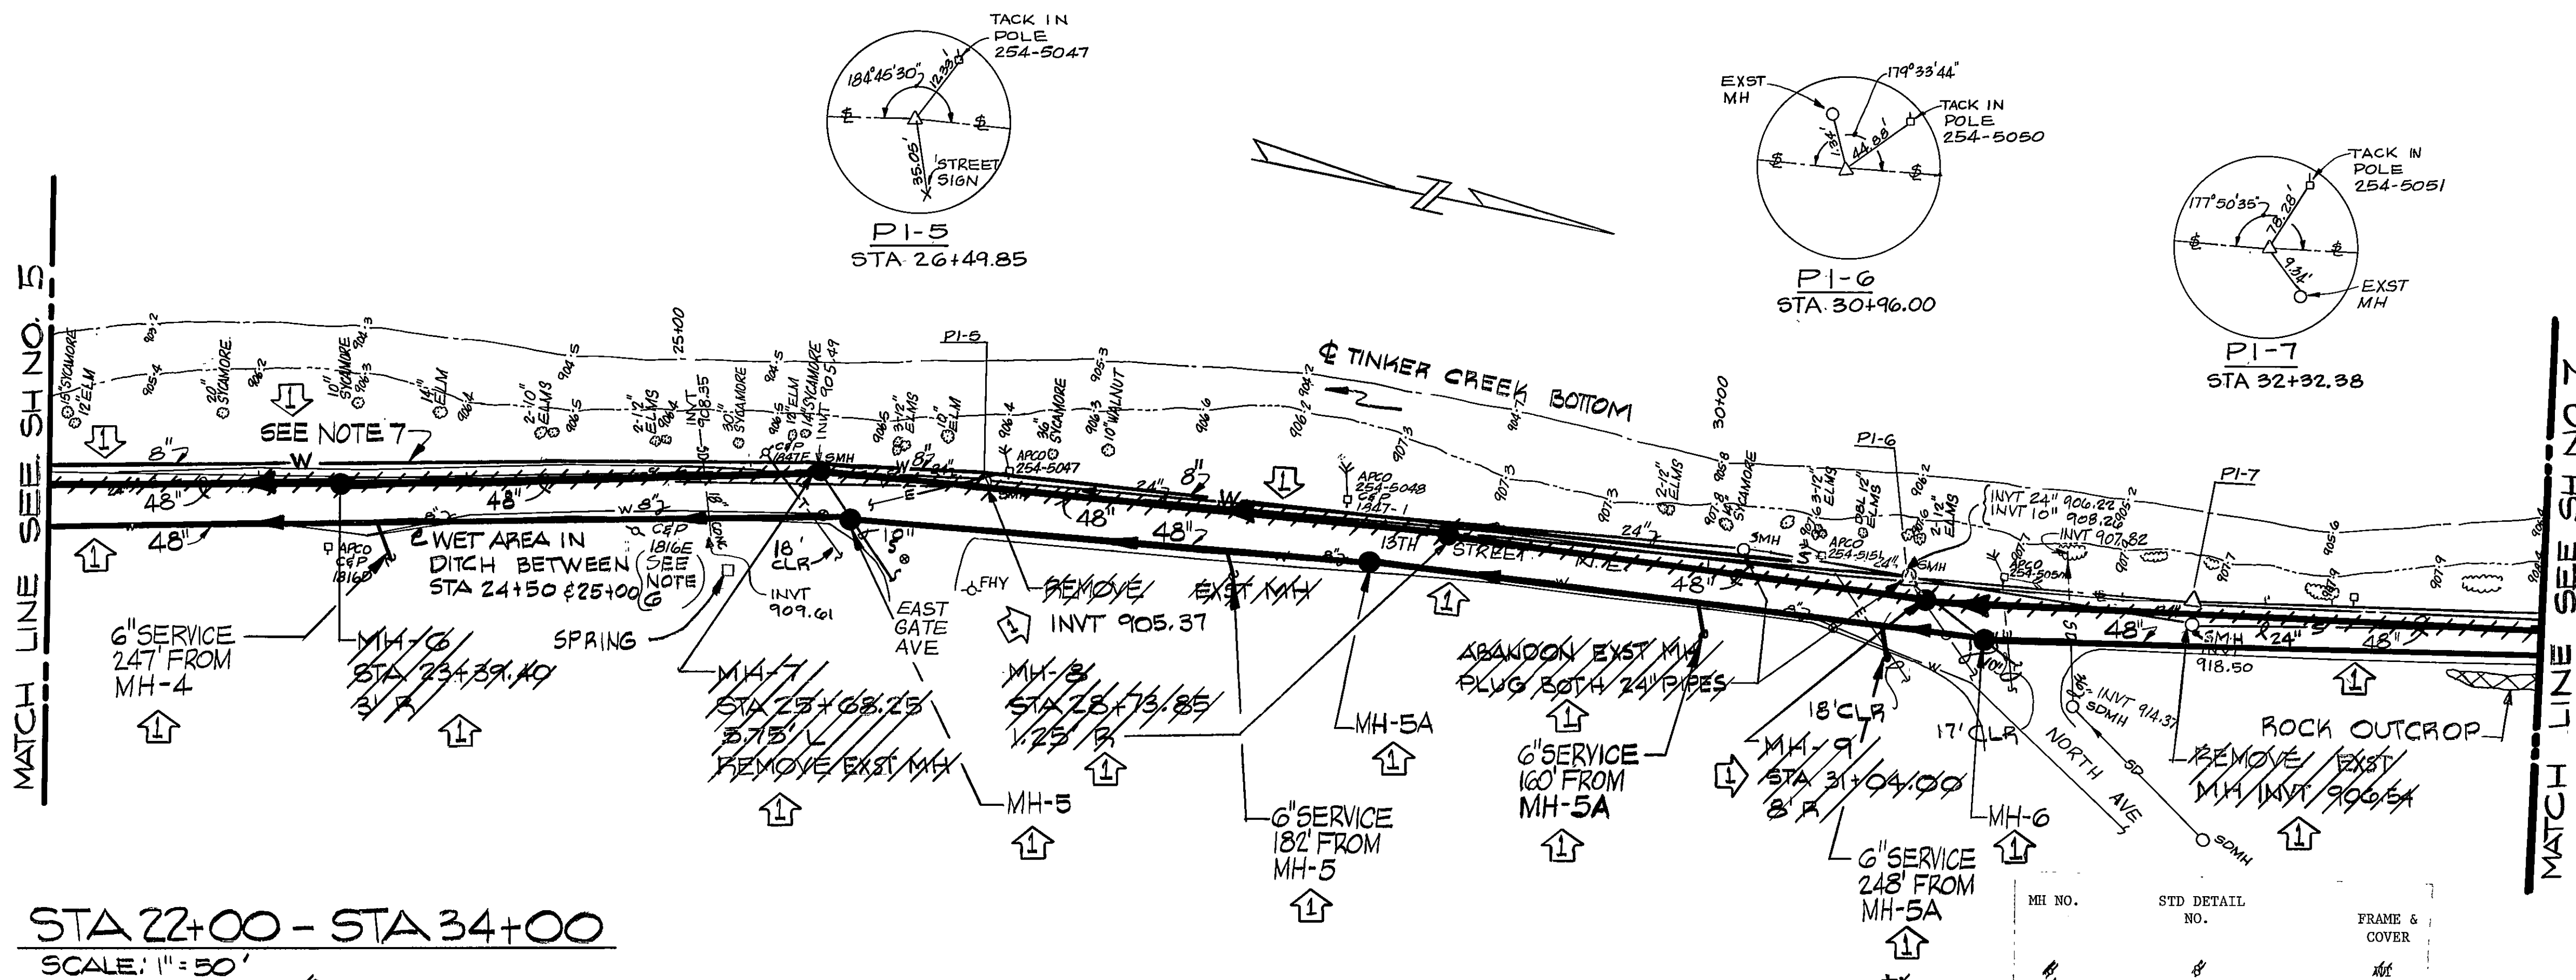

- Notes:
- (1) Exst 24" sanitary sewer shall be abandoned or removed as required for construction from just down stream of MH 1 to just upstream of MH 12. Exst manholes in this reach shall be abandoned or removed as required for construction.
 - (2) The Contractor shall be required, at all times, to maintain the sewage flow and any service connections to this reach of the Tinker Creek interceptor. Bypass of sewage to adjacent waterways shall not be allowed.
 - (3) 13th Street between Orange Avenue and Mason Mill Road shall be closed and Type III barricades shall be placed at Orange Avenue, Archbold Street, Varnell Avenue, East Gate Avenue, North Avenue and Mason Mill Road. Access for residences and businesses shall be maintained.
 - (4) Service connections shown are based on available records. Exact number and location shall be field verified.
 - (5) The surface of 13th Street, from Orange Avenue to the 13th Street Bridge, that is not disturbed by trenching, shall be provided with a bituminous surface overlay. Surface course over entire pavement width shall be placed after bituminous base course over trench has been placed flush with exst pavement surface.
 - (6) Telephone cable goes underground at this pole, location unknown.
 - (7) EXST 8" WATER LINE REMOVED FROM EAST SIDE 13TH STREET AND RELOCATED TO WEST SIDE.

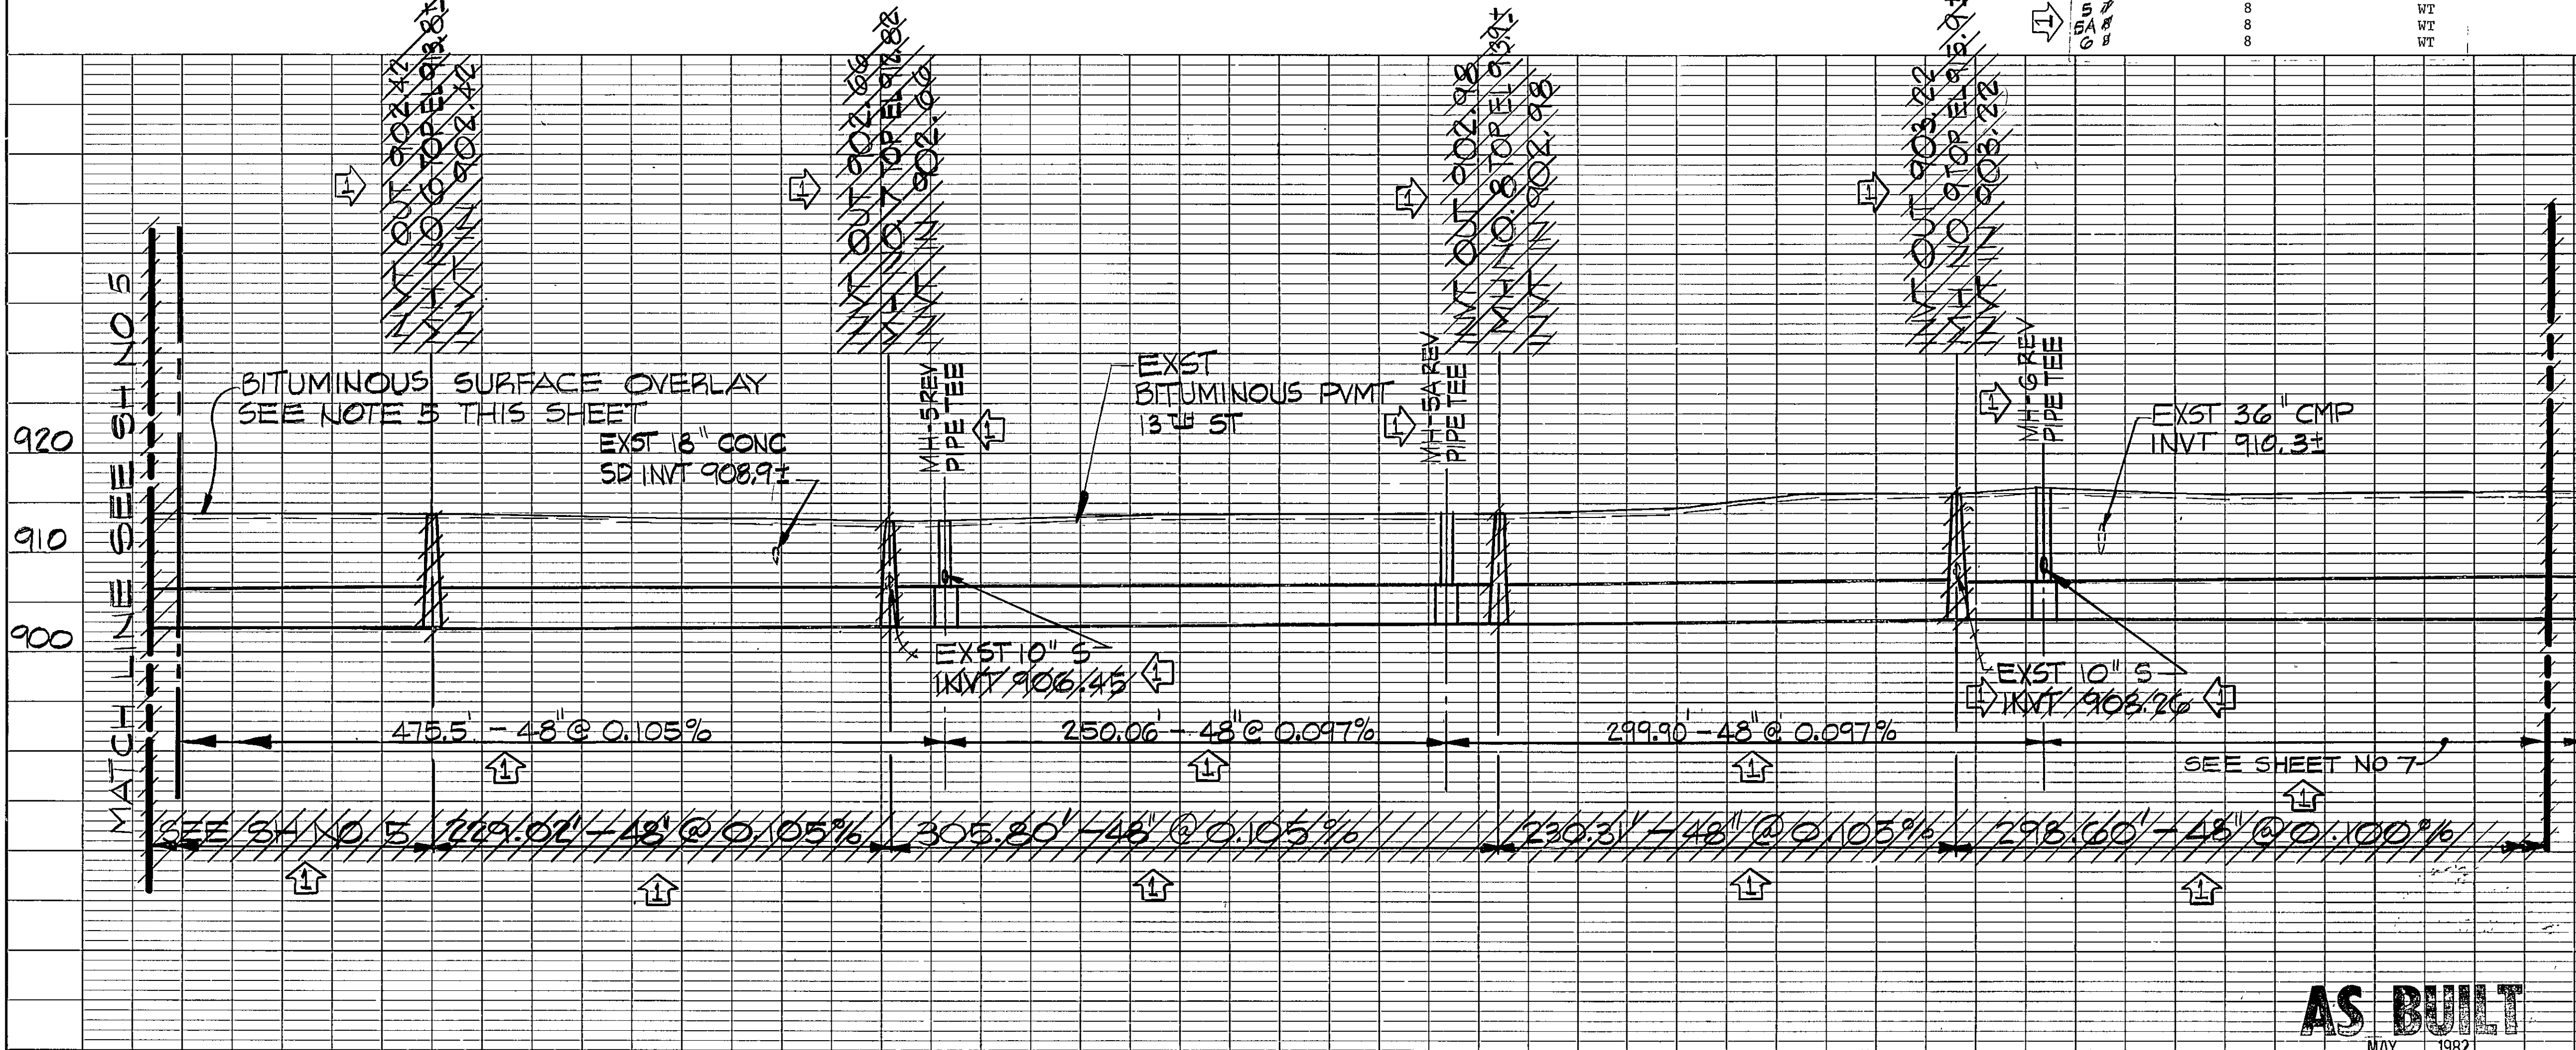

MAY 82 AS BUILT		DWG
DESIGNED	SWT	BY
DRAWN	MTA	APP
CHECKED	DWG	
APPROVED	JWC	
SUBMITTED	ECM	
TINKER CREEK SANITARY SEWER INTERCEPTOR STA 22+00—STA 34+00 CITY OF ROANOKE, VIRGINIA		
Mattern and Craig CONSULTING ENGINEERS ROANOKE, VIRGINIA		SCALE AS NOTED DATE OCT 1980 COMM. NO. 347 SHEET 6