
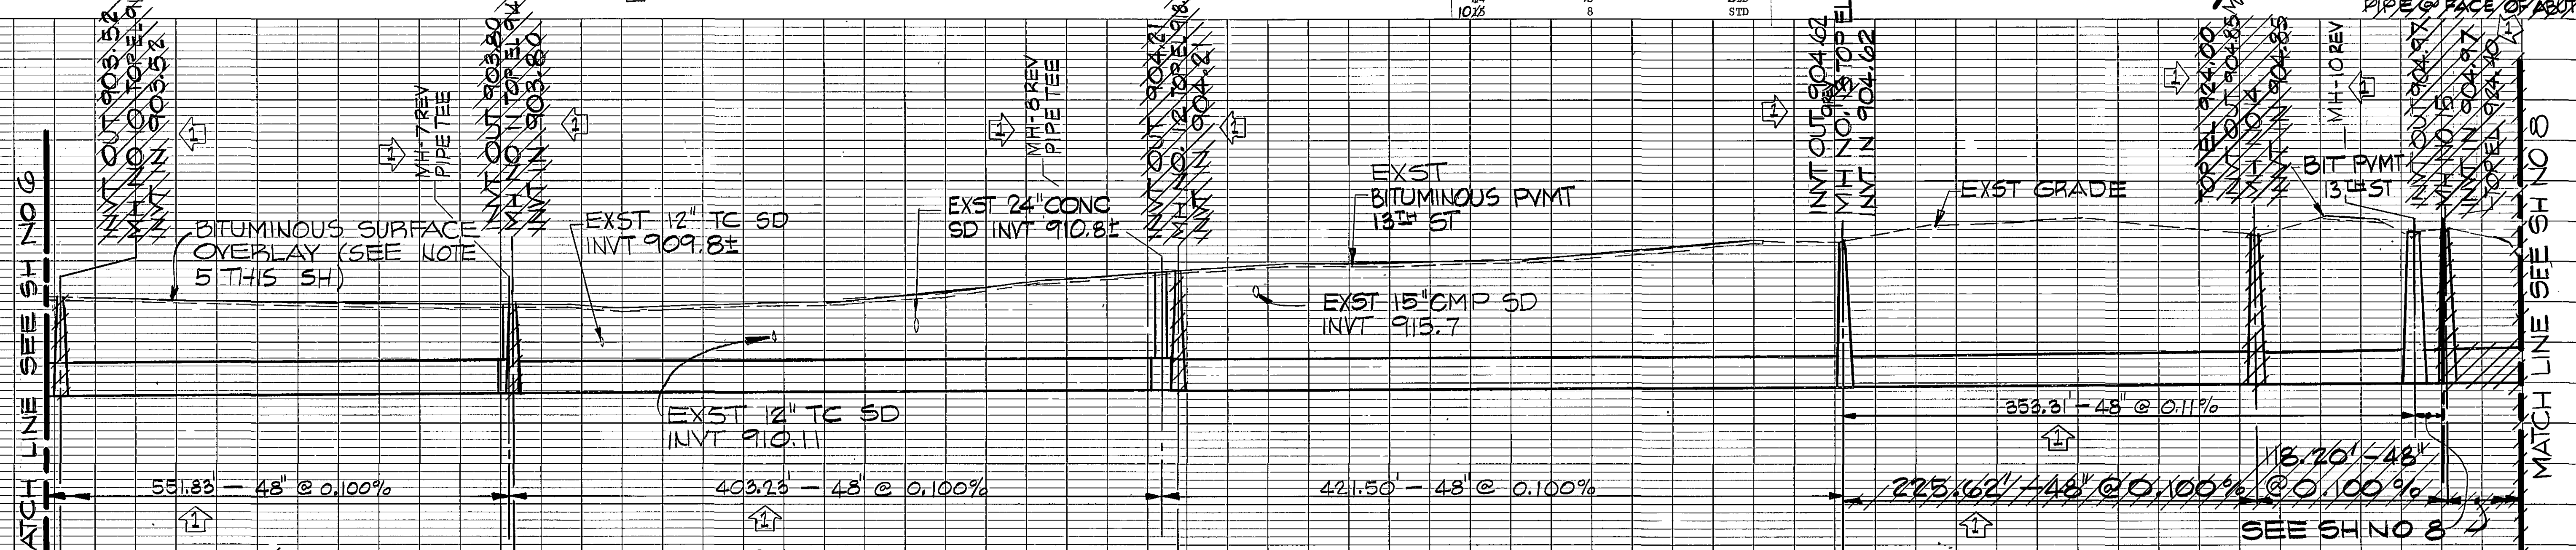


NOTES:

- (1) Exst 24" sanitary sewer shall be abandoned and removed as required for construction from just down stream of MH 1 to just upstream of MH 12. Exst manholes in this reach shall be abandoned or removed as required for construction.
- (2) The Contractor shall be required, at all times, to maintain the sewage flow and any service connections to this reach of the Tinker Creek interceptor. Bypass of sewage to adjacent waterways shall not be allowed.
- (3) 13th Street between Orange Avenue and Mason Mill Road shall be closed and Type III barricades shall be placed at Orange Avenue, Archbold Street, Varnell Avenue, East Gate Avenue, North Avenue and Mason Mill Road. Access for residences and businesses shall be maintained.
- (4) Service connections shown are based on available records. Exact number and location shall be field verified.
- (5) The surface of 13th Street, from Orange Avenue to the 13th Street Bridge, that is not disturbed by trenching, shall be provided with a bituminous surface overlay. Surface course over entire pavement width shall be placed after bituminous base course over trench has been placed flush with exst pavement surface.

PLAN	DATE	BY	DATE	BY
NO. 1				
NO. 2				
NO. 3				
NO. 4				
NO. 5				
NO. 6				
NO. 7				
NO. 8				
NO. 9				
NO. 10				

PROFILE	DATE	BY	DATE	BY
NO. 1				
NO. 2				
NO. 3				
NO. 4				
NO. 5				
NO. 6				
NO. 7				
NO. 8				
NO. 9				
NO. 10				

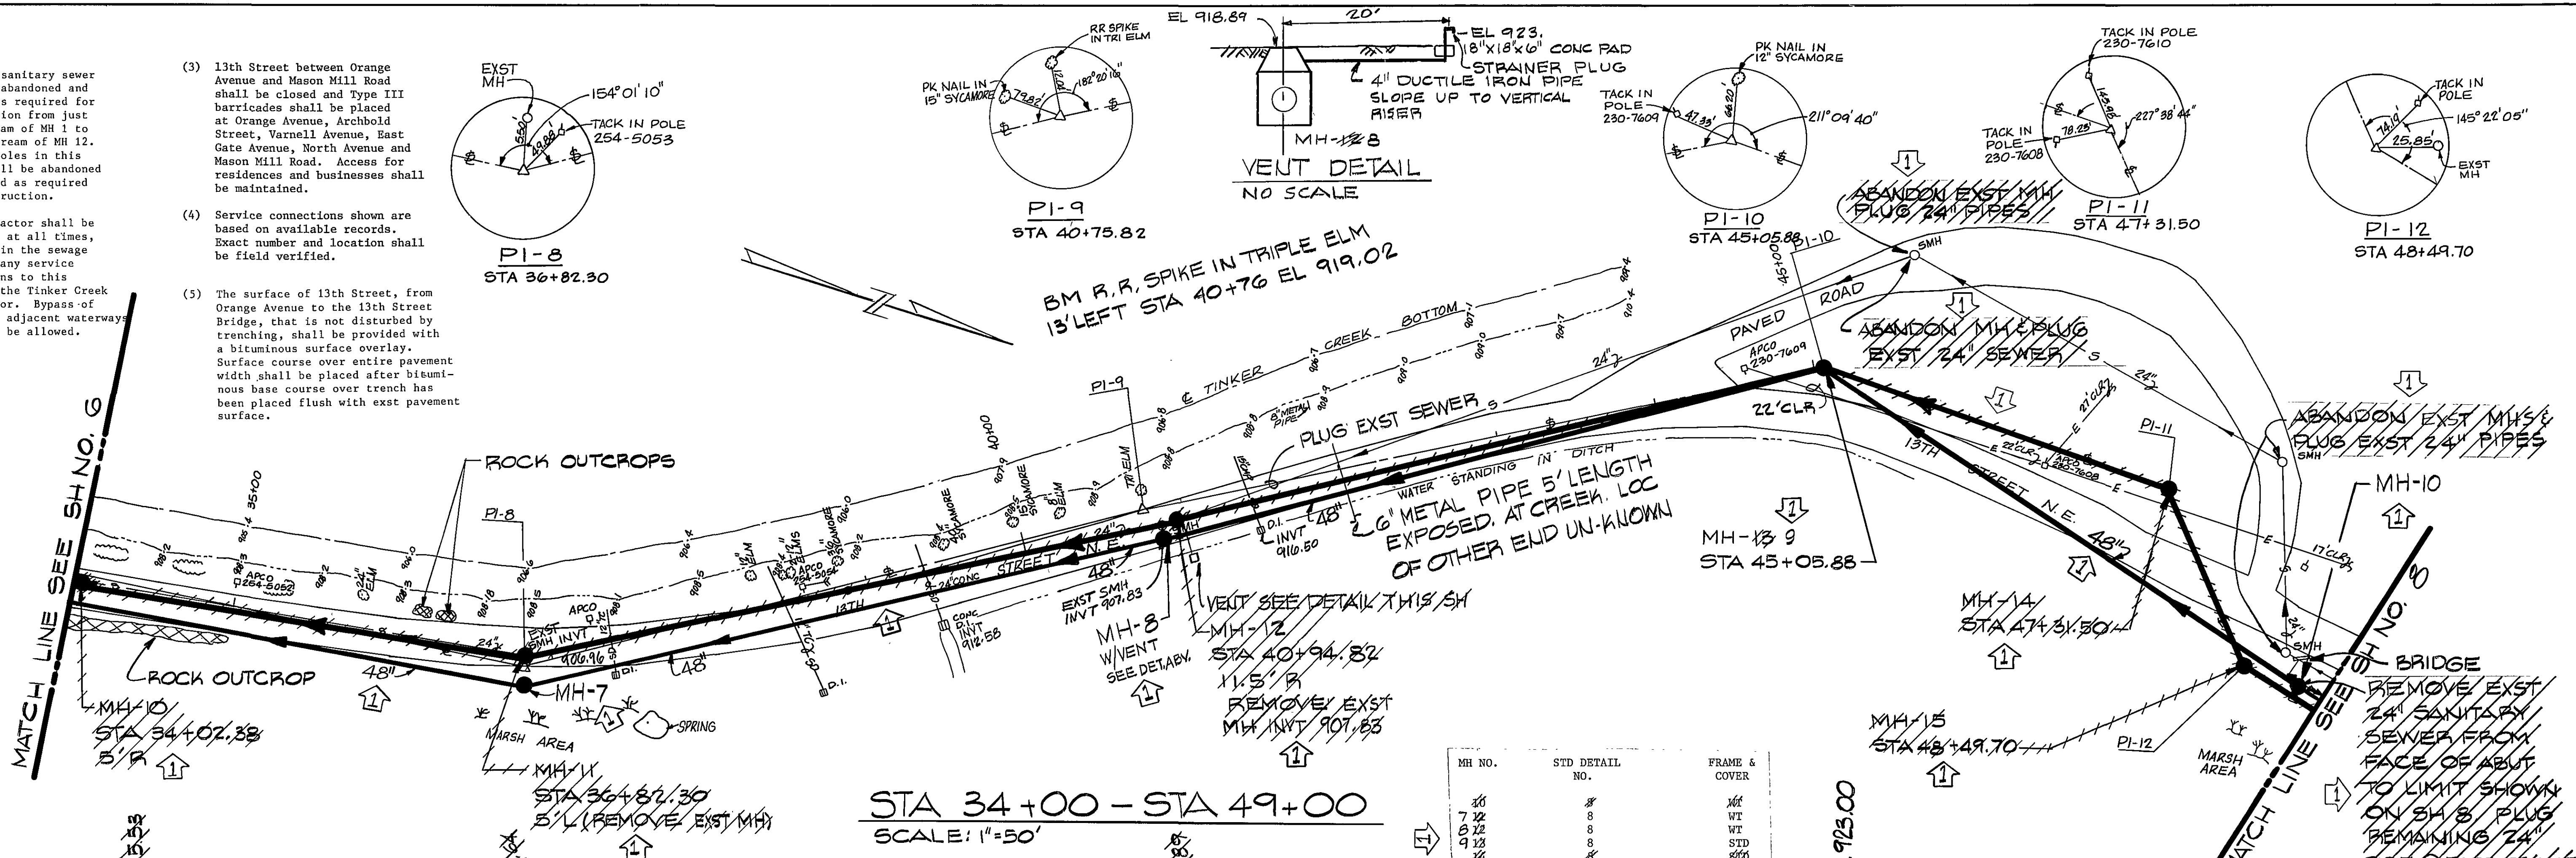

AS BUILT
MAY 1982

REVISION	DATE	DESCRIPTION	BY	APP
1	MAY '82	AS BUILT	DMC	SWH
DESIGNED	SWH	TINKER CREEK SANITARY SEWER INTERCEPTOR STA 34+00-STA 49+00 CITY OF ROANOKE, VIRGINIA		
DRAWN	MTA			
CHECKED	DMC			
APPROVED	JWC			
SUBMITTED	SWH	Mattern and Craig CONSULTING ENGINEERS ROANOKE, VIRGINIA		
SCALE: AS NOTED		COMM. NO. 347		
DATE: OCT. 1980		SHEET 7		