

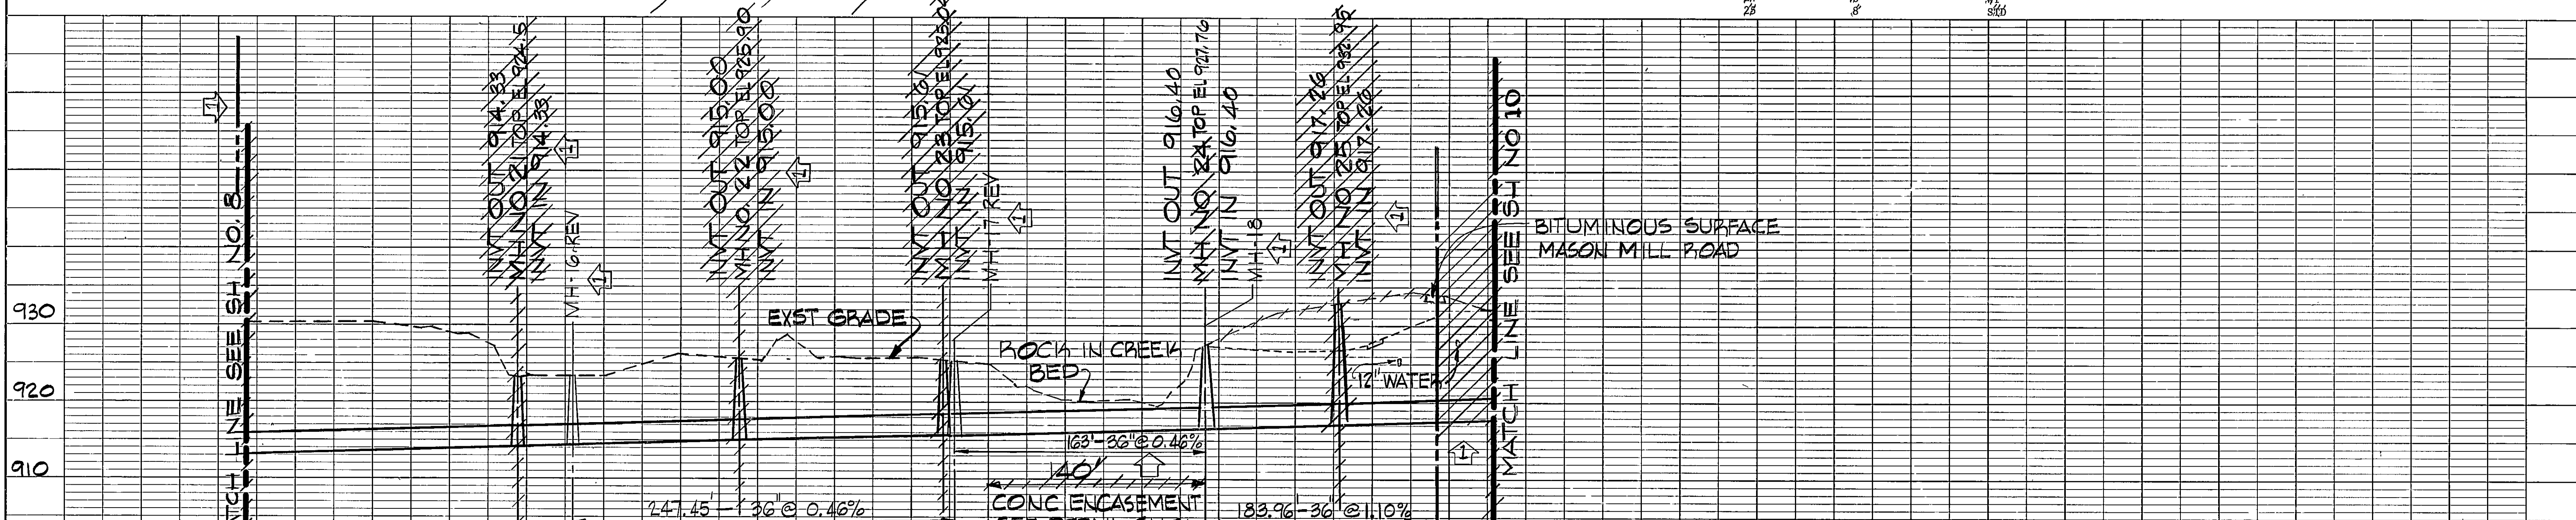


PLAN	DATE	BY	REVISION	NO.
NO. 1				
NO. 2				
NO. 3				
NO. 100				

PROFILE	DATE	BY	REVISION	NO.
NO. 1				
NO. 2				
NO. 3				
NO. 100				

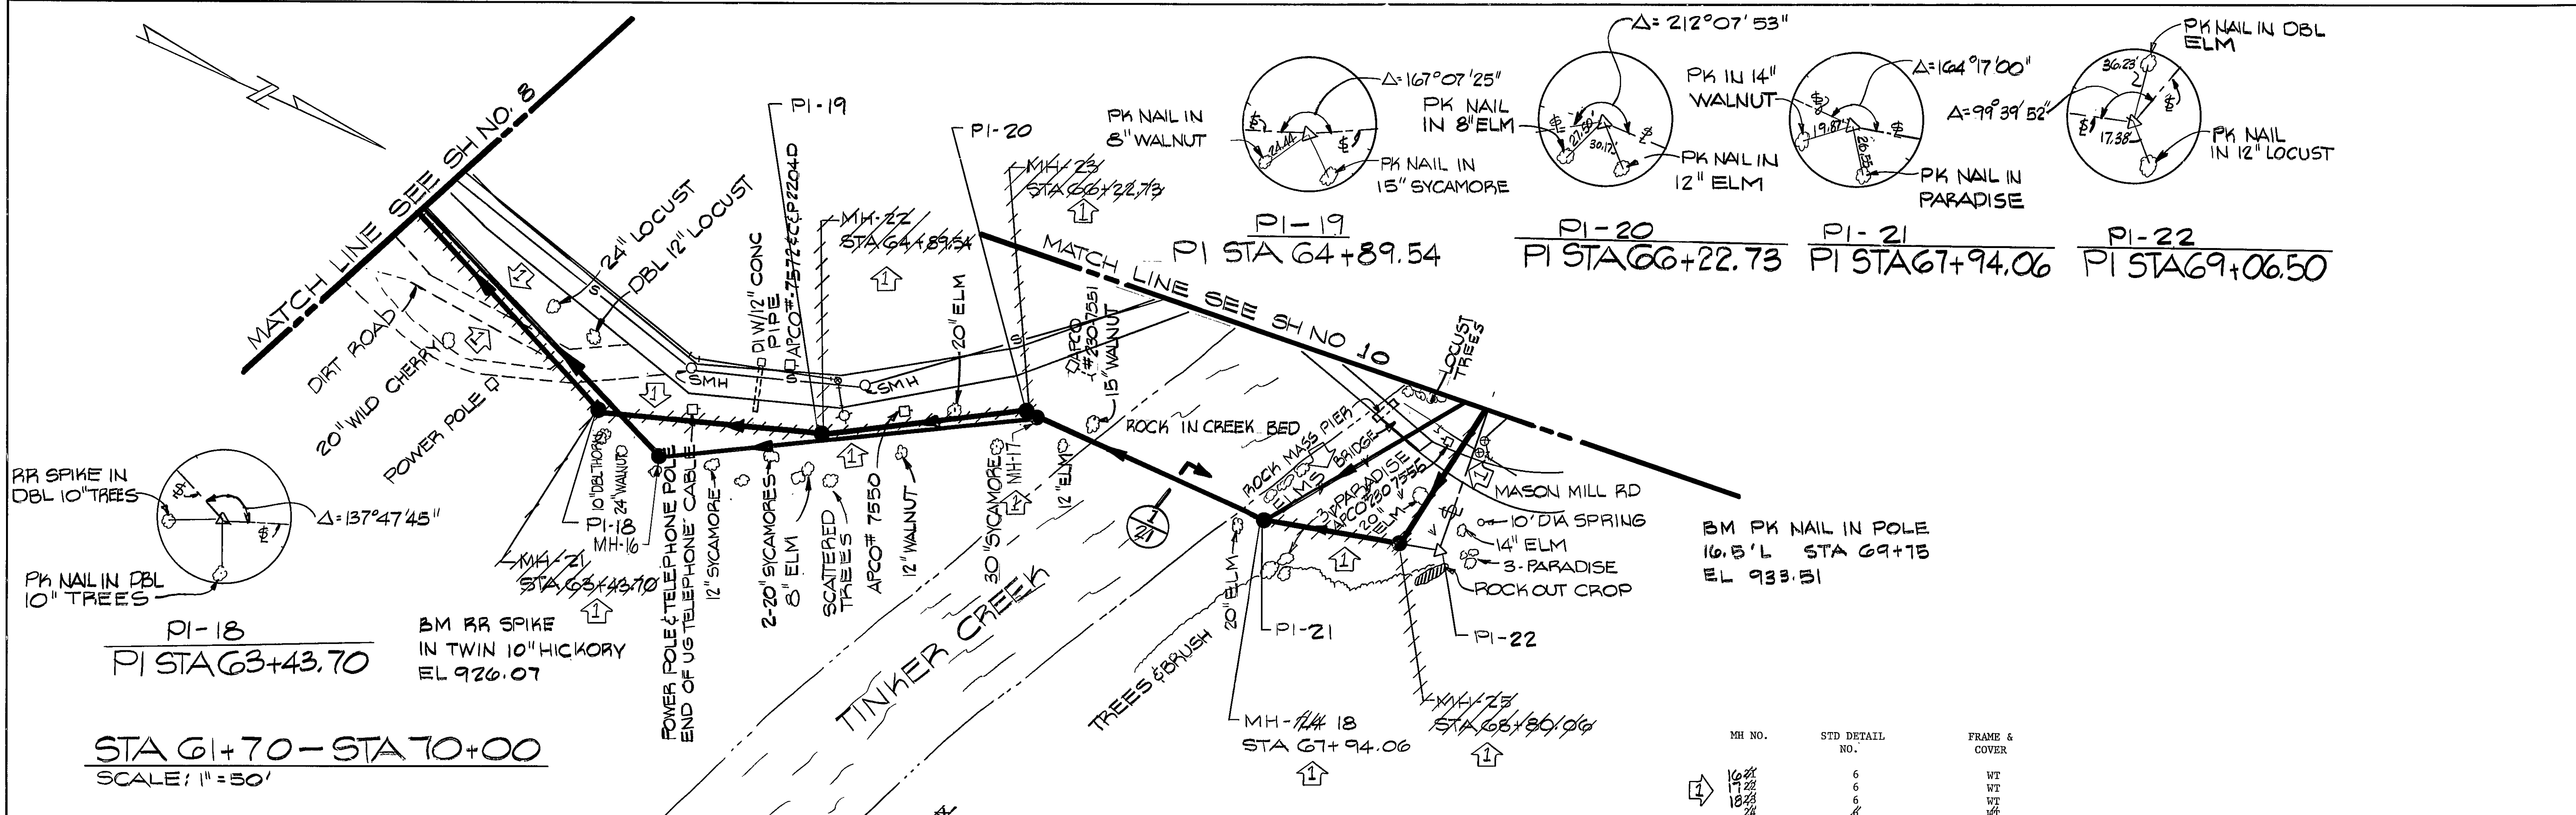

AS BUILT
MAY 1982

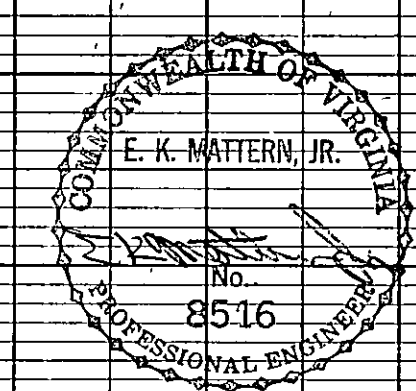

DESIGNED	SWH	DATE	MAY 82	DESCRIPTION	A5 BUILT	BY	DMC	APP	SWH
DRAWN	MTA	CHECKED	DMC	TINKER CREEK SANITARY SEWER INTERCEPTOR STA 61+70—STA 70+00 CITY OF ROANOKE, VIRGINIA					
APPROVED	JWC	SUBMITTED	DMC						
Mattern and Craig CONSULTING ENGINEERS ROANOKE, VIRGINIA				SCALE	AS NOTED	COMM. NO.	347	SHEET	9
				DATE	OCT 1980				