


PLAN	DATE	
	BY	
	SAVED	
	NOTED	

PROFILE	DATE	
	BY	
	SAVED	
	NOTED	

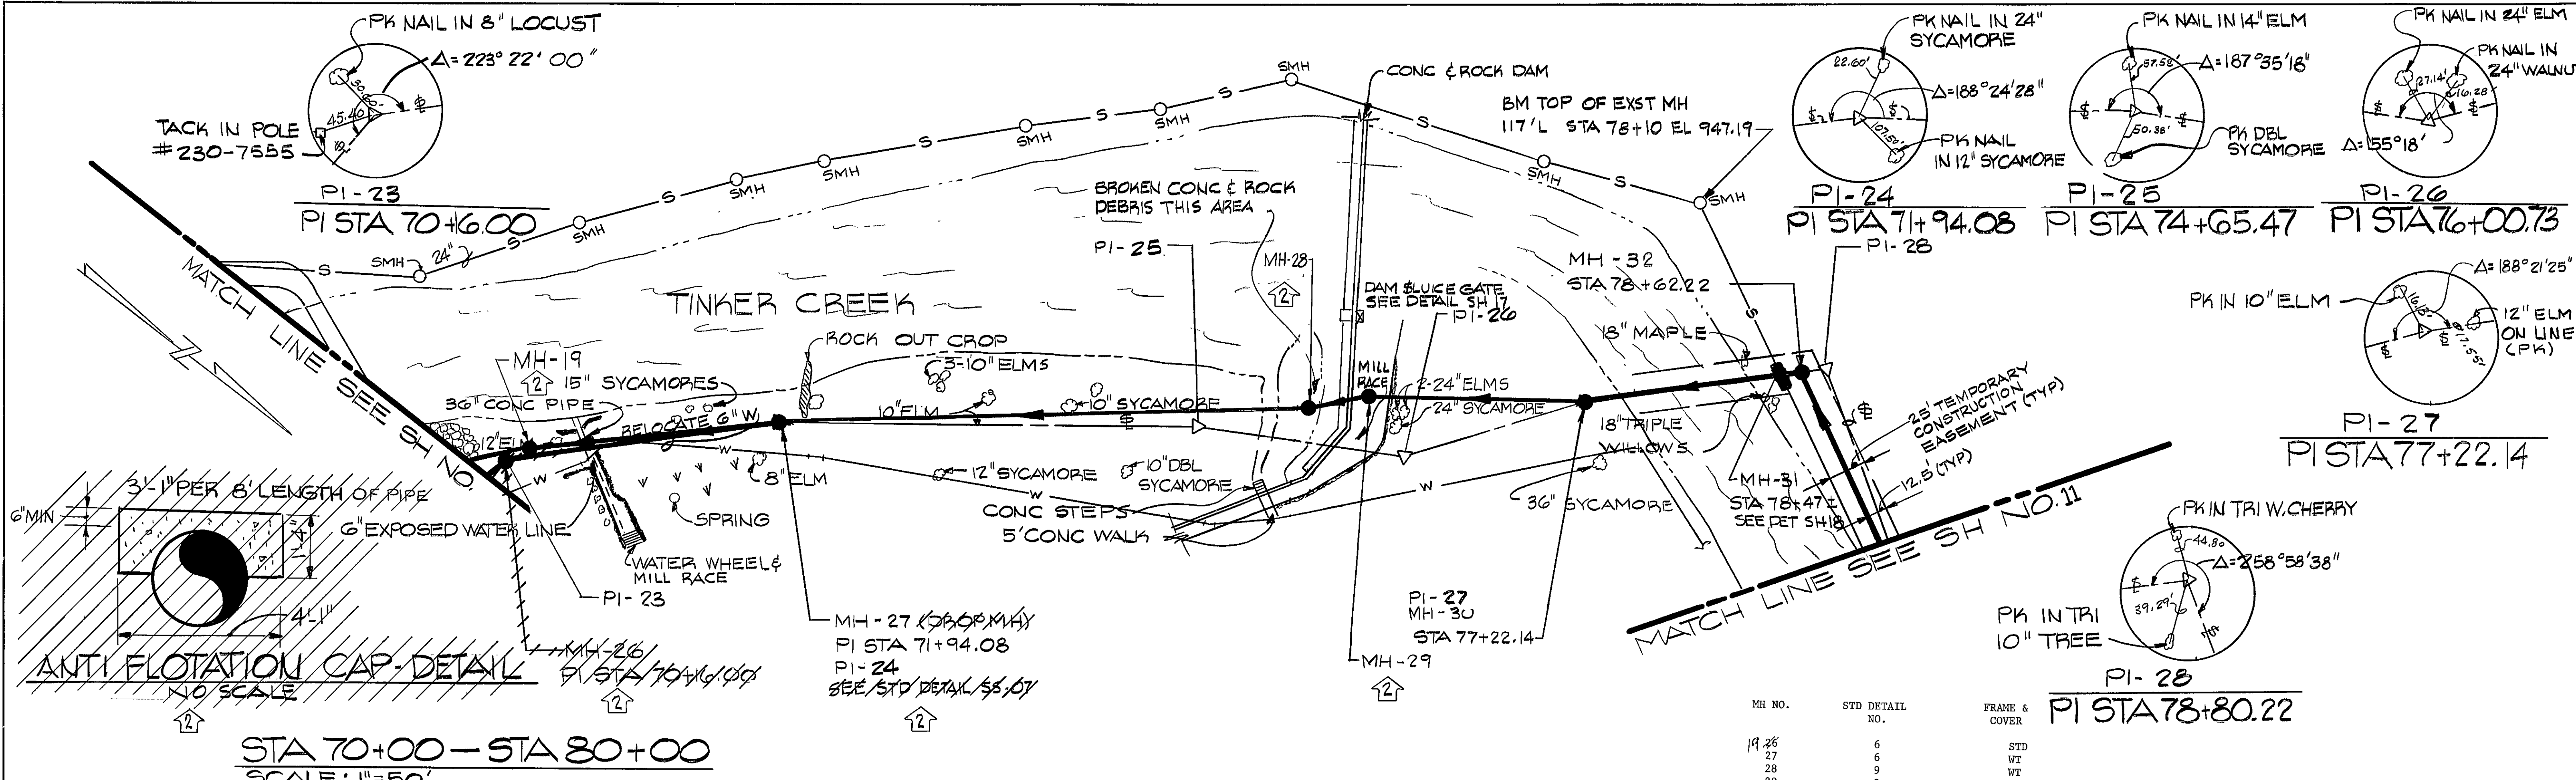

MANHOLE NO.	STD DETAIL NO.	FRAME & COVER
19-26	6	STD
27	6	WT
28	9	WT
29	8	WT
30	8	STD WT
31	See Sh 18	
32	8	STD WT

