
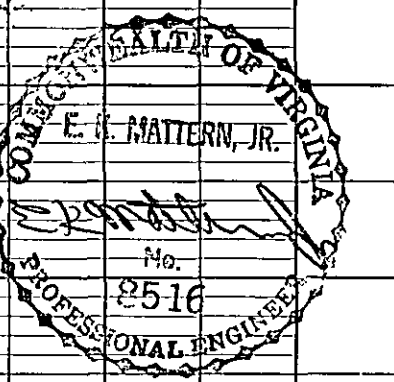
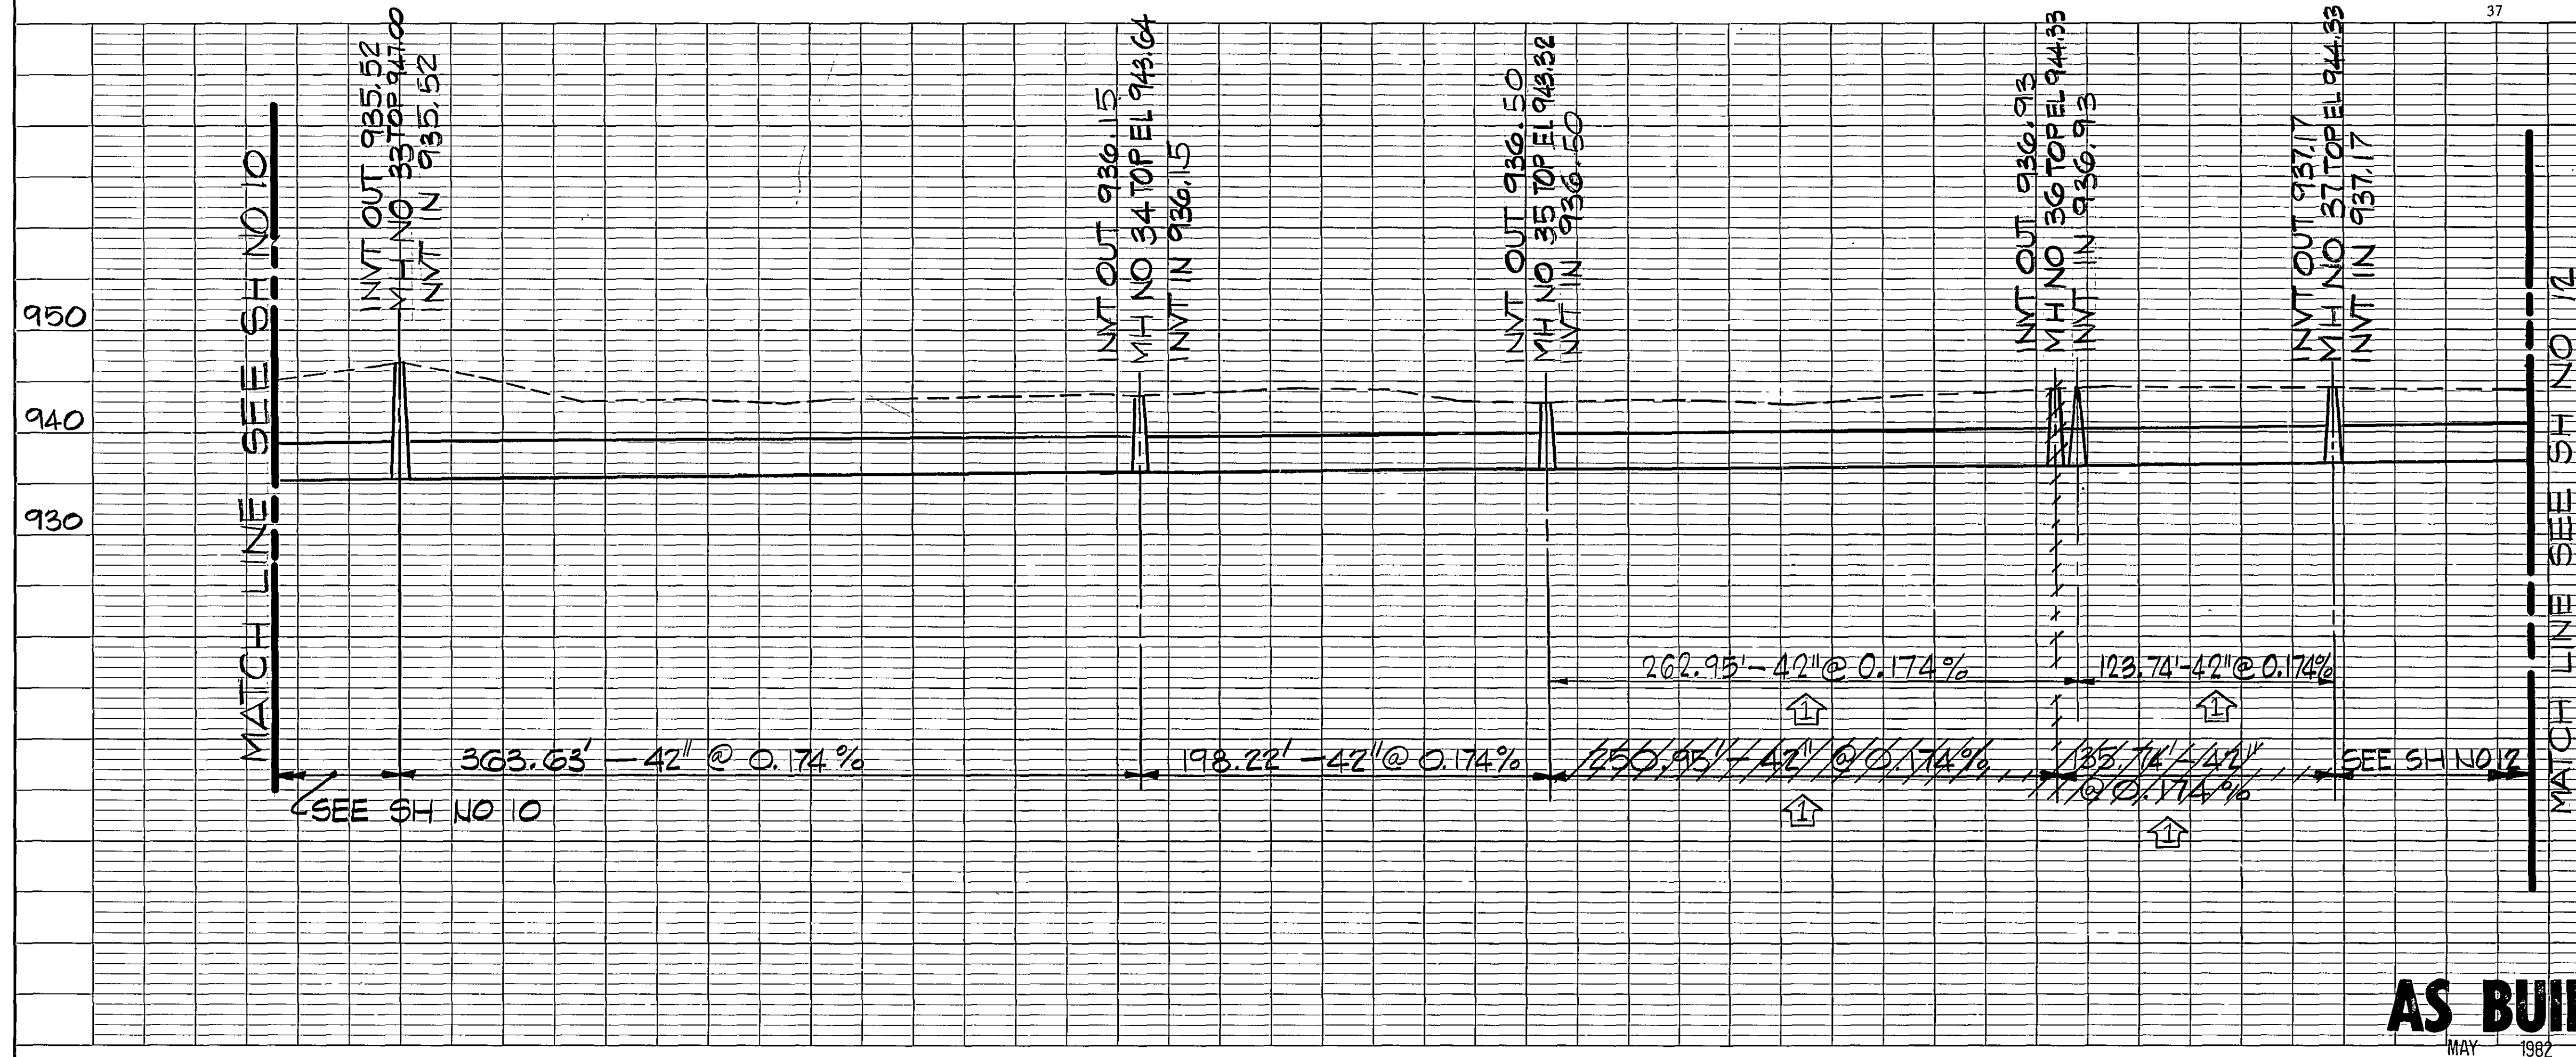


PROFILE	SURVEYED _____	BY _____	DATE _____
NOTE BOOK	PLOTTED _____ GRADES CHECKED _____ B. M.'S. NOTED _____ STRUCTURE NOTATIONS CHECKED _____		
No. _____			

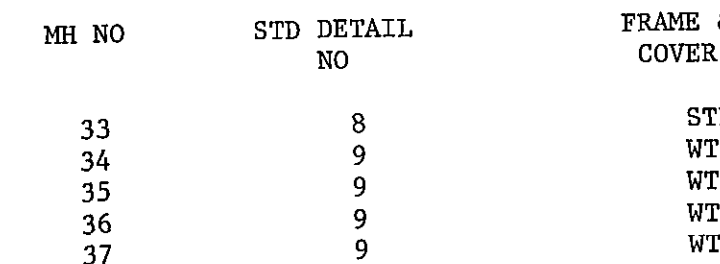

↑ MAY 82 AS BUILT		DWG SWR	
REVISION	DATE	DESCRIPTION	BY APP
DESIGNED <i>SWR</i>		TINKER CREEK SANITARY SEWER INTERCEPTOR STA 80+00—STA 91+00 CITY OF ROANOKE, VIRGINIA	
DRAWN <i>MTA</i>			
CHECKED <i>DMG</i>			
APPROVED <i>JWC</i>			
SUBMITTED <i>SPR</i>			
Mattern and Craig CONSULTING ENGINEERS ROANOKE, VIRGINIA		SCALE: AS NOTED	COMM. NO. 347
		DATE: OCT 1980	SHEET 11