
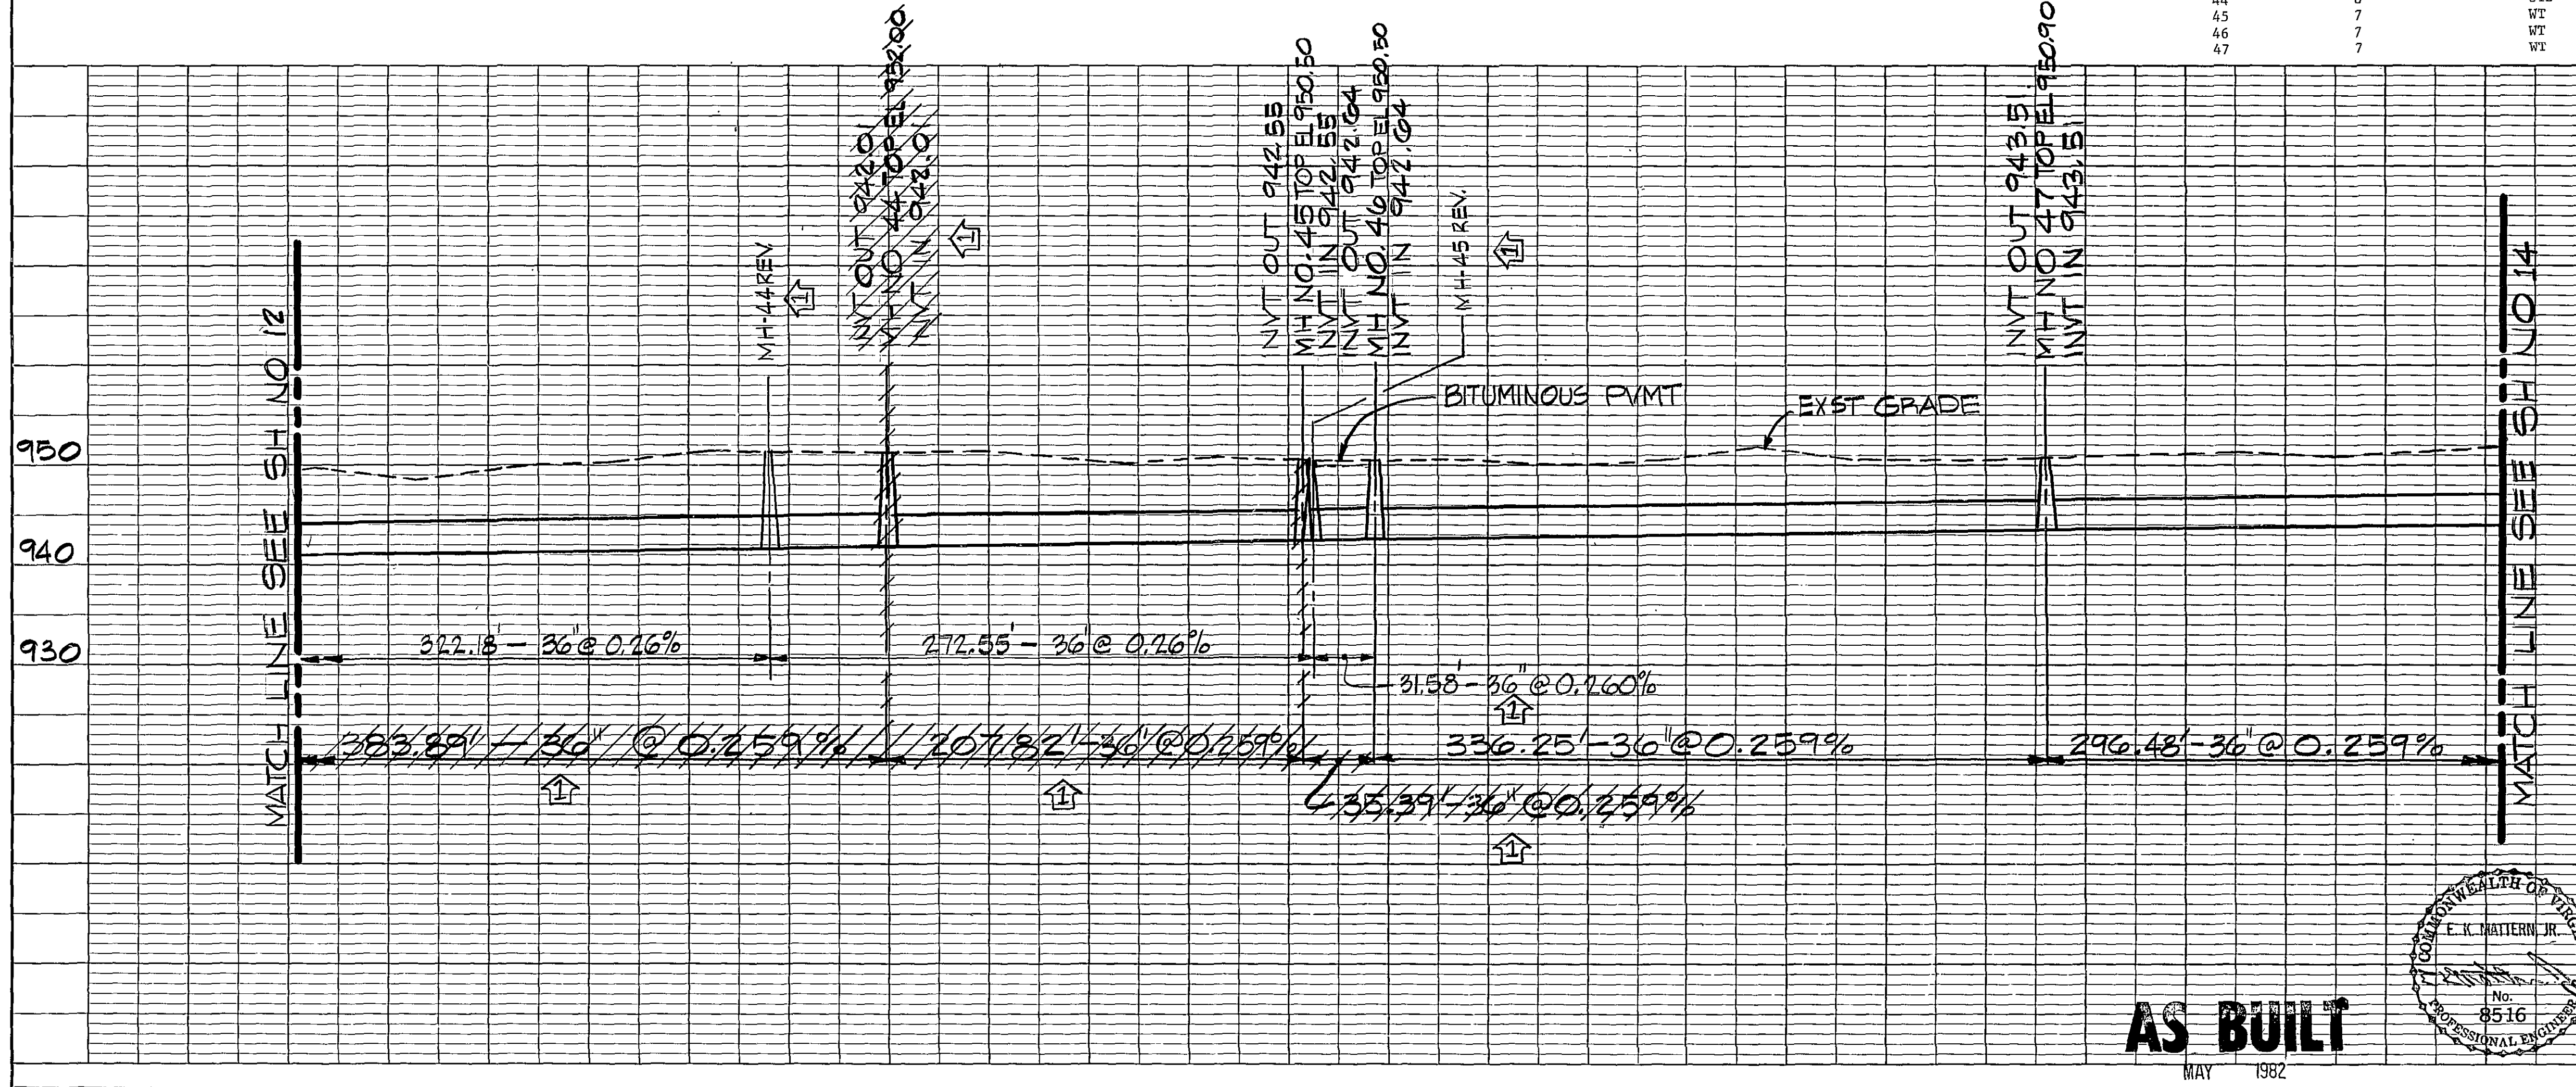


| PLAN   | DATE |
|--------|------|
| NO. 1  | DATE |
| NO. 2  | DATE |
| NO. 3  | DATE |
| NO. 4  | DATE |
| NO. 5  | DATE |
| NO. 6  | DATE |
| NO. 7  | DATE |
| NO. 8  | DATE |
| NO. 9  | DATE |
| NO. 10 | DATE |

| PROFILE | DATE |
|---------|------|
| NO. 1   | DATE |
| NO. 2   | DATE |
| NO. 3   | DATE |
| NO. 4   | DATE |
| NO. 5   | DATE |
| NO. 6   | DATE |
| NO. 7   | DATE |
| NO. 8   | DATE |
| NO. 9   | DATE |
| NO. 10  | DATE |

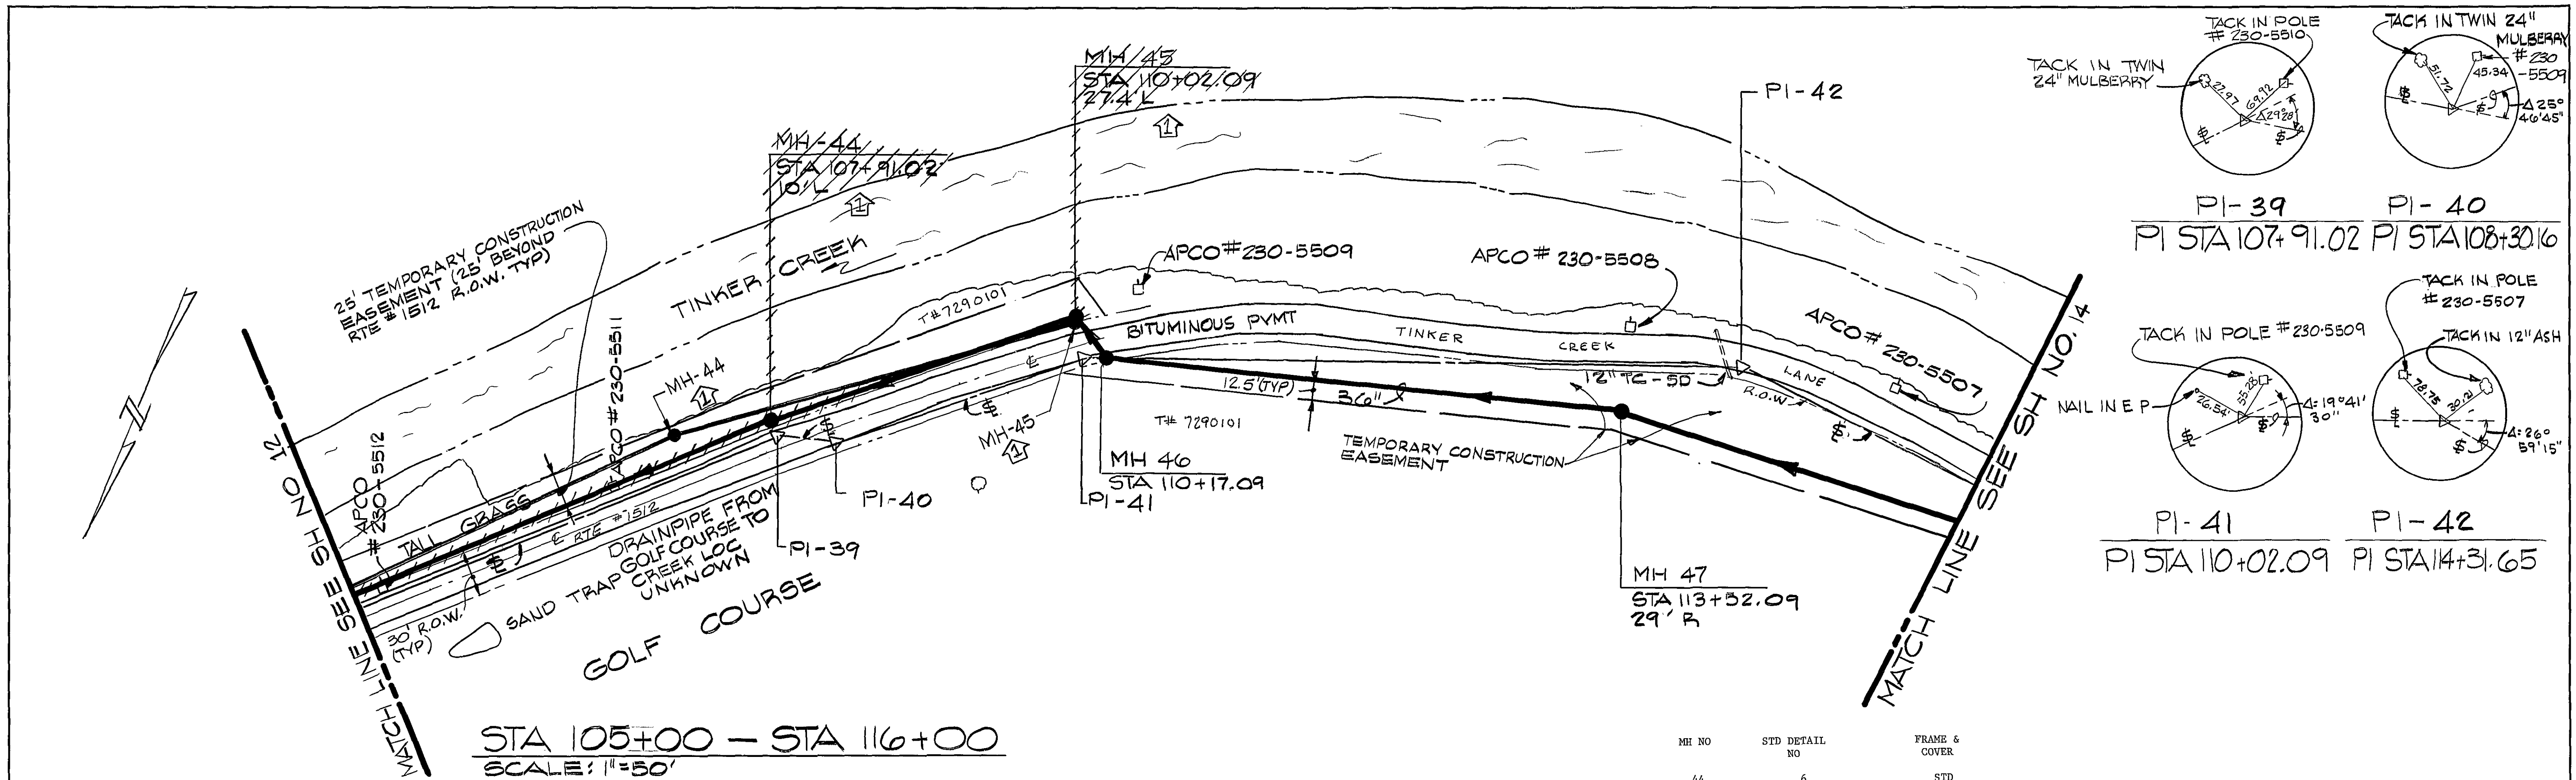

PI-39  
PI STA 107+91.02

PI-40  
PI STA 108+30.16

PI-41  
PI STA 110+02.09

PI-42  
PI STA 114+31.65

TACK IN POLE # 230-5510

TACK IN TWIN 24" MULBERRY

TACK IN TWIN 24" MULBERRY

TACK IN POLE # 230-5507

TACK IN 12" ASH

NAIL IN P

| MH NO | STD DETAIL NO | FRAME & COVER |
|-------|---------------|---------------|
| 44    | 6             | STD           |
| 45    | 7             | WT            |
| 46    | 7             | WT            |
| 47    | 7             | WT            |

AS BUILT

MAY 1982

DESIGNED SWH

DRAWN MTA

CHECKED *Amc*

APPROVED *JWC*

SUBMITTED *JWC*

|          |        |             |     |     |
|----------|--------|-------------|-----|-----|
| REVISION | DATE   | DESCRIPTION | BY  | APP |
| 1        | MAY 82 | AS BUILT    | DMC | SWH |

**TINKER CREEK SANITARY SEWER INTERCEPTOR**

**STA 105+00—STA 116+00**

CITY OF ROANOKE, VIRGINIA

**Mattern and Craig**

CONSULTING ENGINEERS

ROANOKE, VIRGINIA

SCALE: AS NOTED

DATE: OCT 1980

COMM. NO. 347

SHEET 13