



PROFILE	SURVEYED.....	BY.....	DATE.....
	PLOTTED.....		
NOTE BOOK	GRADES CHECKED.....		
	B. M.'s NOTED.....		
NO.	STRUCTURE NOVA'S ONE CHECKED.....		

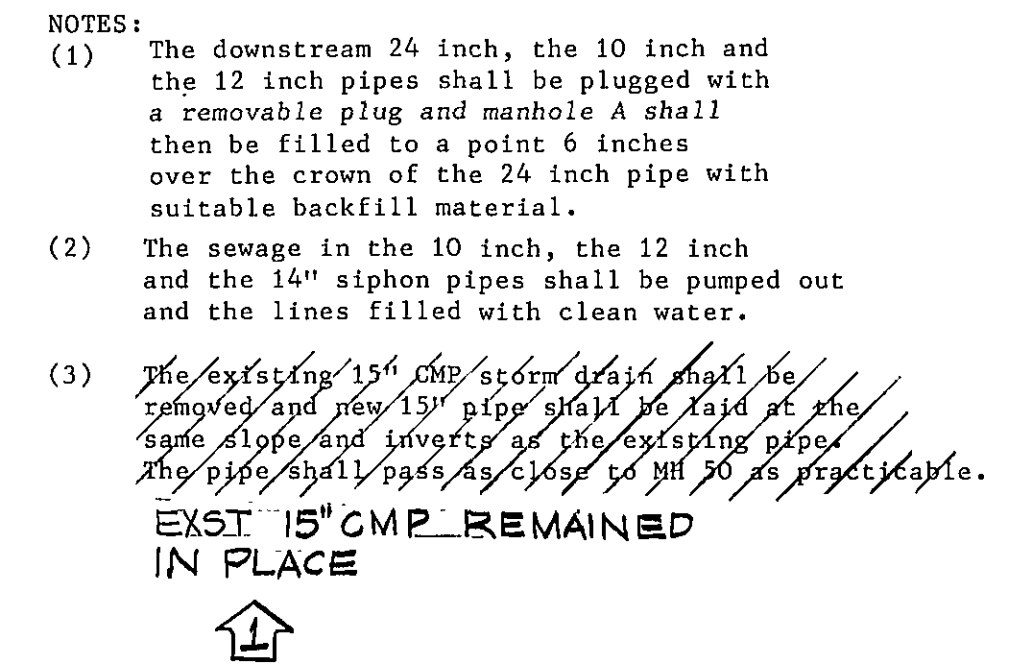

MH NO.	STD DETAIL NO	FRAME COVER
48	7	STD
49	7	WT
50	Spec MH - See Detail	Sheet 18

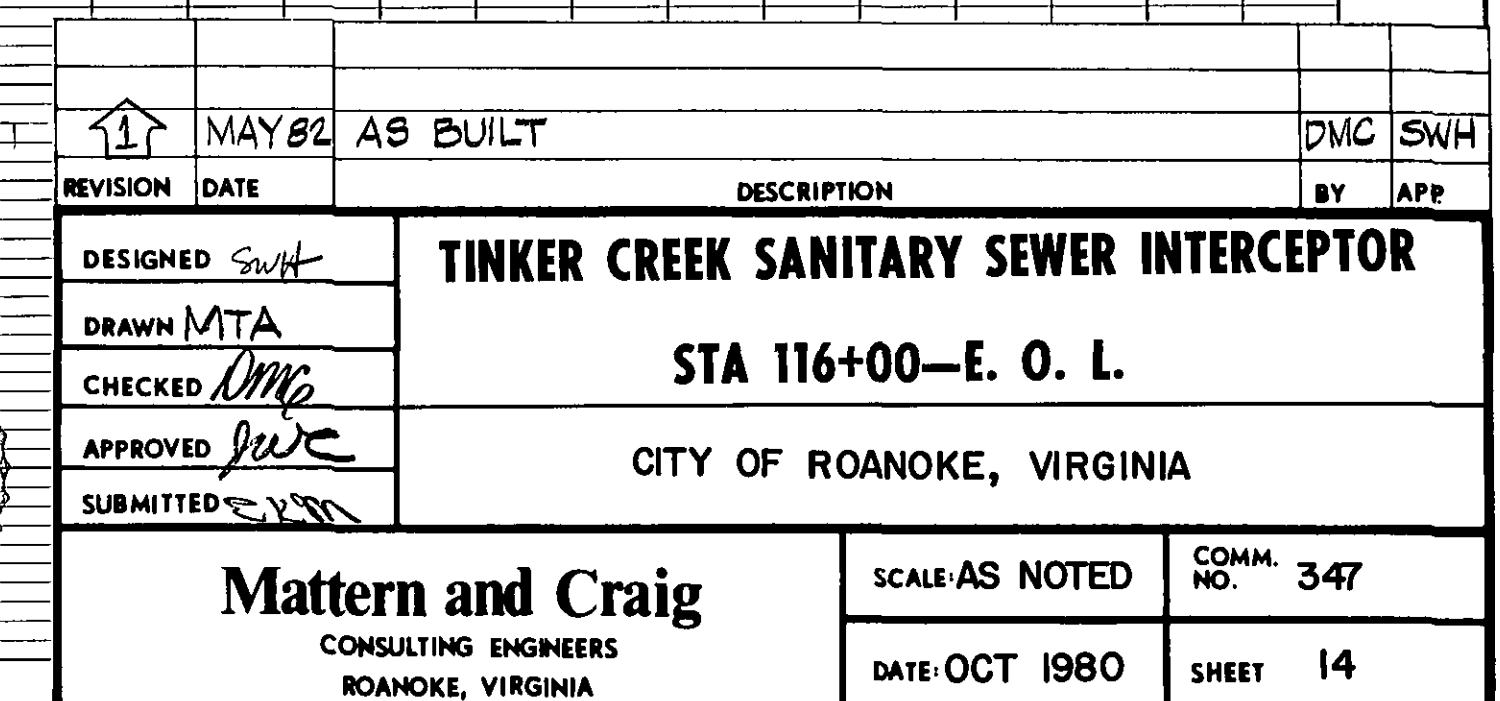

AS BUILT

MAY 1982

5773