

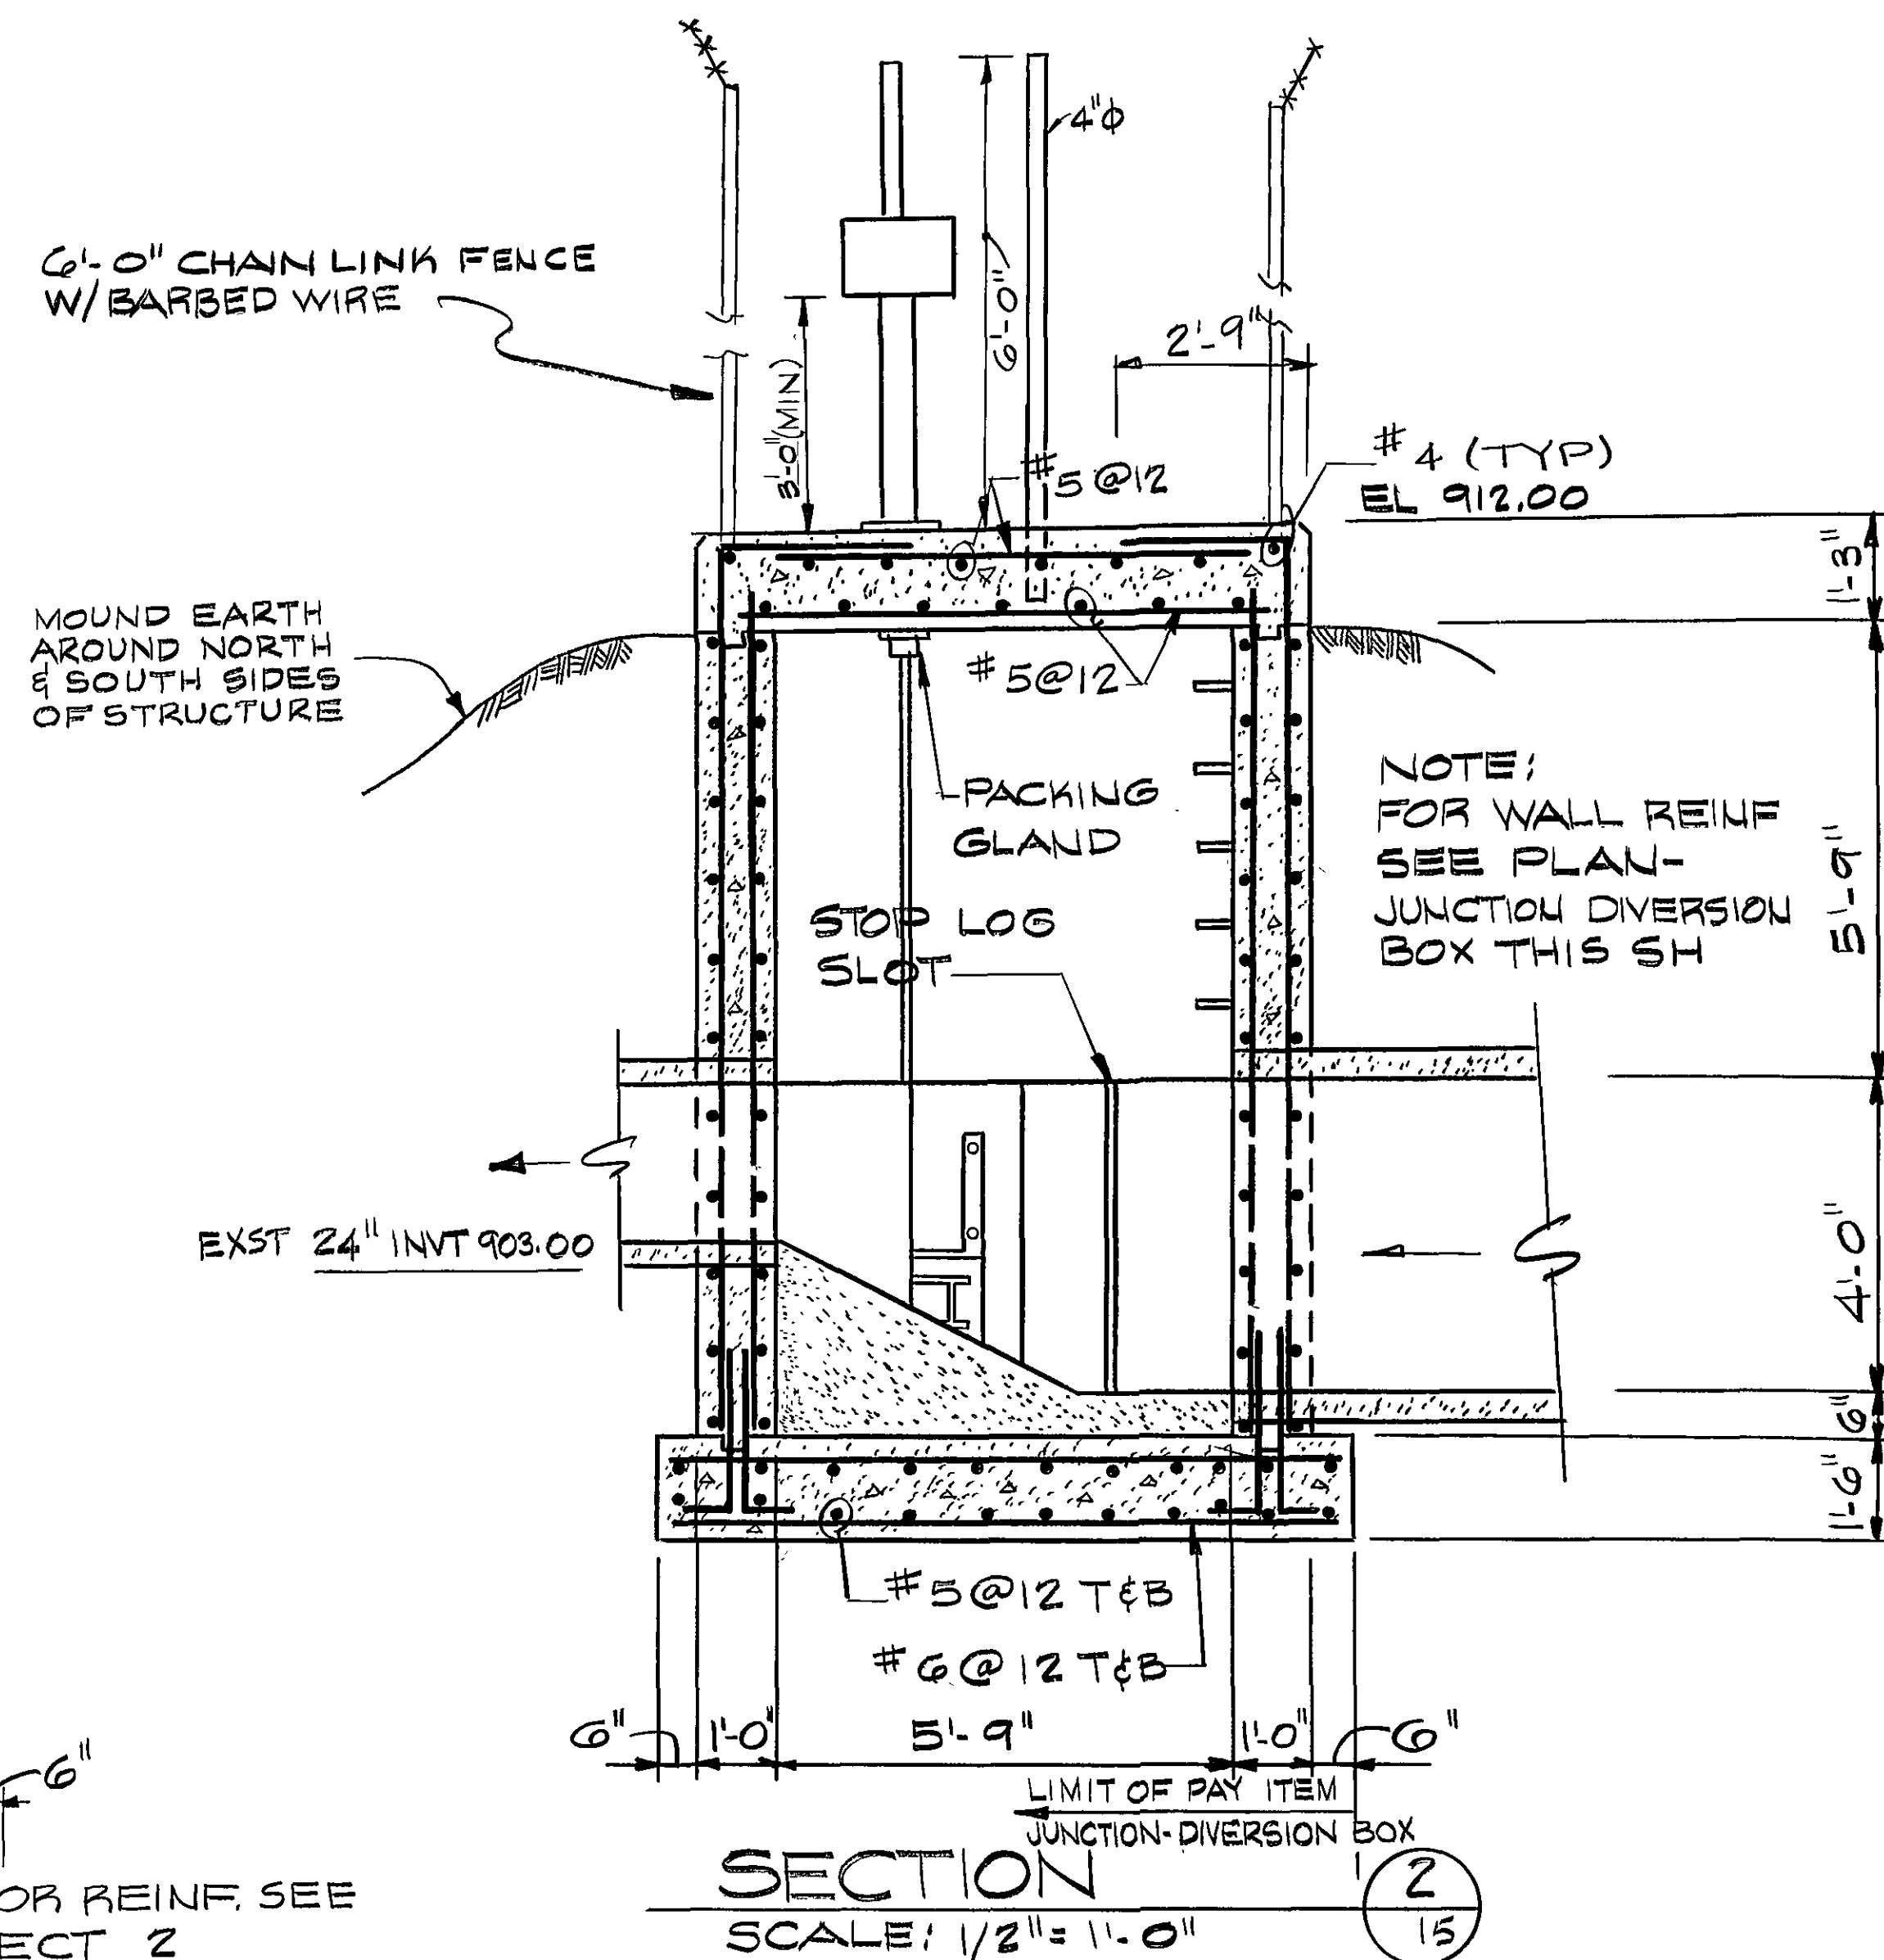
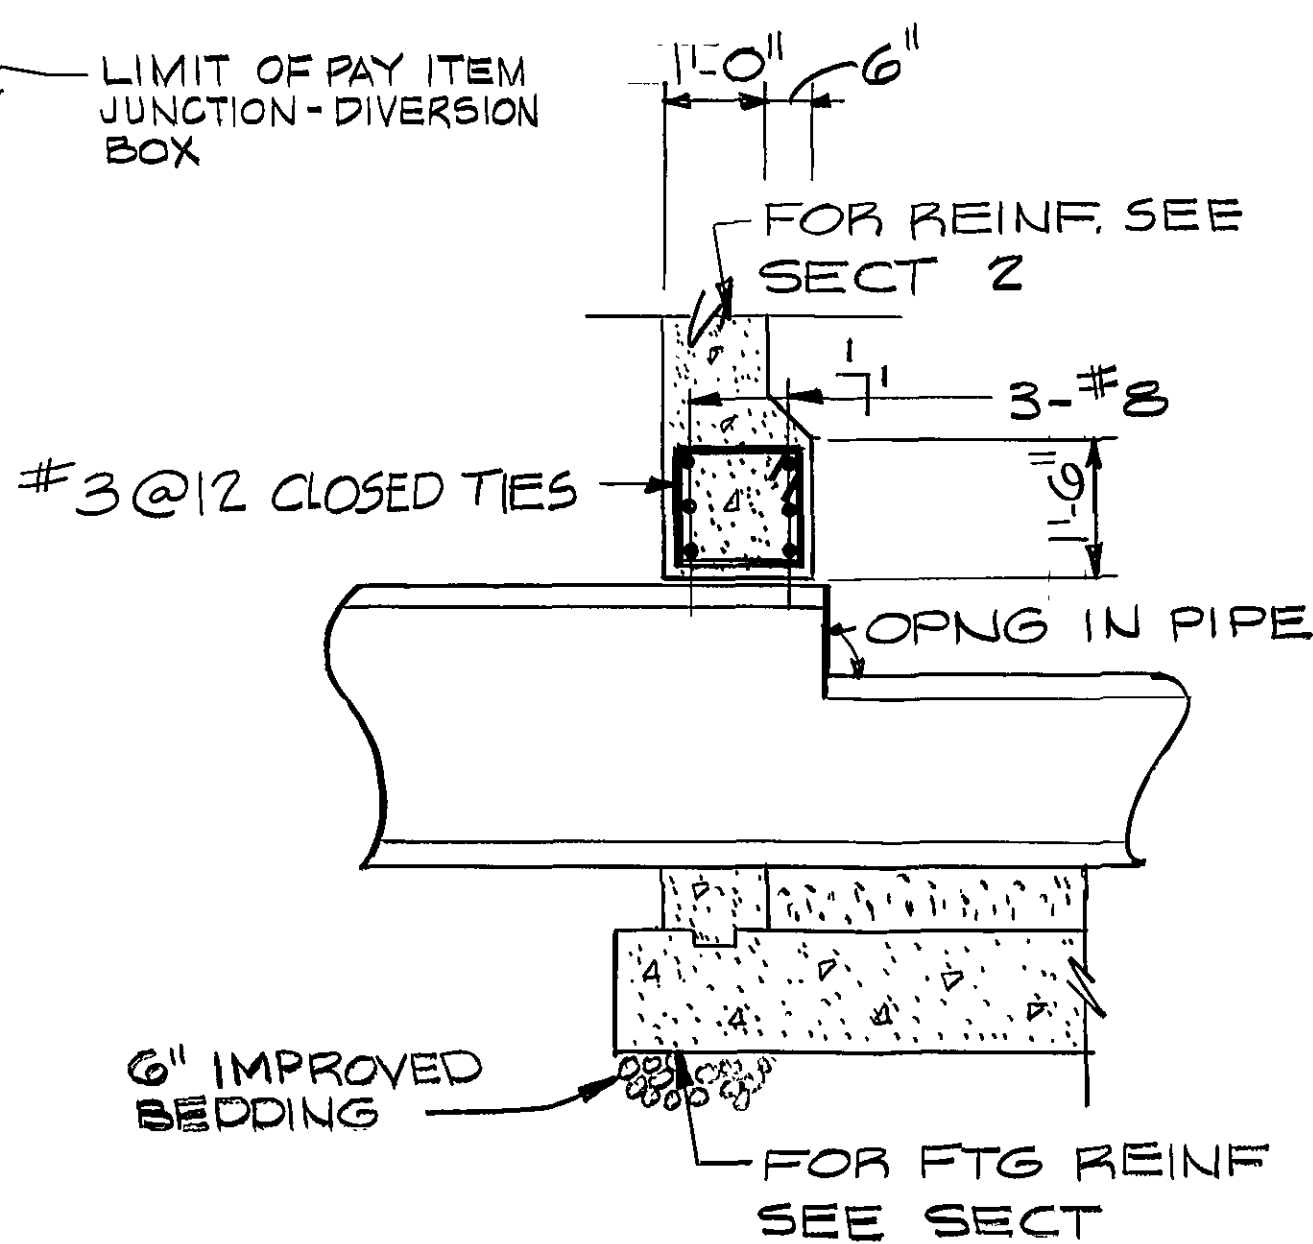
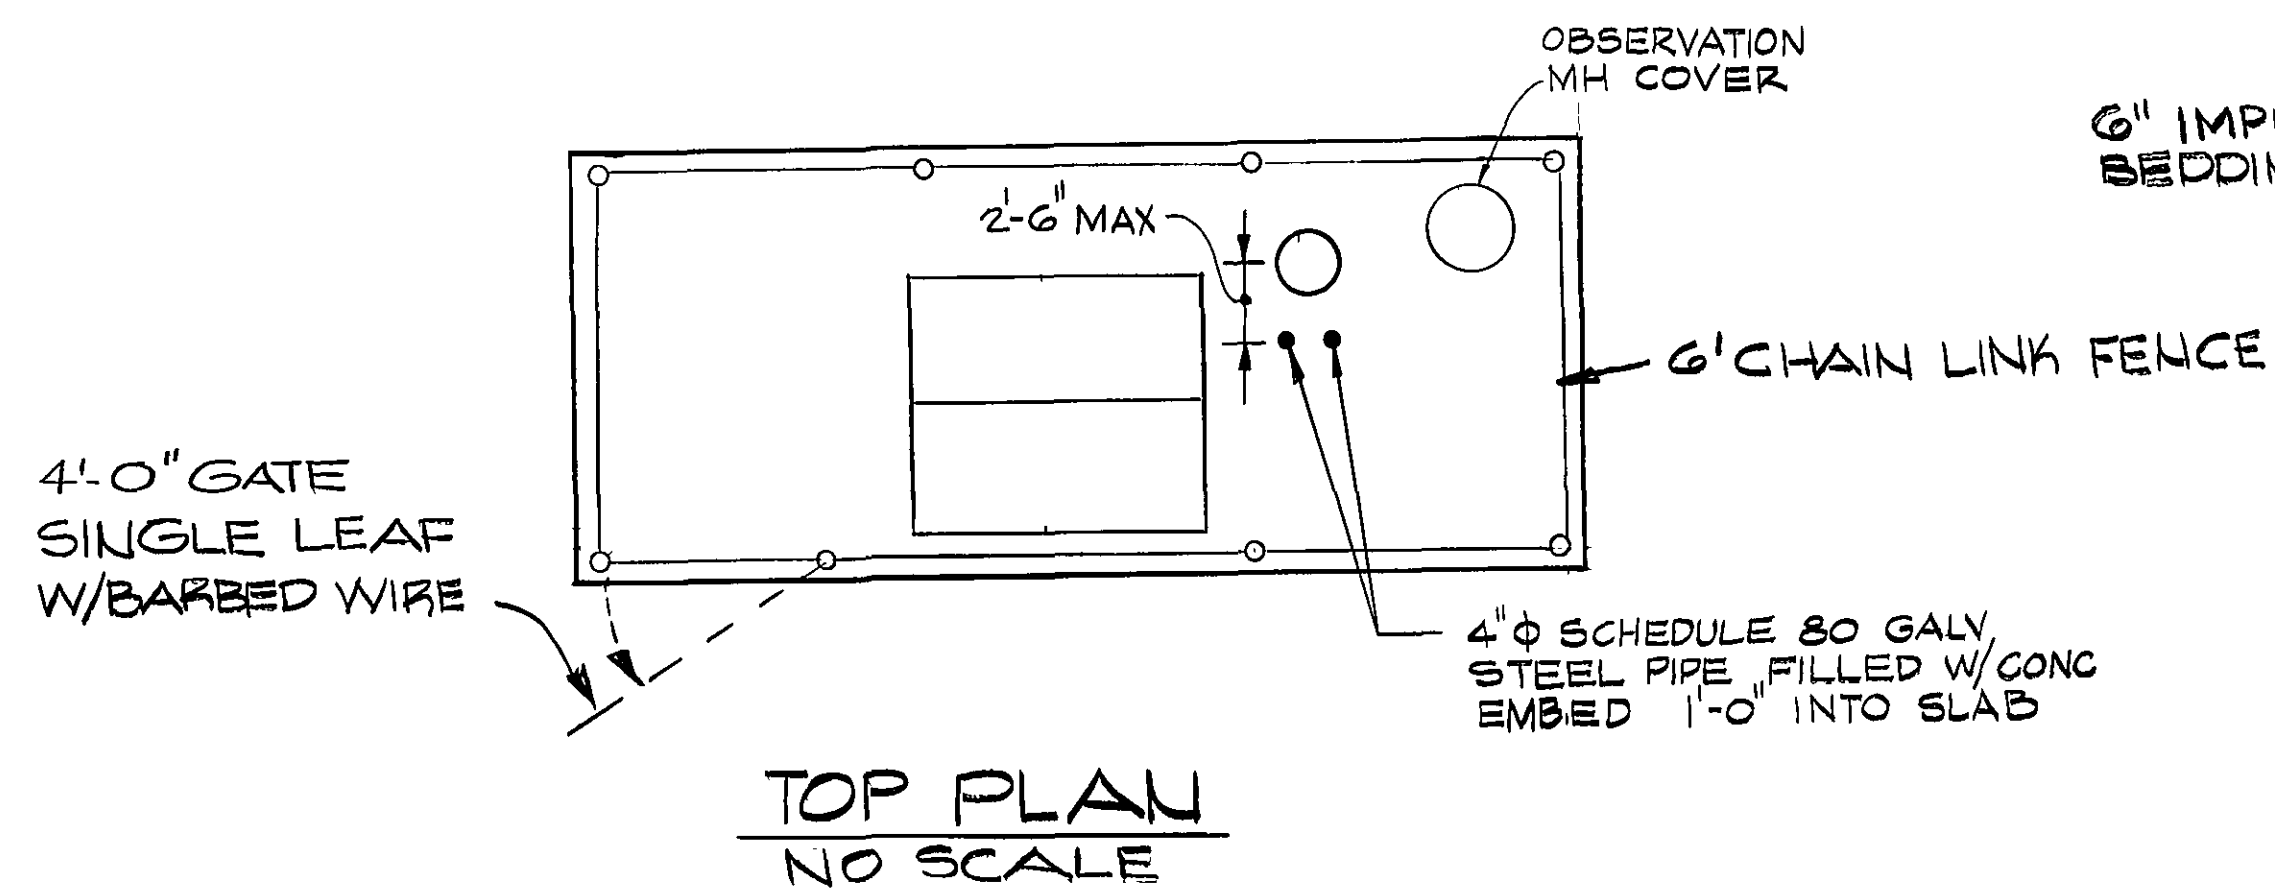


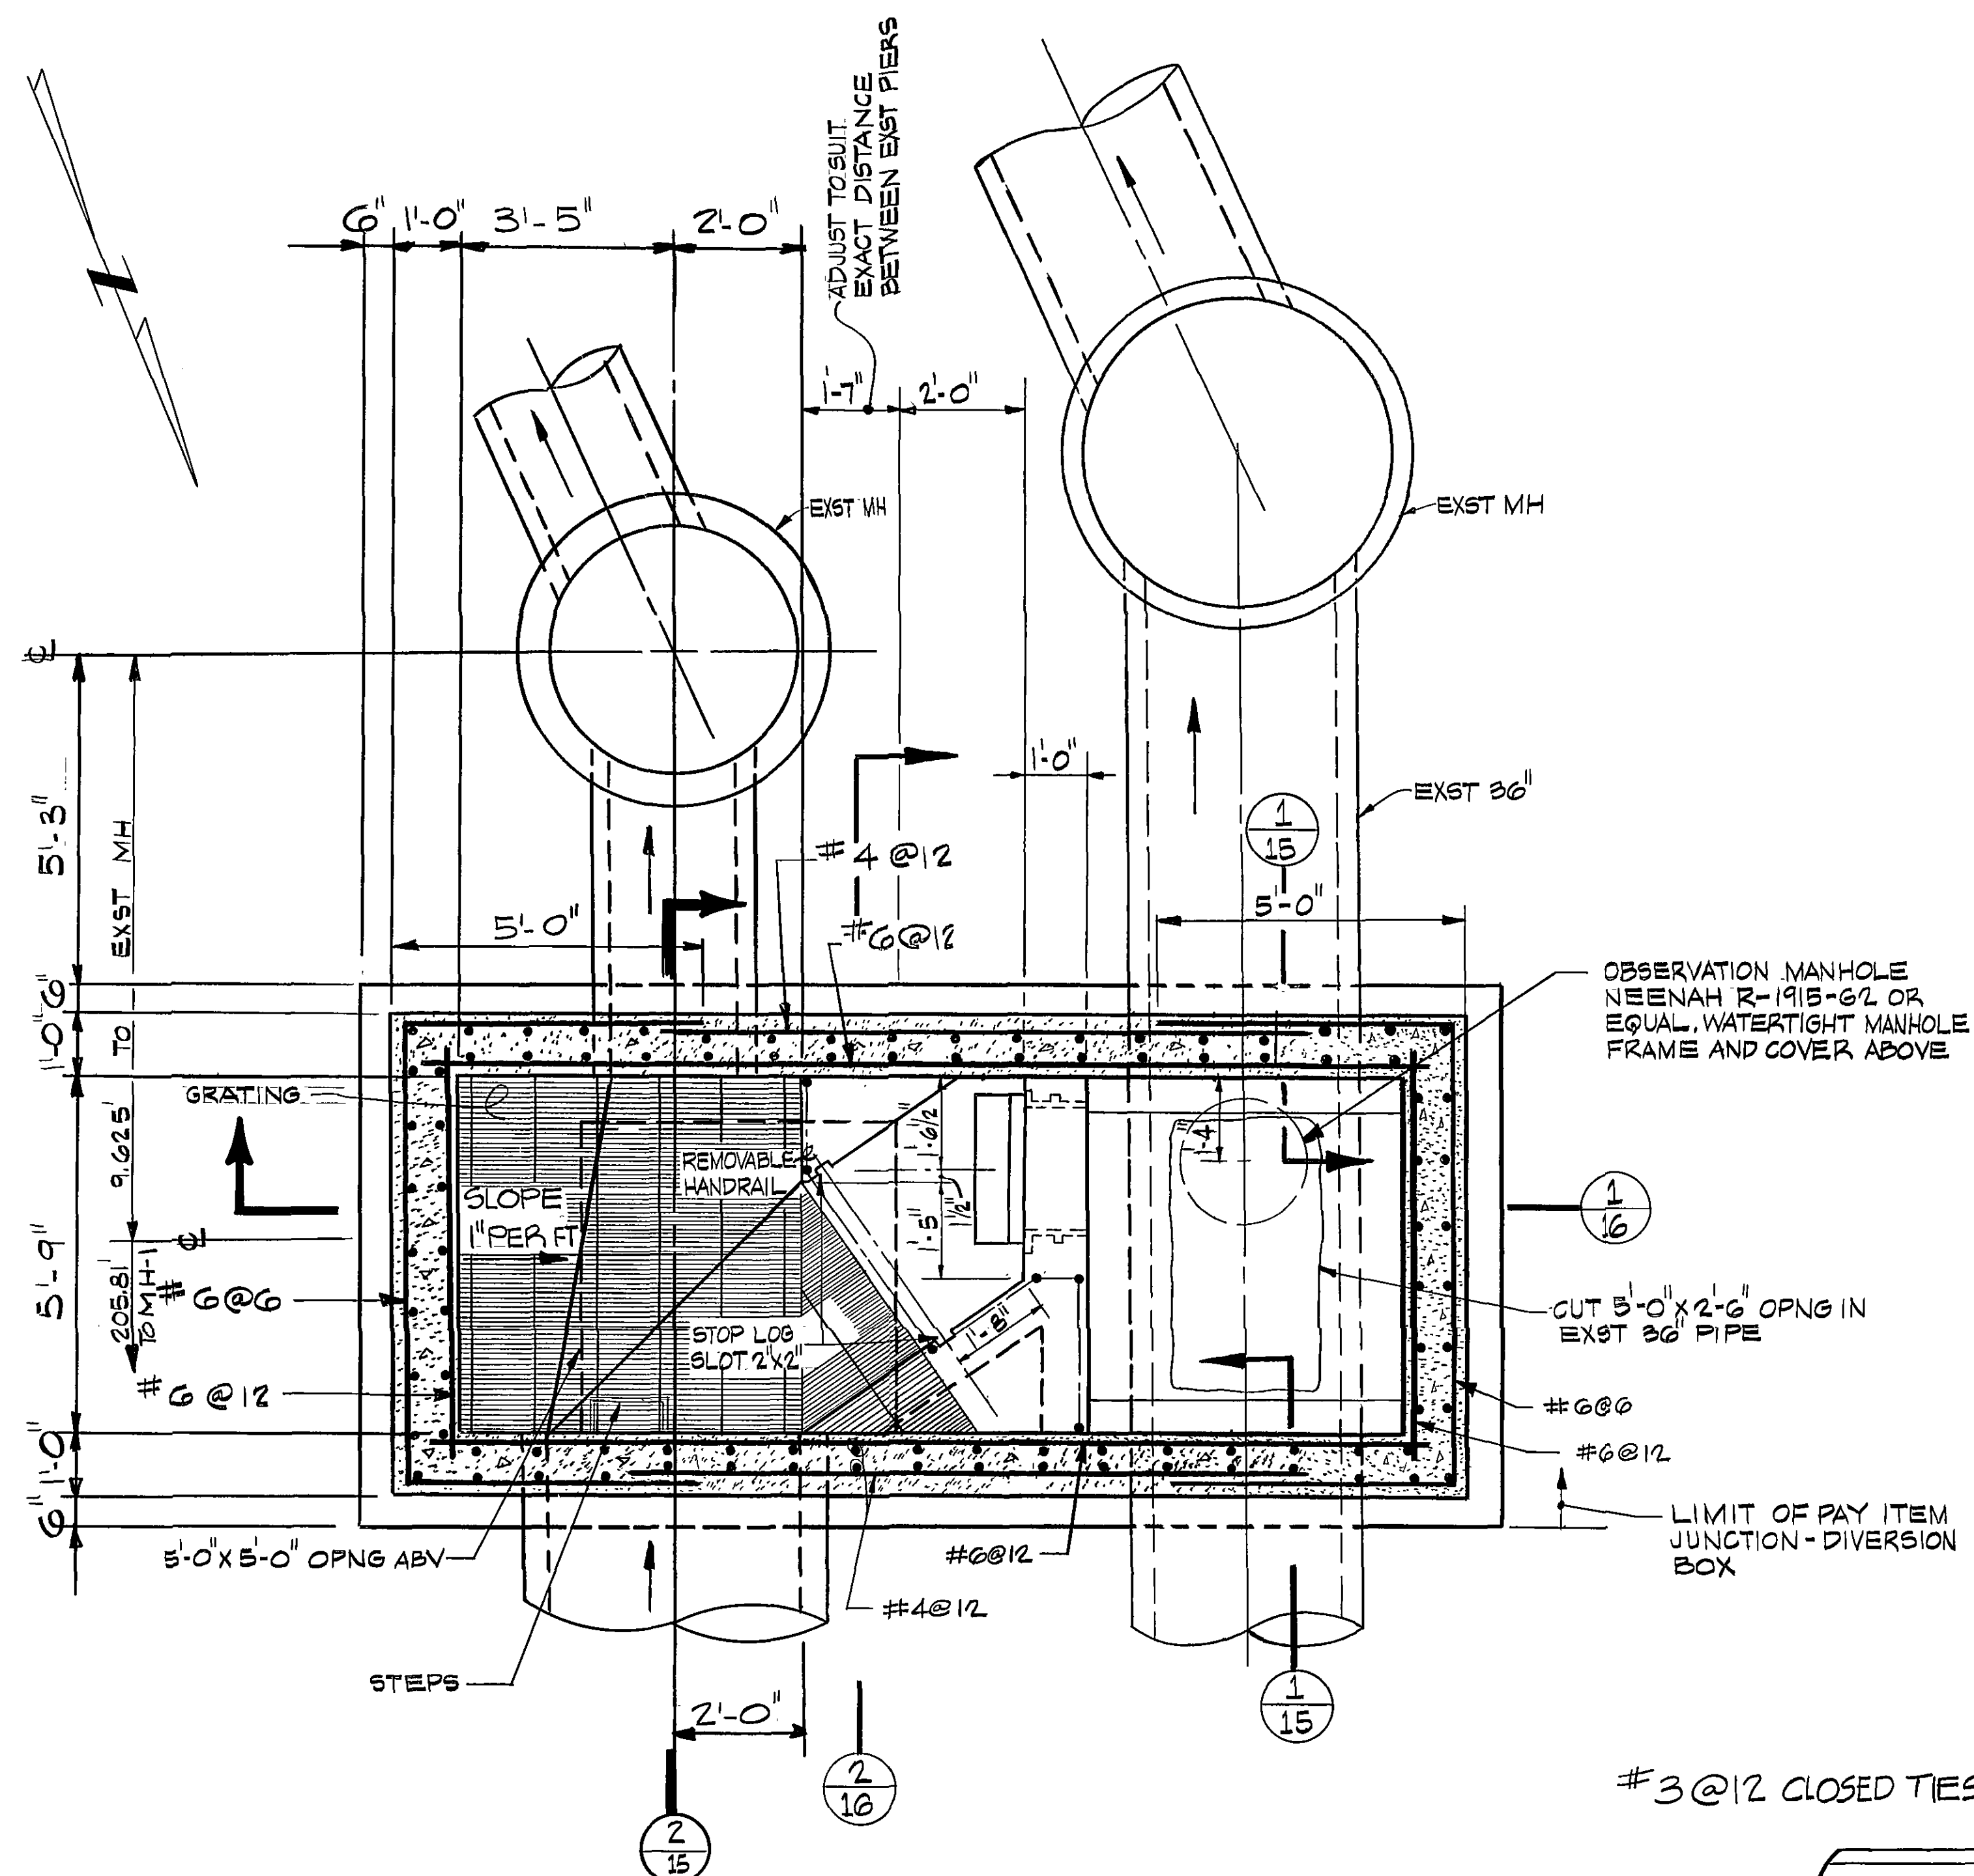

NOTES:
1) SEE SH 21 FOR STOP LOG DETAIL

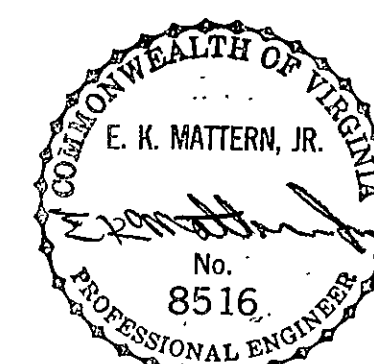

AS BUILT

MAY 198

[illegible]