



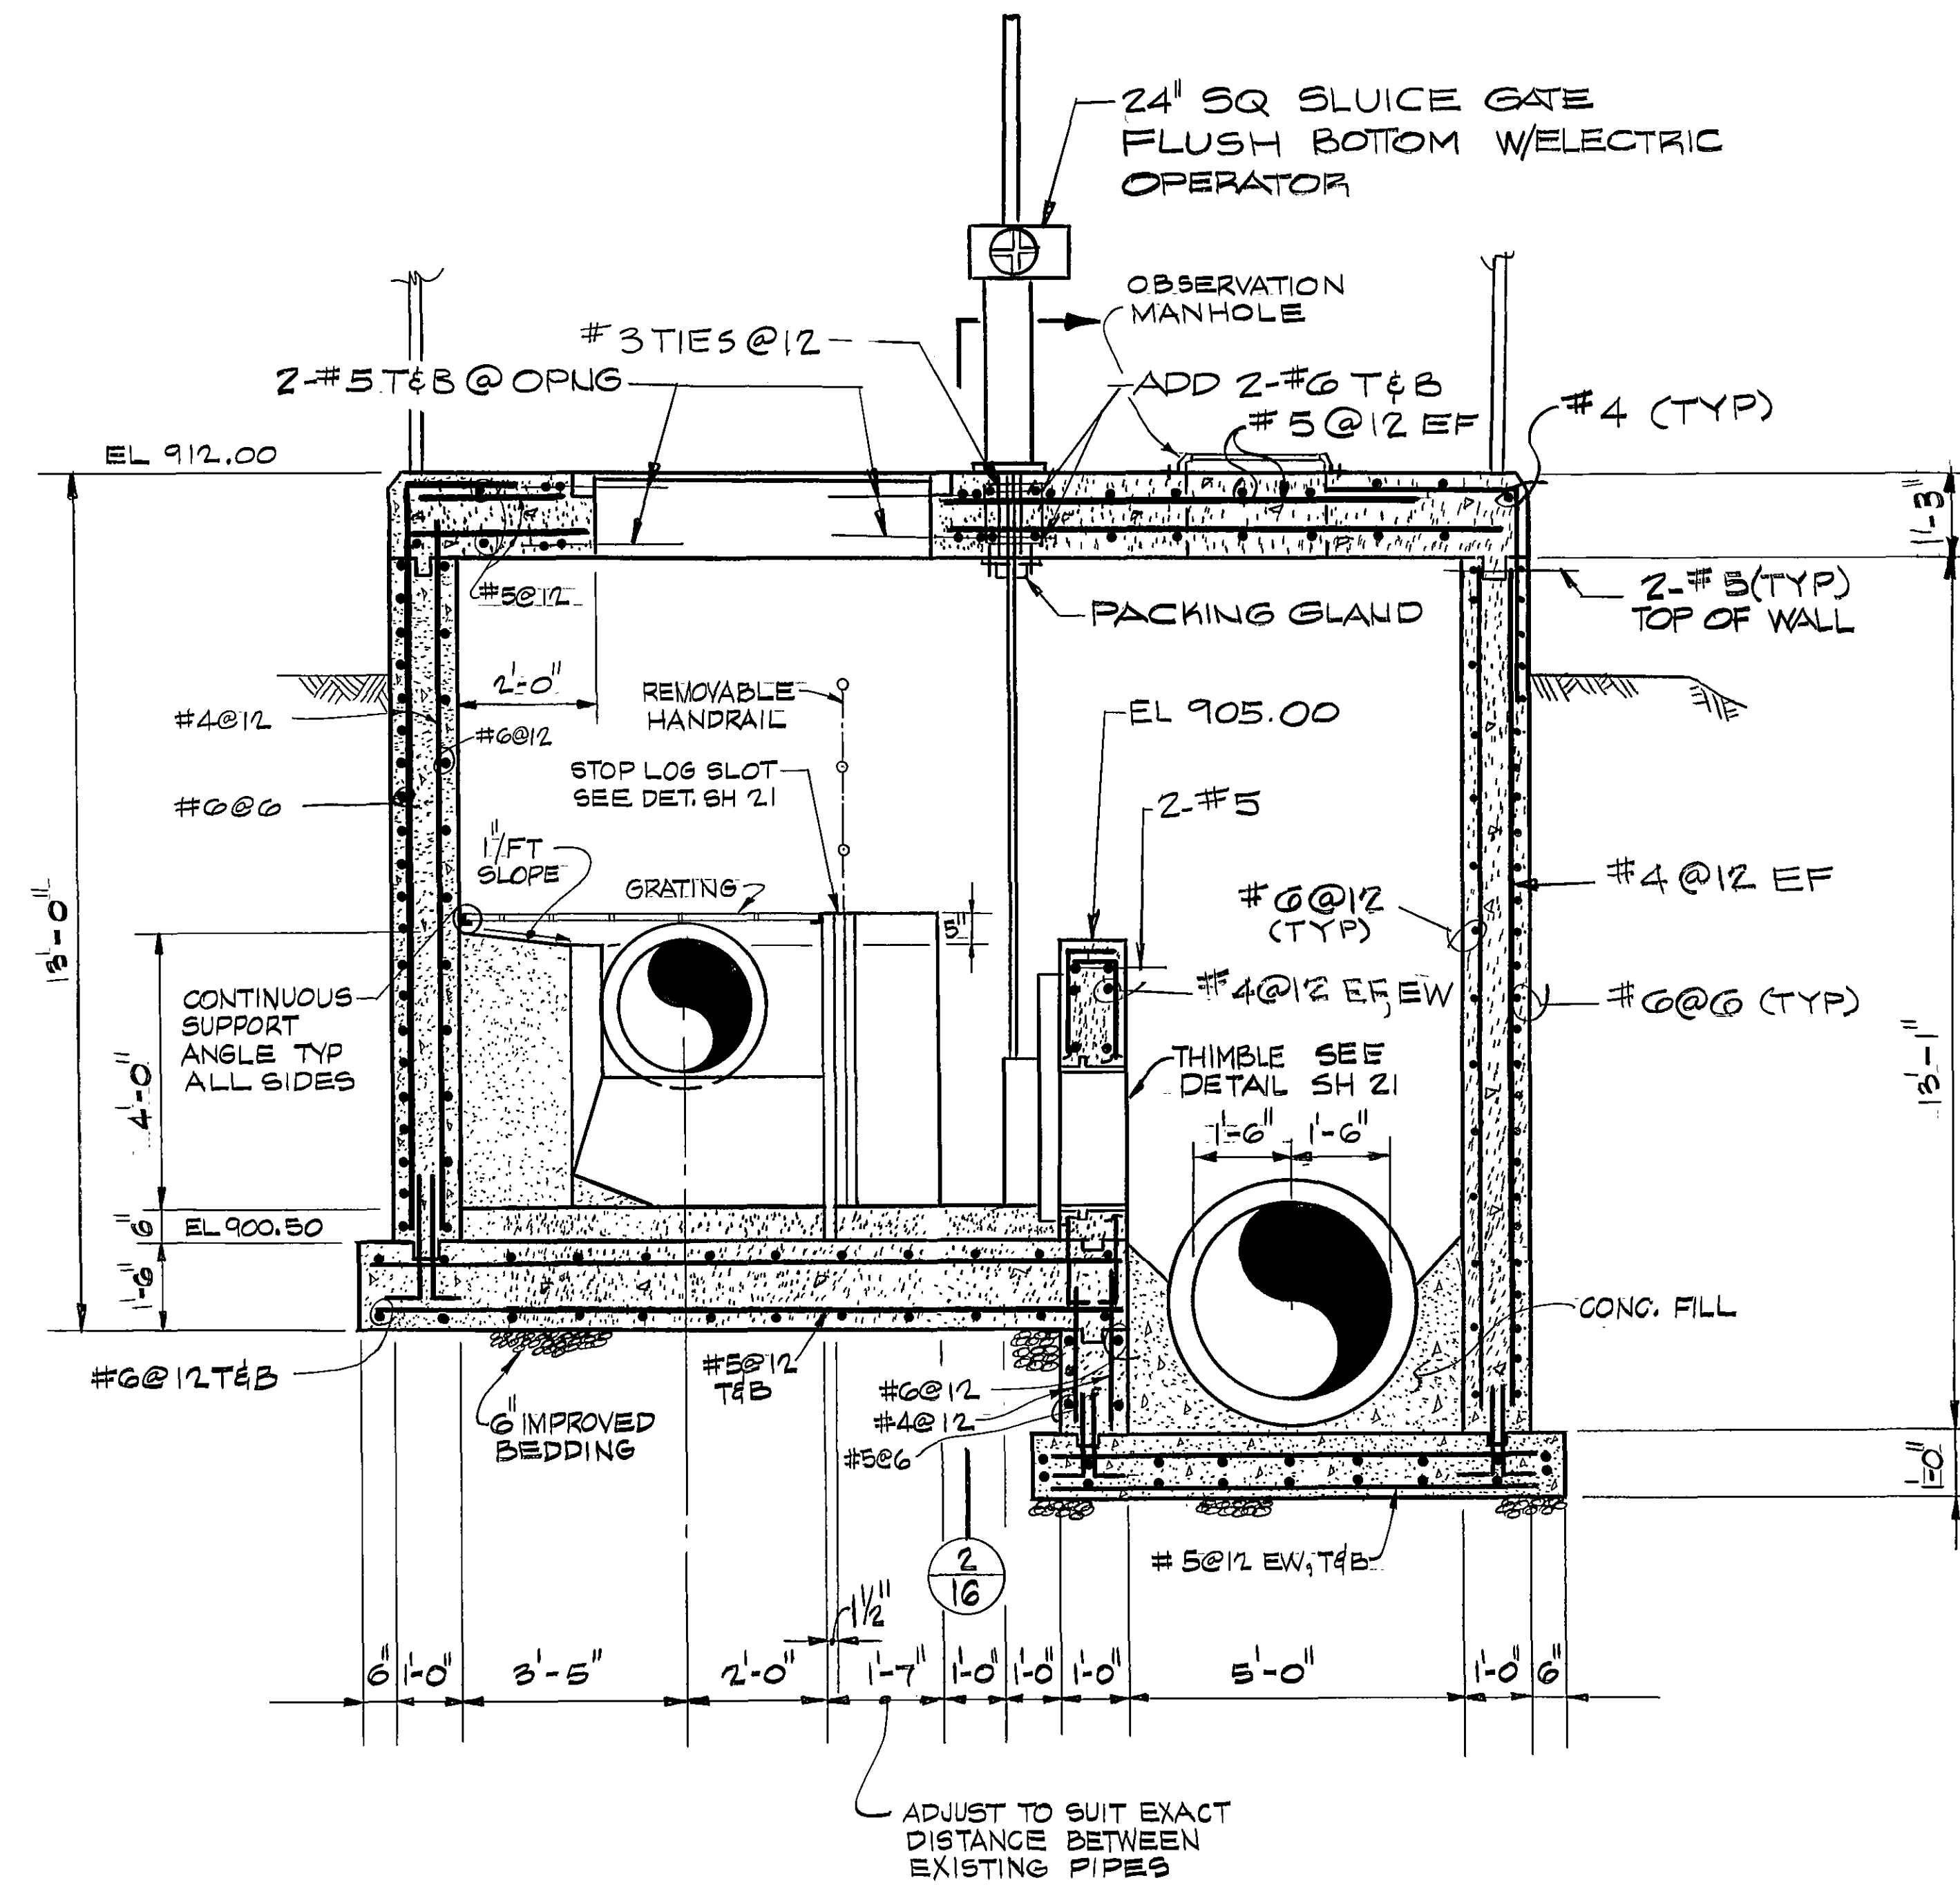


SECTION 1
SCALE: 1/2" = 1'-0"

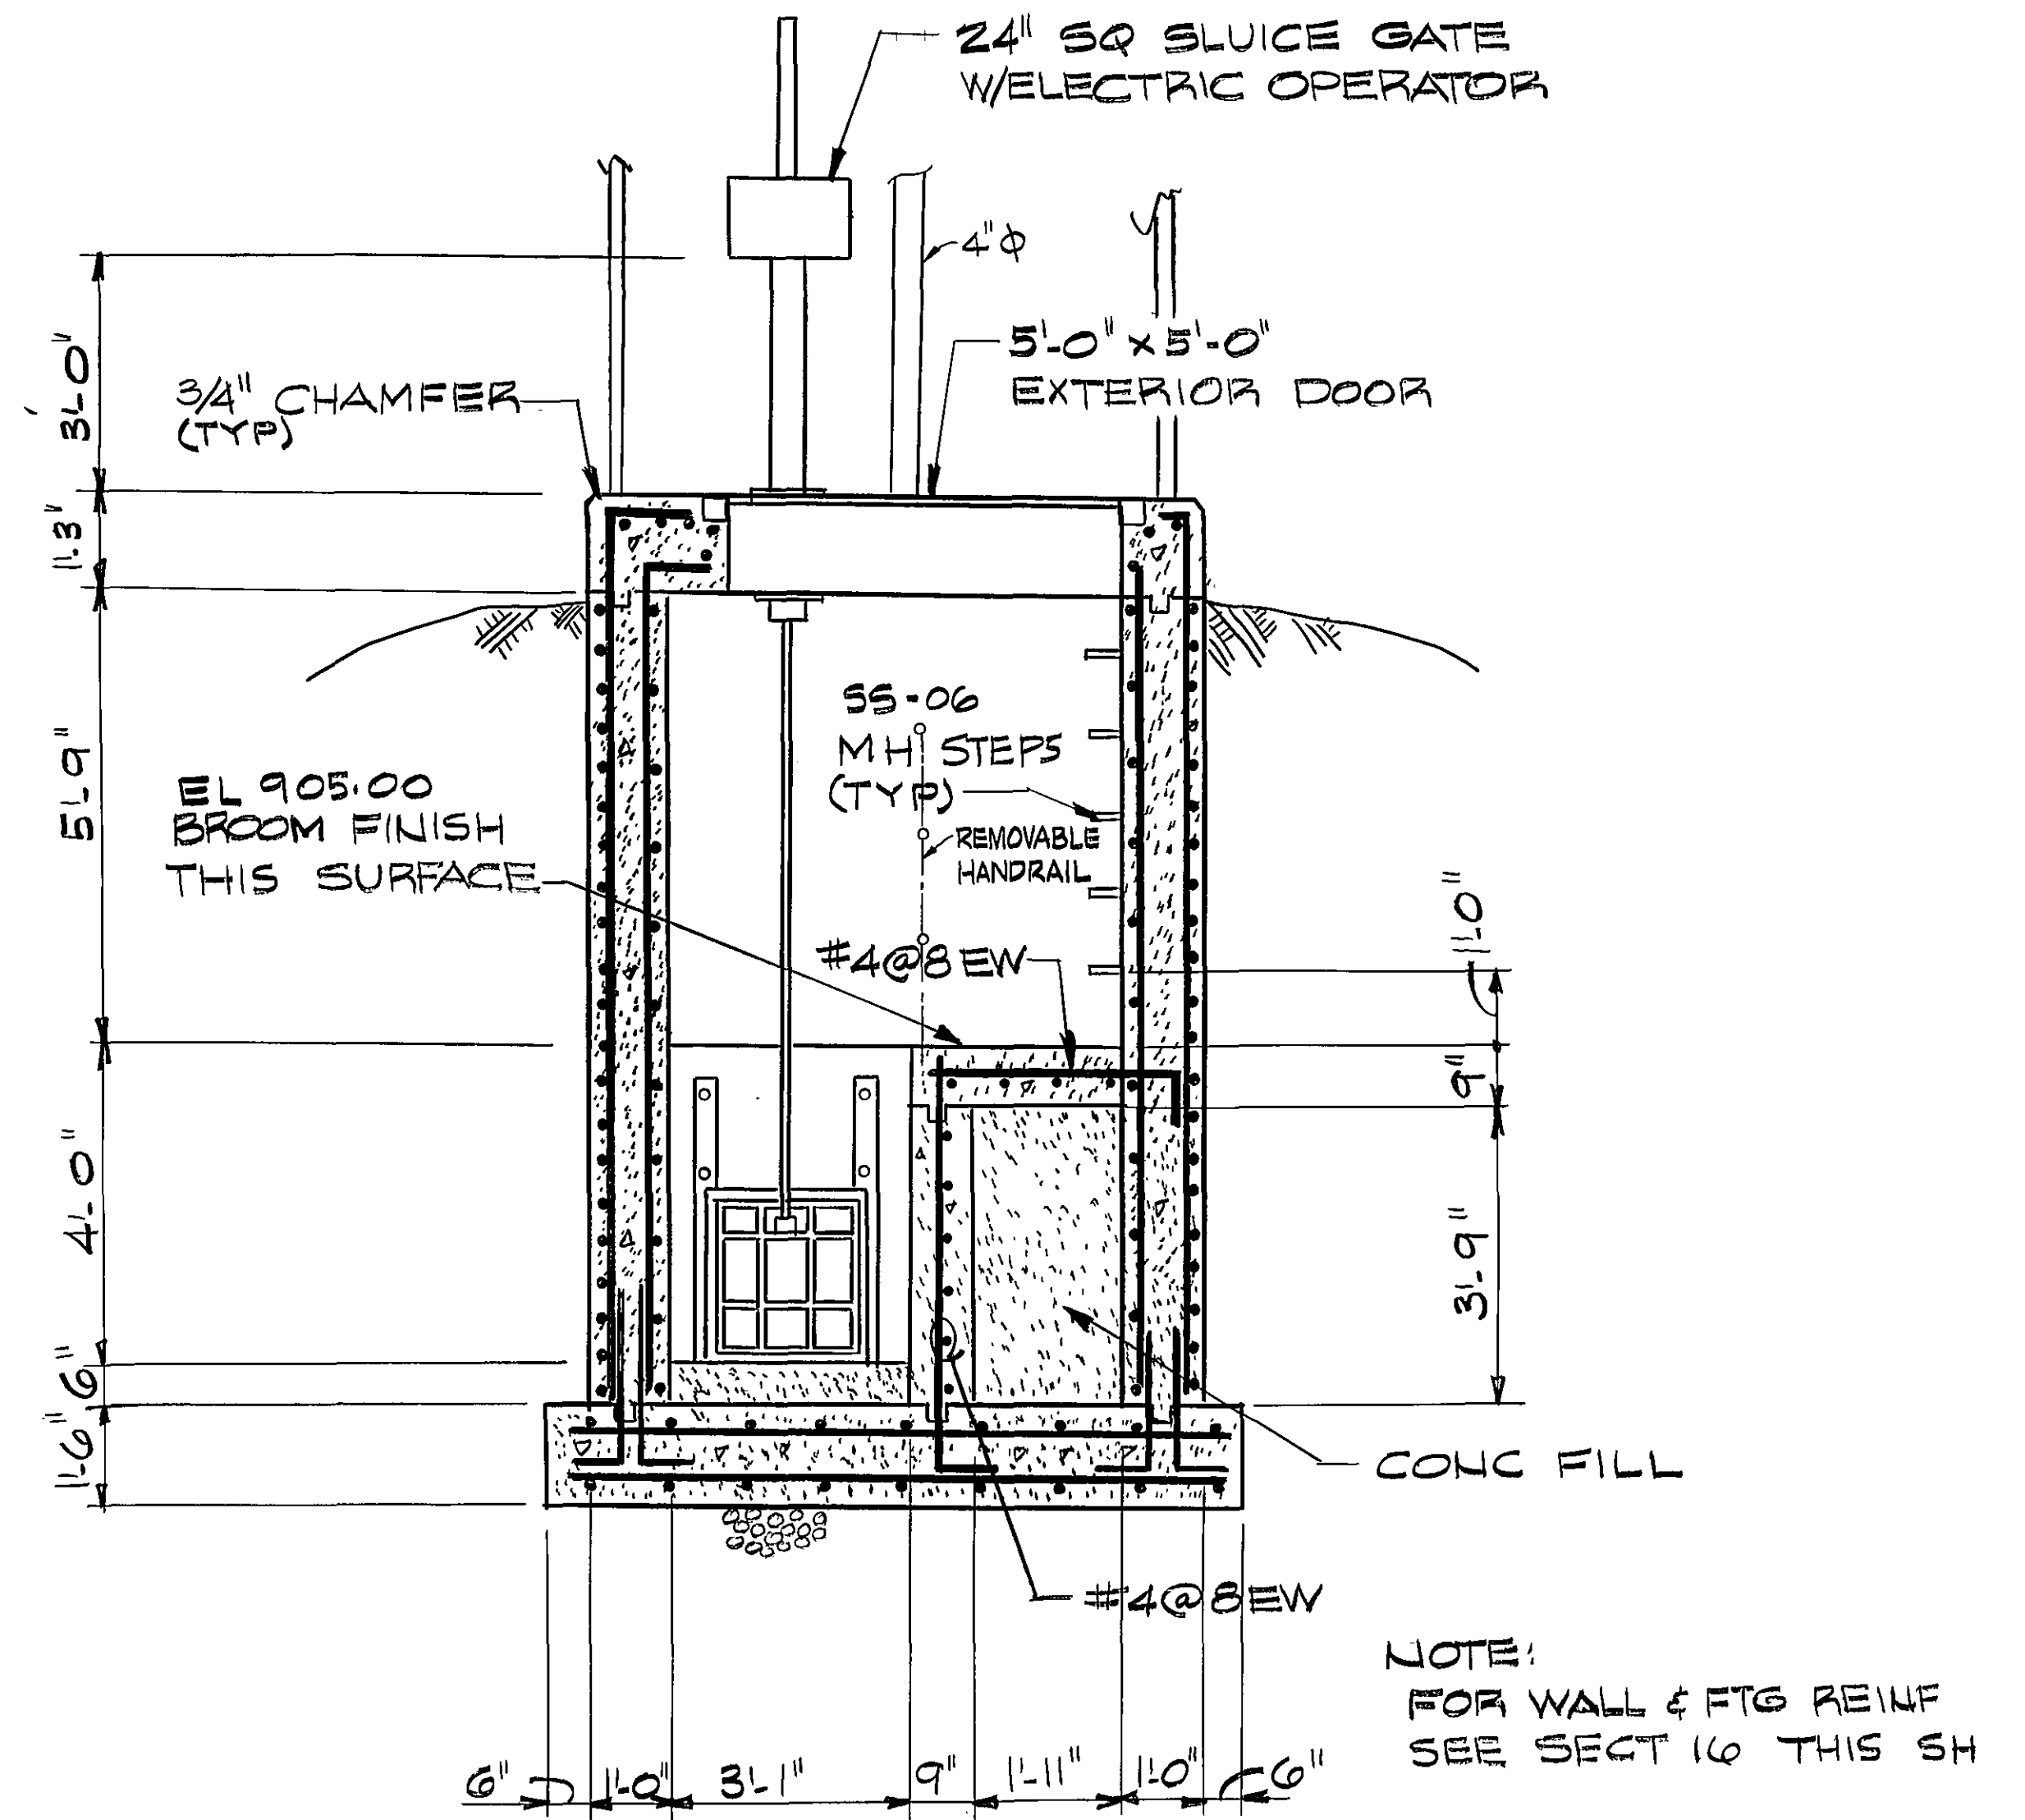

SECTION 2
SCALE: 1/2" = 1'-0"

AS BUILT
MAY 1982

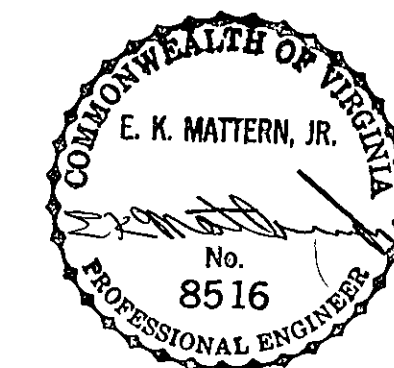

DESIGNED <i>SWH</i>	TINKER CREEK SANITARY SEWER INTERCEPTOR JUNCTION DIVERSION BOX SECTIONS CITY OF ROANOKE, VIRGINIA	
DRAWN <i>MTA</i>		
CHECKED <i>DMG</i>		
APPROVED <i>SWH</i>		
SUBMITTED <i>SWH</i>		
Mattern and Craig CONSULTING ENGINEERS ROANOKE, VIRGINIA		SCALE AS NOTED DATE OCT 1980
		COMM. NO. 347 SHEET 16