

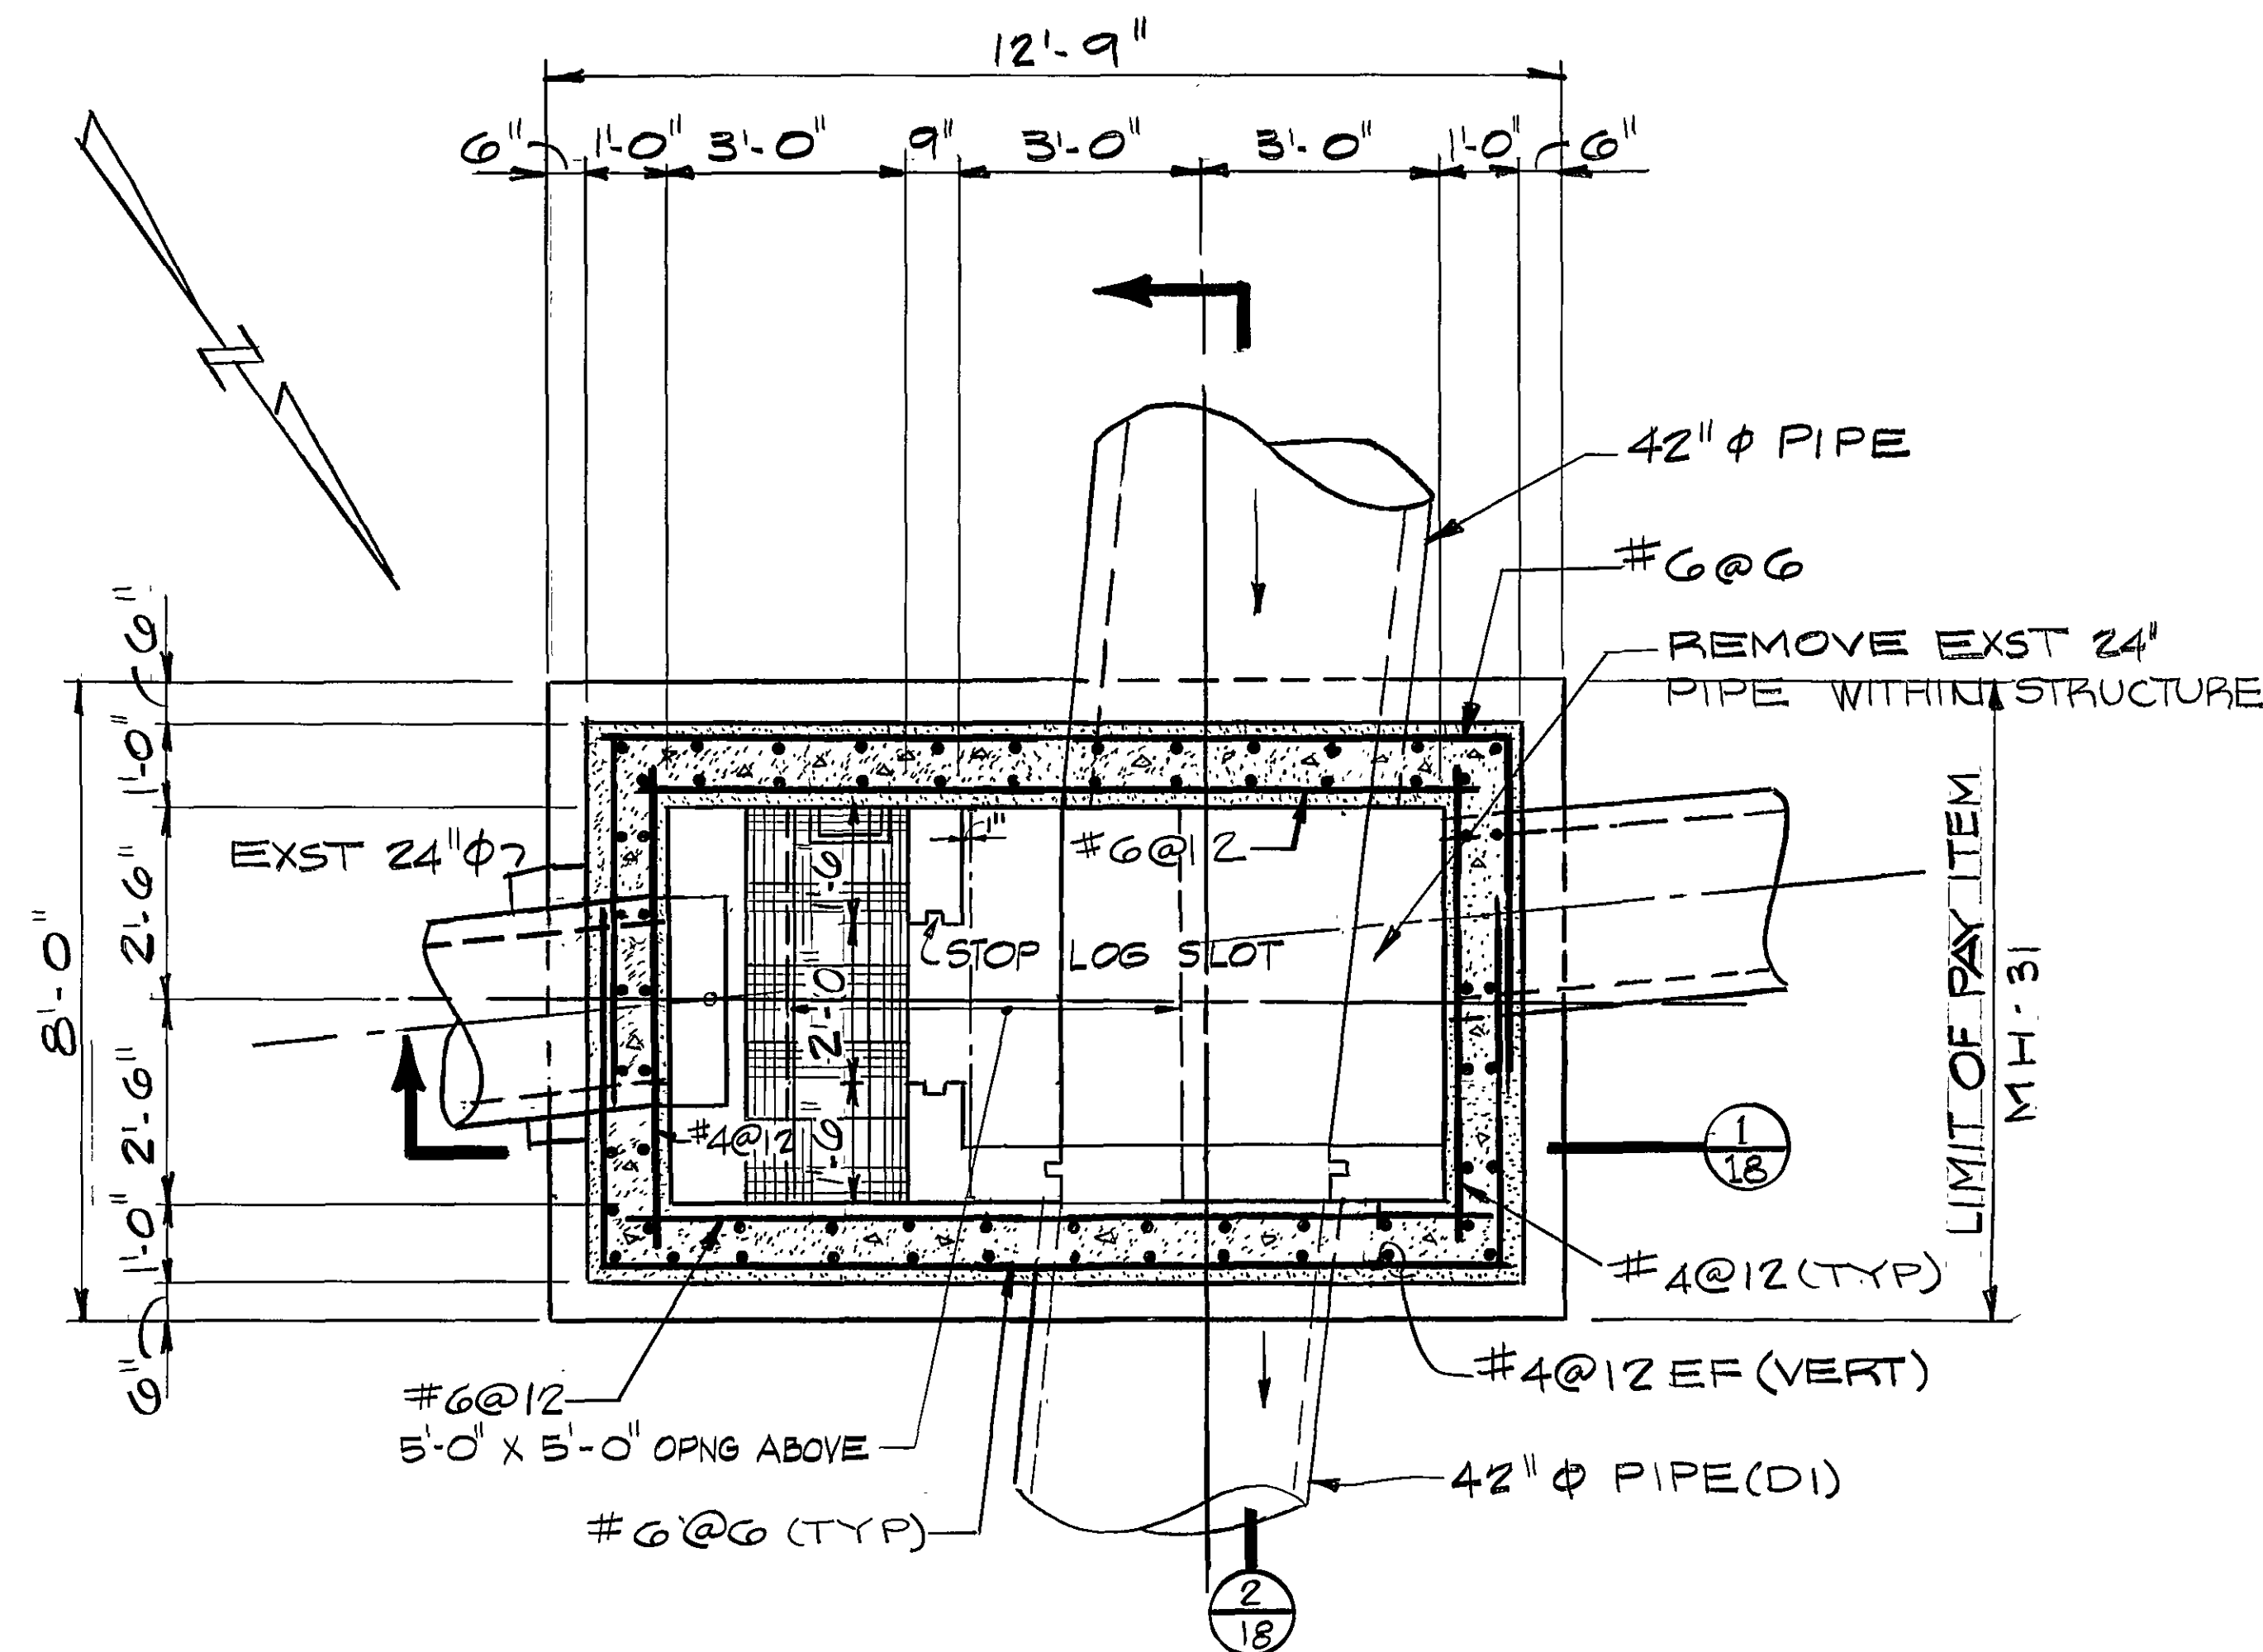


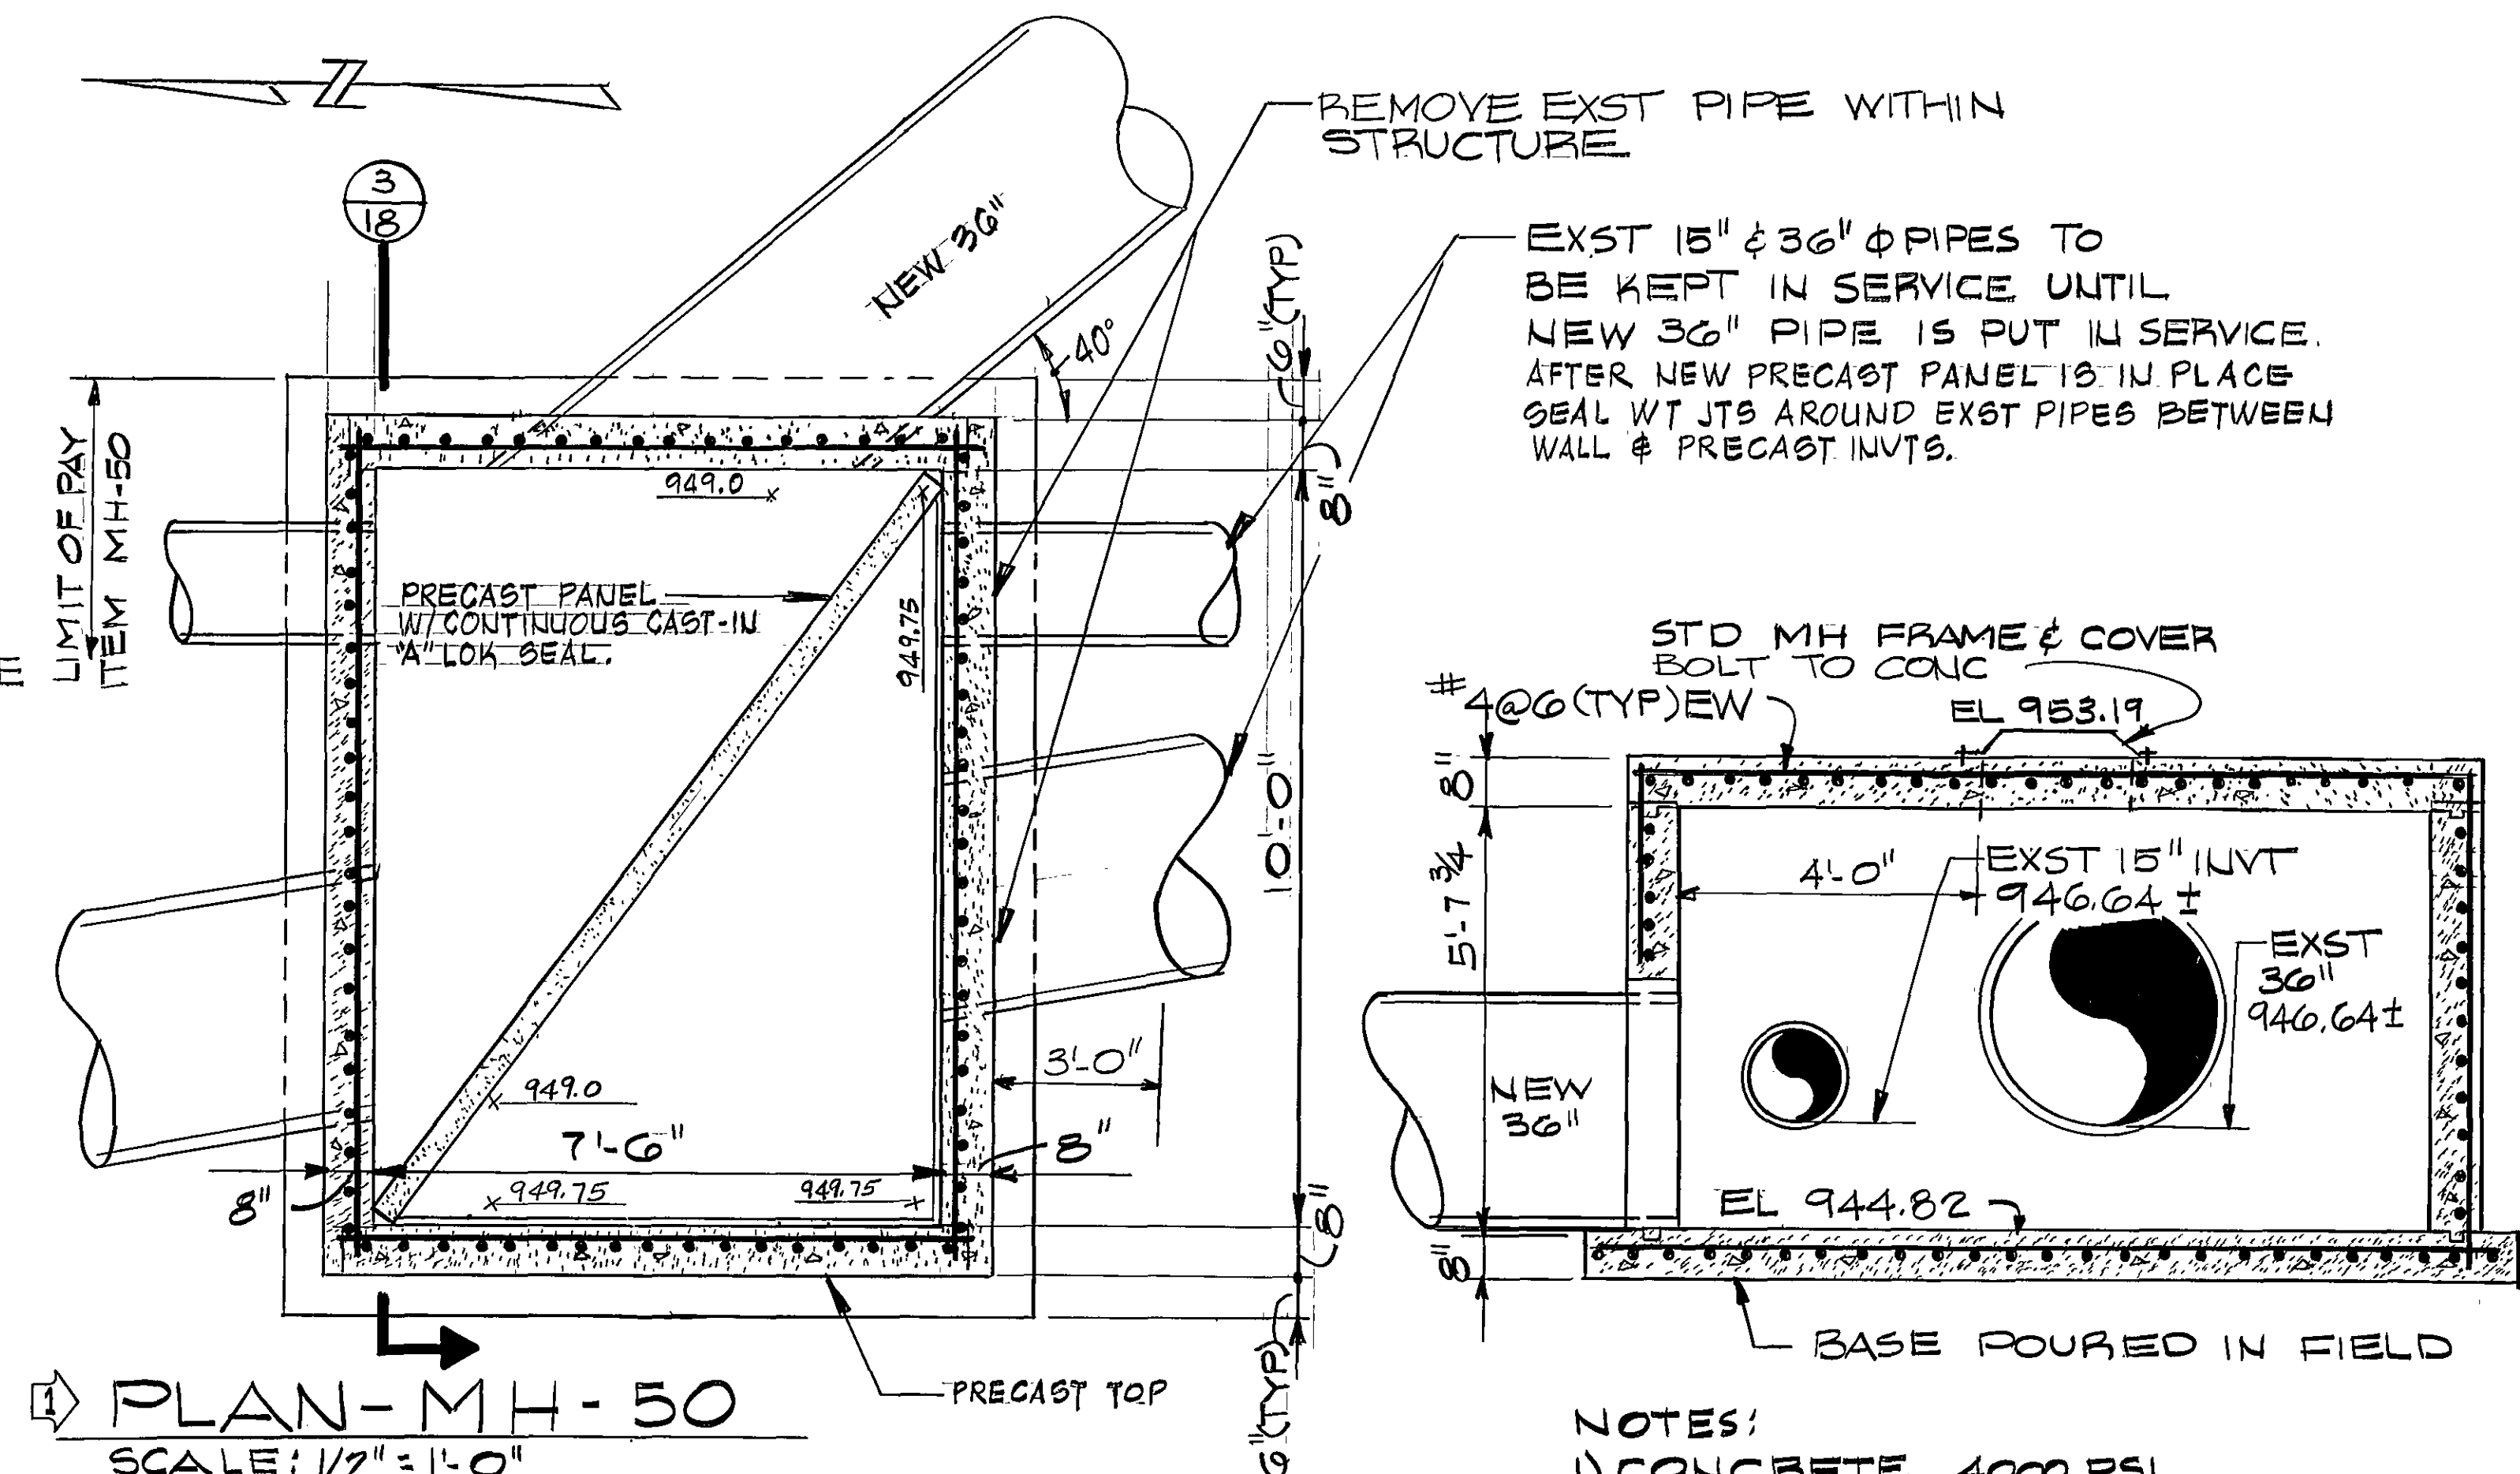


PLAN-MH-31
SCALE: 1/2" = 1'-0"

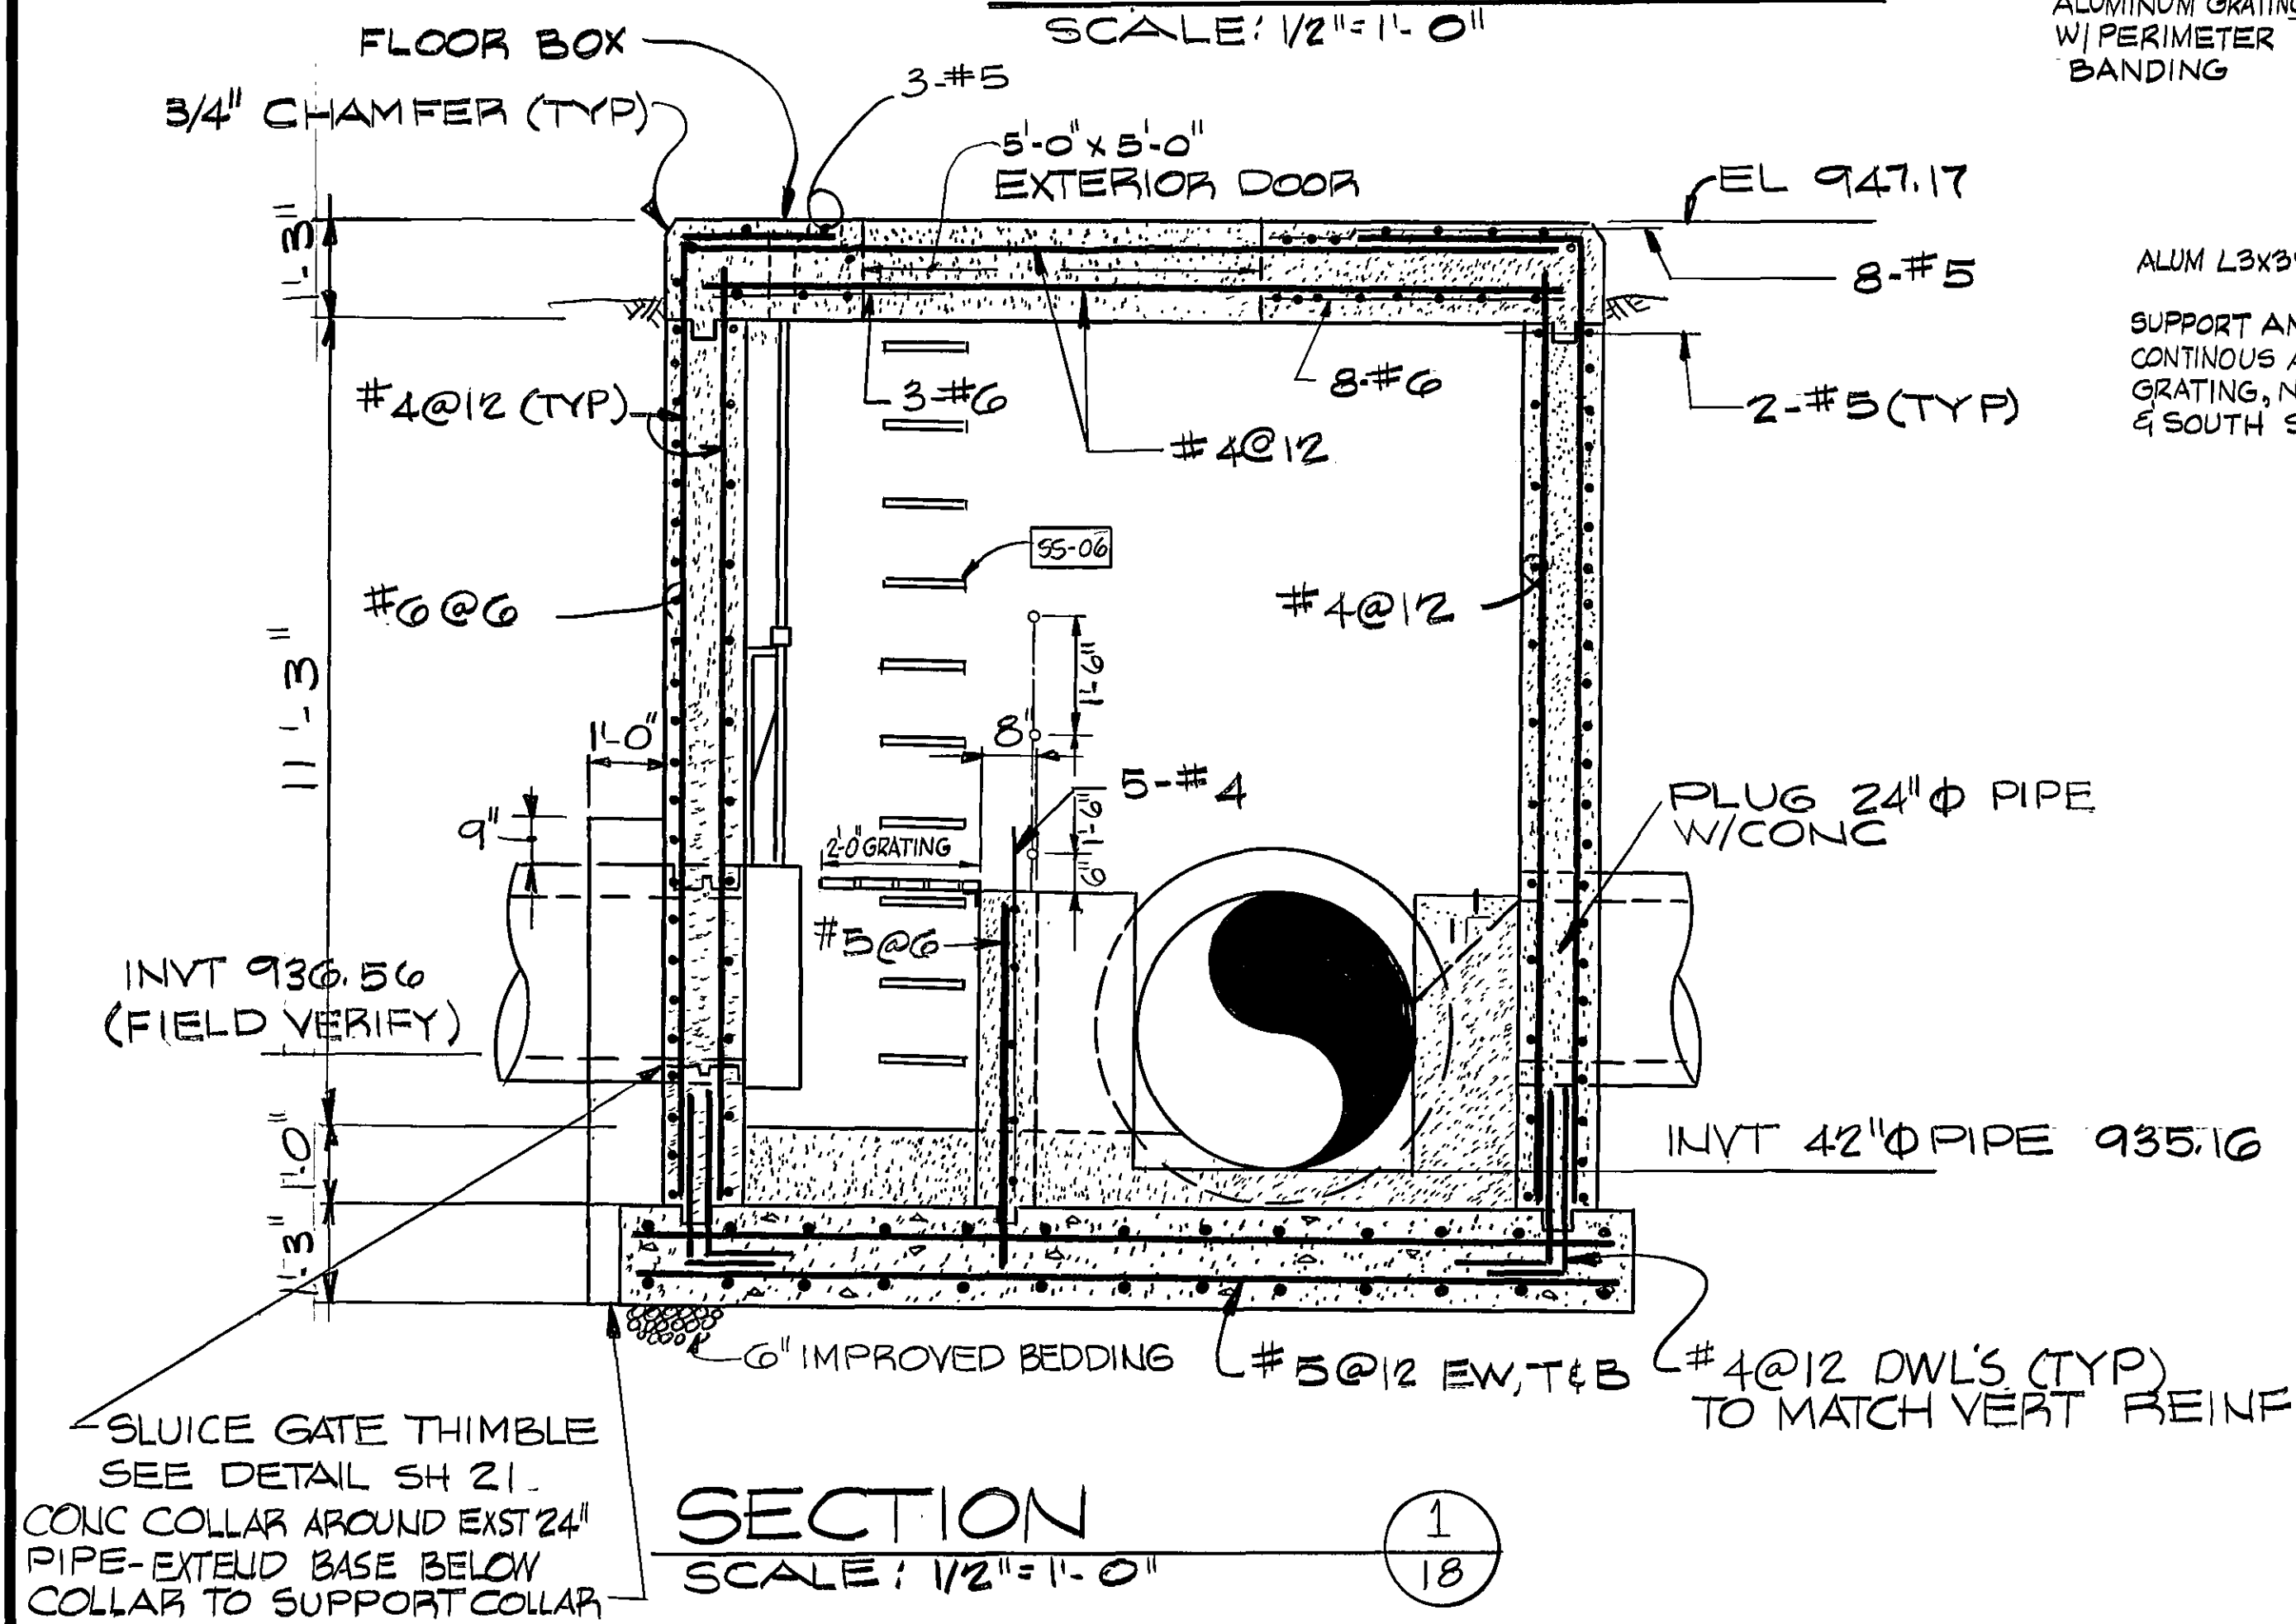

- NOTES:
- 1) CONCRETE 4000 PSI
 - 2) JOINTS TO BE BOLTED W/ 3/4" LAG BOLTS INTO CONCRETE INSERTS
 - 3) JOINTS SEALED W/ BUTYL RUBBER SEALANT
 - 4) INVERT TO BE PRECAST

SECTION
SCALE: 1/2" = 1'-0"

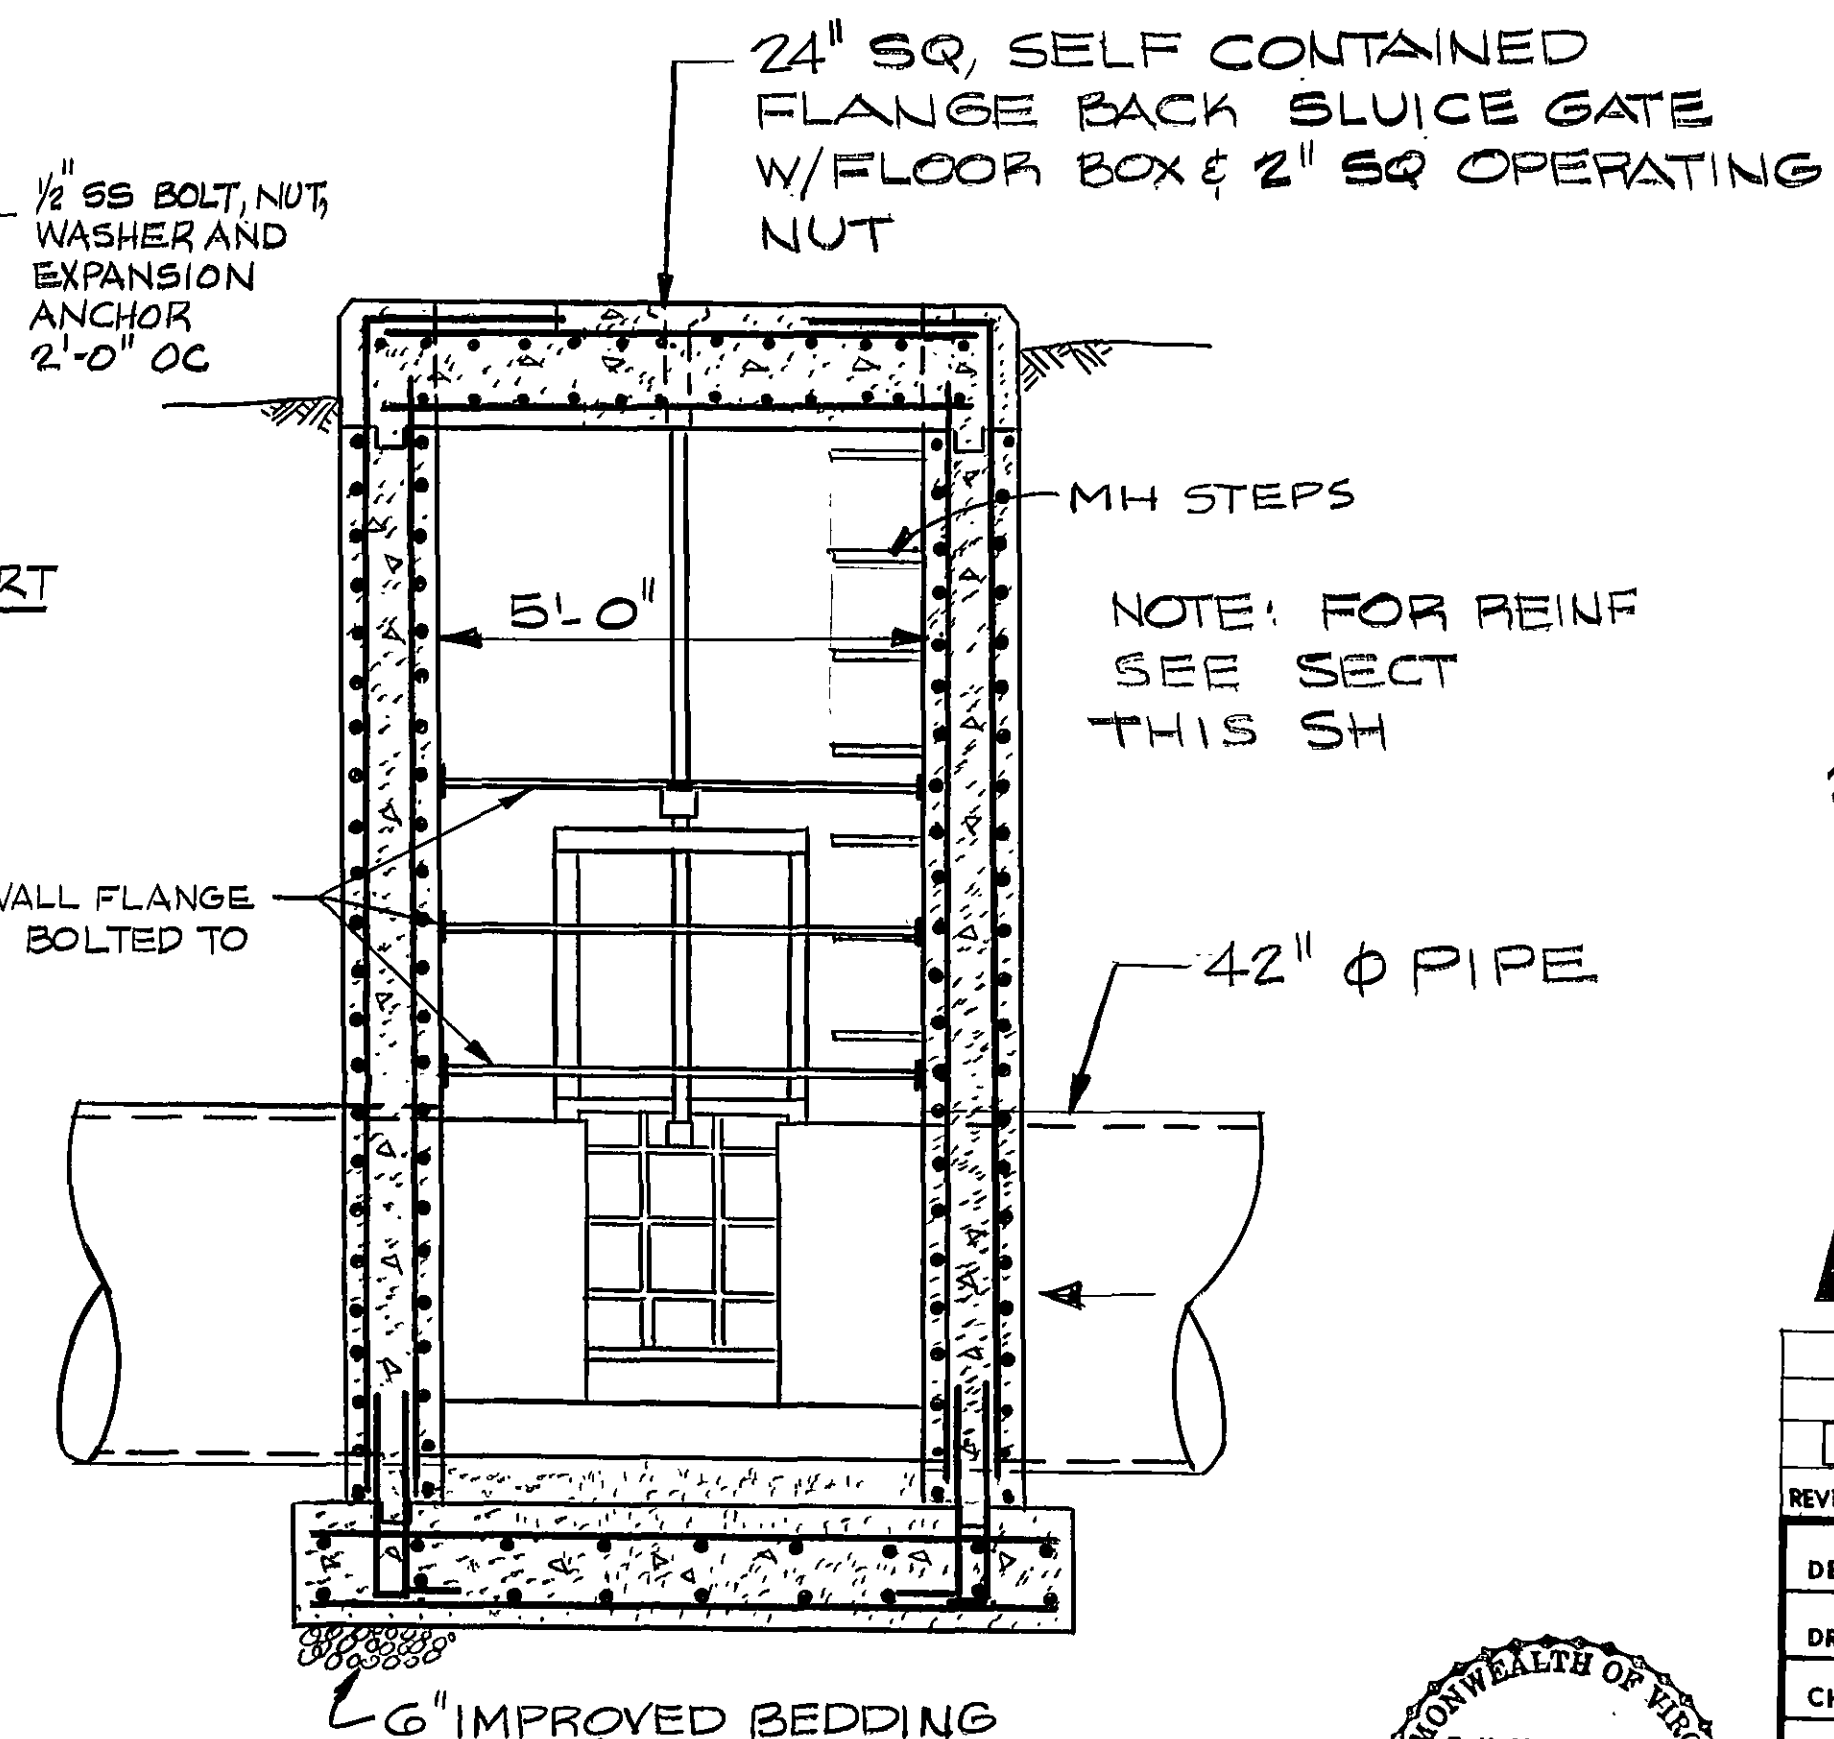

- NOTES:
- 1) SEE SH 21 FOR STOP LOG SLOT DETAIL
 - 2) FOR EXTRA REINF AROUND OPNGS, SEE STD DETAILS 10 & 11

MAY 1982
AS BUILT

