

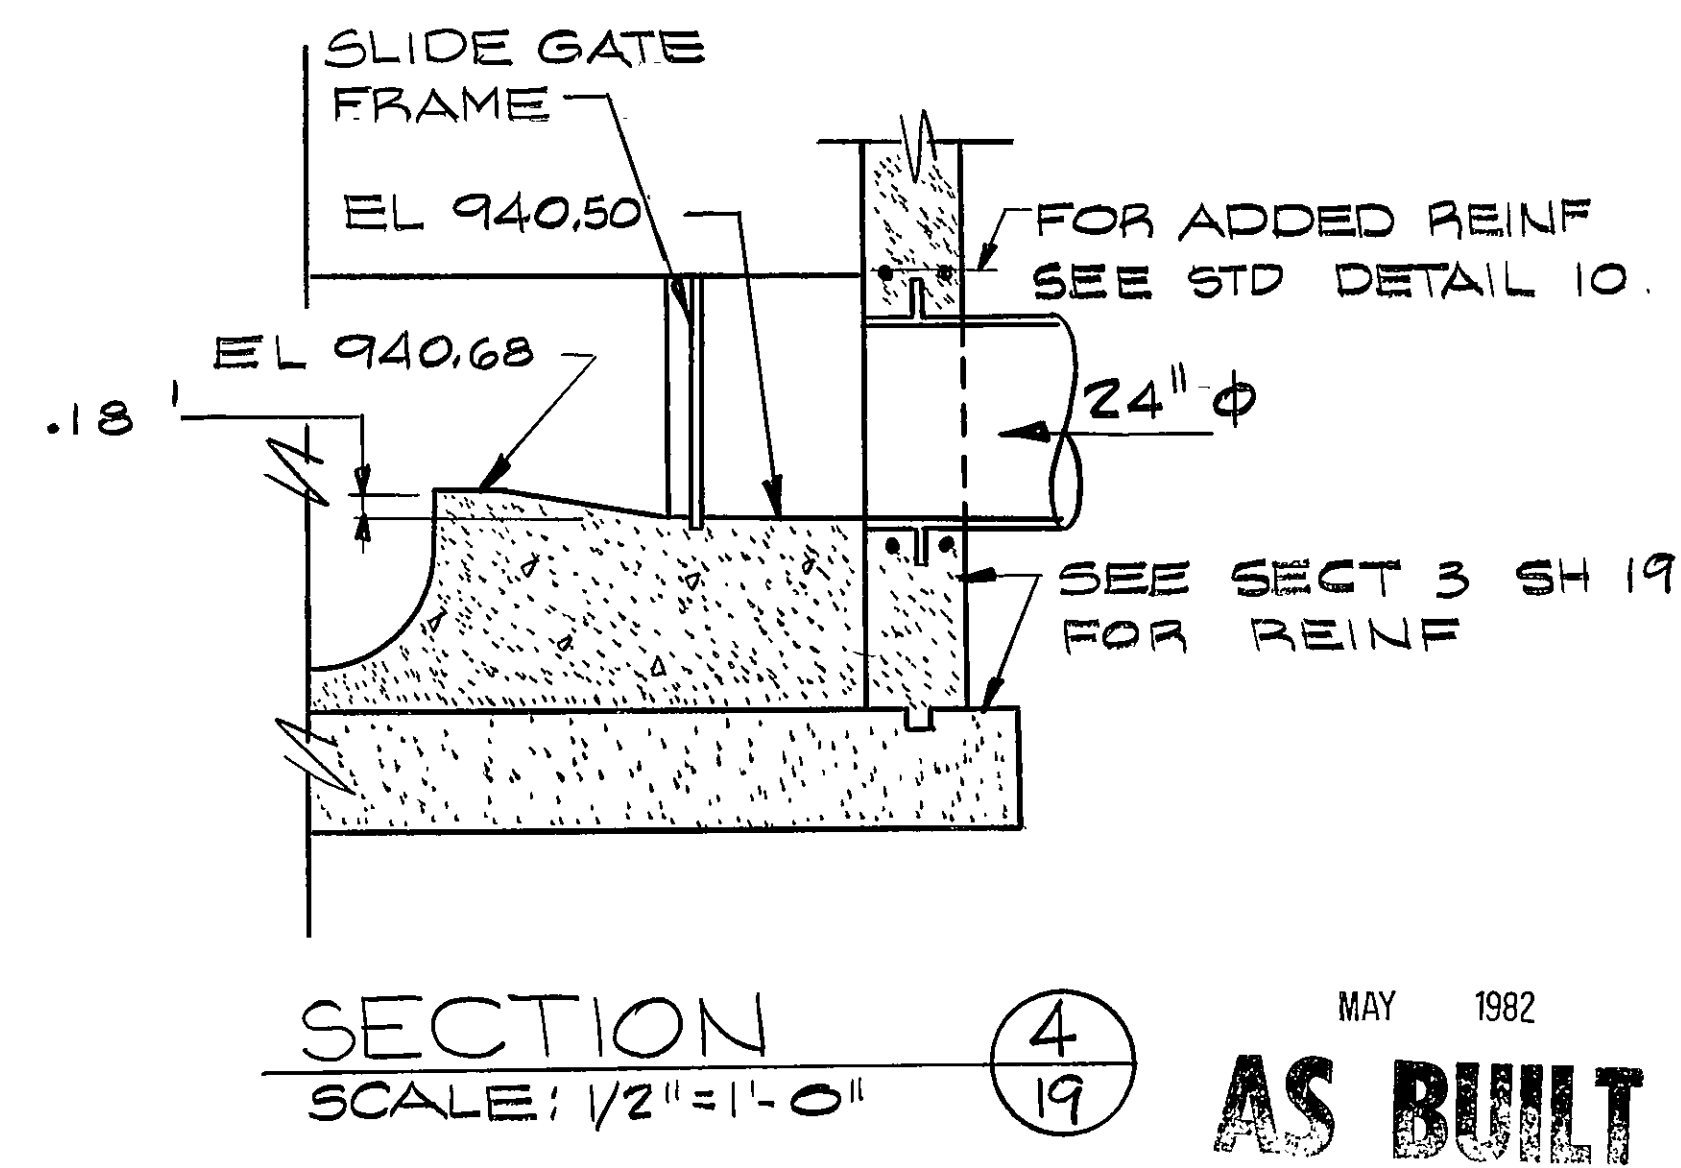
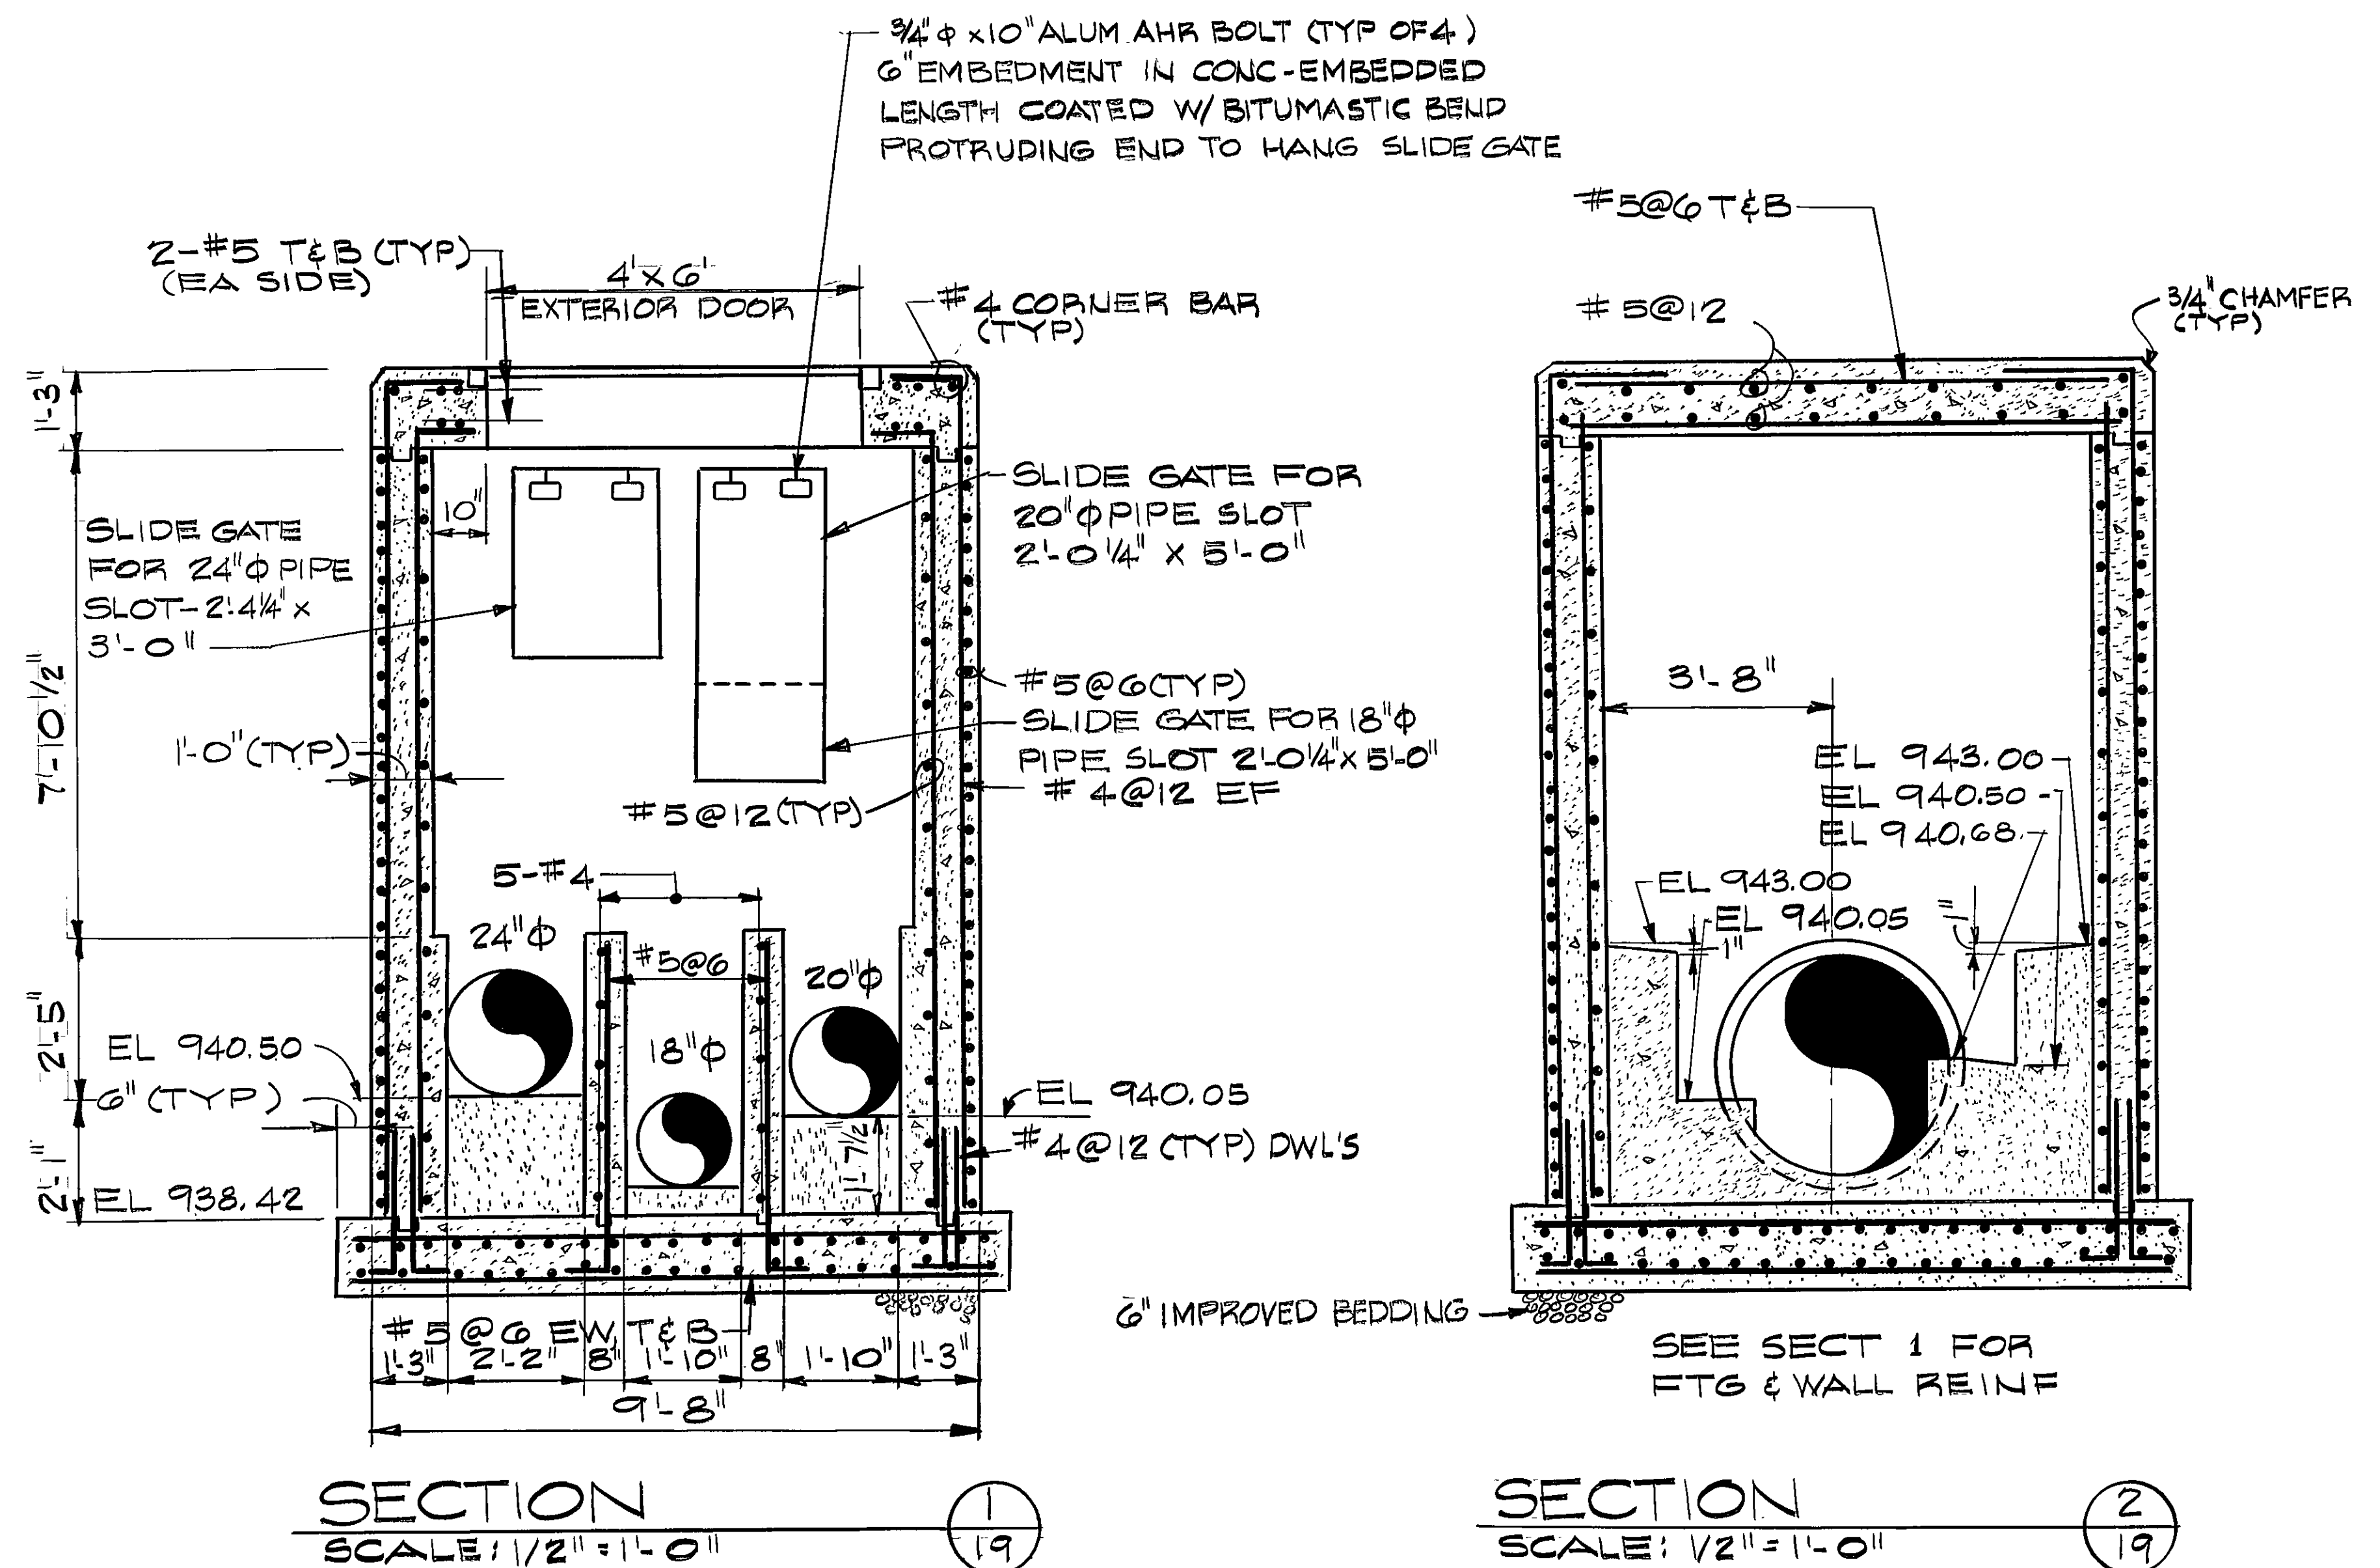
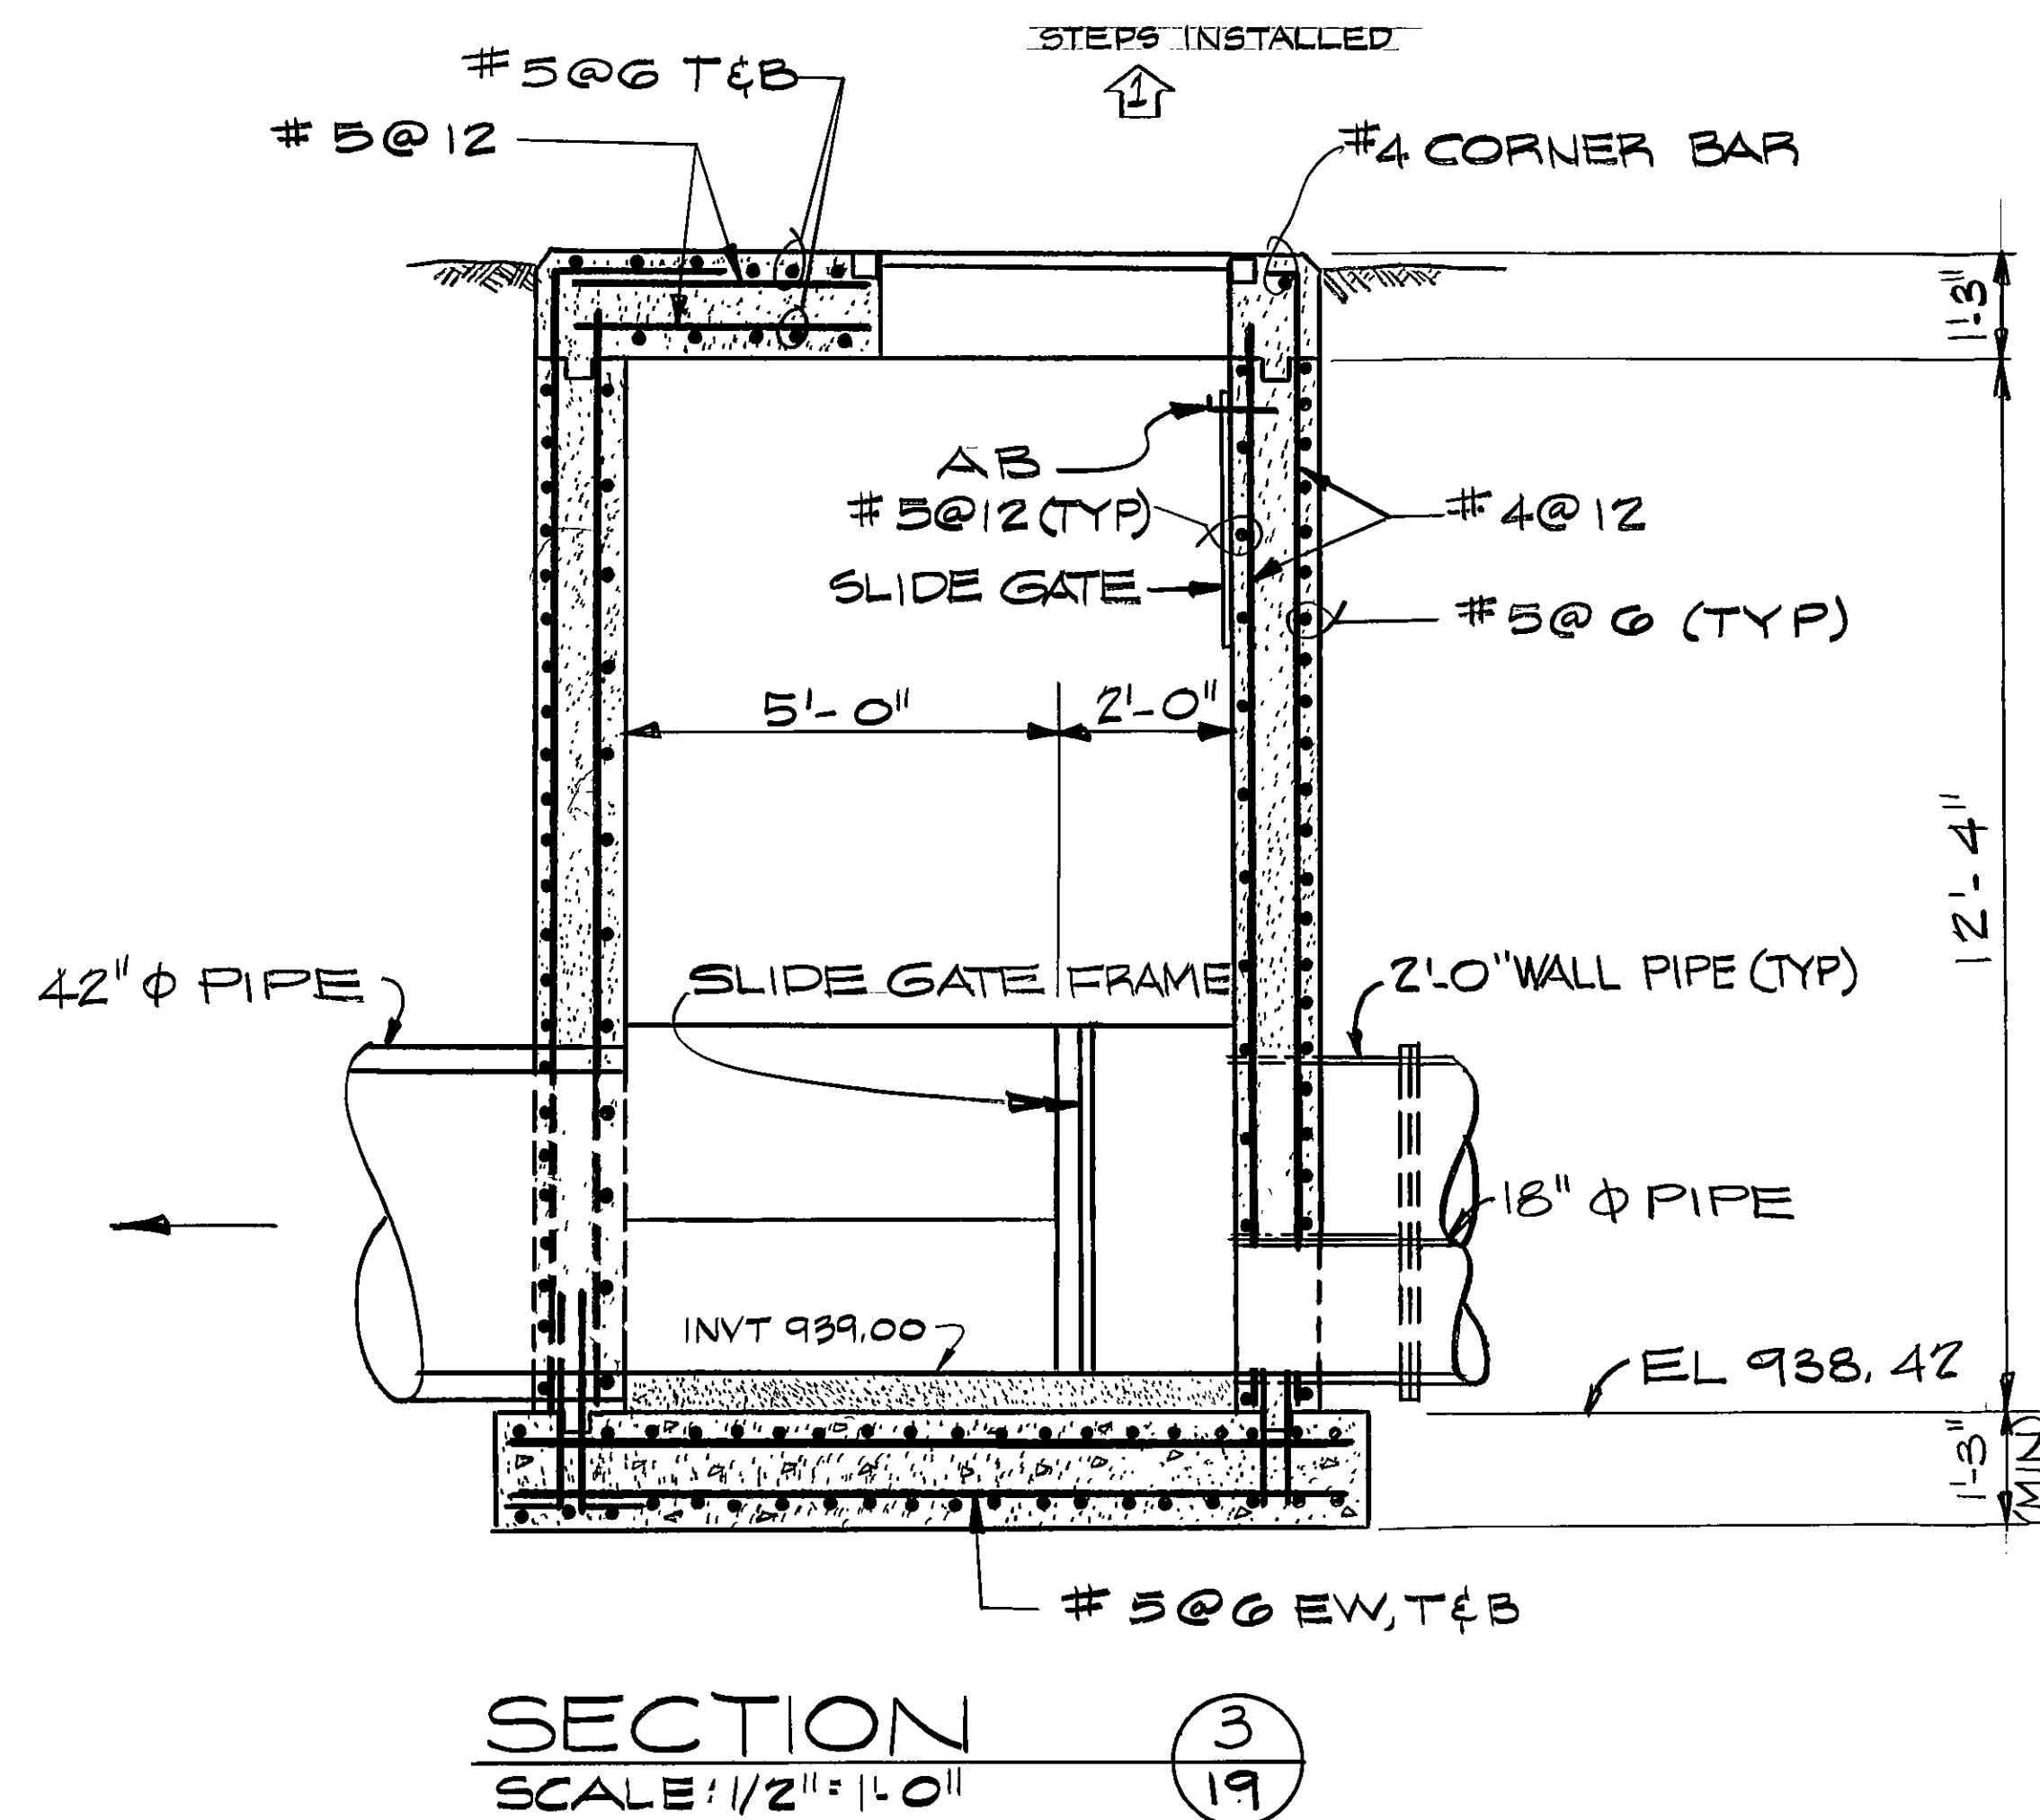


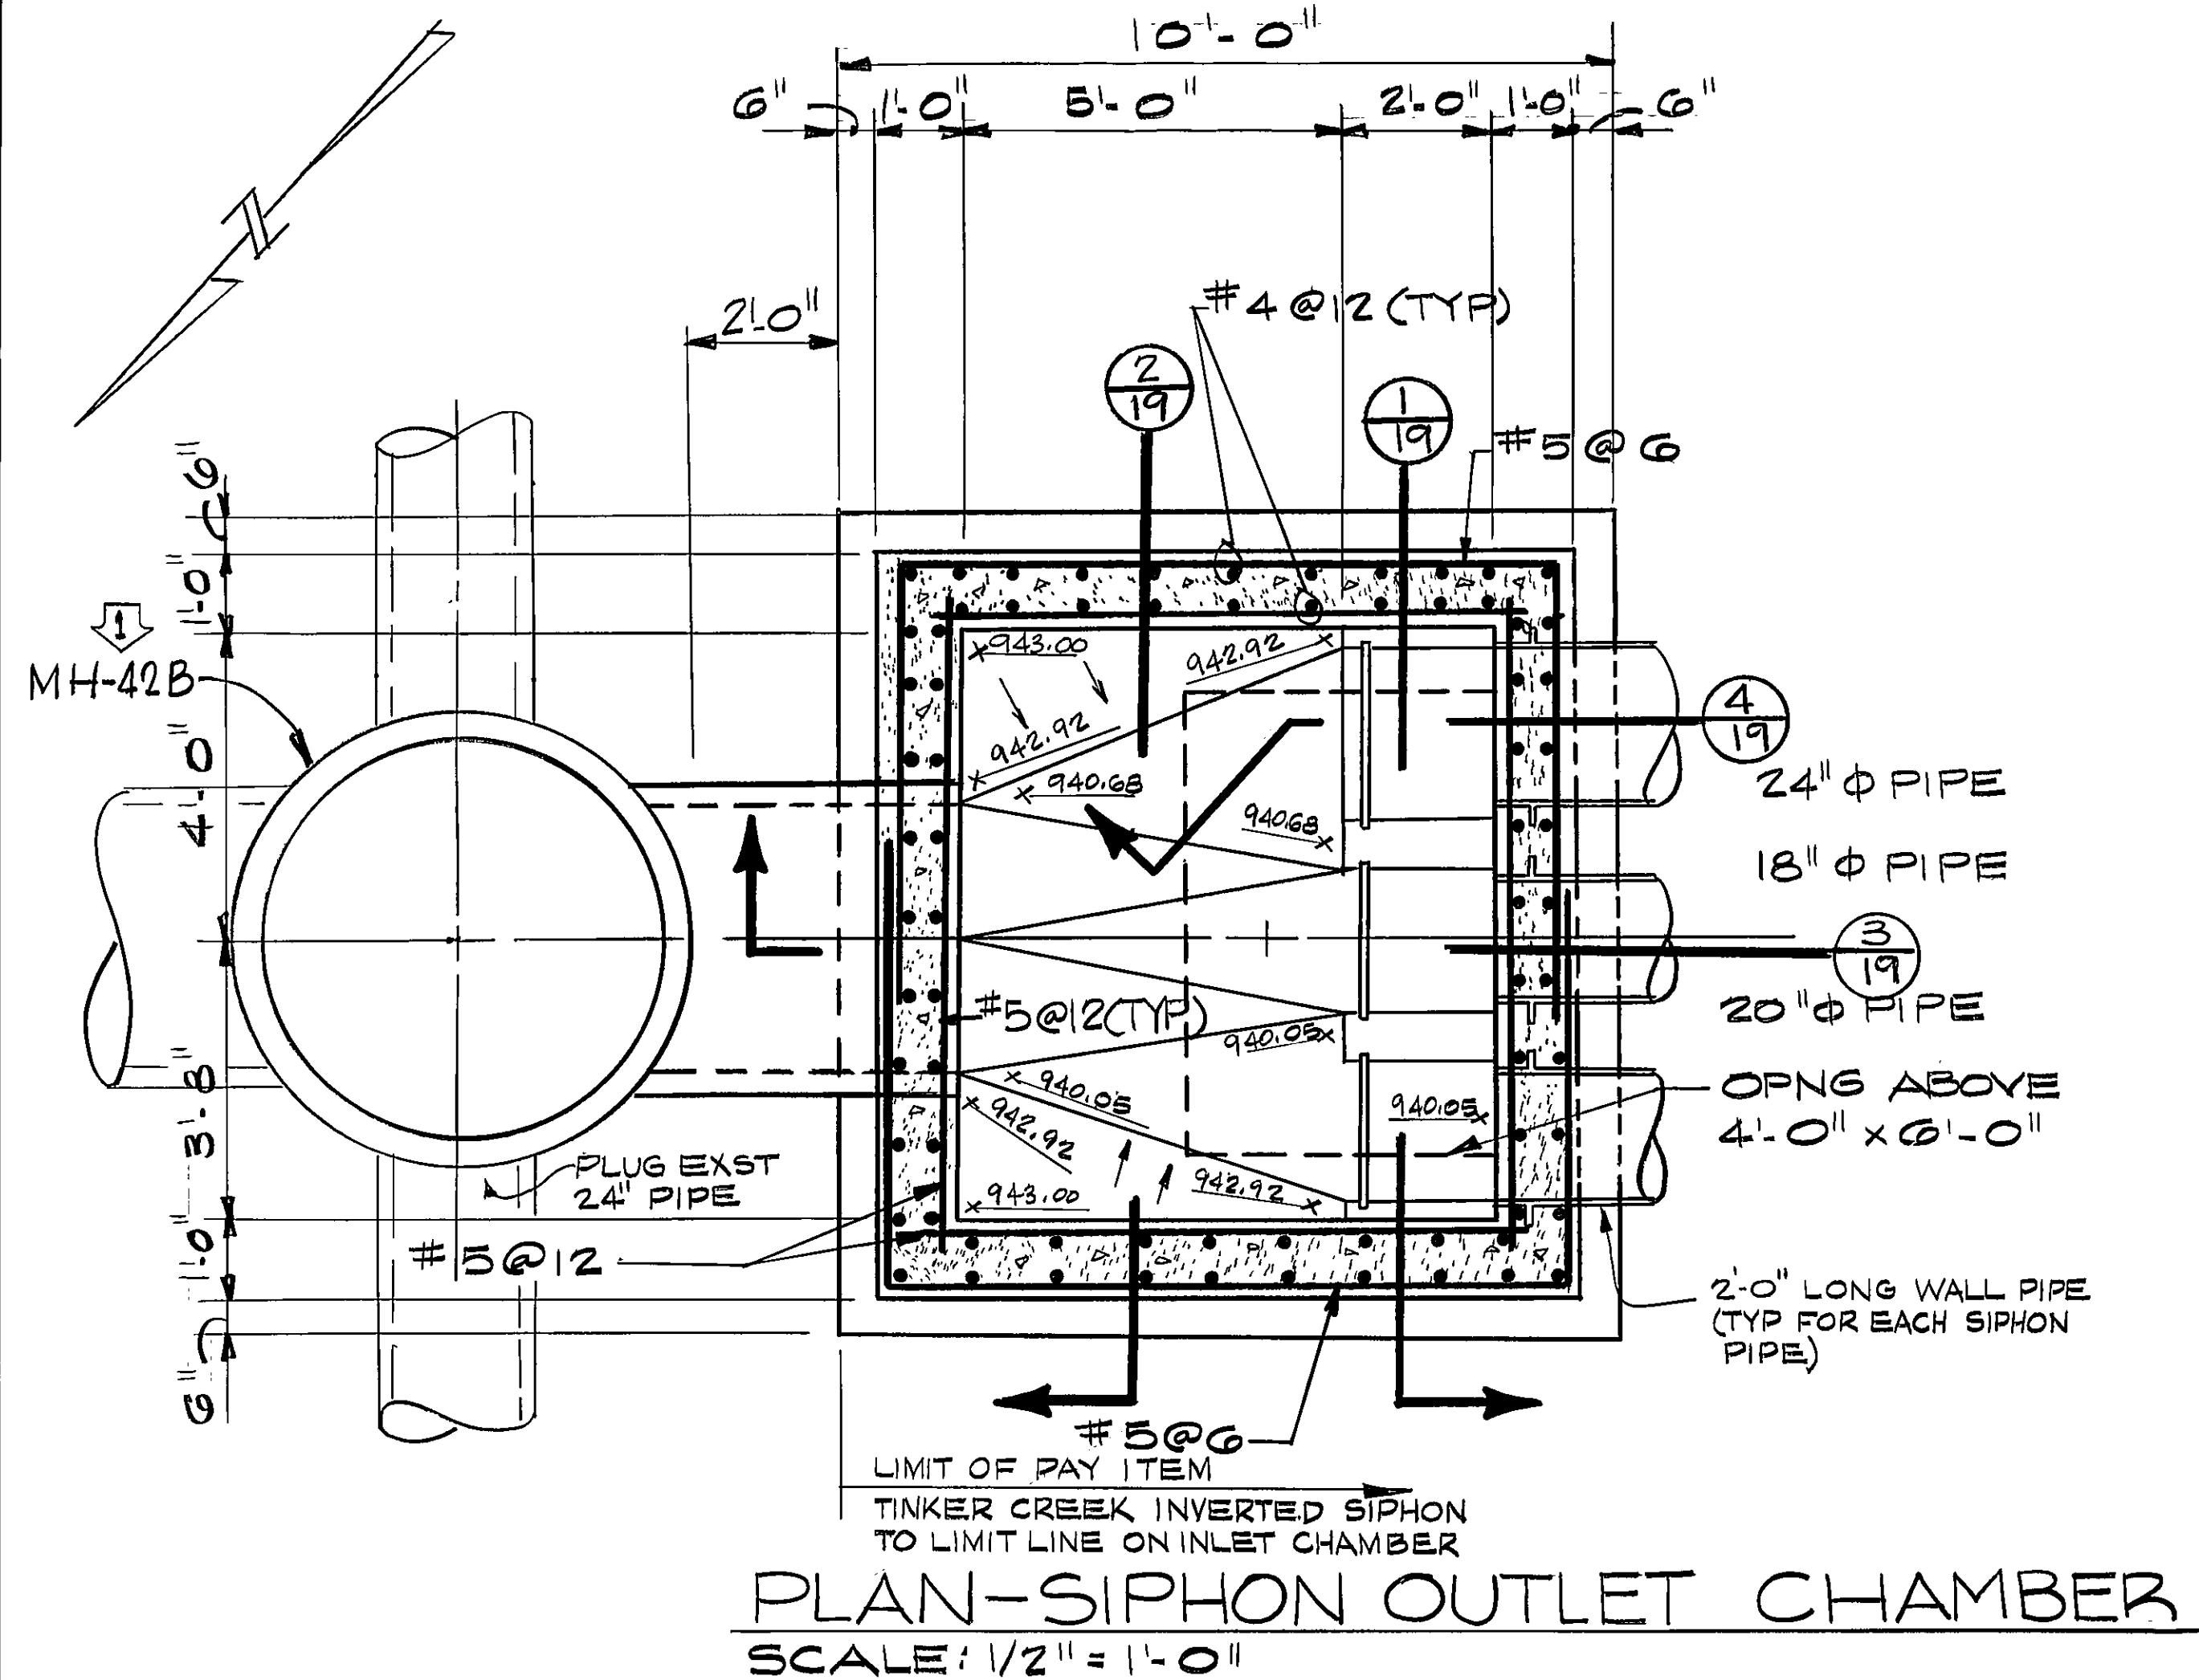

DESIGNED	SWH	DATE	MAY 82	DESCRIPTION	AS BUILT	BY	DMC	APP	SWH
DRAWN	MTA	CHECKED	DMP	APPROVED	JWC	SUBMITTED	2-2-82	TINKER CREEK SANITARY SEWER INTERCEPTOR	
								SIPHON OUTLET CHAMBER	
								CITY OF ROANOKE, VIRGINIA	
Mattern and Craig								SCALE: AS NOTED	COMM. NO. 347
CONSULTING ENGINEERS								DATE: OCT 1980	SHEET 19
ROANOKE, VIRGINIA									

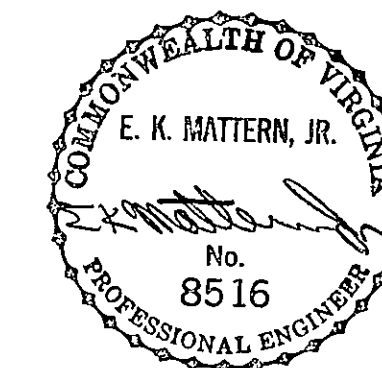

MAY 1982
AS BUILT