




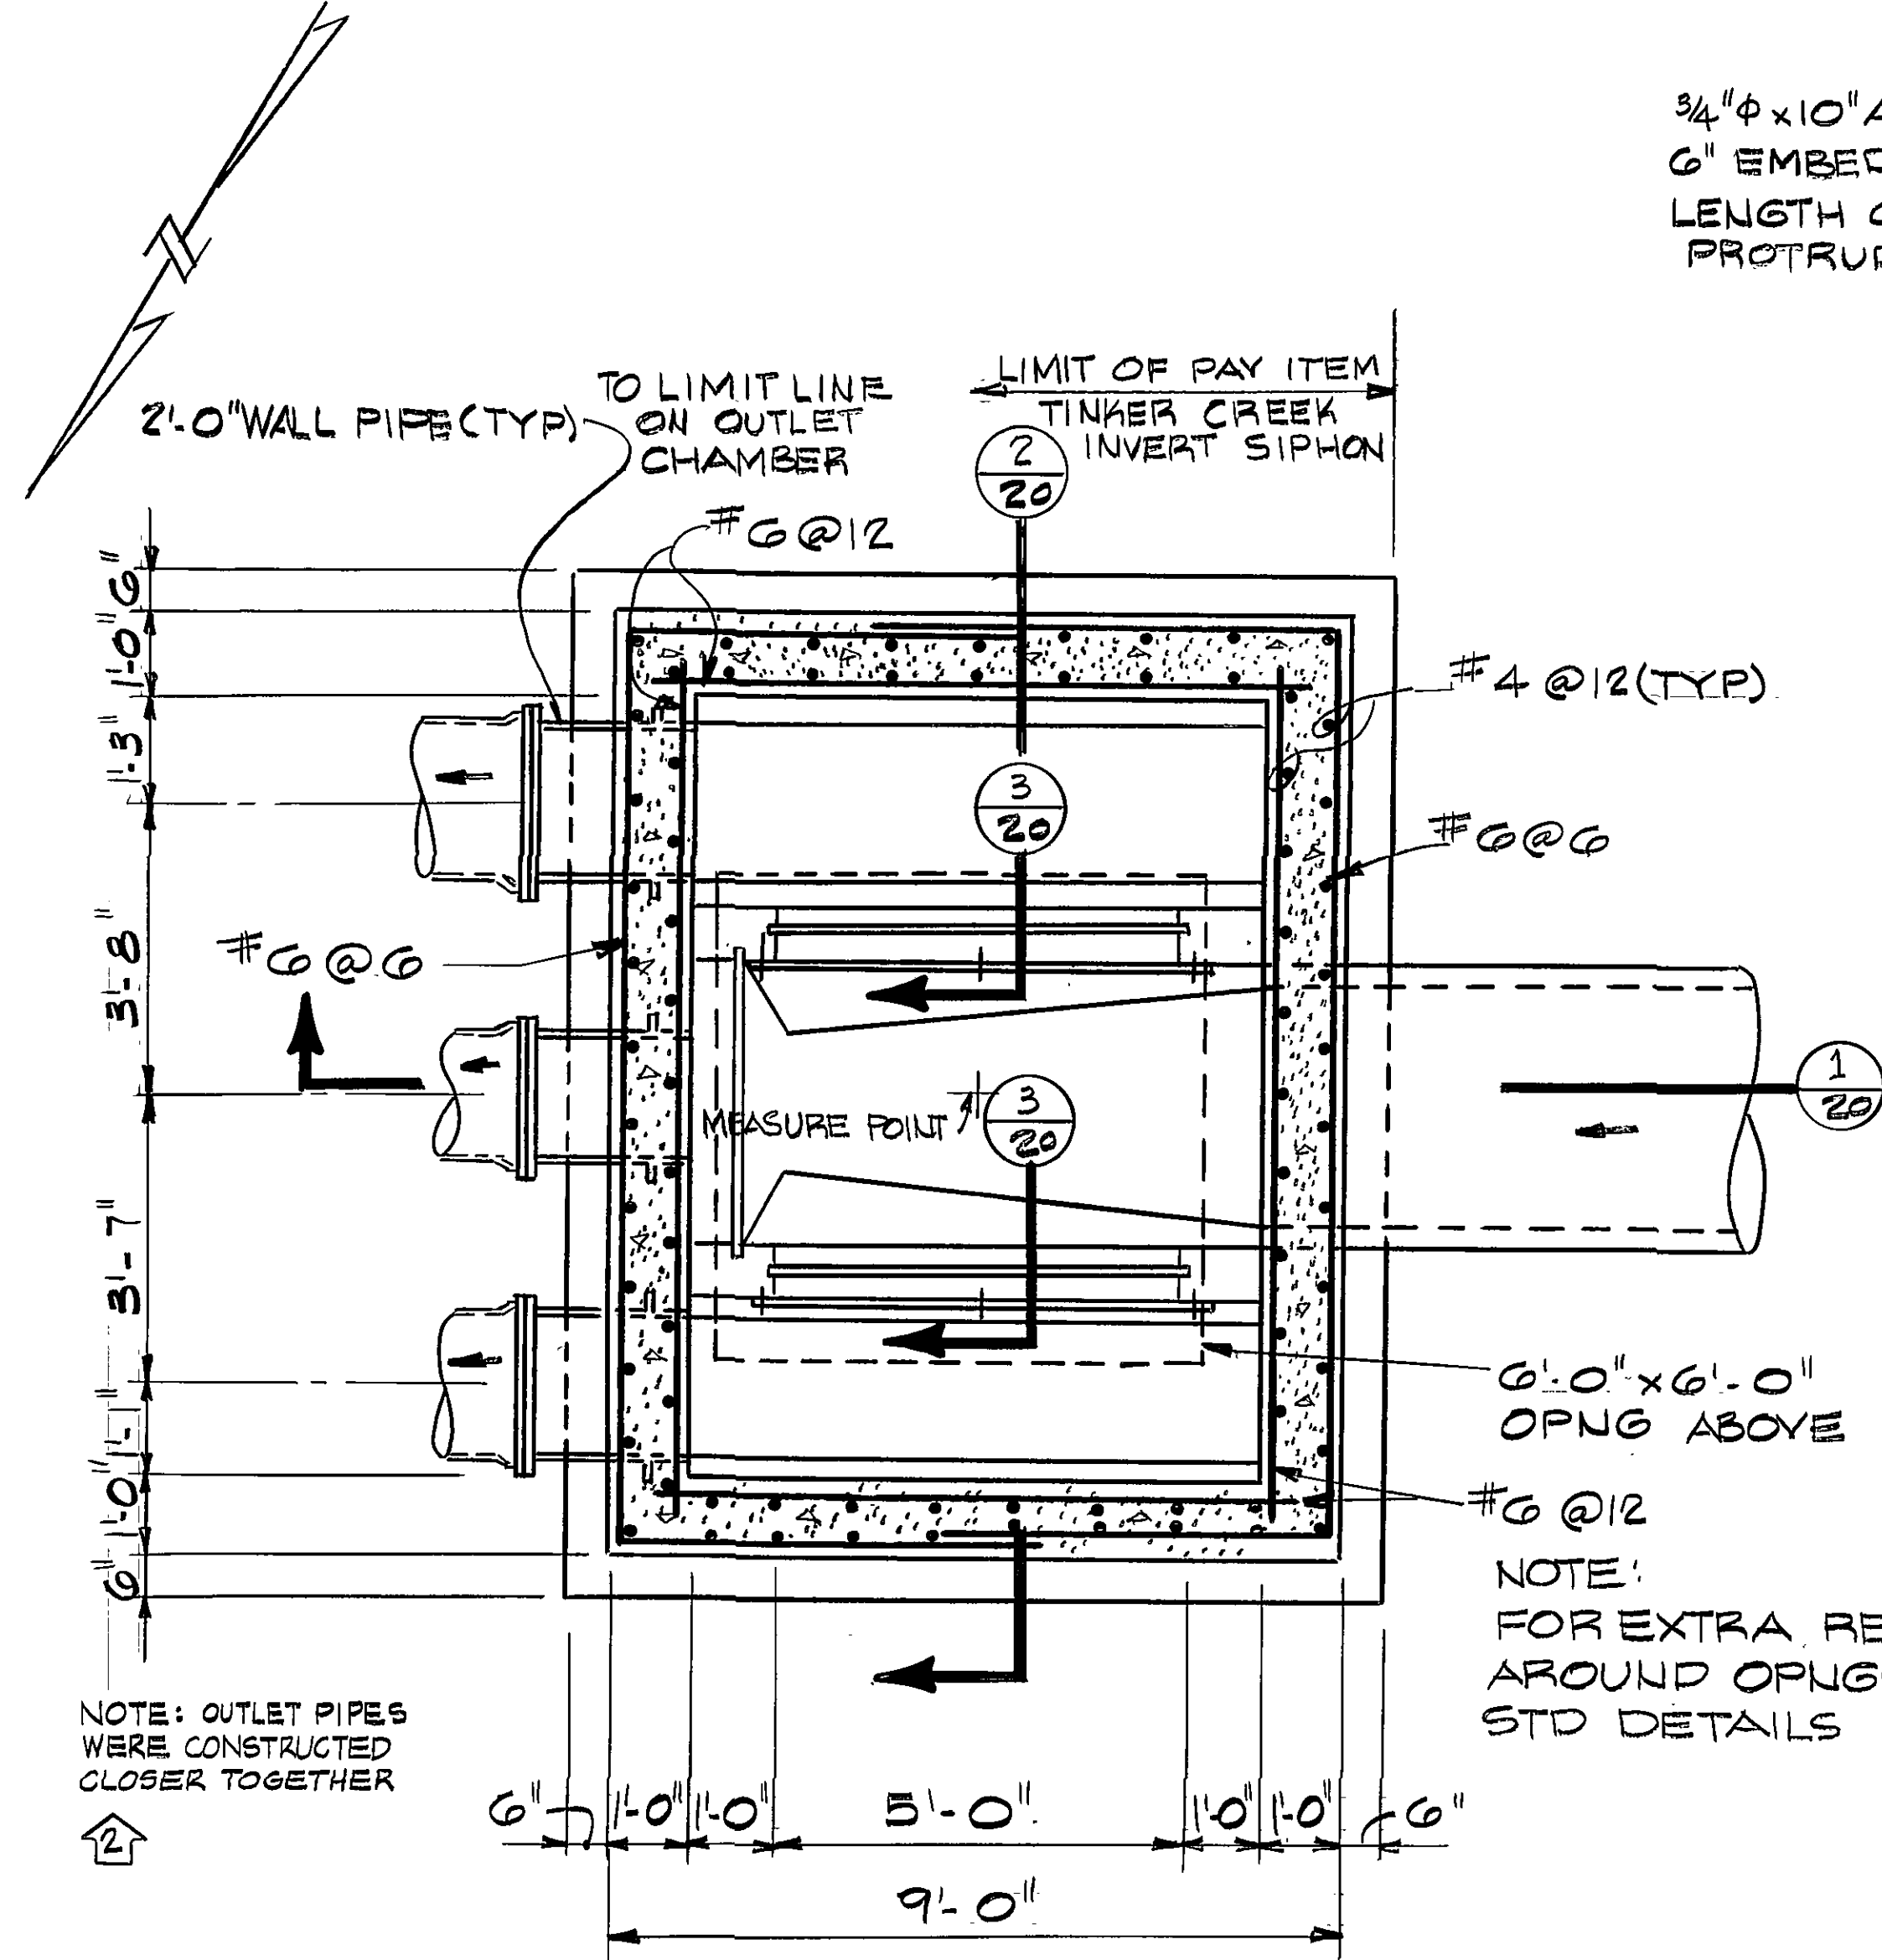


PLAN-SIPHON INLET CHAMBER
SCALE: 1/2" = 1'-0"

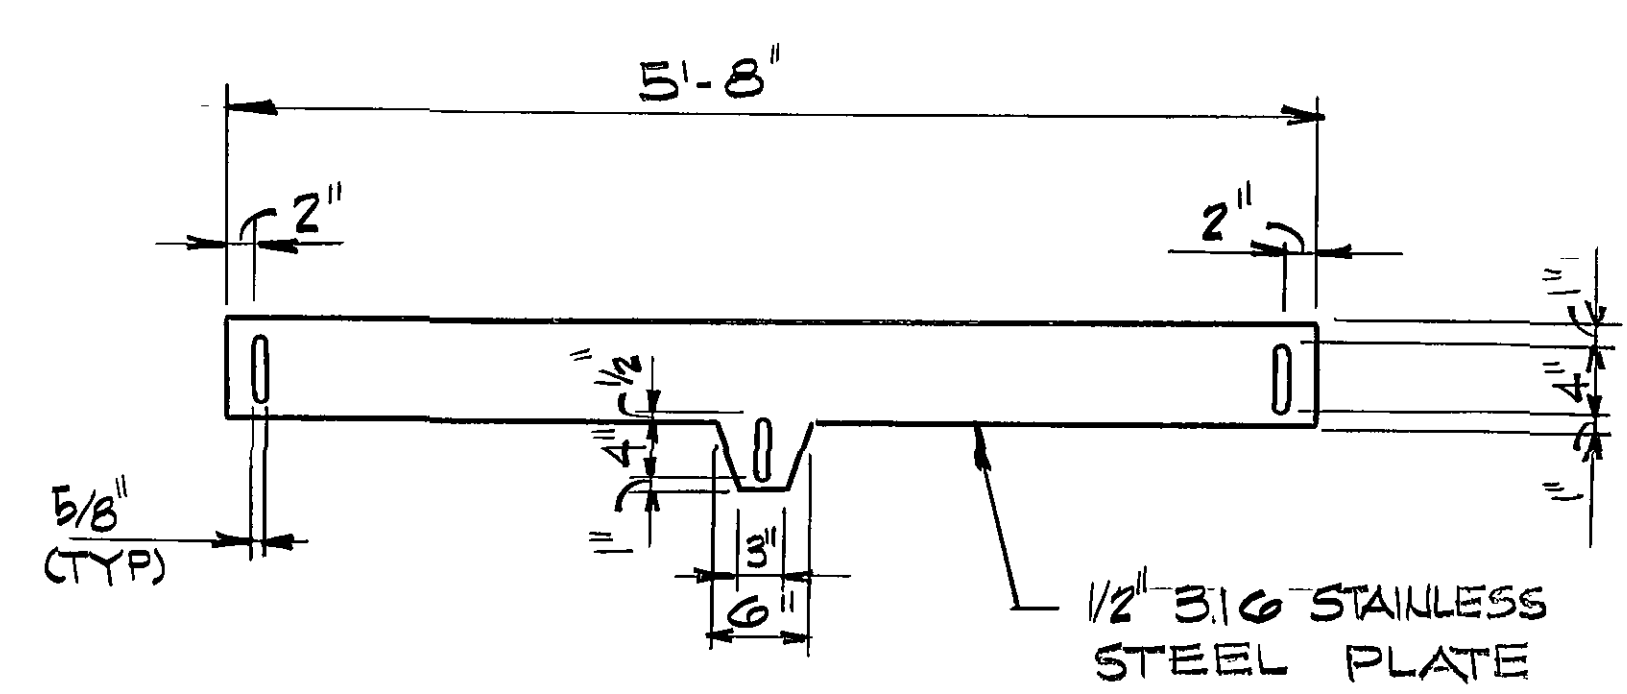


WEIR PLATE DETAIL
NO SCALE

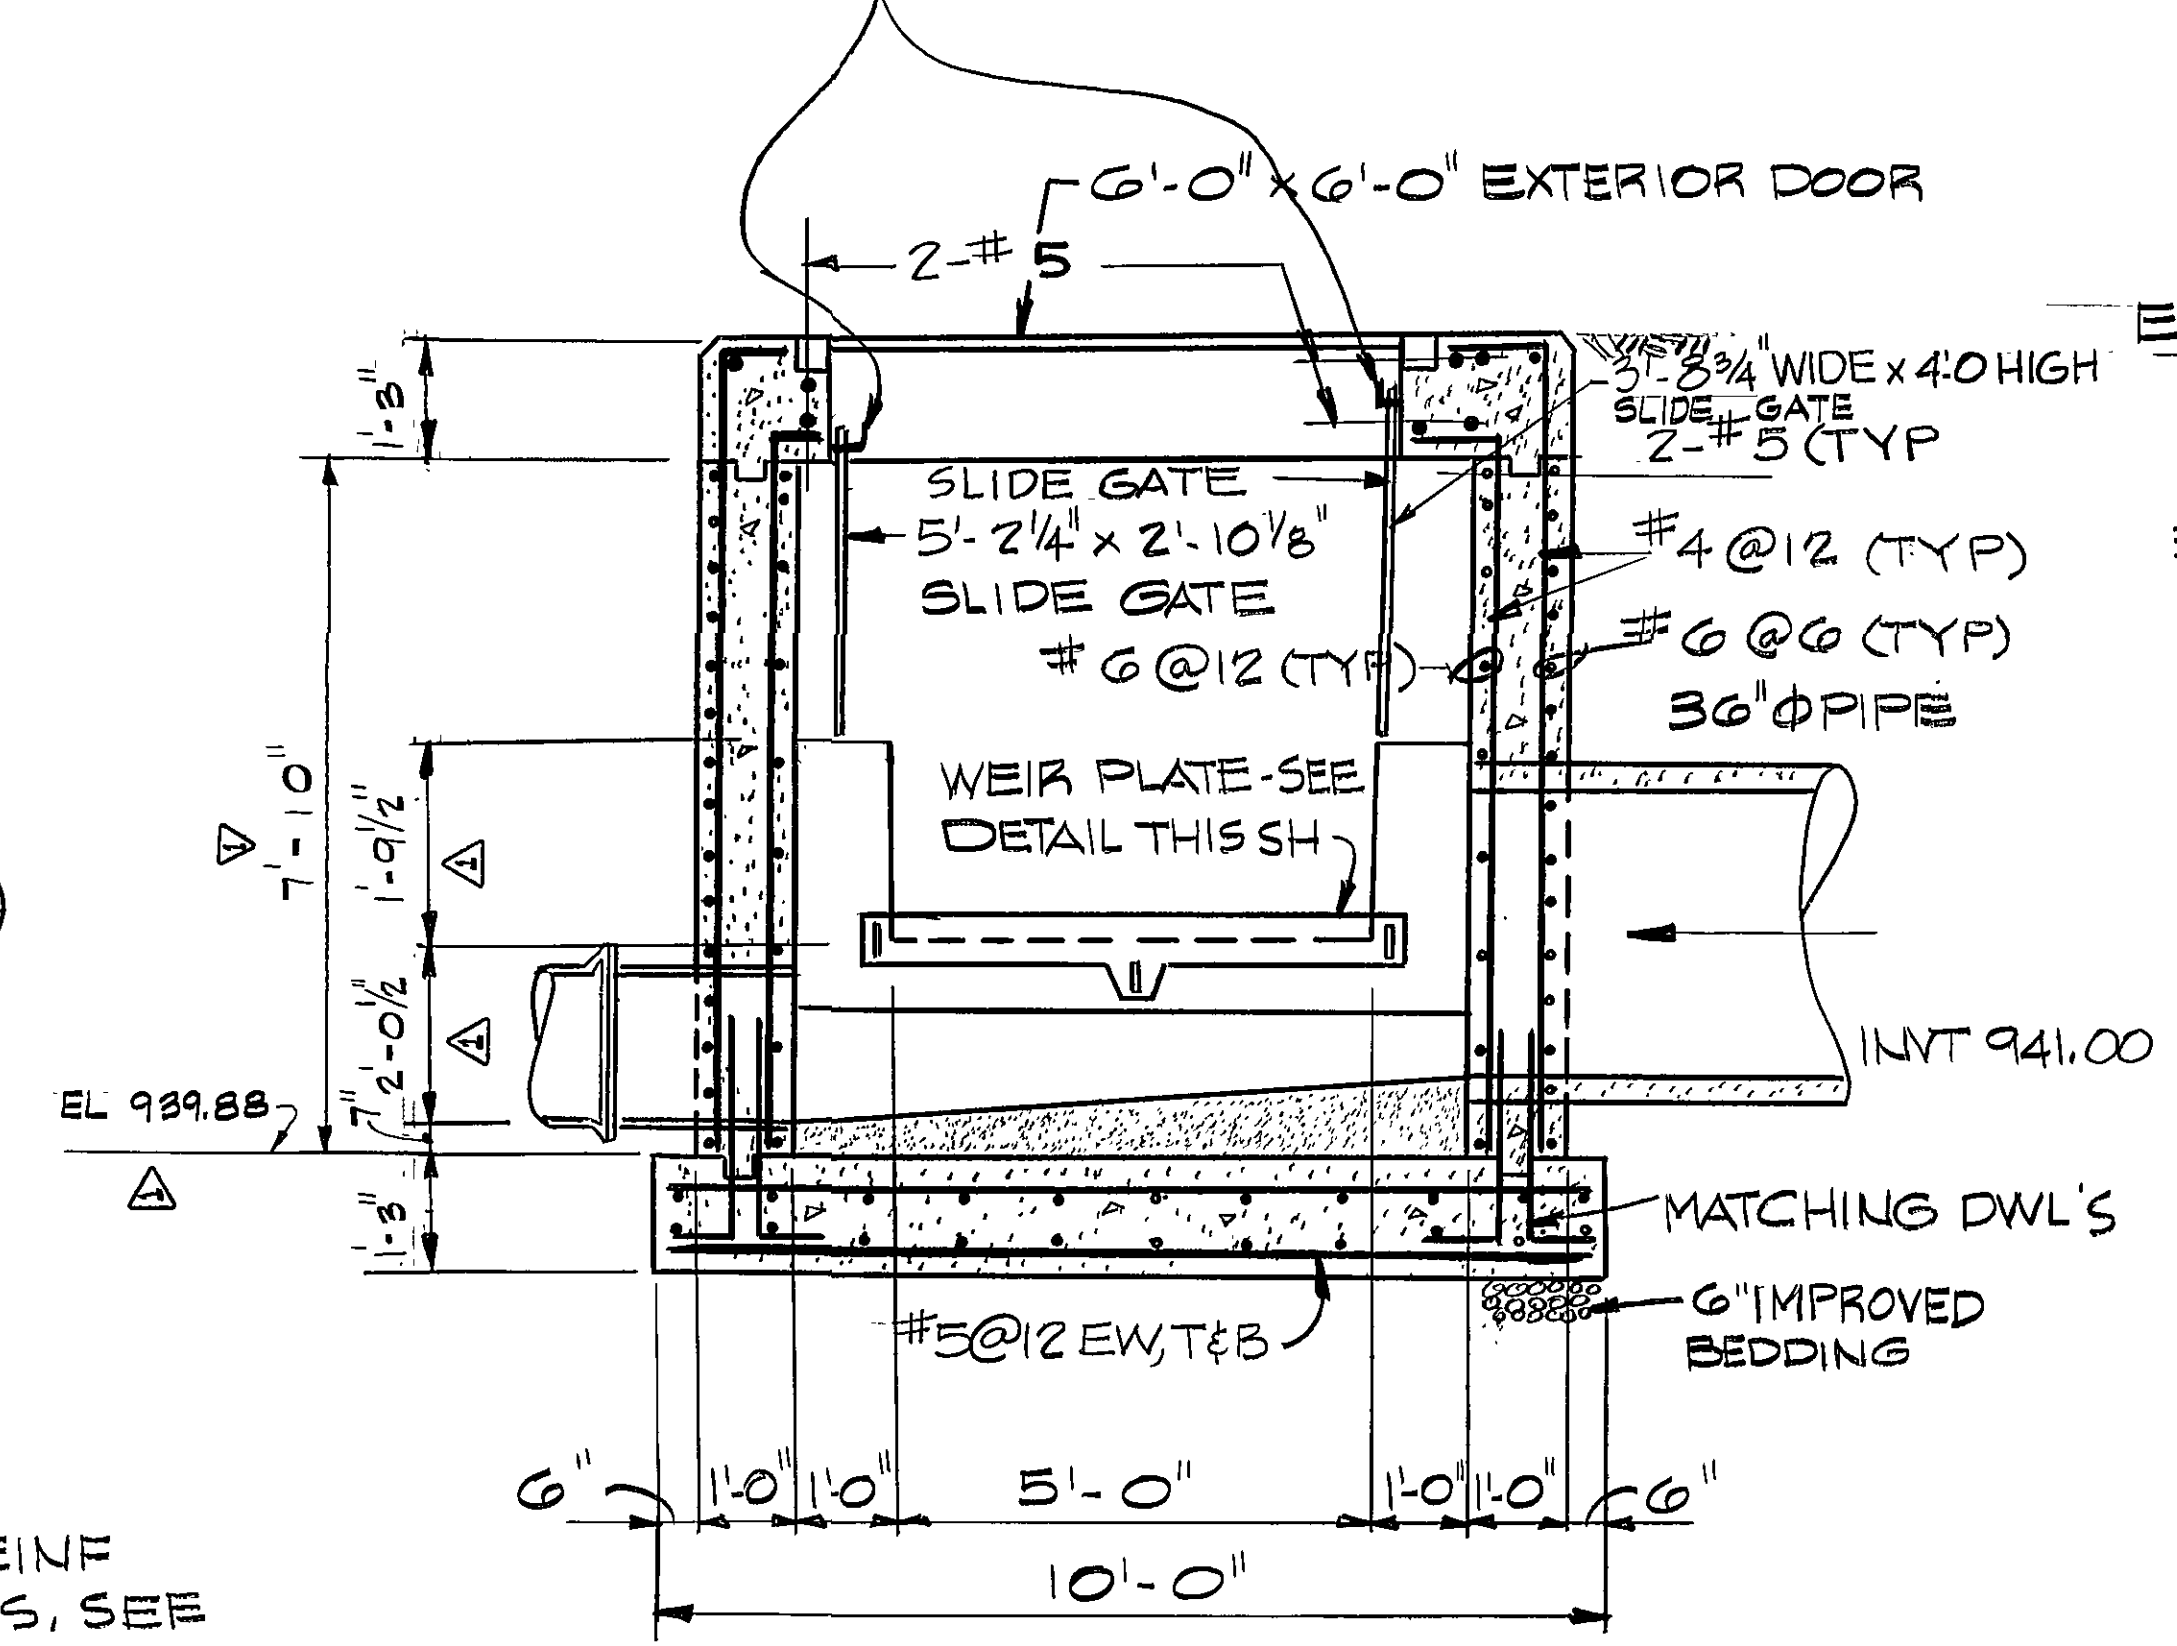


SECTION 1
SCALE: 1/2" = 1'-0"

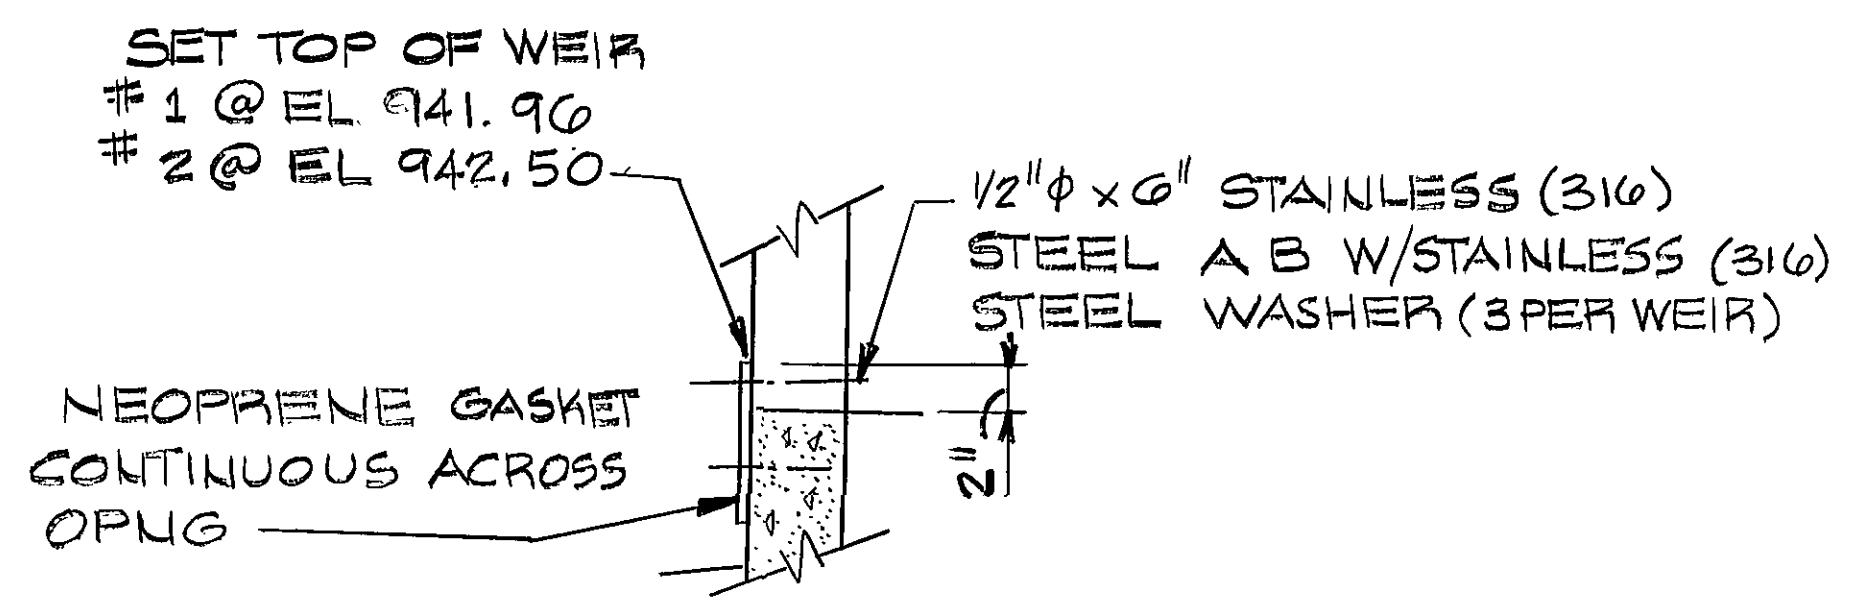

SECTION 3
NO SCALE

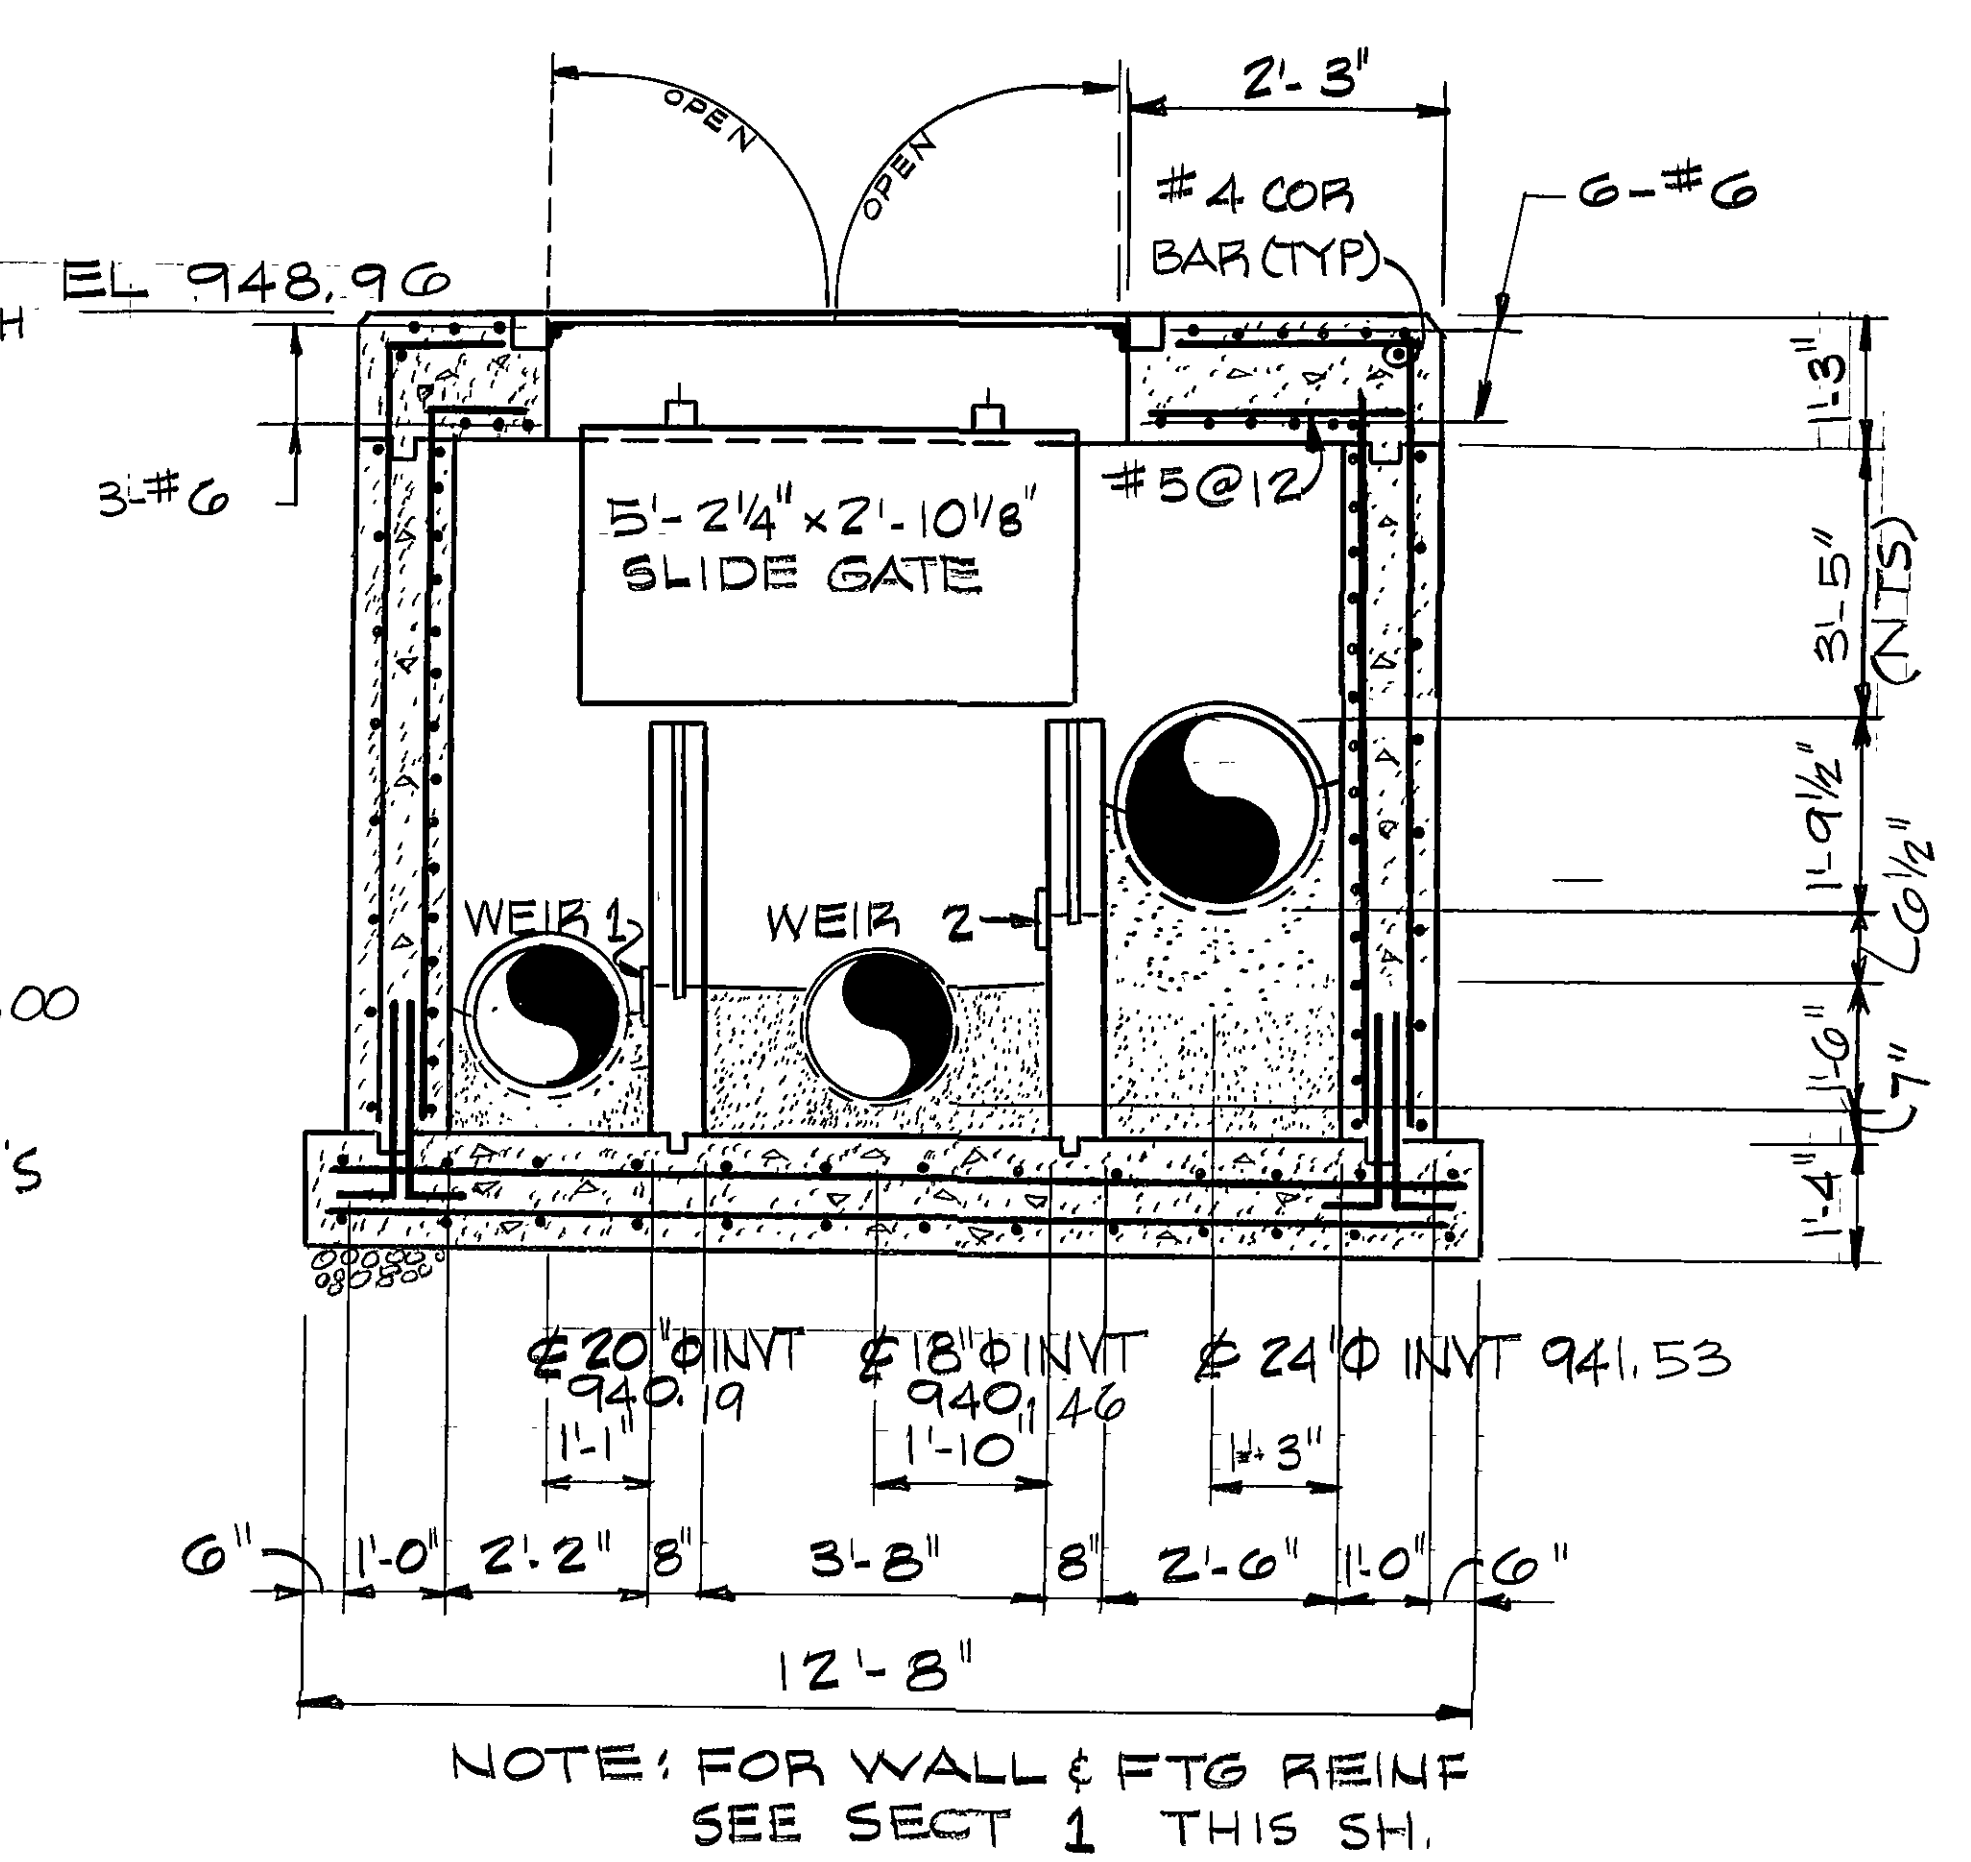

SECTION 2
SCALE: 1/2" = 1'-0"

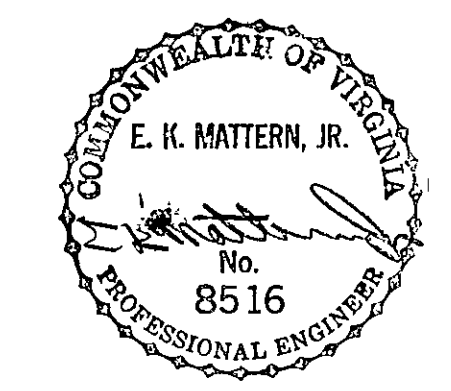

AS BUILT
MAY 1982

2	MAY 82	AS BUILT	DMC	SWH	EKM
1	SEP 81	SEE SECTION 20			
REVISION	DATE	DESCRIPTION	BY	APP	
DESIGNED	SWH	TINKER CREEK SANITARY SEWER INTERCEPTOR SIPHON INLET CHAMBER CITY OF ROANOKE, VIRGINIA			
DRAWN	MTA				
CHECKED	OMP				
APPROVED	JWC				
SUBMITTED	MM				
Mattern and Craig CONSULTING ENGINEERS ROANOKE, VIRGINIA		SCALE	AS NOTED	COMM. NO.	347
		DATE	OCT 1980	SHEET	20