

ROANOKE COUNTY

PUBLIC SERVICE AUTHORITY


ROANOKE COUNTY, VIRGINIA

PROJECT NO. 71-2-S

AUTHORITY MEMBERS

L.S.	WALDROP		CHAIRMAN
F.R.	ANGELL	VICE	CHAIRMAN
H.F.	REED		
R.H.	RICHARDSON		
B.W.	MAHONEY		

J.A. BEAVERS EXECUTIVE DIRECTOR

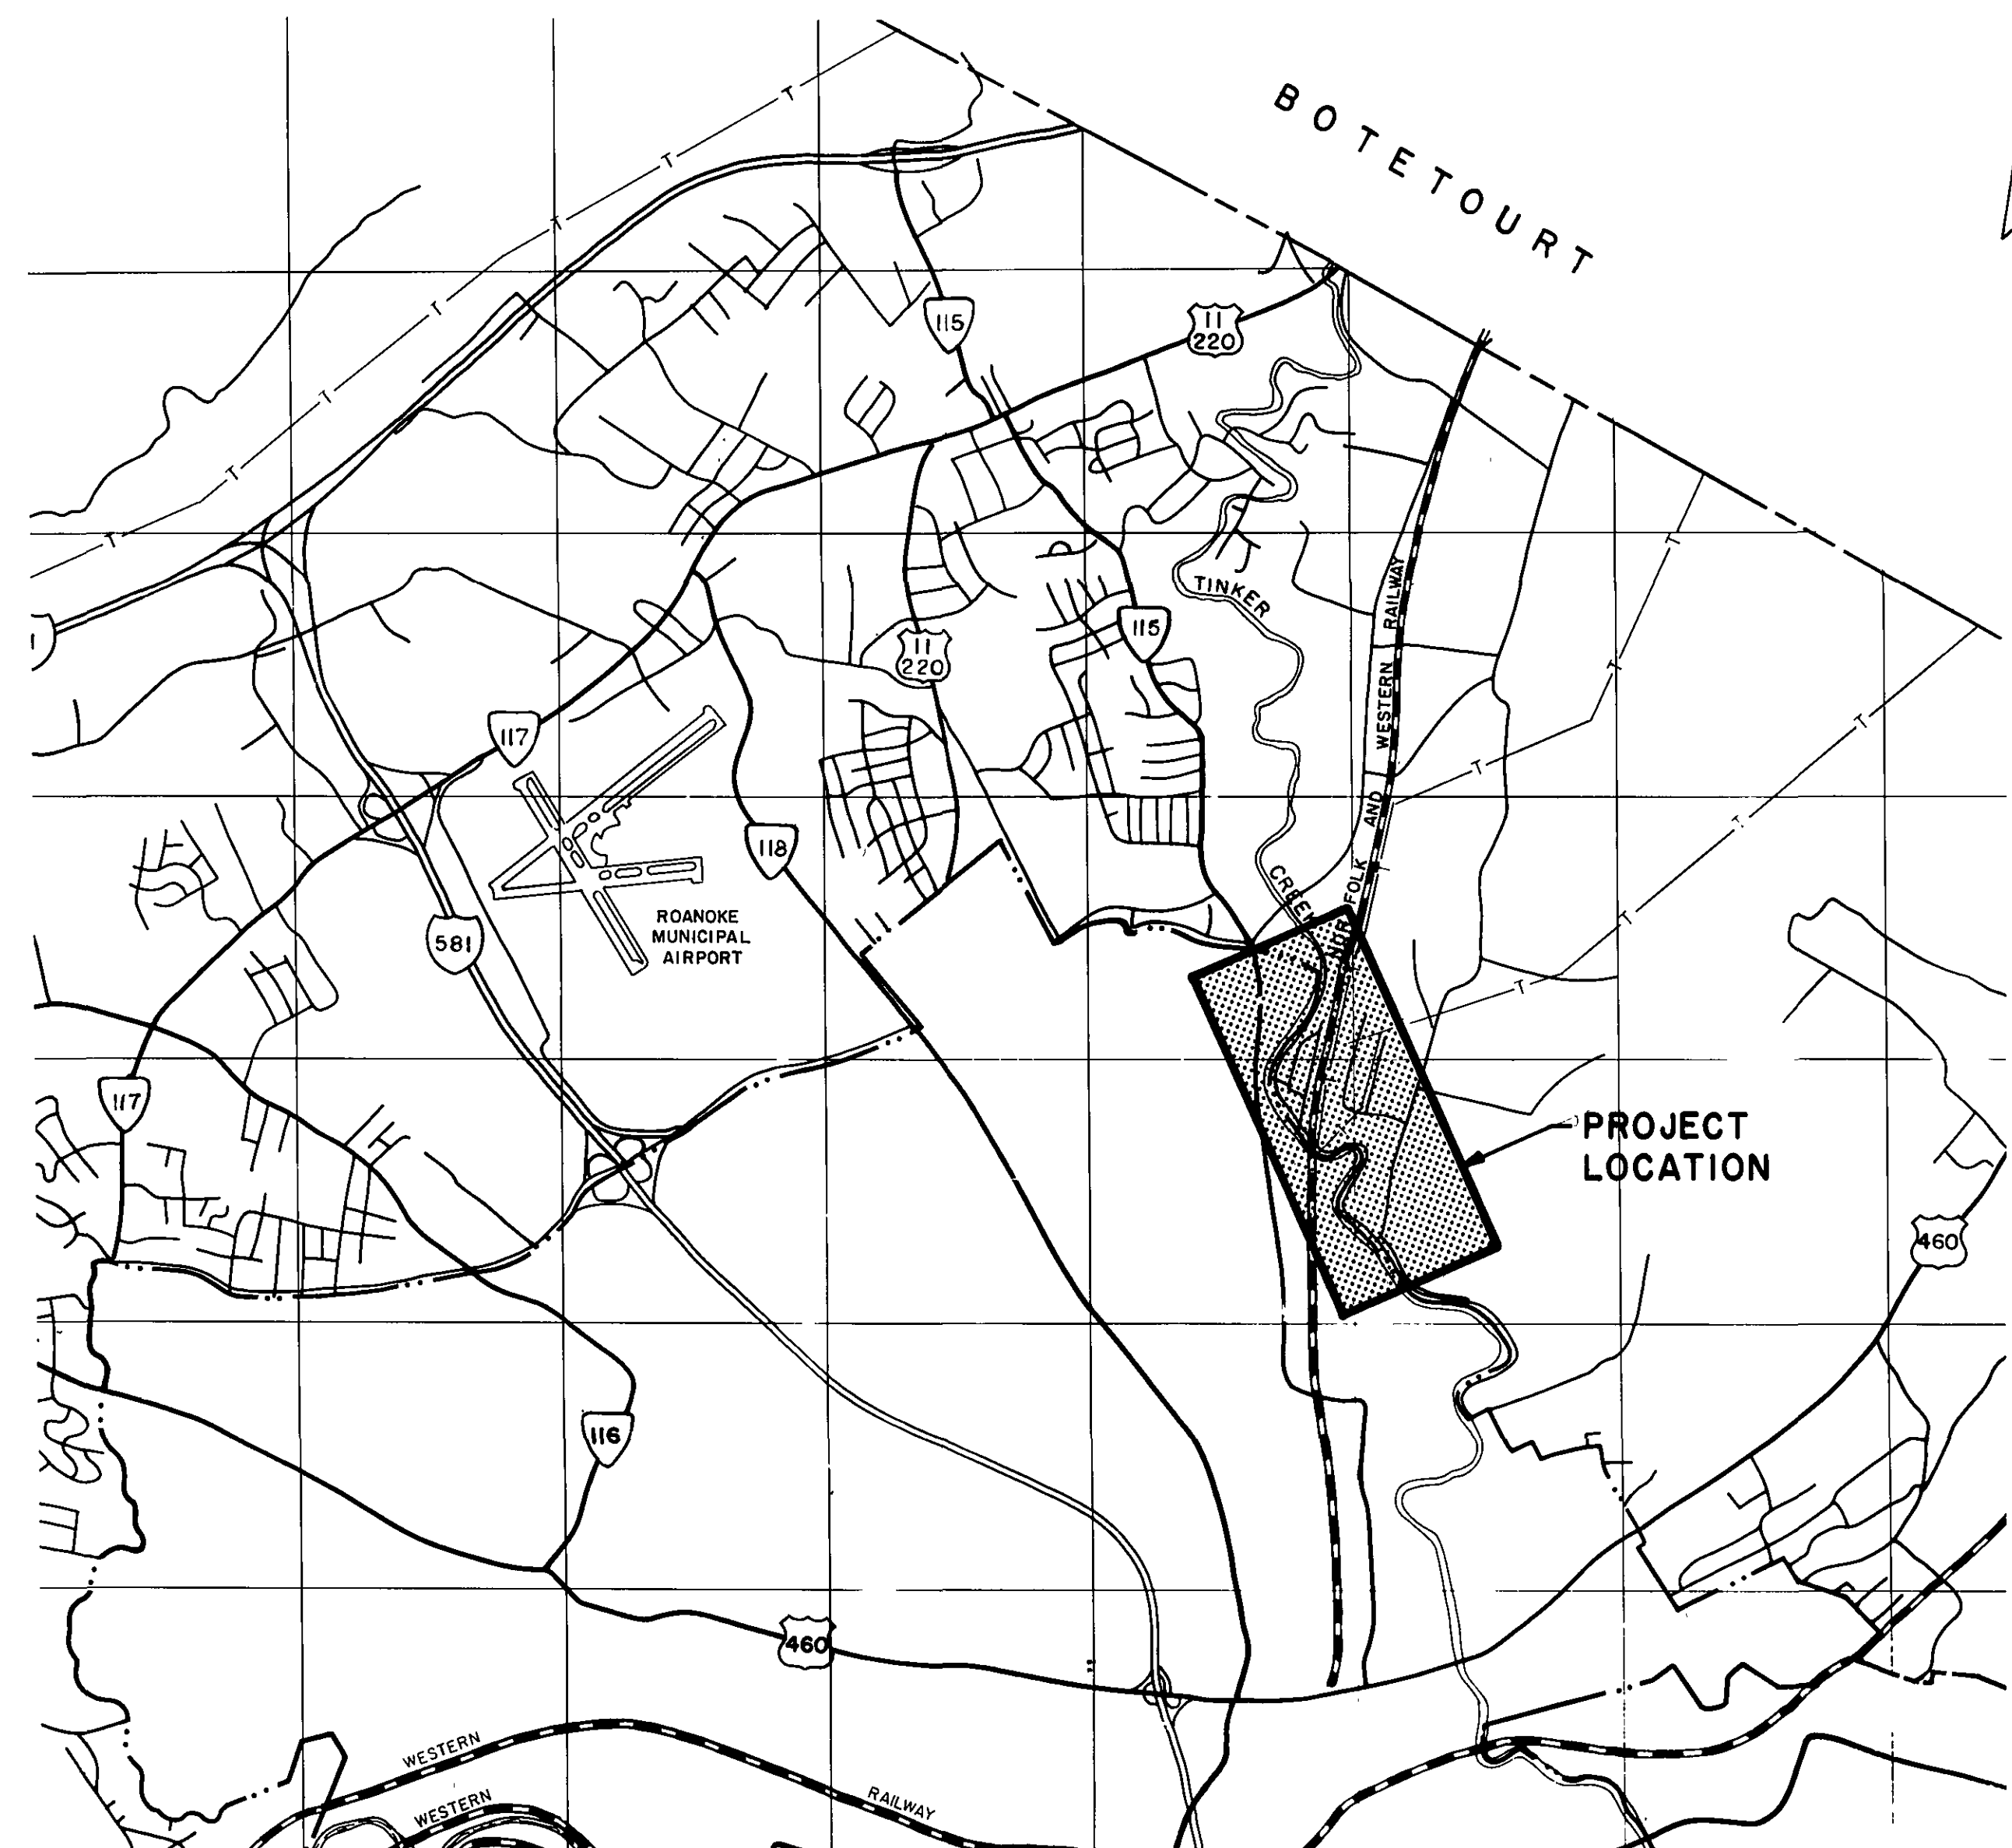

LEGEND

-  SURVEY BASE LINE
 PROPERTY LINE
 RIGHT OF WAY LINE
 EDGE OF PAVEMENT
 EXISTING SANITARY SEWER
 PROPOSED SANITARY SEWER
 EXISTING MANHOLE
 PROPOSED MANHOLE
 PROPOSED CLEANOUT
 PROPOSED METERING STATION
 WATER MAIN
 GAS LINE
 ELECTRIC CABLE OR CONDUIT
 TELEPHONE CABLE OR CONDUIT
 RAILROAD TRACKS
 DITCH
 STREAM
 FENCE
 FIRE HYDRANT
 POWER POLE
 TELEPHONE POLE AND GUY WIRE
 VALVE VAULT
 WATER METER
 TREE
 SHRUB
 HEDGE
 ROCK OR STONE WALL
 EXISTING GROUND

SCHEDULE OF DRAWINGS

<u>SHEET</u>	<u>TITLE</u>	<u>STATION</u>
1.	TINKER CREEK INTERCEPTOR	9+60 - 16+00
2.	TINKER CREEK INTERCEPTOR	16+00 - 29+00
3.	TINKER CREEK INTERCEPTOR	29+00 - 45+00
4.	TINKER CREEK INTERCEPTOR	45+00 - 60+00
5.	TINKER CREEK INTERCEPTOR	60+00 - 75+00
6.	TINKER CREEK INTERCEPTOR	75+00 - 85+17
7.	METERING CHAMBER	
8.	DETAILS	
9.	DETAILS	
10.	DETAILS	

SUMMARY OF QUANTITIES

[illegible]

LANGLEY,McDONALD AND OVERMAN
C O N S U L T I N G E N G I N E E R S
N O R F O L K , V I R G I N I A



AS BUILT