


PLAN	SURVEYED	DATE
	BY	
NO.	PLOTTED	
	NOTE BOOK ALIGNMENT CHECKED	
	RT. OF WAY CHECKED	

PROFILE	SURVEYED	DATE
	BY	
NO.	PLOTTED	
	NOTE BOOK GRADES CHECKED	
	B. M. NOTED	
	STANDARD NOTATIONS CHECKED	

- NOTES:
1. ALL PIPE SHALL BE LAID ON STANDARD GRAVEL BEDDING.
 2. FOR TYPE "C" MANHOLE SEE DETAIL, SHEET 8.

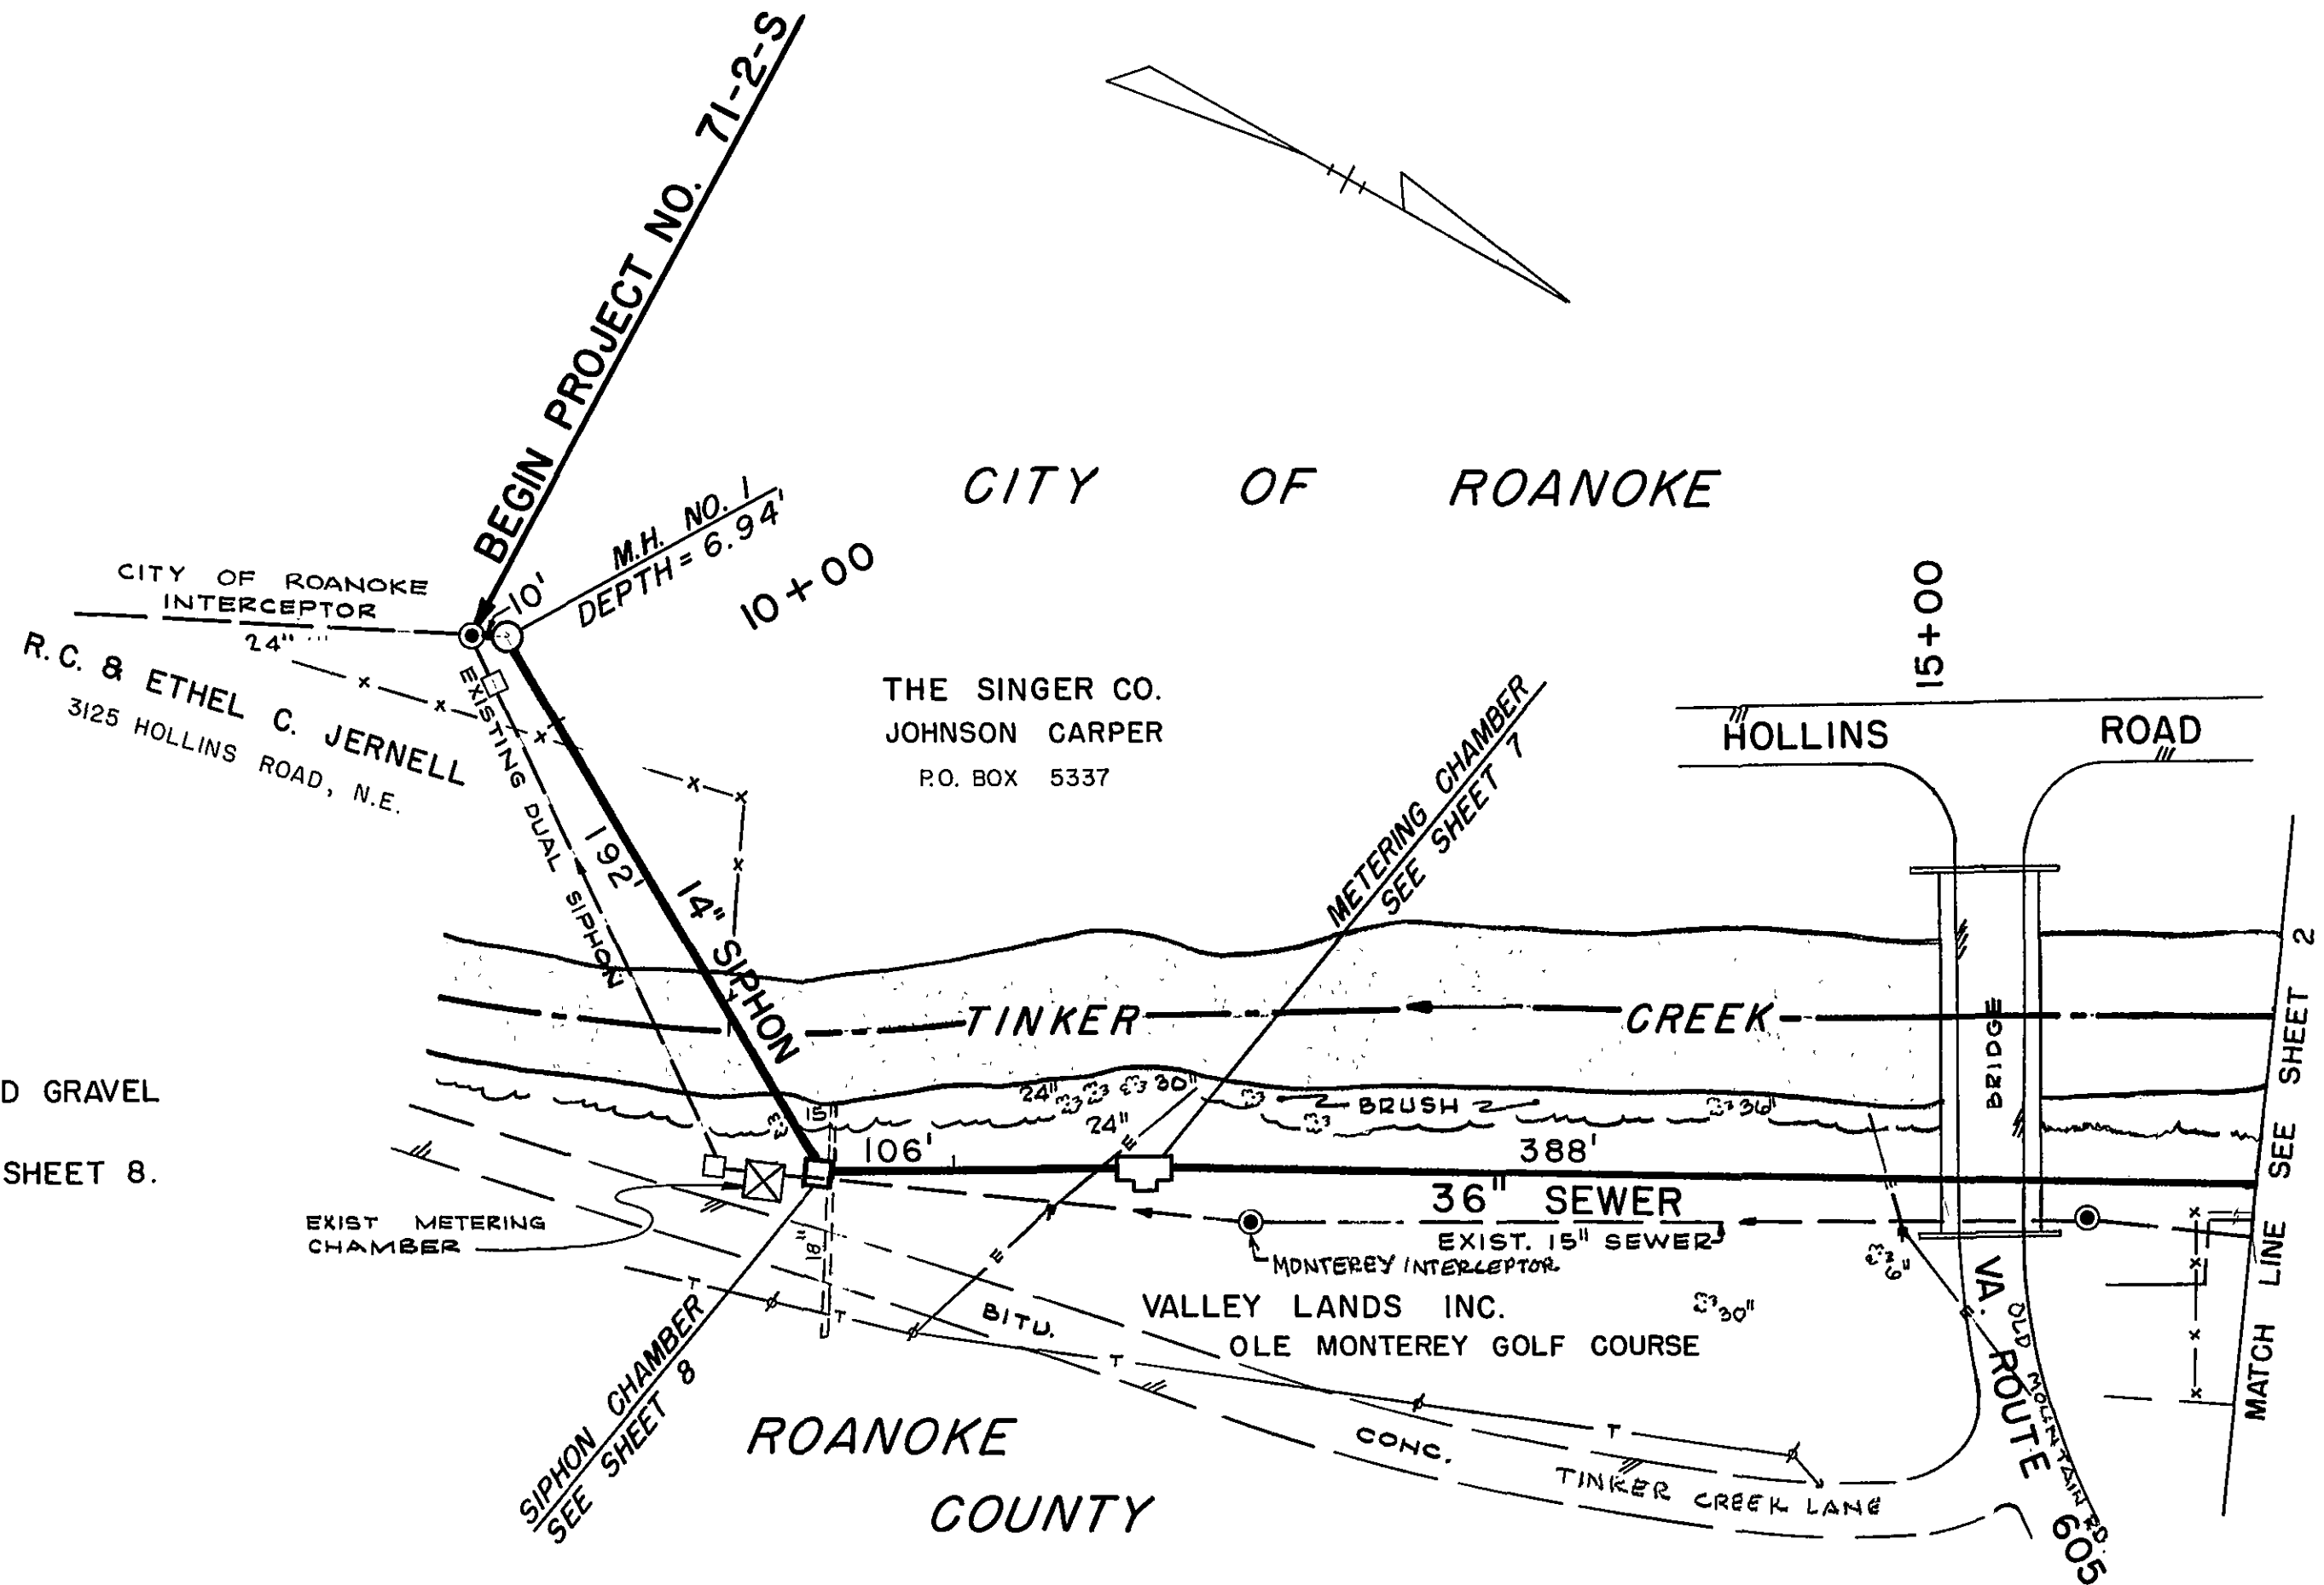

OLD MONTEREY GOLF COURSE SCALE: 1 IN. = 50 FT.


BENCH MARK - CHISELED "B" ON SOUTH END OF WEST ABUTMENT OF NEW BRIDGE OVER TINKER CREEK @ INTERSECTION OF 8th ST. & FINGASTLE TURNPIKE - ELEV. 960.88.

M.H. NO. 1
TYPE "A"
TOP EL. 952.5


SIPHON CHAMBER
TOP EL. 952.8

METERING CHAMBER
TOP EL. 953.25

BID ITEM NO. 9
SEE DETAIL, SHEET 8

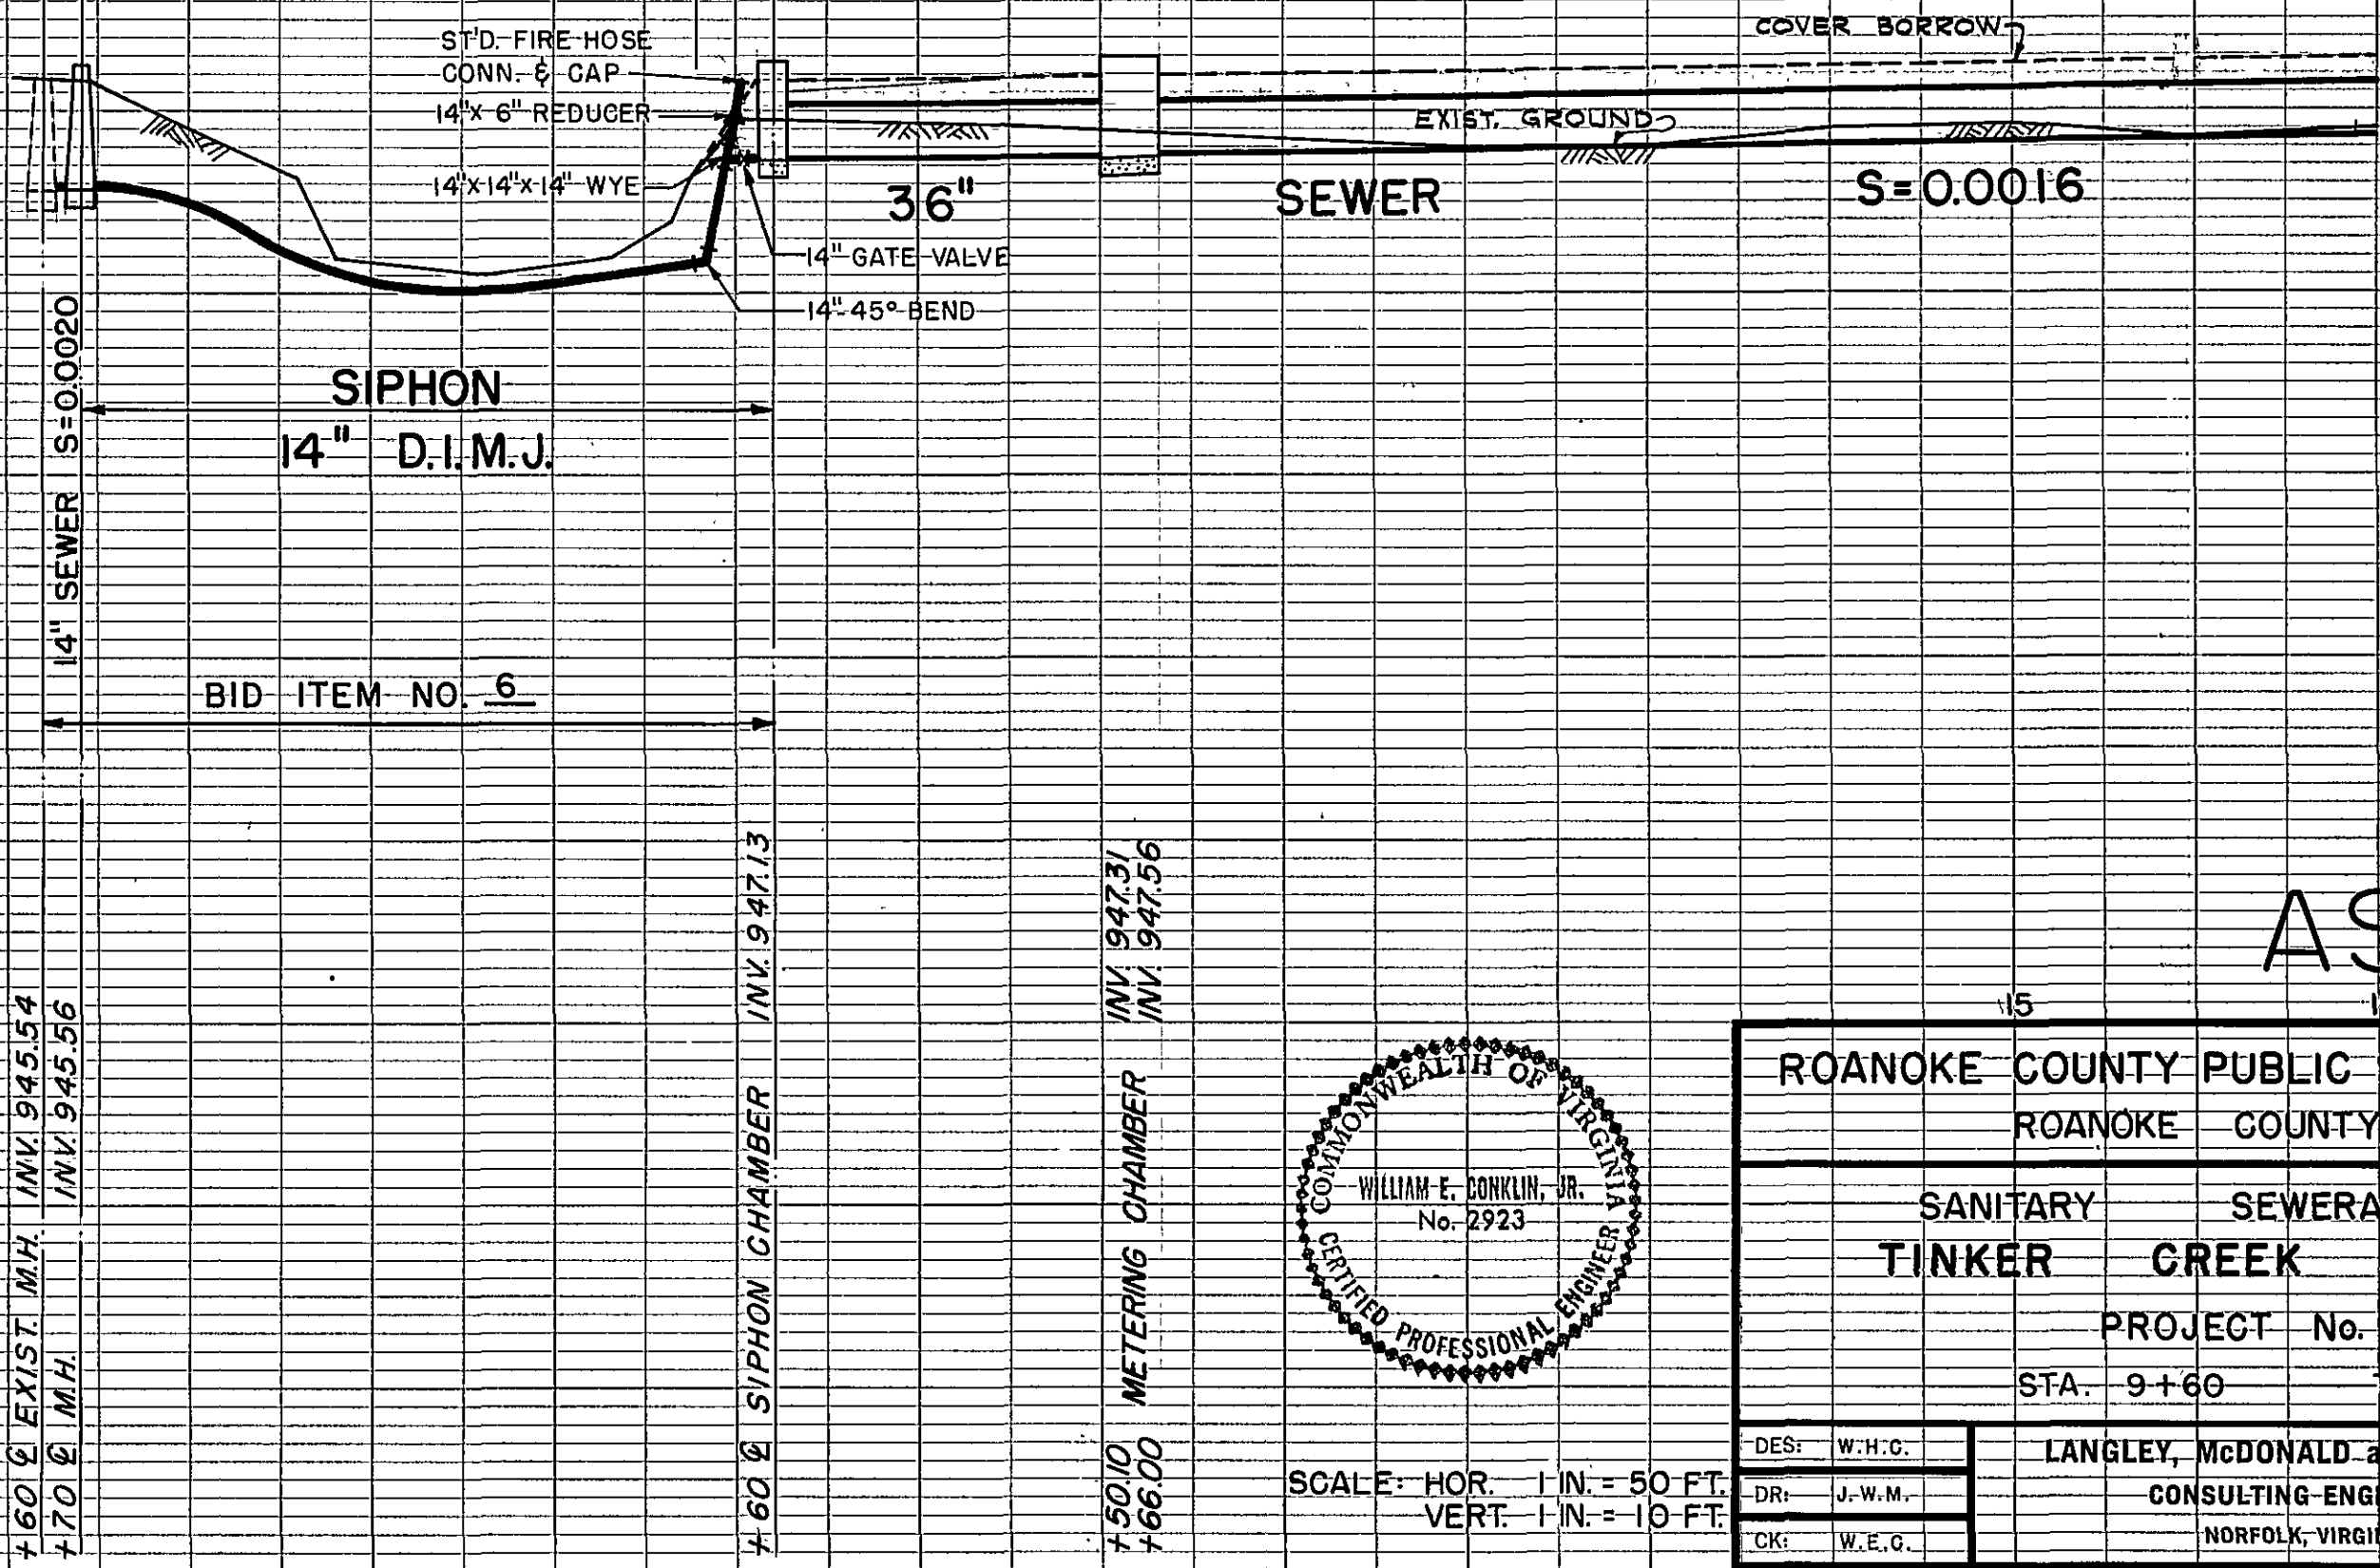

AS BUILT

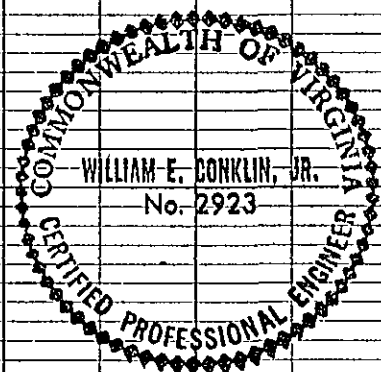

SCALE: HOR. 1 IN. = 50 FT.
VERT. 1 IN. = 10 FT.

ROANOKE COUNTY PUBLIC SERVICE AUTHORITY	
ROANOKE COUNTY, VIRGINIA	
SANITARY	SEWERAGE SYSTEM
TINKER CREEK	INTERCEPTOR
PROJECT No. 71-2-S	
STA. 9+60	TO STA. 16+00
DES: W.E.C.	LANGLEY, McDONALD and OVERMAN
DR: J.W.M.	CONSULTING ENGINEERS
CK: W.E.C.	NORFOLK, VIRGINIA
SCALE: AS SHOWN	DATE: 7/15/71
SHEET 1 OF 10	