



PLAN	SURVEYED	DATE
	NOTE BOOK	BY
	ALIGNMENT CHECKED	
	RT. OF WAY CHECKED	
	NO.	

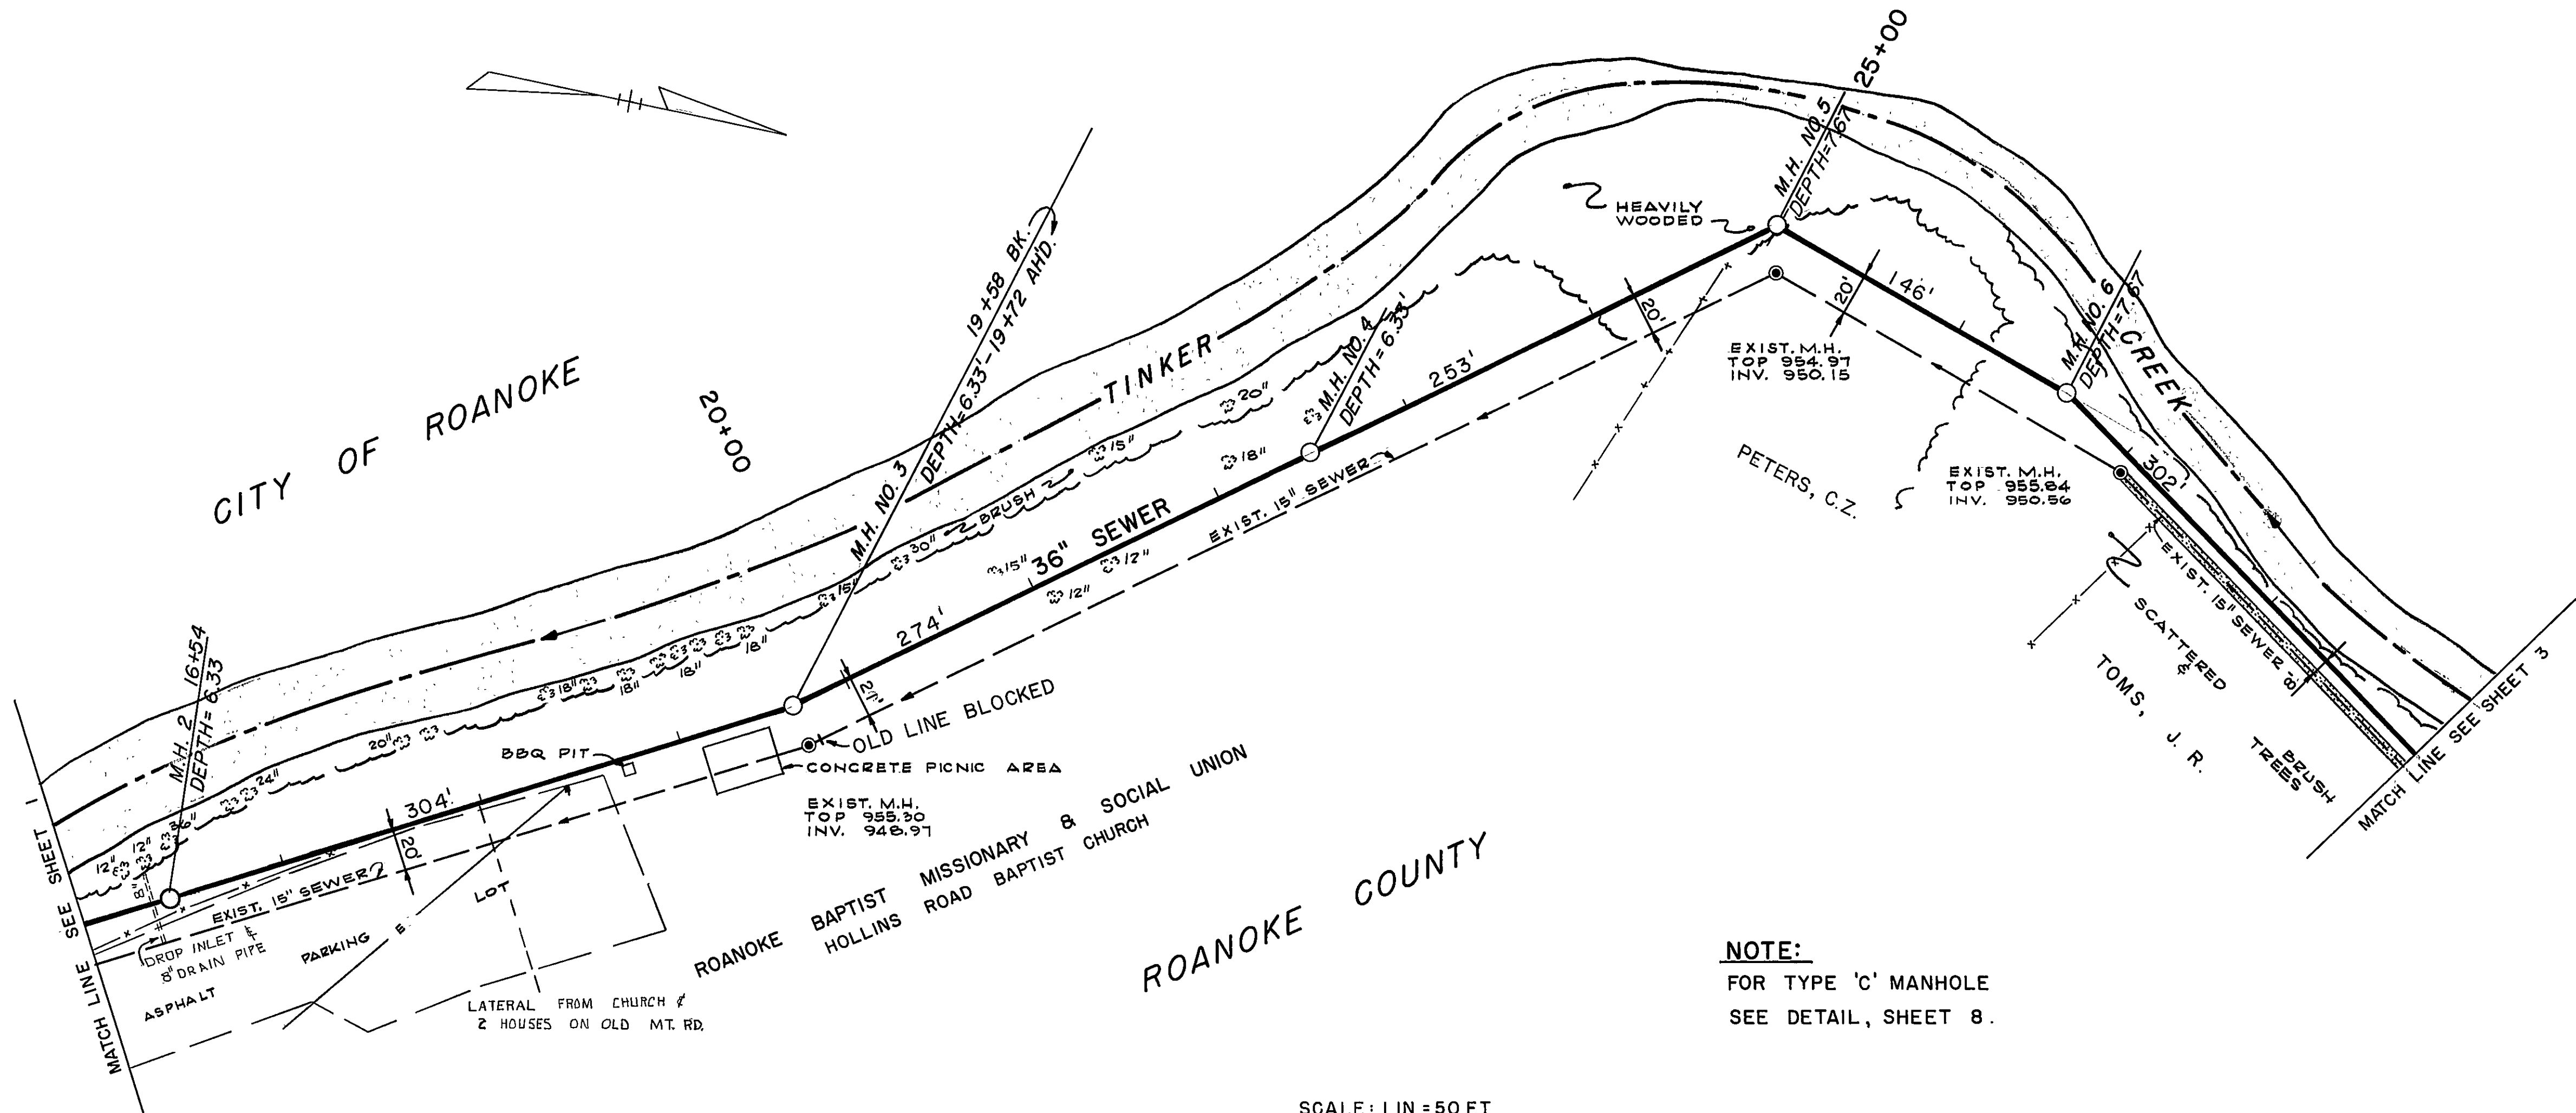


NOTE:
FOR TYPE 'C' MANHOLE
SEE DETAIL, SHEET 8.

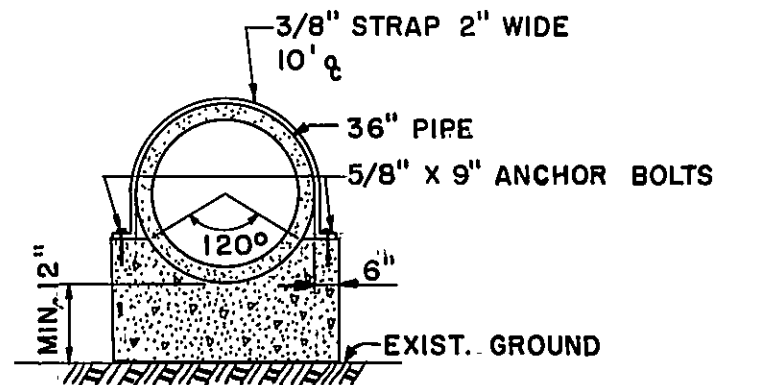

CONCRETE BEDDING
NO SCALE

PROFILE	SURVEYED	DATE
	NOTE BOOK	BY
	GRADES CHECKED	
	STRUCTURE NOTATIONS CHECKED	
	NO.	

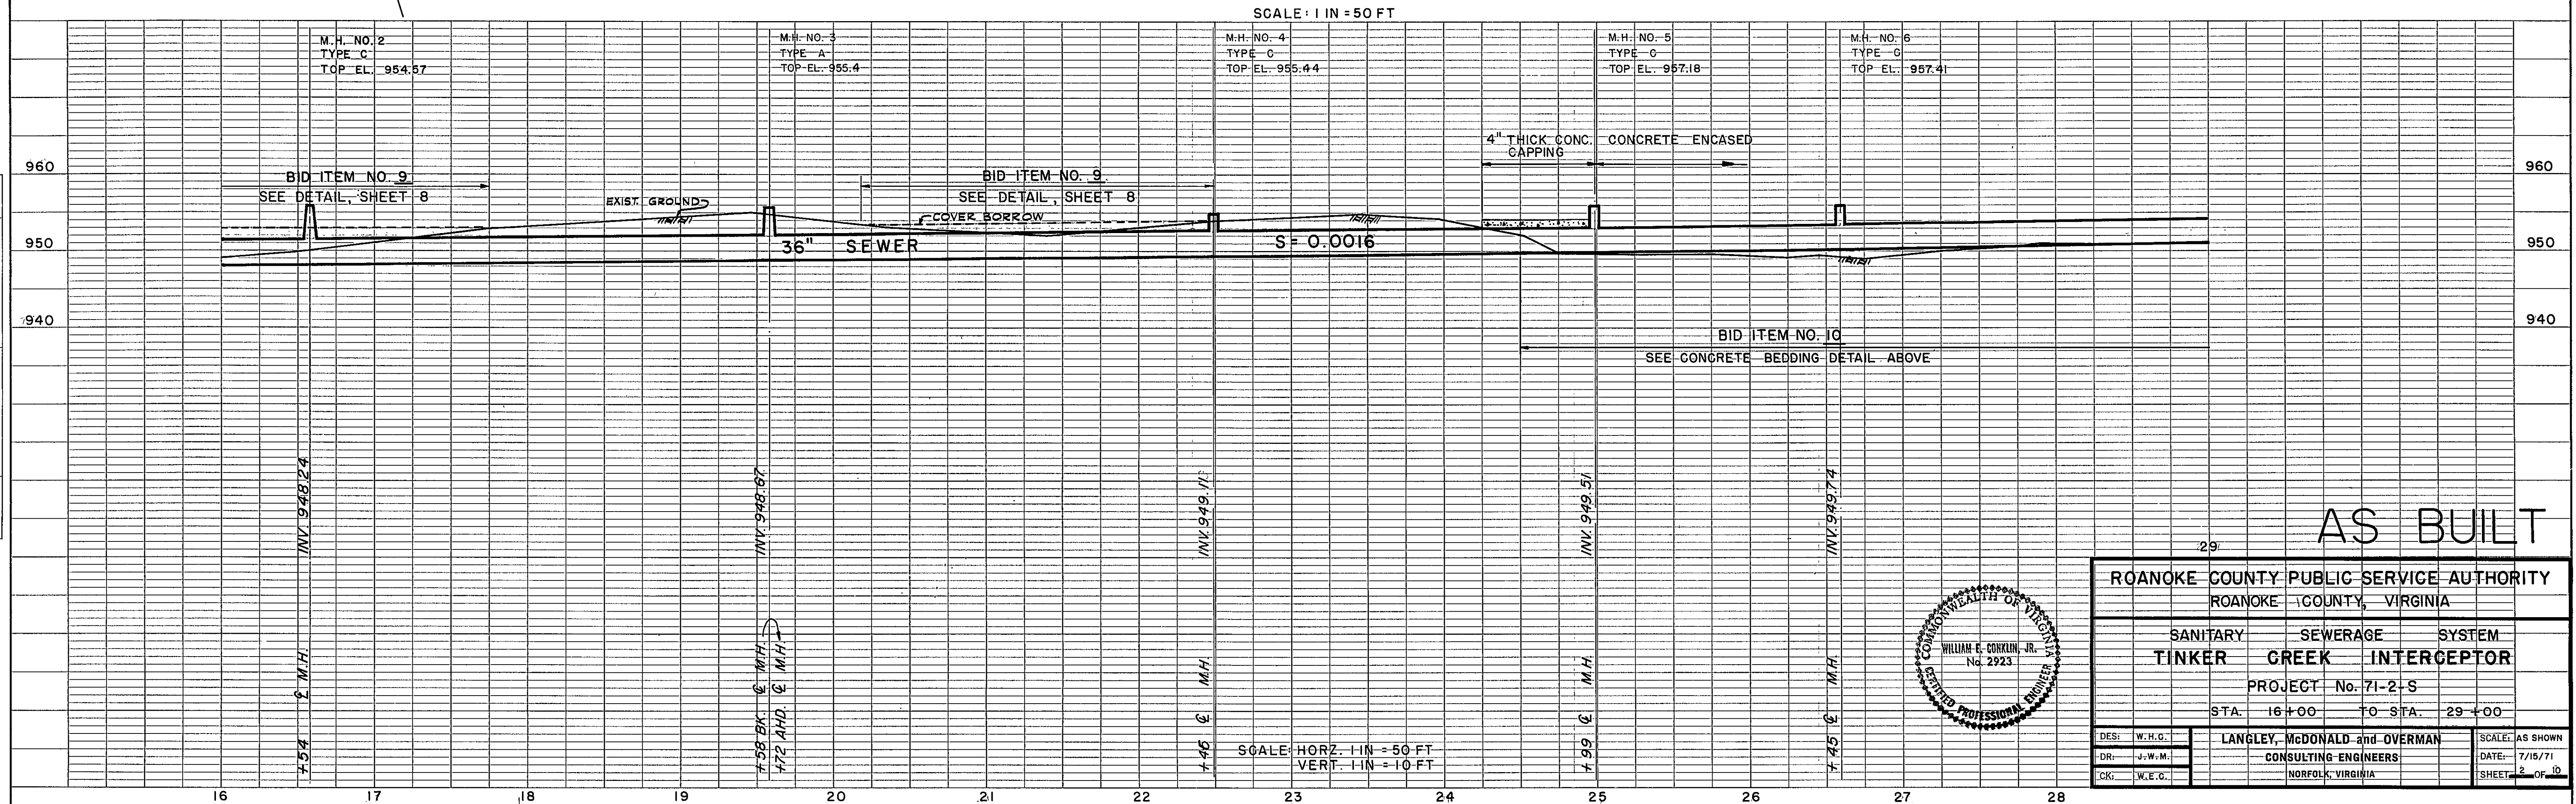

AS BUILT

ROANOKE COUNTY PUBLIC SERVICE AUTHORITY ROANOKE COUNTY, VIRGINIA		
SANITARY TINKER	SEWERAGE CREEK	SYSTEM INTERCEPTOR
PROJECT No. 71-2-S		
STA. 16+00 TO STA. 29+00		
DES: W.H.G.	LANGLEY, McDONALD and OVERMAN	
DR: J.W.M.	CONSULTING ENGINEERS	
CK: W.E.C.	NORFOLK, VIRGINIA	
SCALE: AS SHOWN	DATE: 7/15/71	SHEET: 2 OF 10