




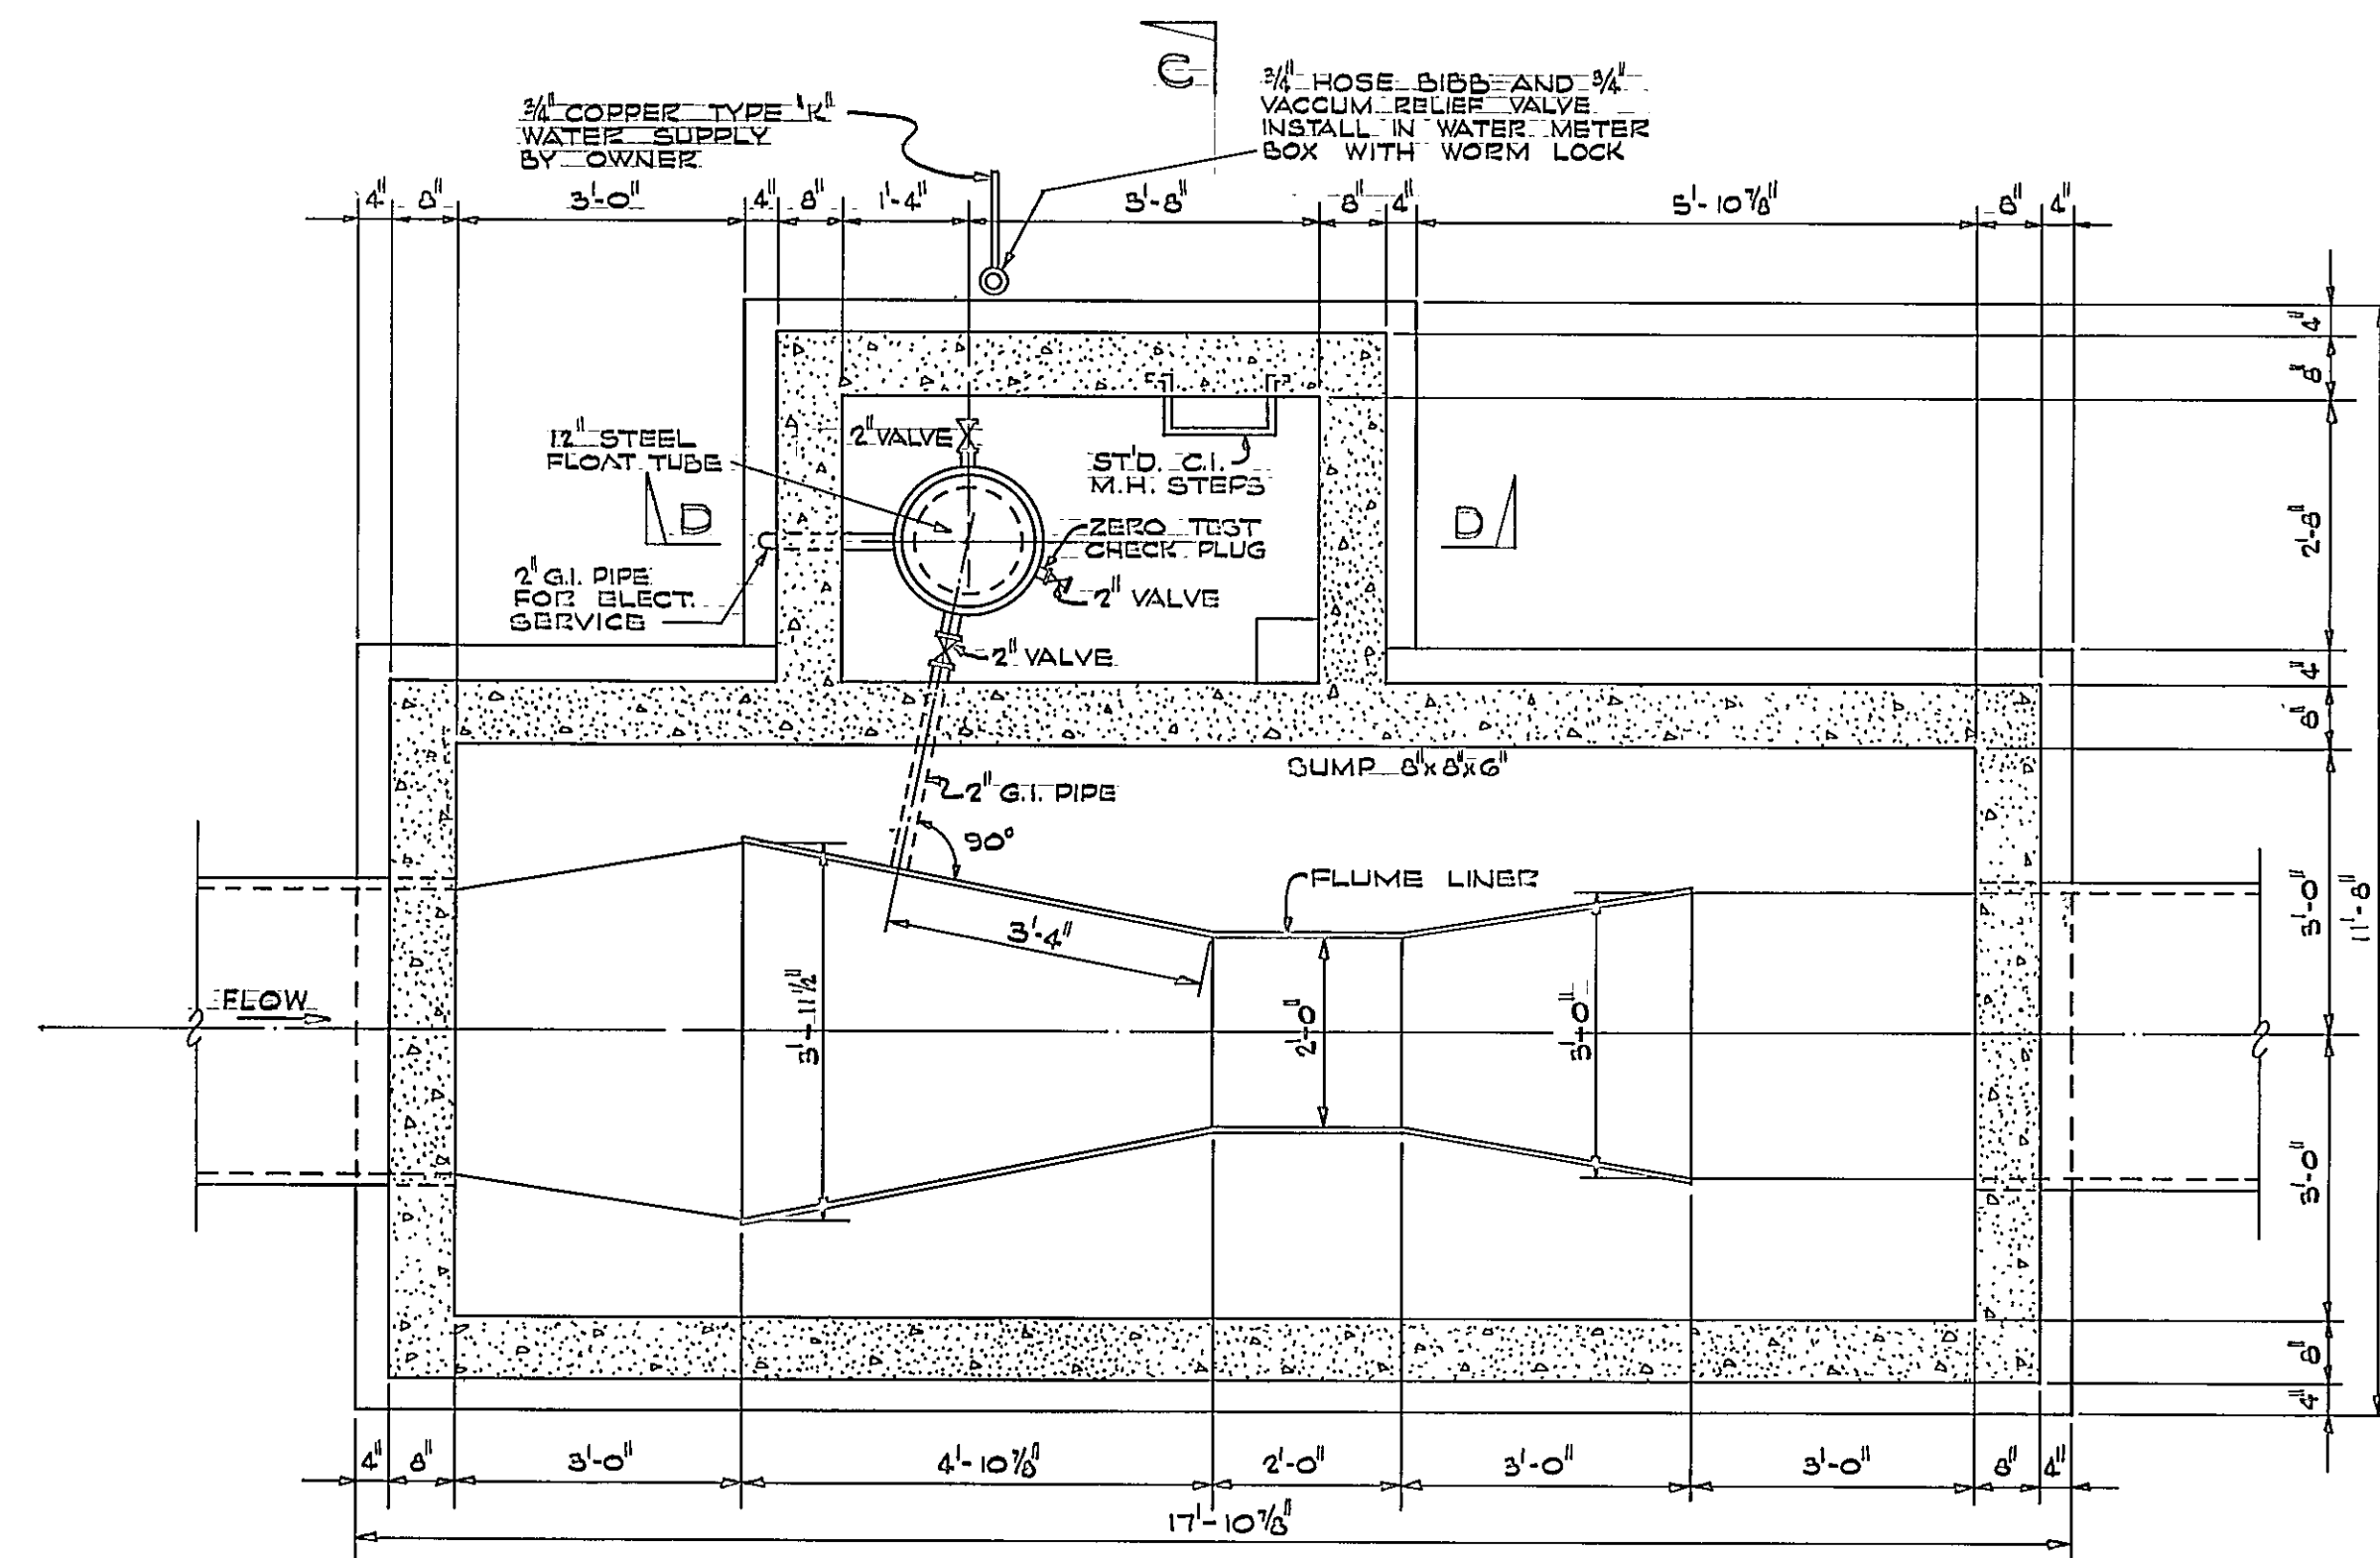


SECTION "A-A"
SCALE: 1/2" = 1'-0"

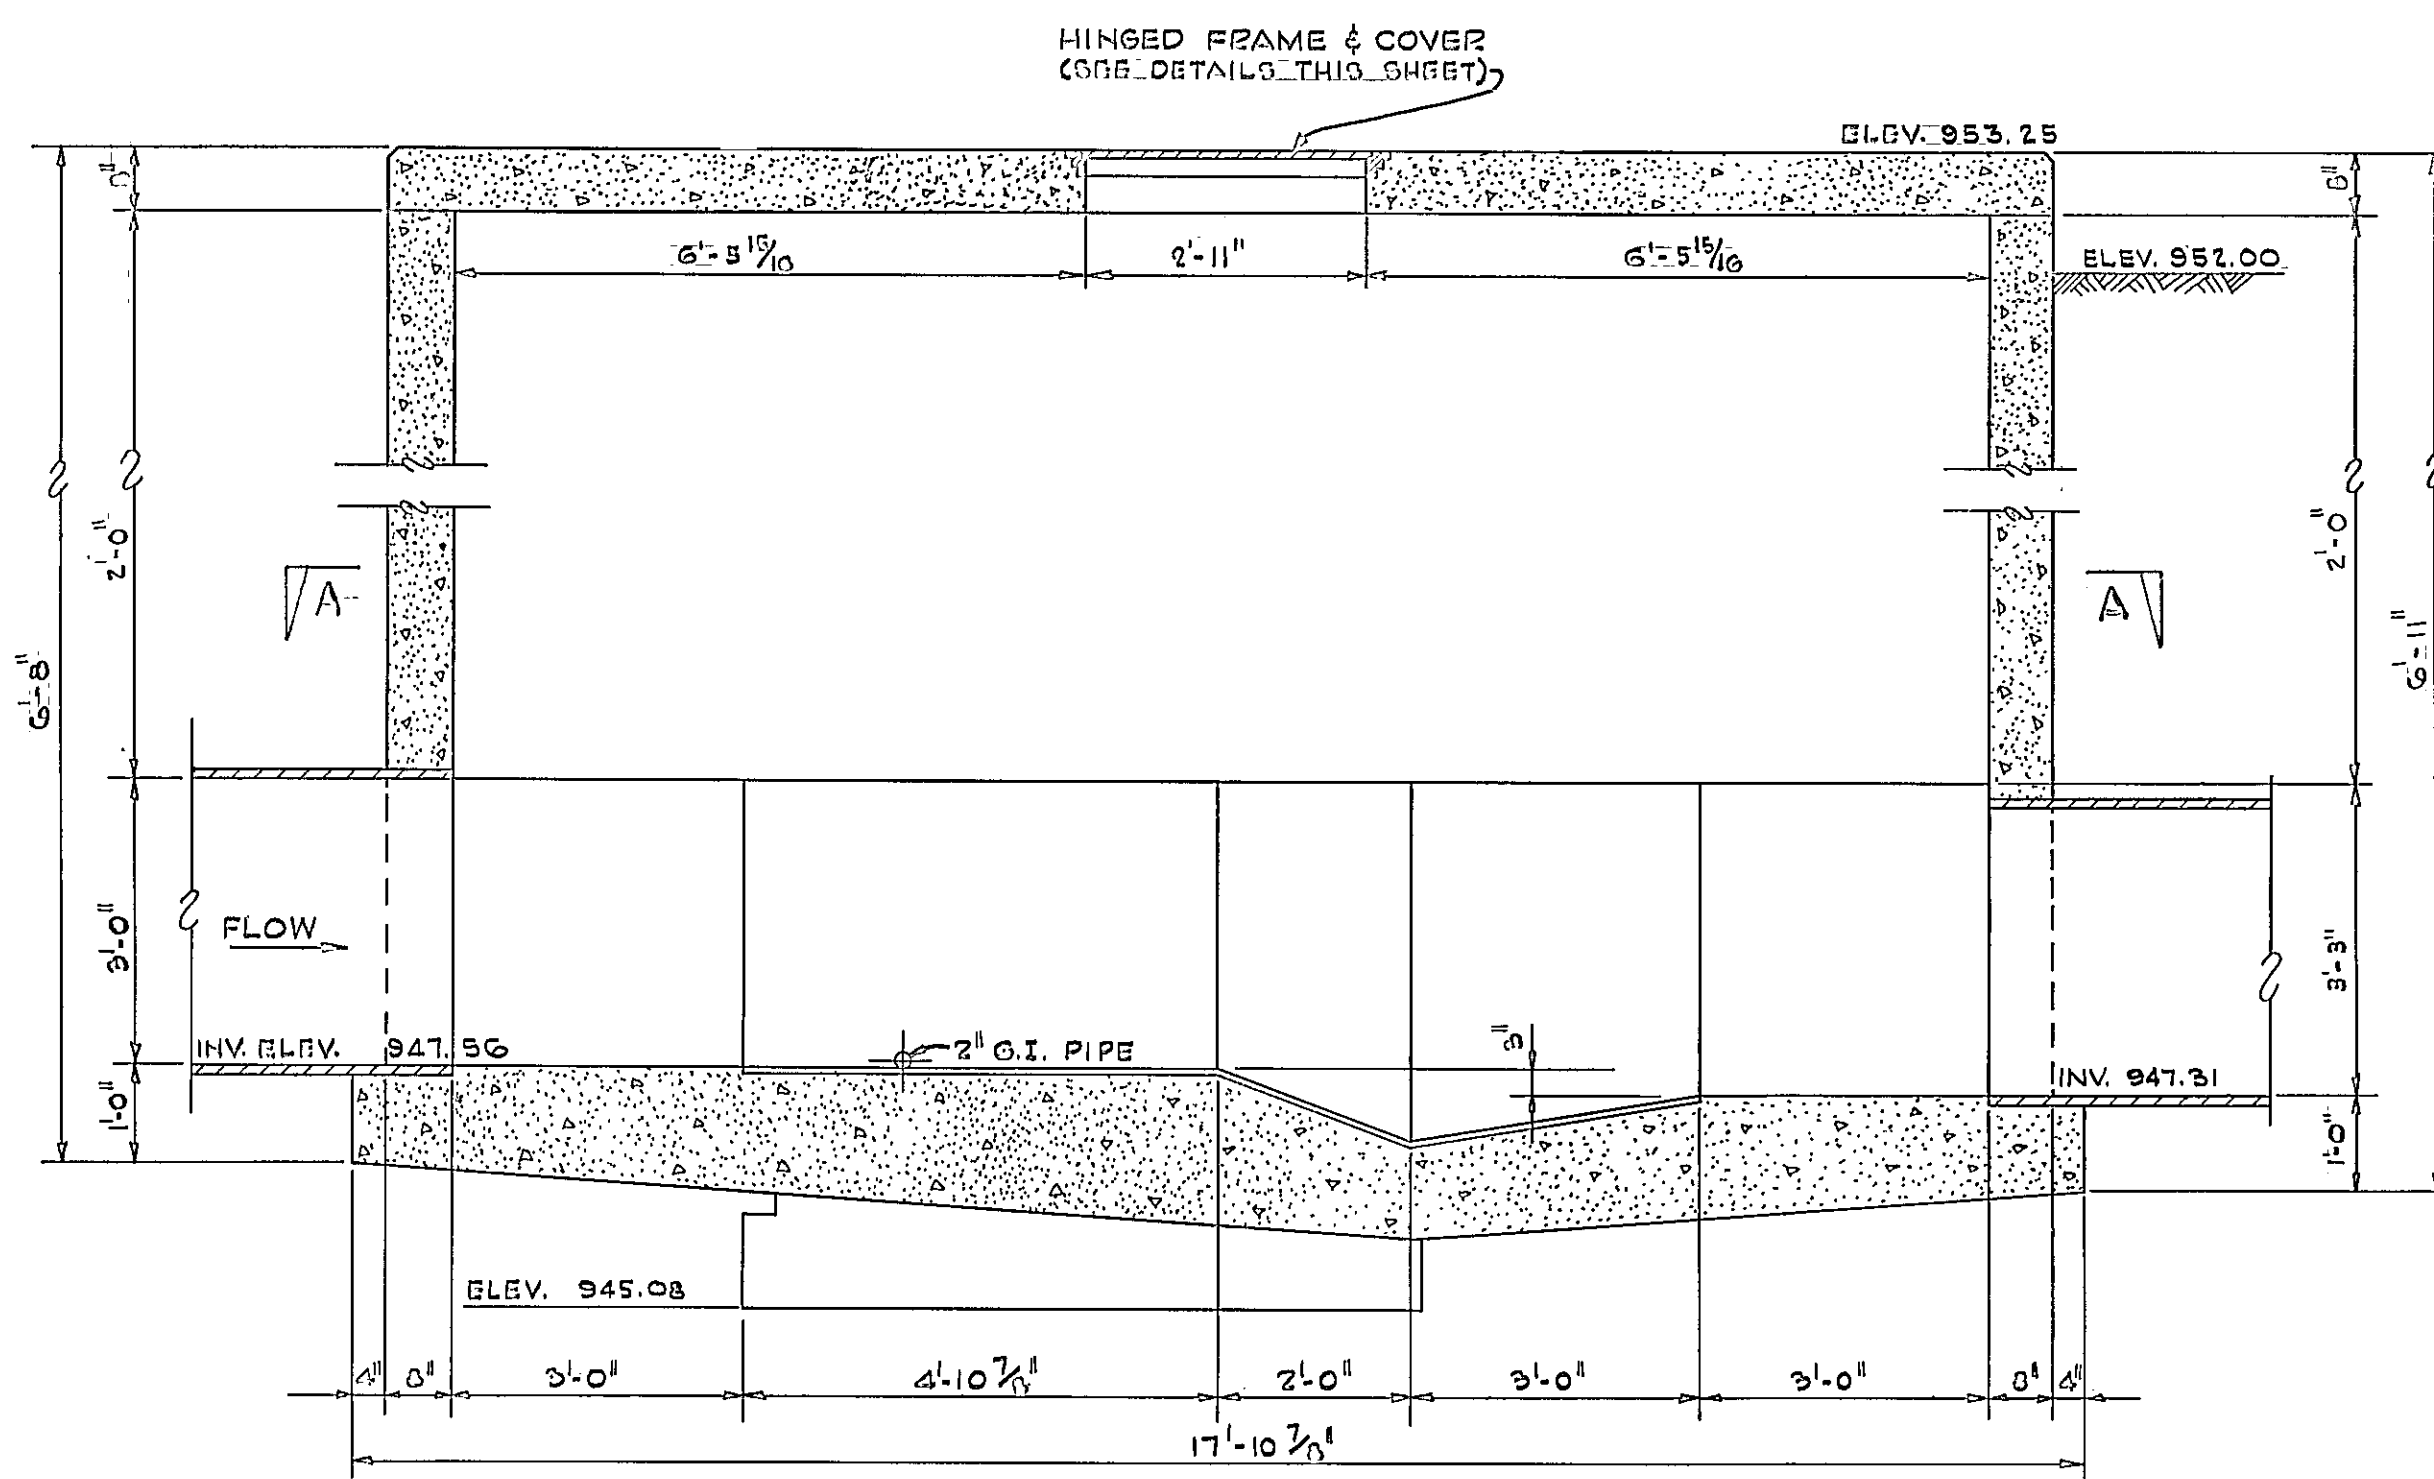


SECTION "B-B"
SCALE: 1/2" = 1'-0"

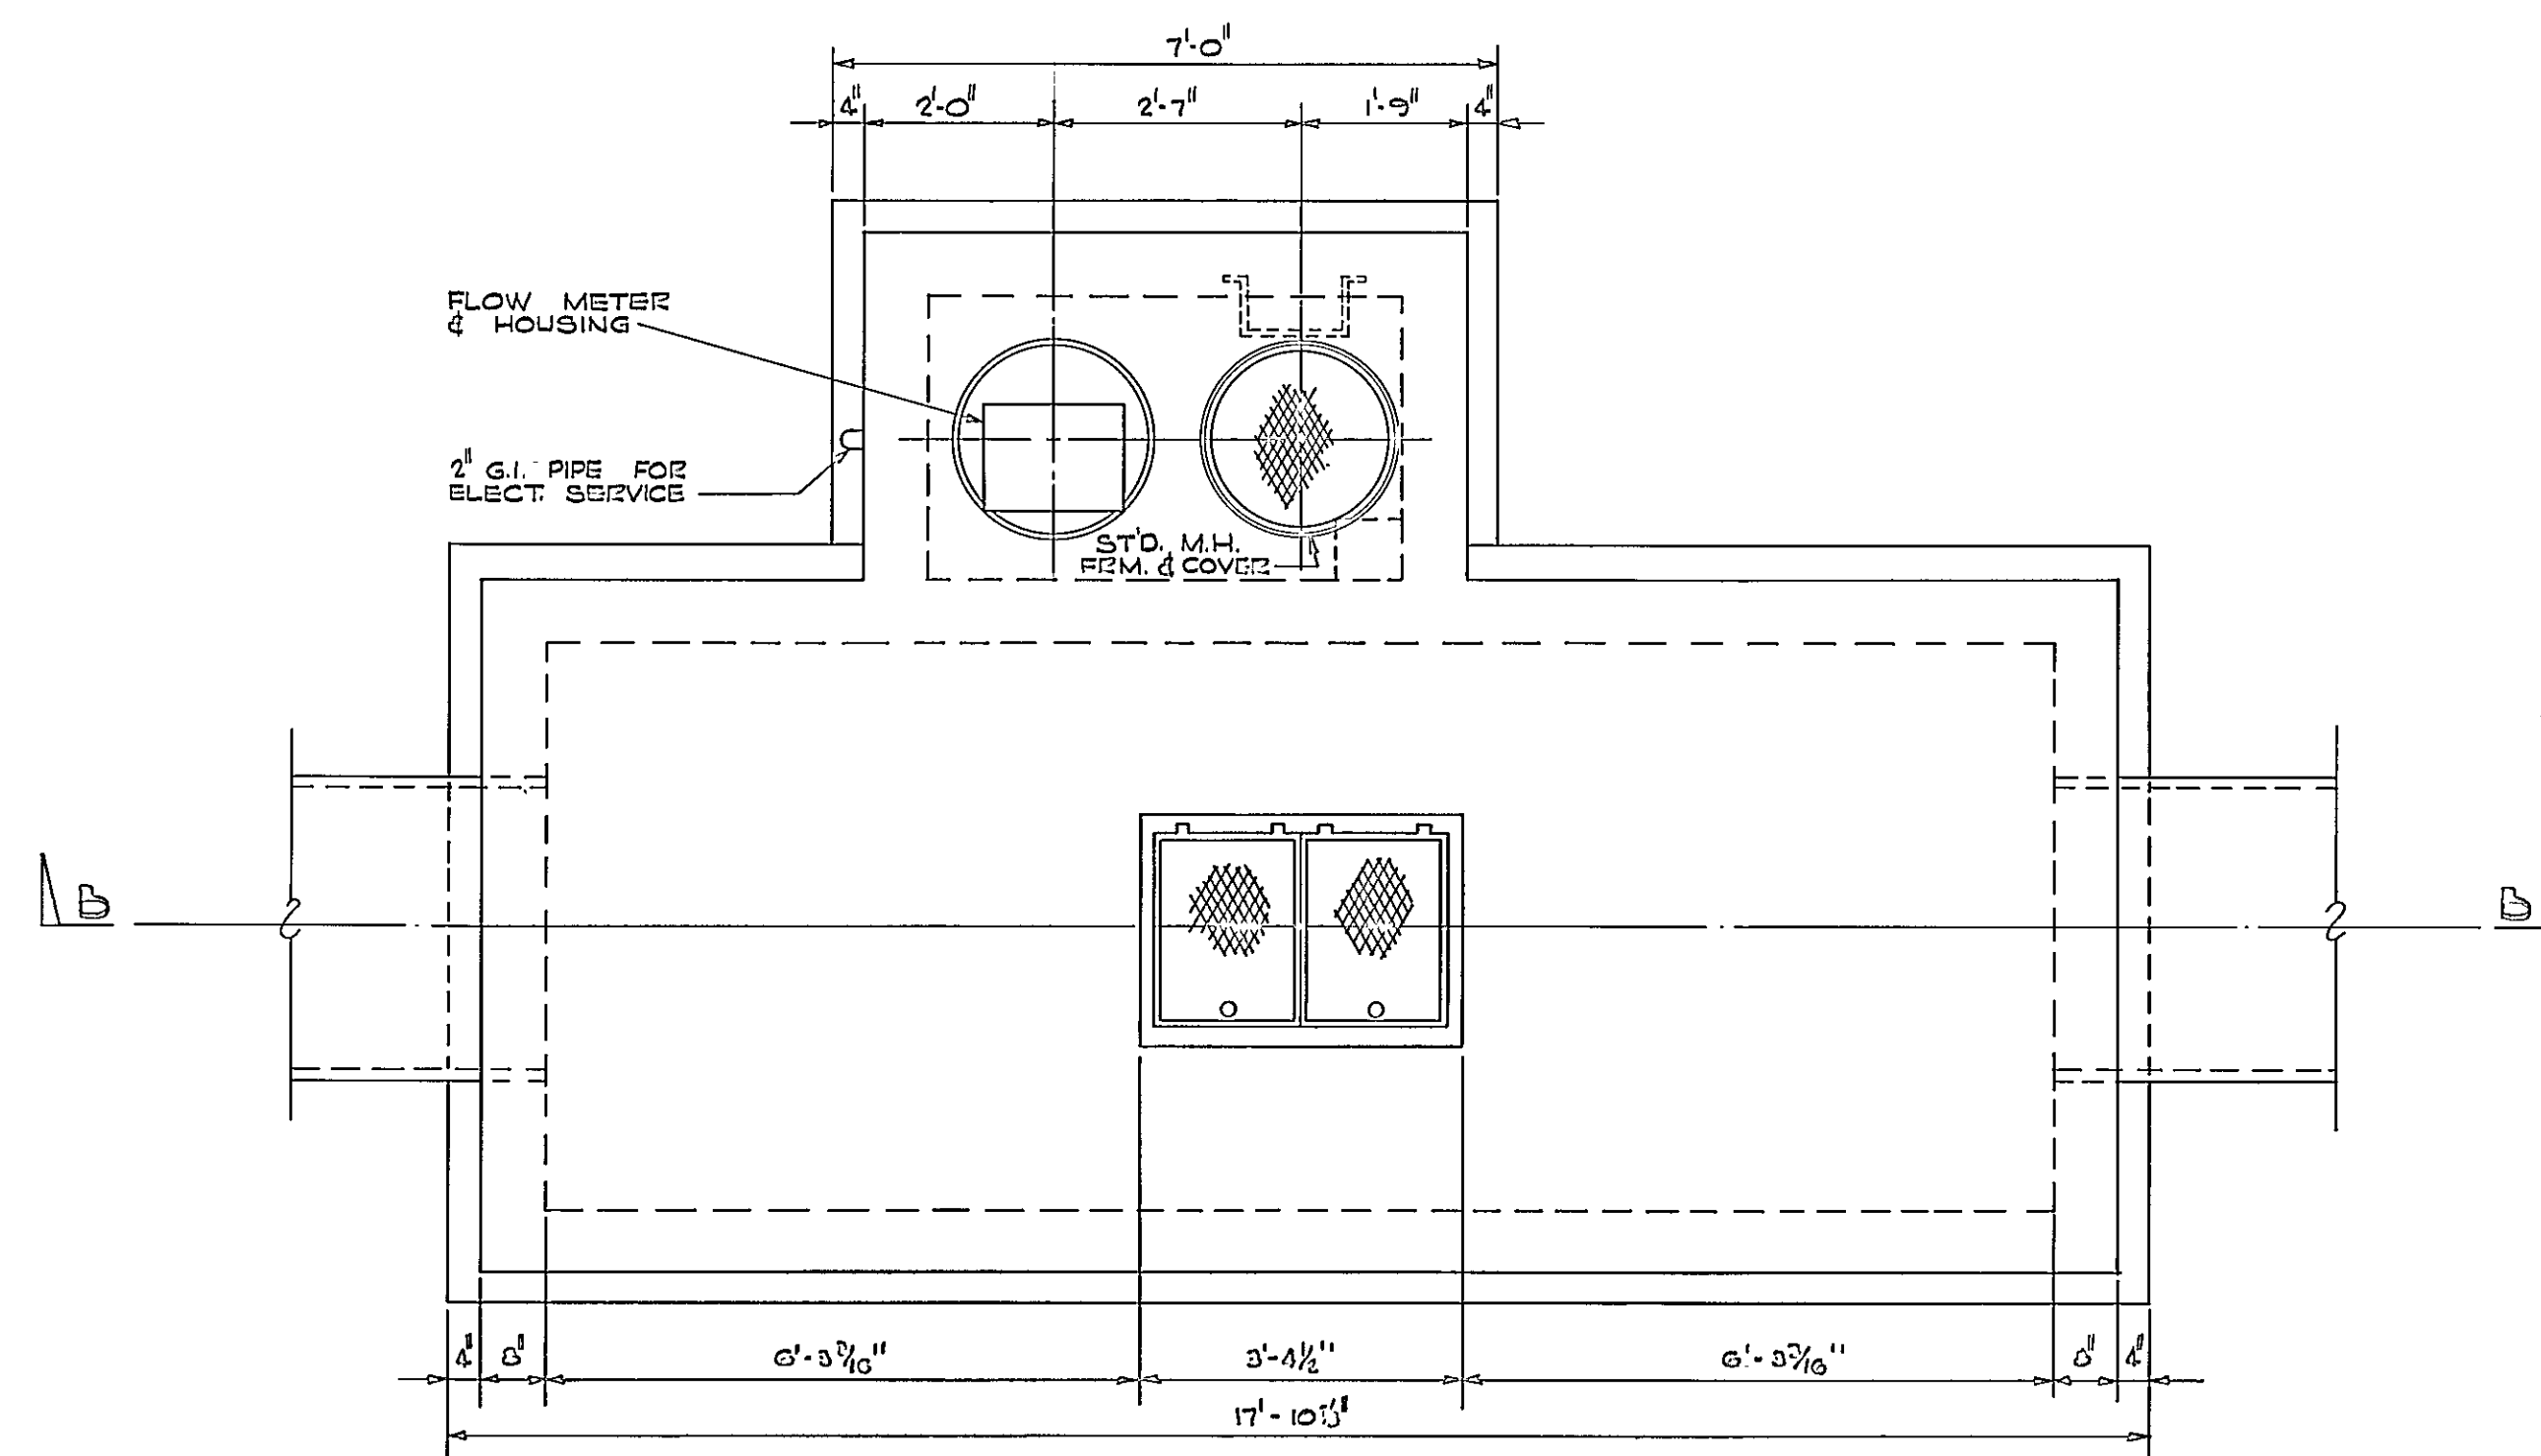


PLAN
SCALE: 1/2" = 1'-0"

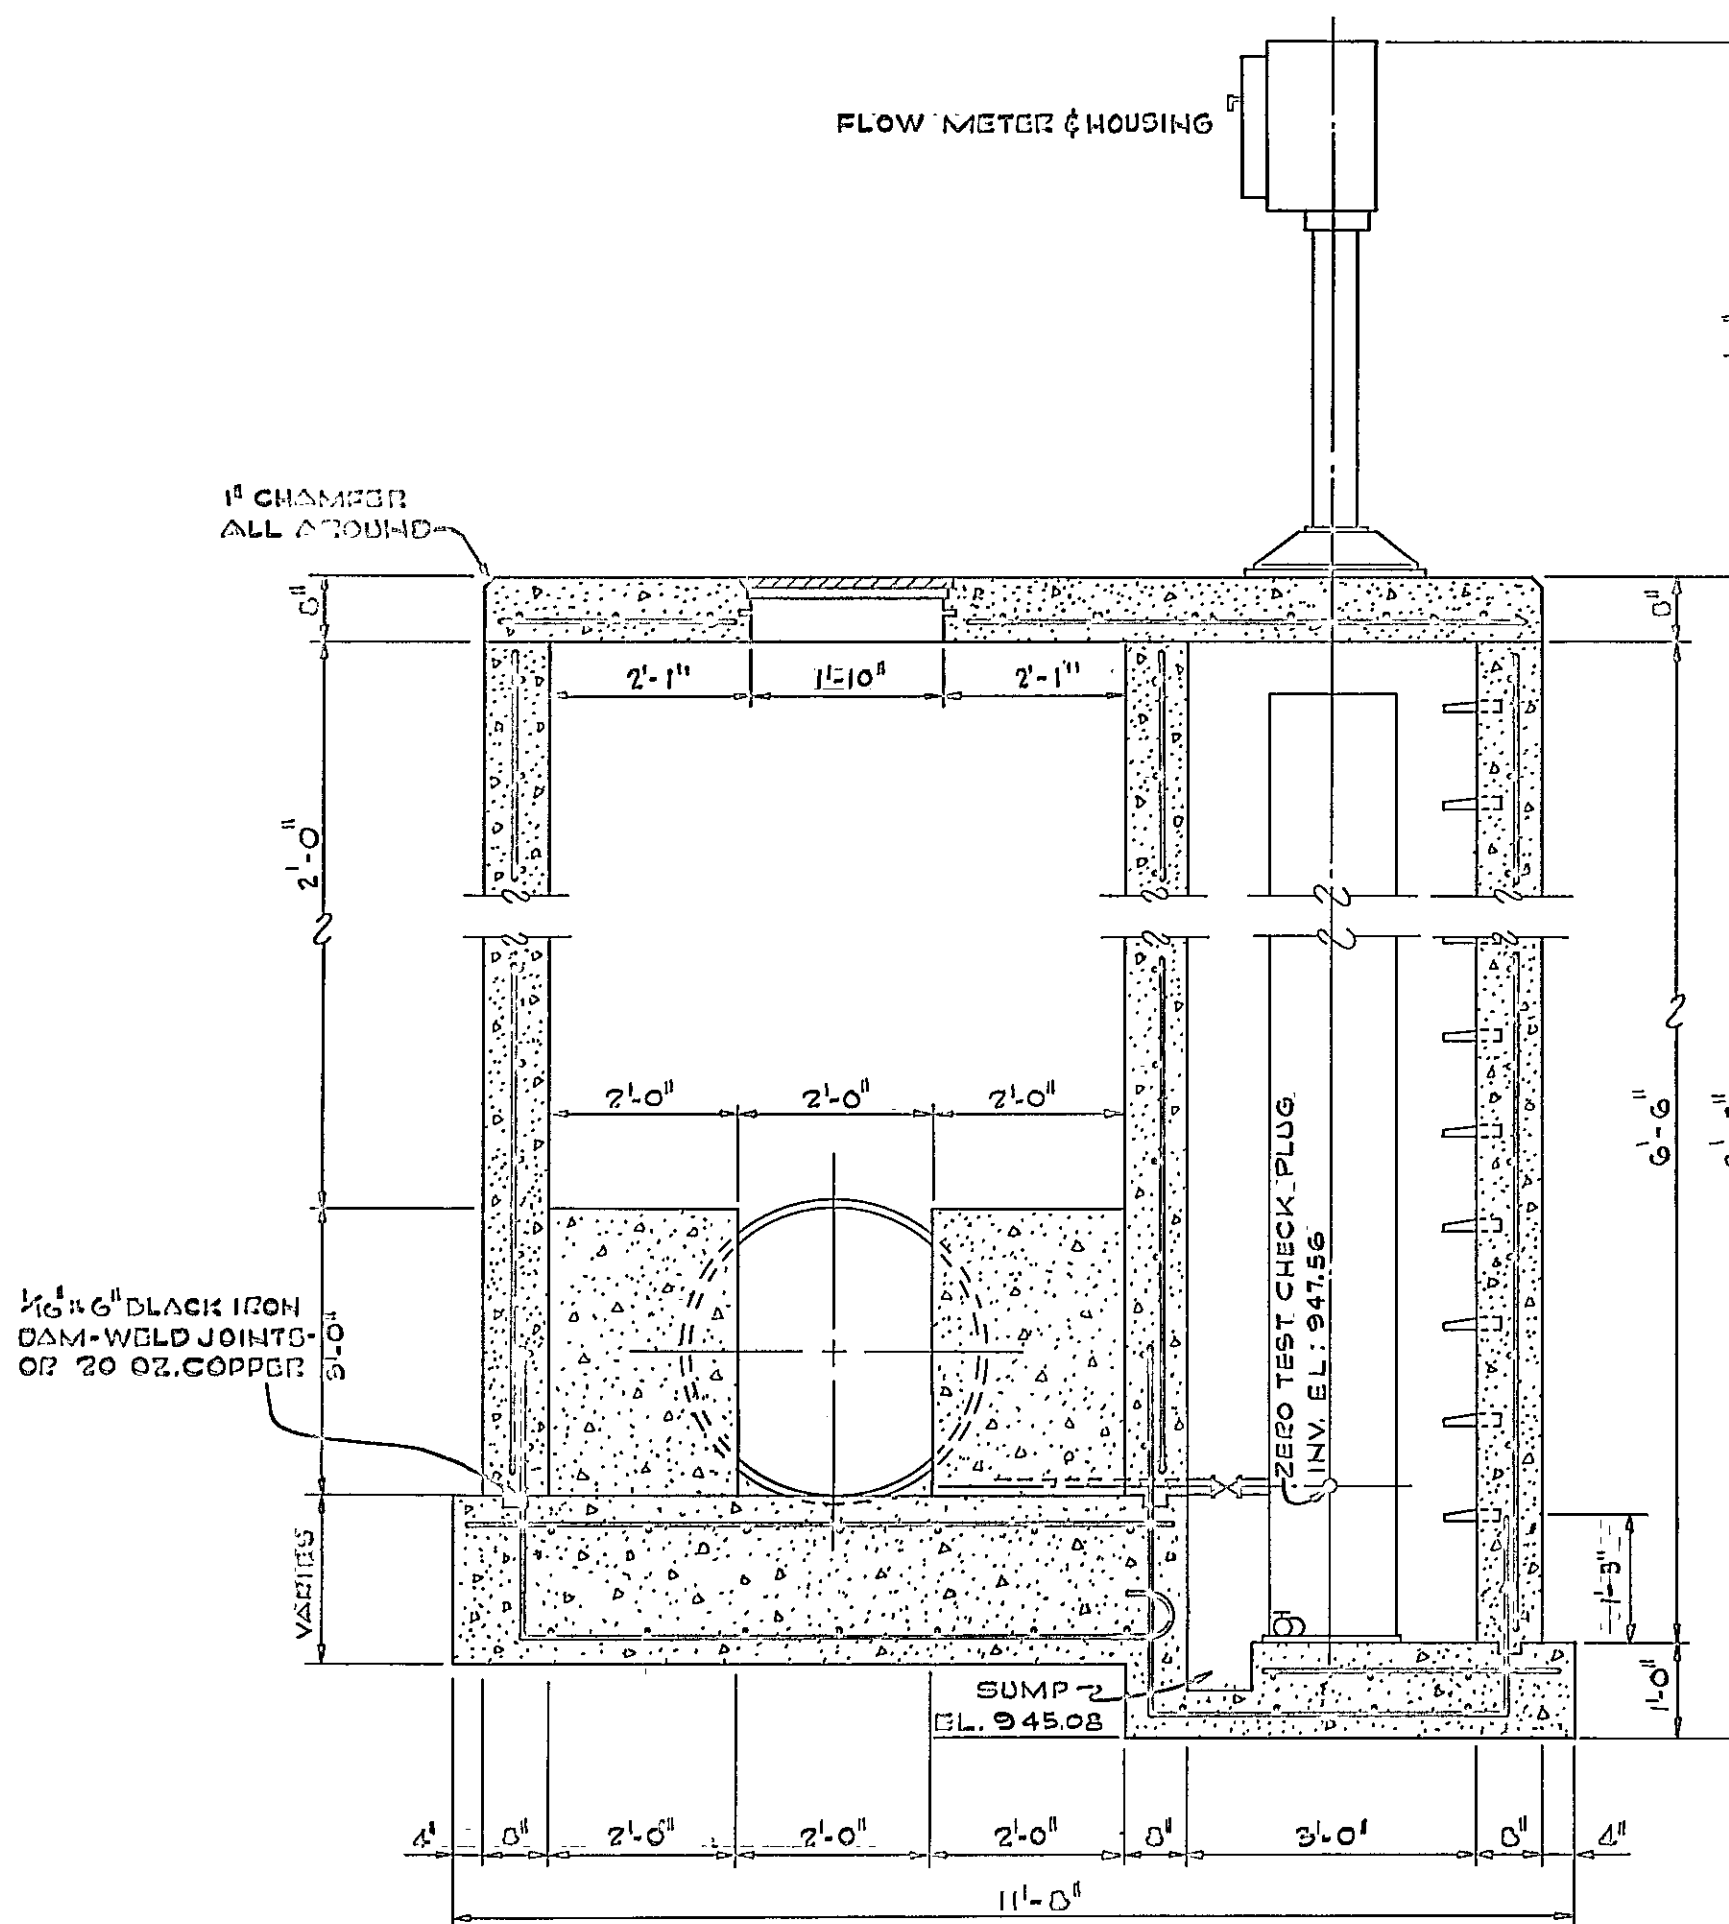


SECTION "C-C"
SCALE: 1/2" = 1'-0"

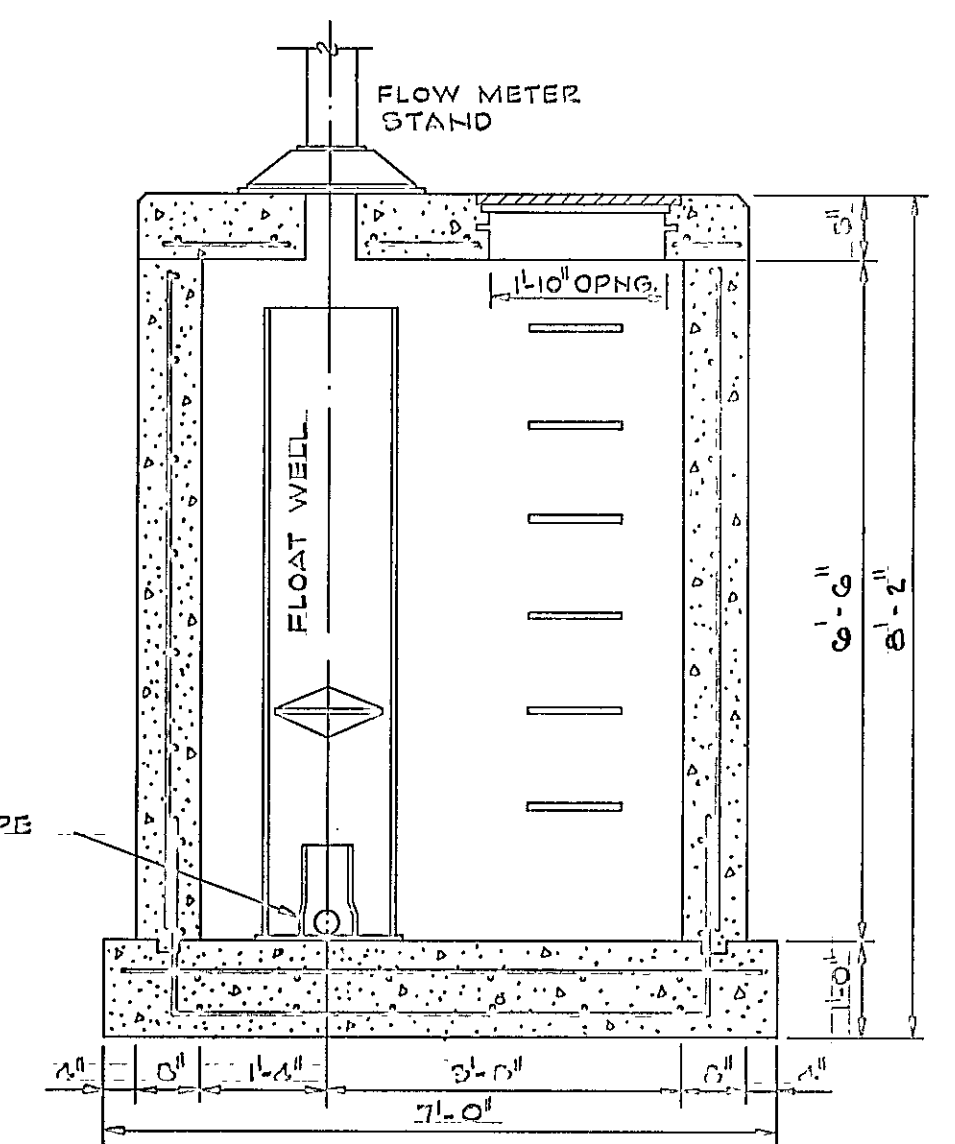


SECTION "D-D"
SCALE: 1/2" = 1'-0"

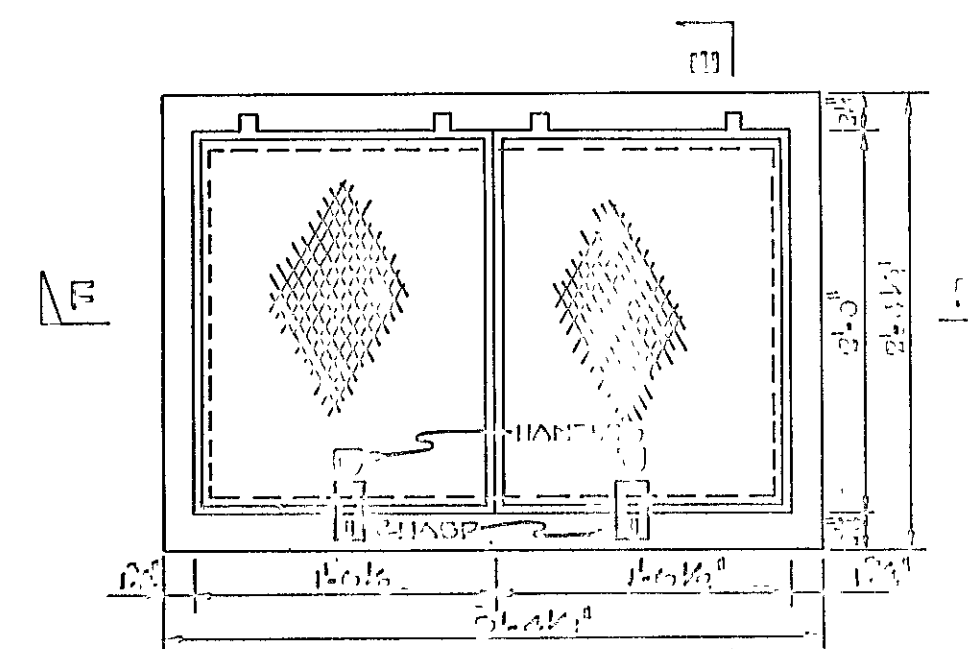

PLAN
SCALE: 1/2" = 1'-0"

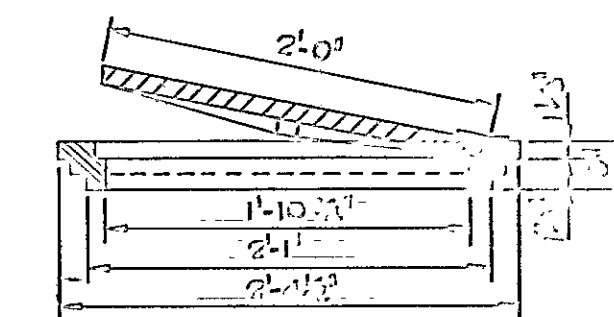


SECTION "E-E"
SCALE: 1/2" = 1'-0"

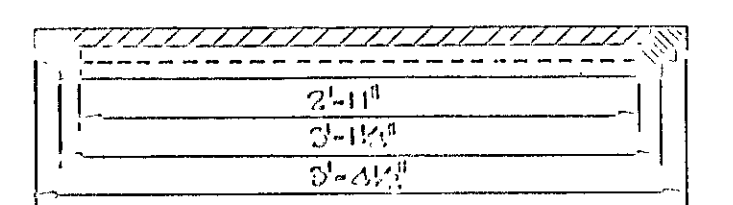

SECTION "F-F"
SCALE: 1/2" = 1'-0"

PAINT O.D. WALLS
WITH 2 COATS
BITUMASTIC NOTED

ALL REINF. STEEL
#5 @ 12" C

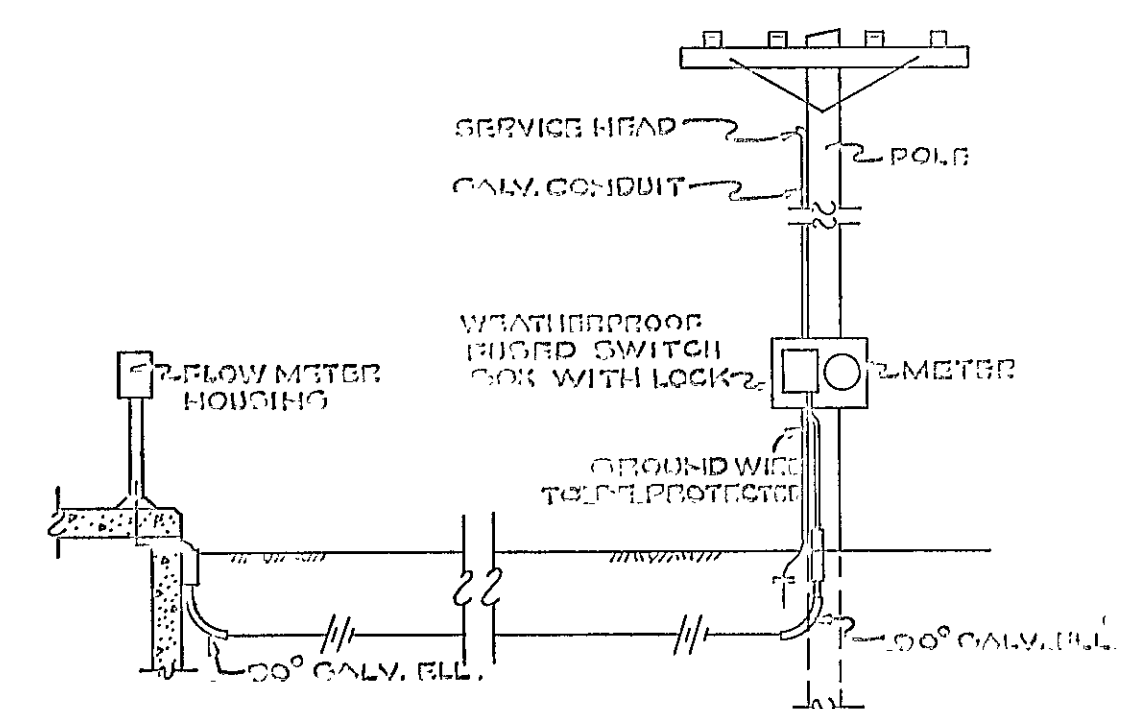

ELECTRICAL SERVICE CONNECTION
NOT TO SCALE

ROANOKE COUNTY PUBLIC SERVICE AUTHORITY ROANOKE COUNTY, VIRGINIA		
SANITARY TINKER	SEWERAGE CREEK	SYSTEM INTERCEPTOR
PROJECT No. 71-2-S METERING CHAMBER		
DES: W.H.C.	LANGLEY, McDONALD and OVERMAN	SCALE: AS SHOWN
DR: J.W.M.	CONSULTING ENGINEERS	DATE: 7/15/71
CK: W.E.C.	NORFOLK, VIRGINIA	SHEET 7 OF 10

AS BUILT