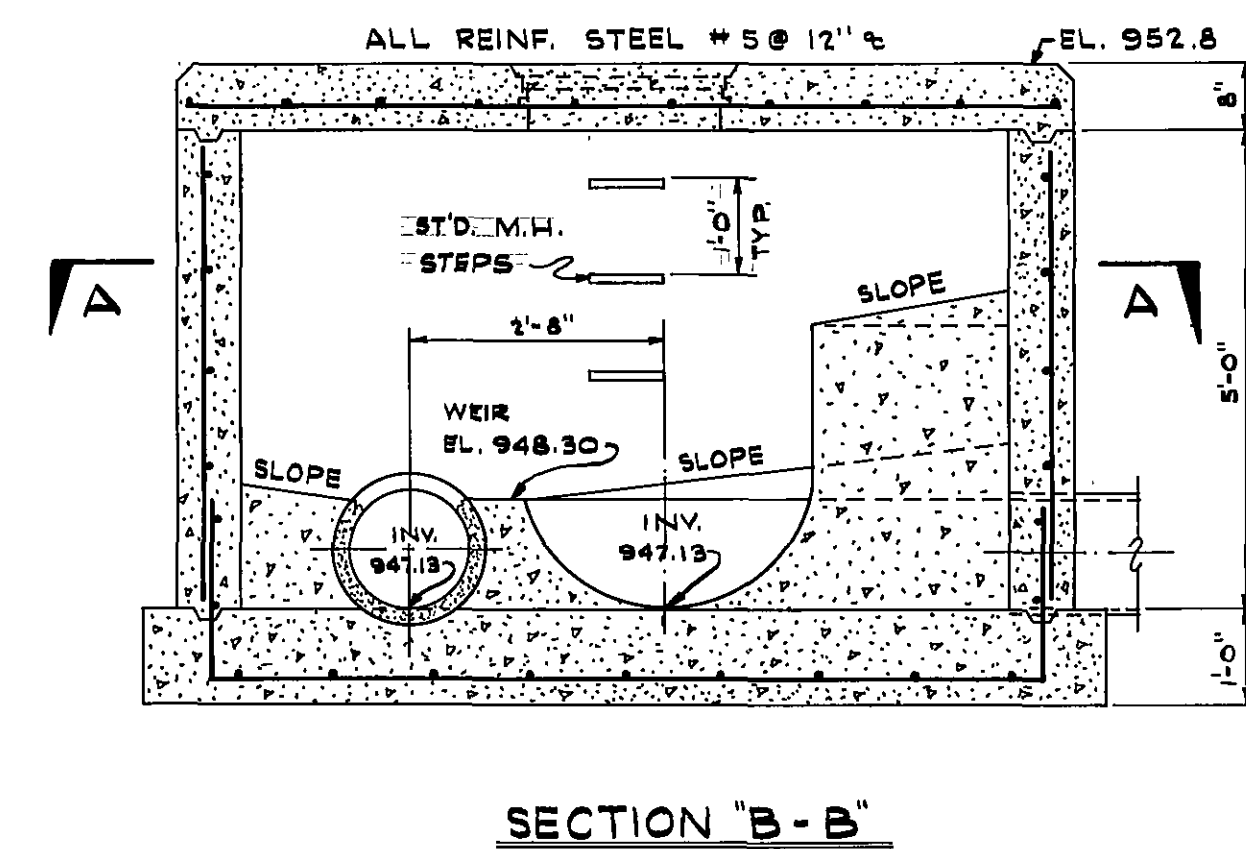
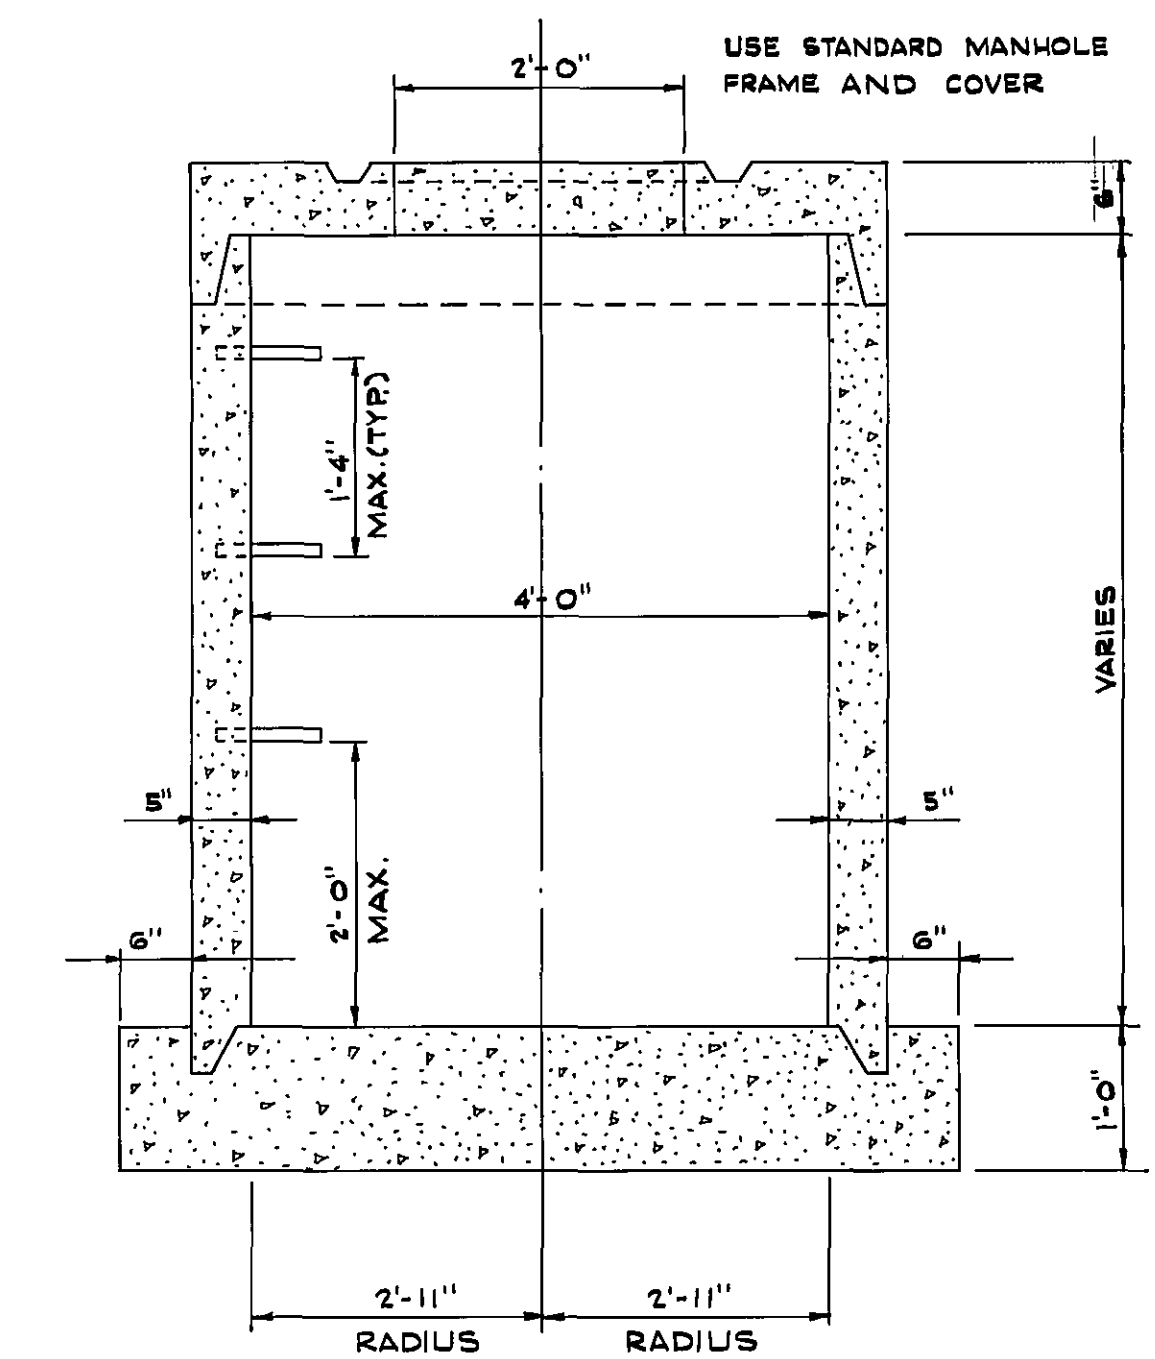
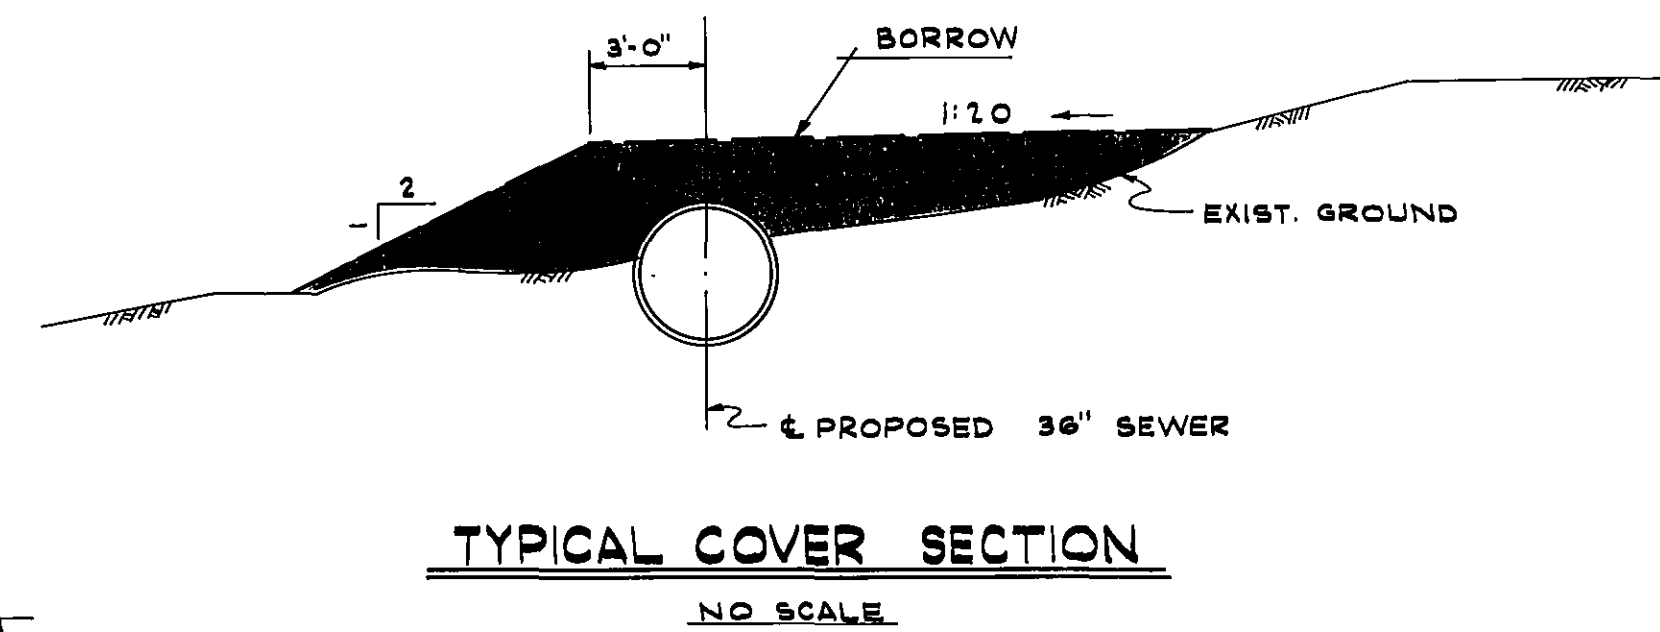
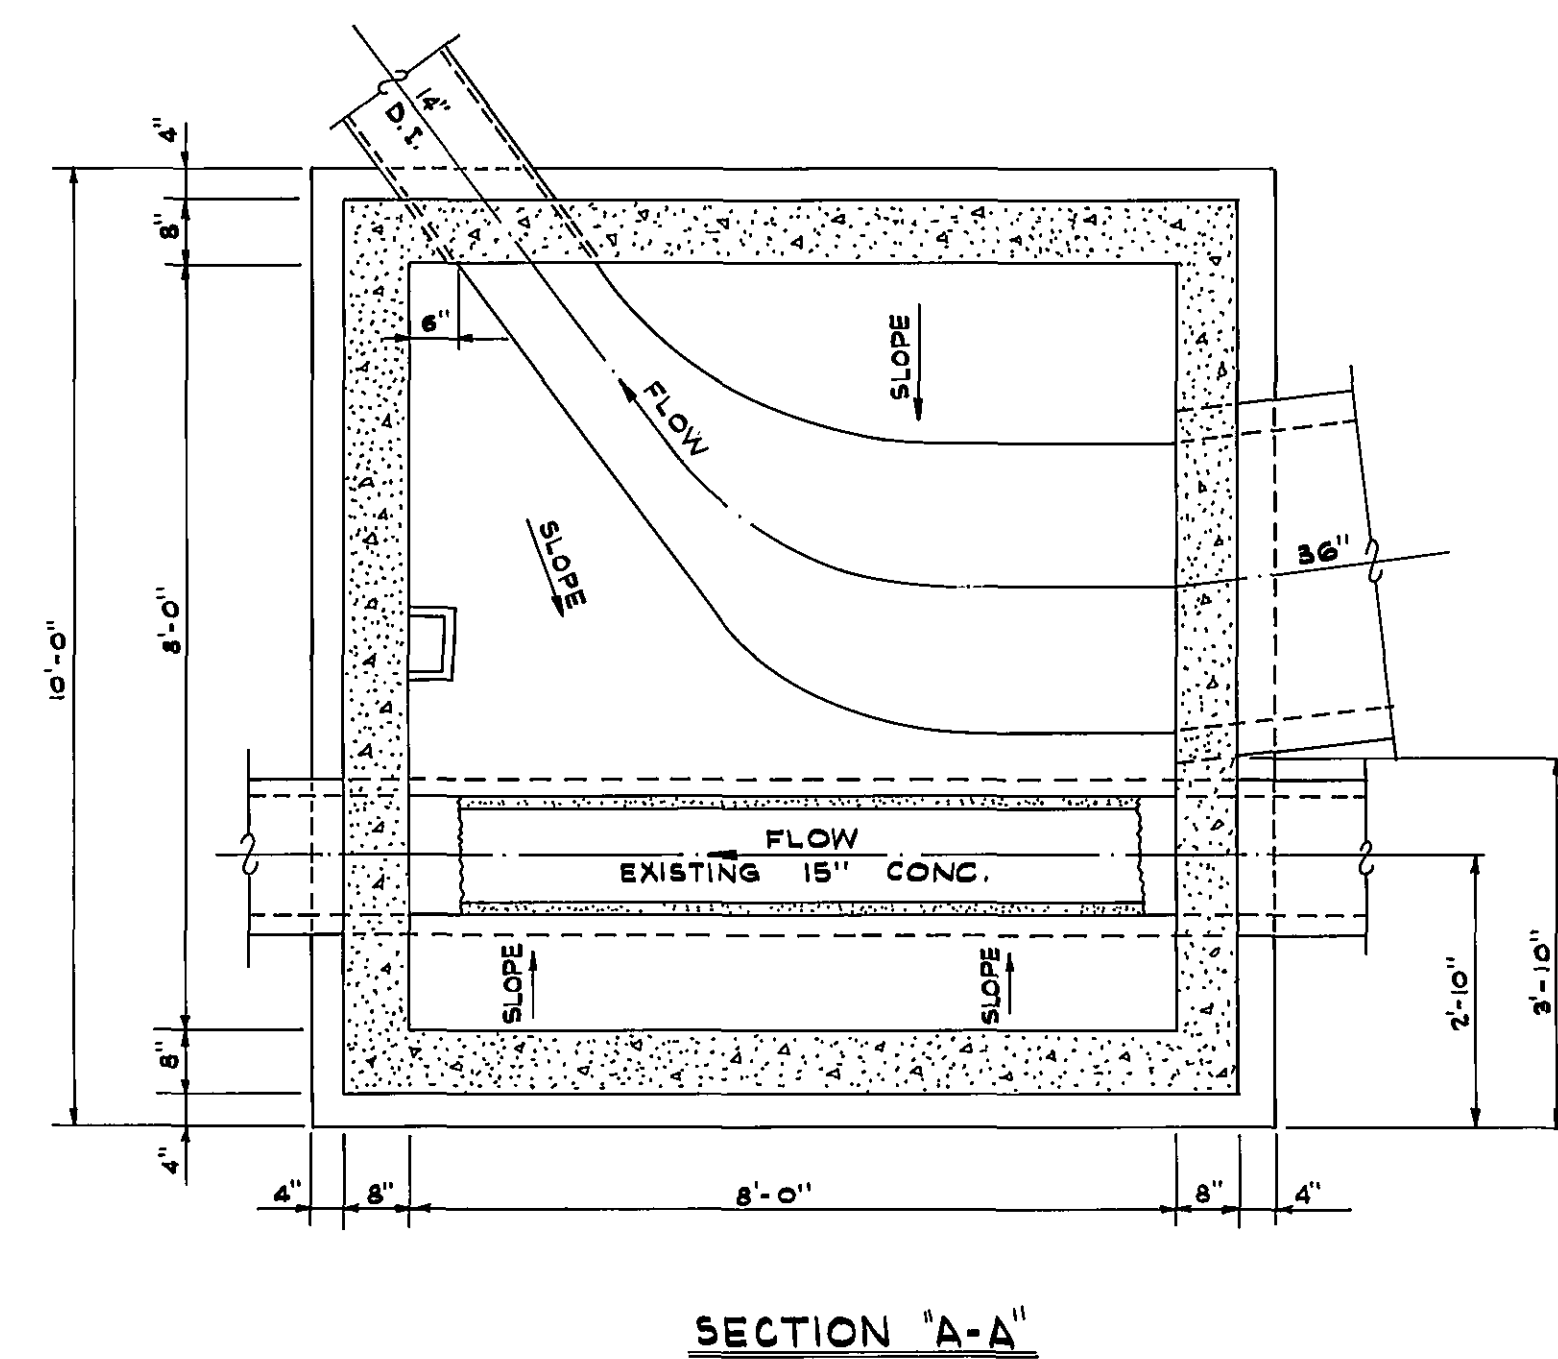
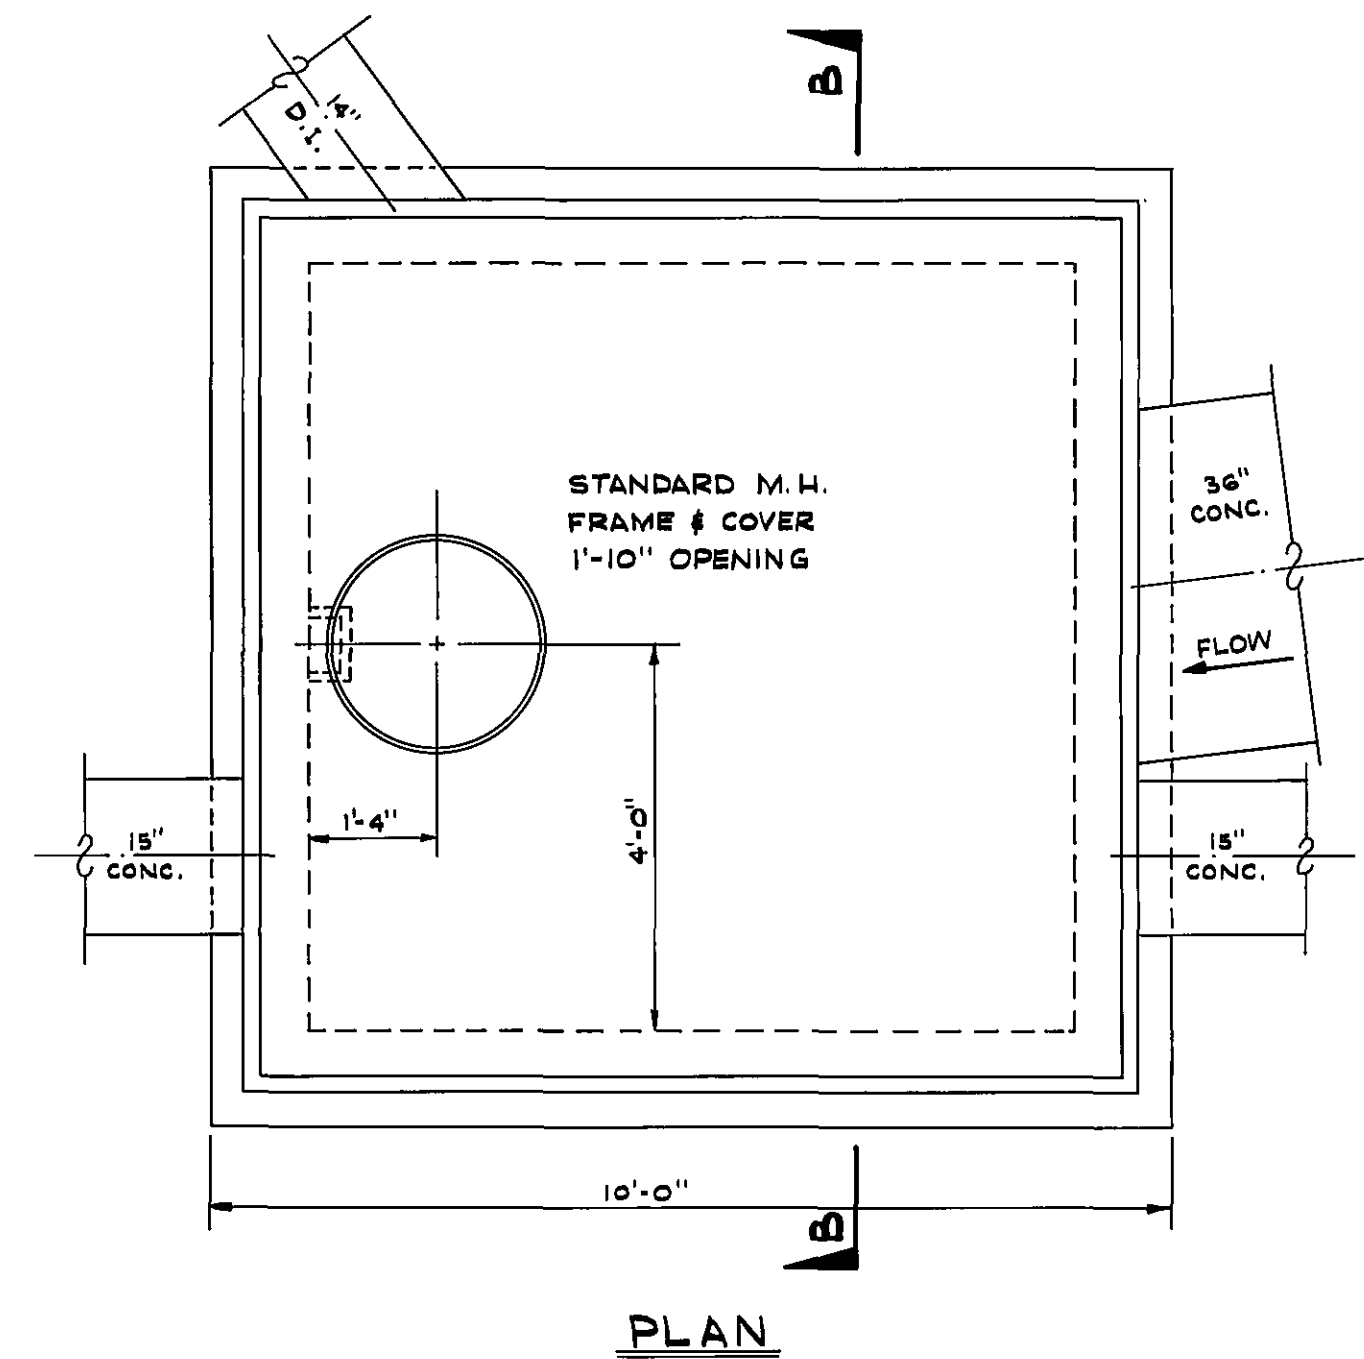


AS BUILT

ROANOKE COUNTY PUBLIC SERVICE AUTHORITY
ROANOKE COUNTY, VIRGINIA

SANITARY SEWERAGE SYSTEM TINKER CREEK INTERCEPTOR

PROJECT No. 71-2-S
DETAILS

, McDONALD and

DES:	W.E.C.
DR:	T.V.L.
CK:	W.E.C.

DR: T.V.L.

CK: W.E.C.

LANGLEY, McDONALD and OVERMAN
CONSULTING ENGINEERS
NORFOLK, VIRGINIA

SCALE: AS SHOWN
DATE: 7/15/71
SHEET 8 OF 10

