




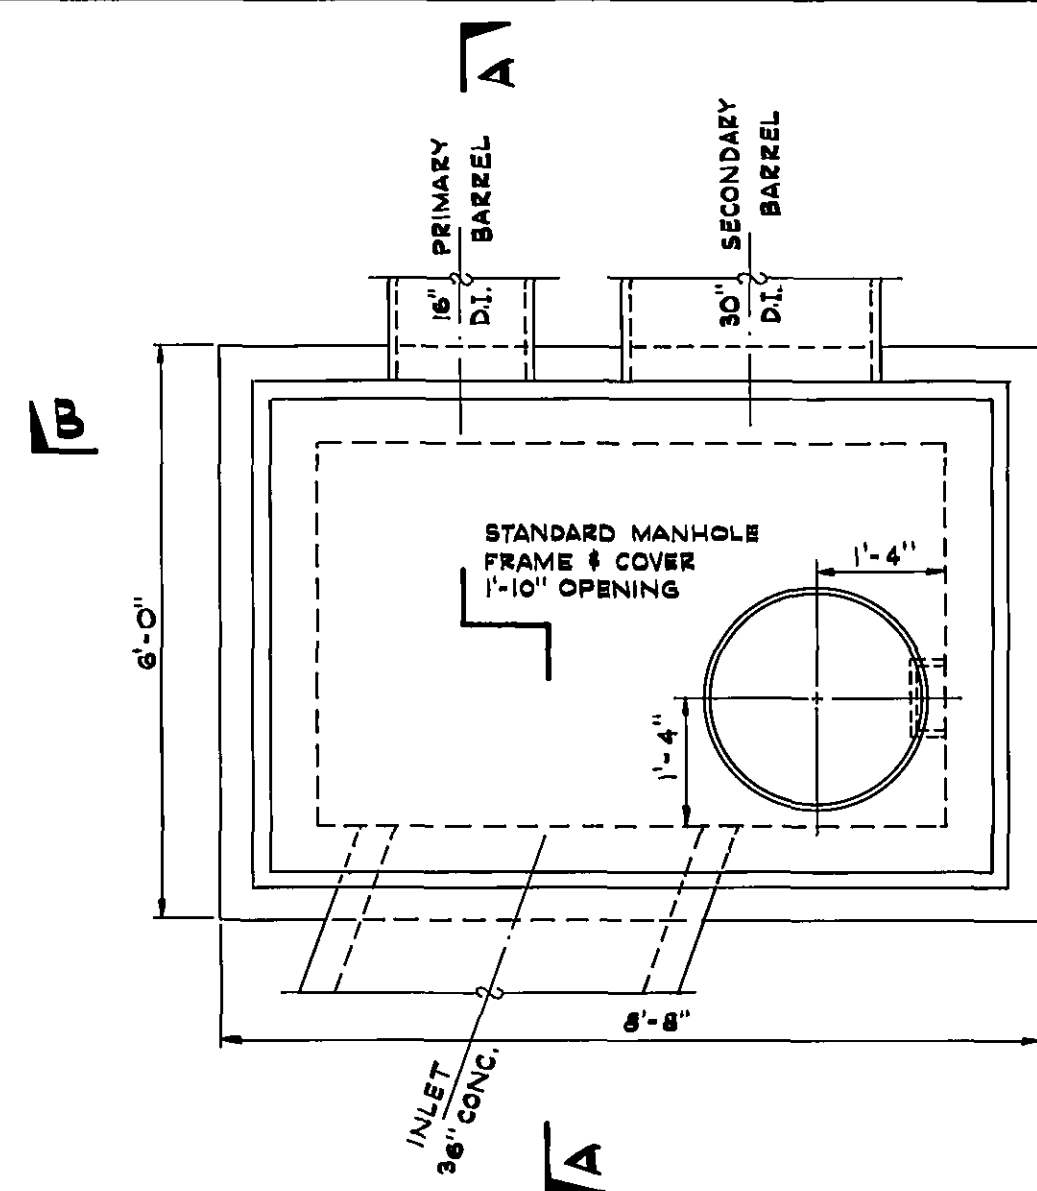


PLAN AT ELEV. 957.00

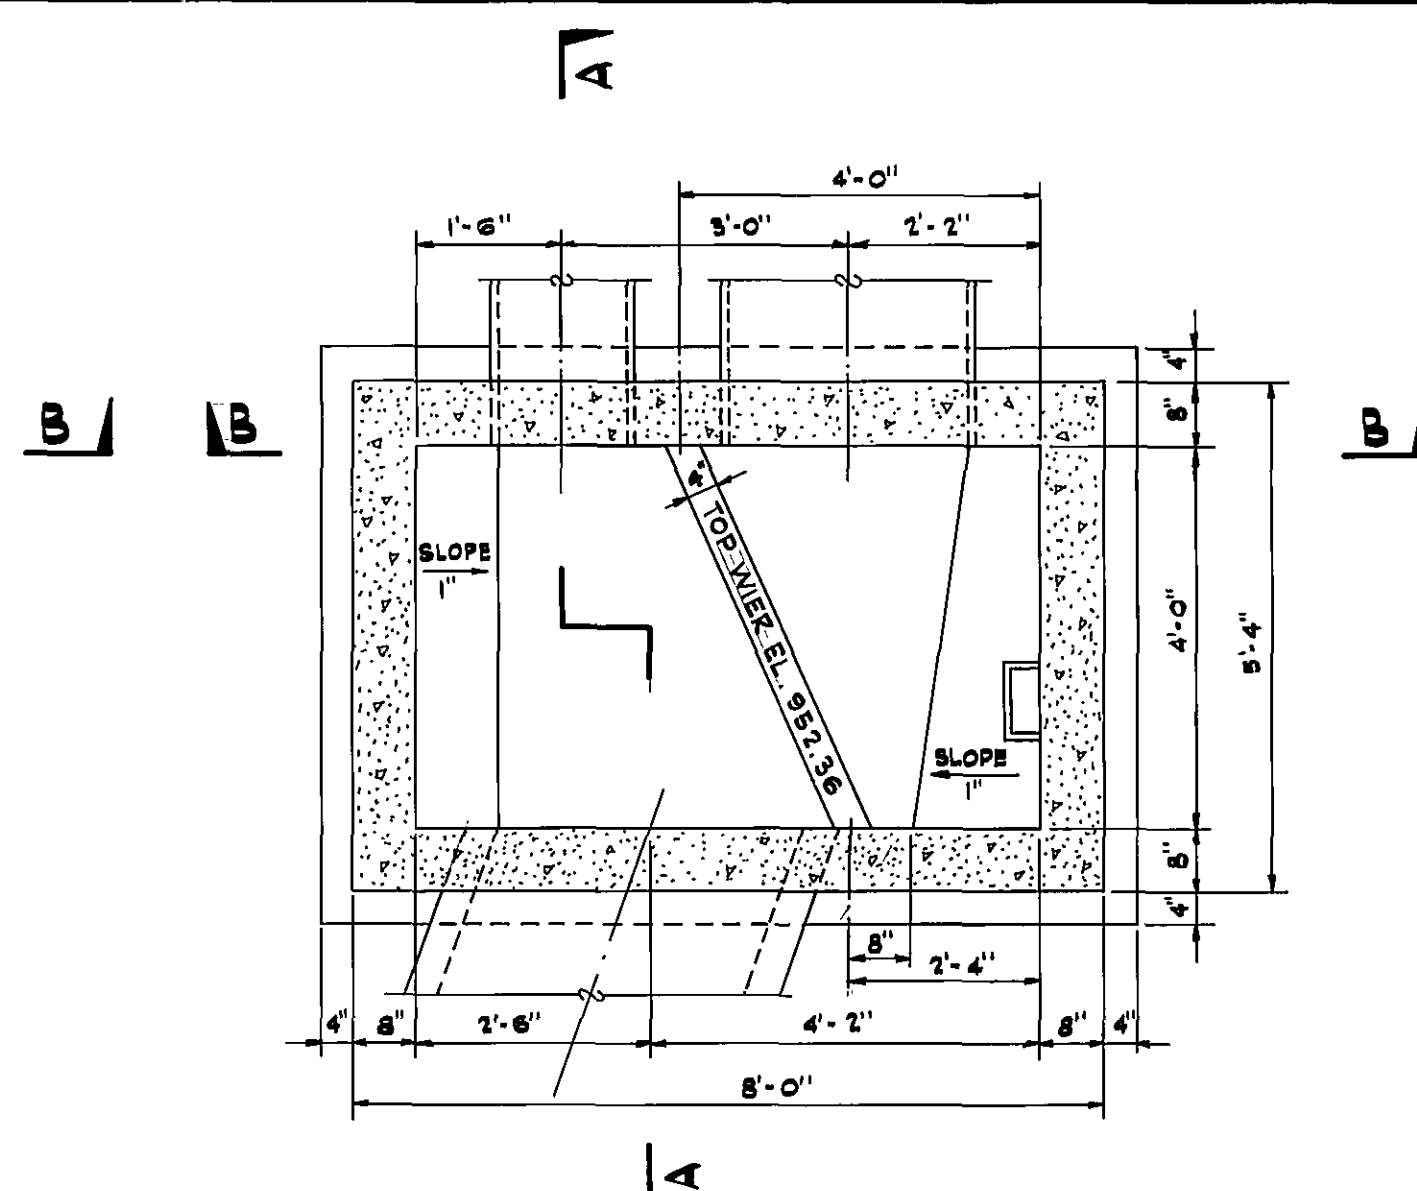

PLAN AT ELEV. 954.00

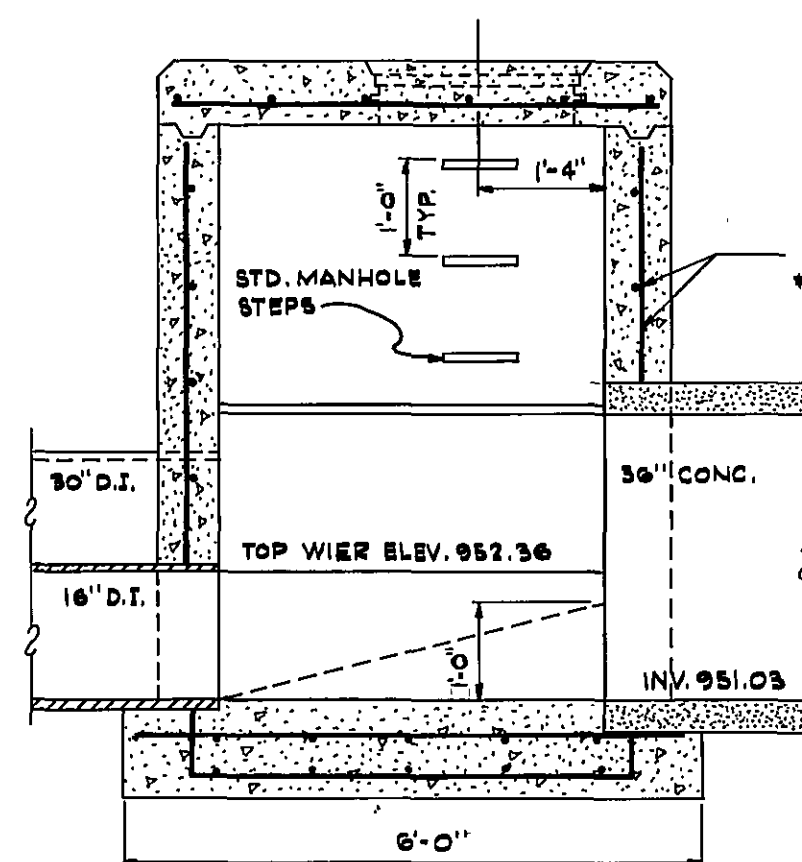


SECTION "A-A"

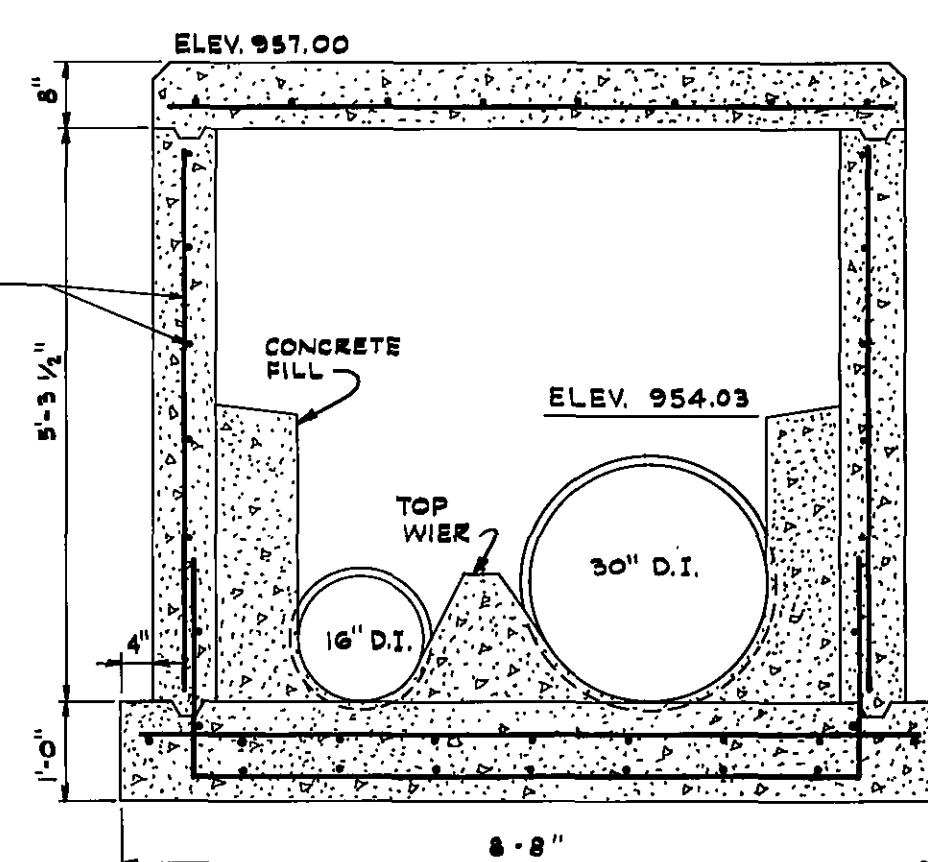


SECTION "B-B"

SIPHON INLET CHAMBER


STA. 31 + 47
SCALE: 1/4" = 1'-0"

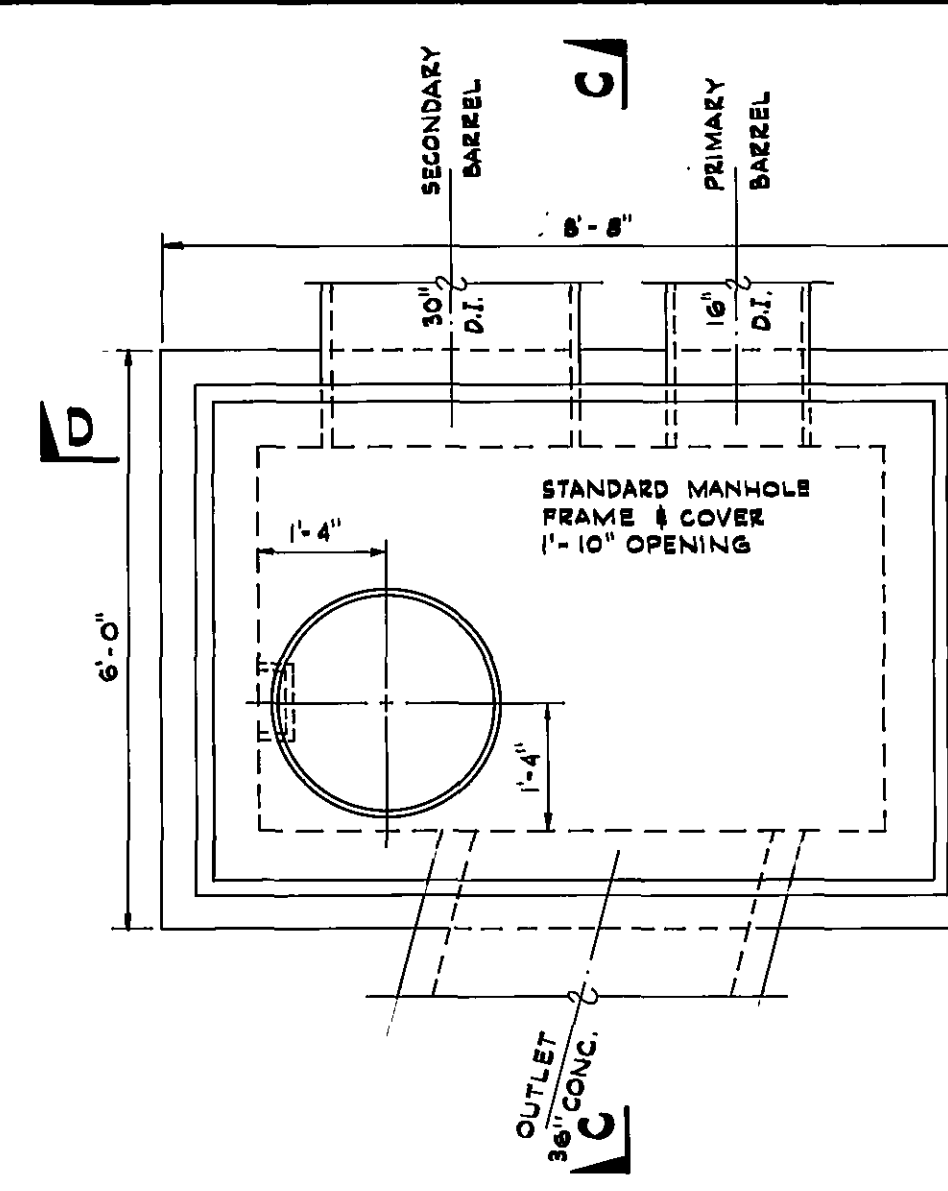


PLAN AT ELEV. 951.00

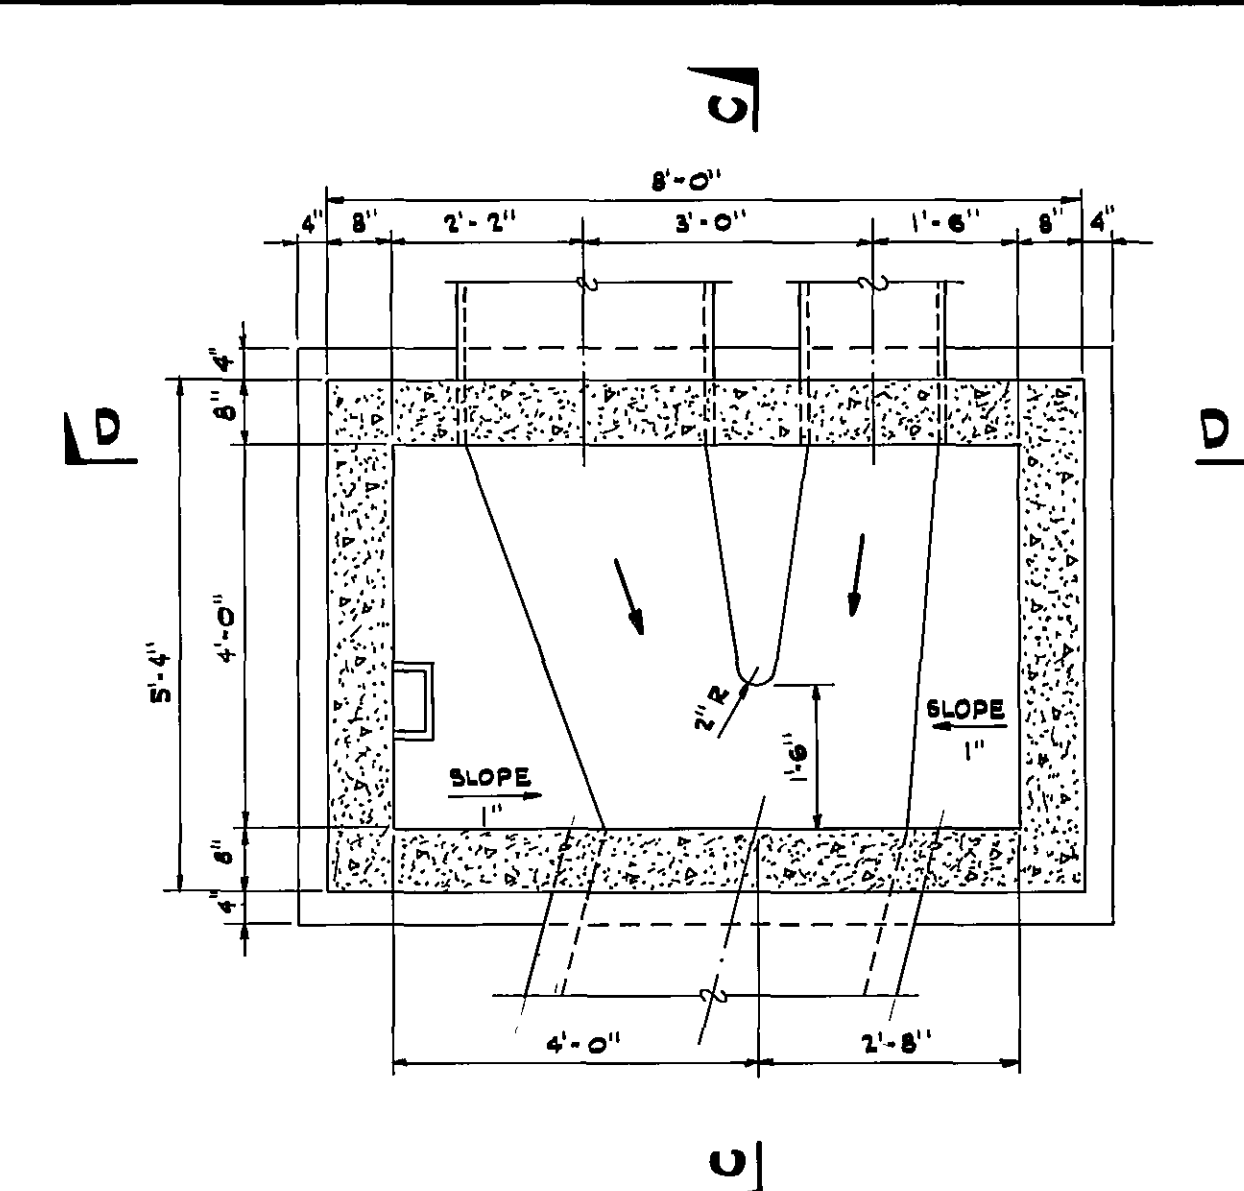

PLAN AT ELEV. 954.00

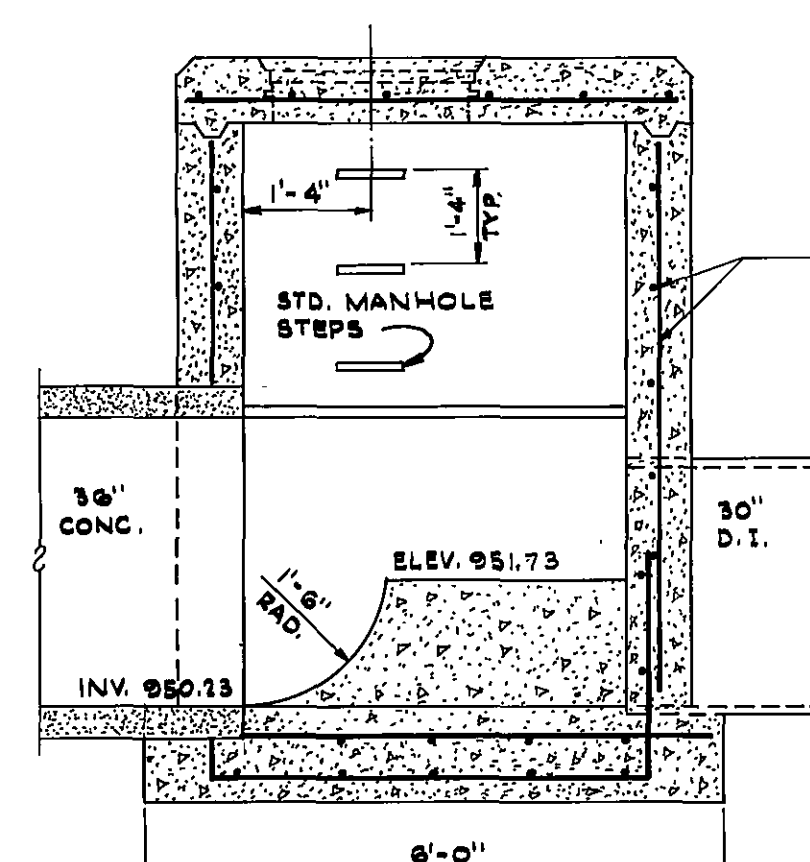


SECTION "C-C"

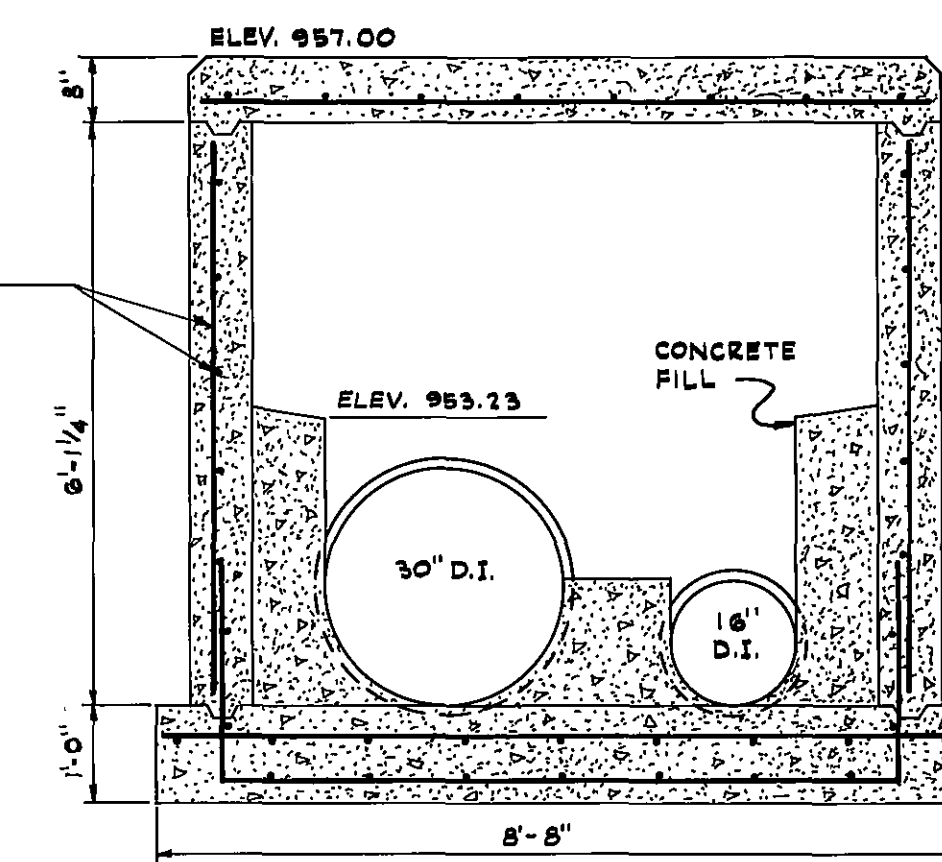

SECTION "D-D"

SIPHON OUTLET CHAMBER

STA. 19 + 47
SCALE: 1/4" = 1'-0"

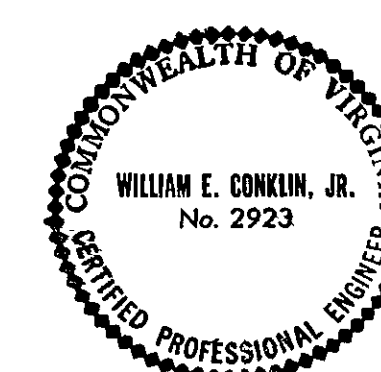

AS BUILT

ROANOKE COUNTY PUBLIC SERVICE AUTHORITY
ROANOKE COUNTY, VIRGINIA

SANITARY SEWERAGE SYSTEM
TINKER CREEK INTERCEPTOR
PROJECT No. 71-2-S
DETAILS

DES: W.H.C.
DR: T.V.L.
CK: W.E.C.

LANGLEY, McDONALD and OVERMAN
CONSULTING ENGINEERS
NORFOLK, VIRGINIA

SCALE: AS SHOWN
DATE: 7/15/71
SHEET 9 OF 110