


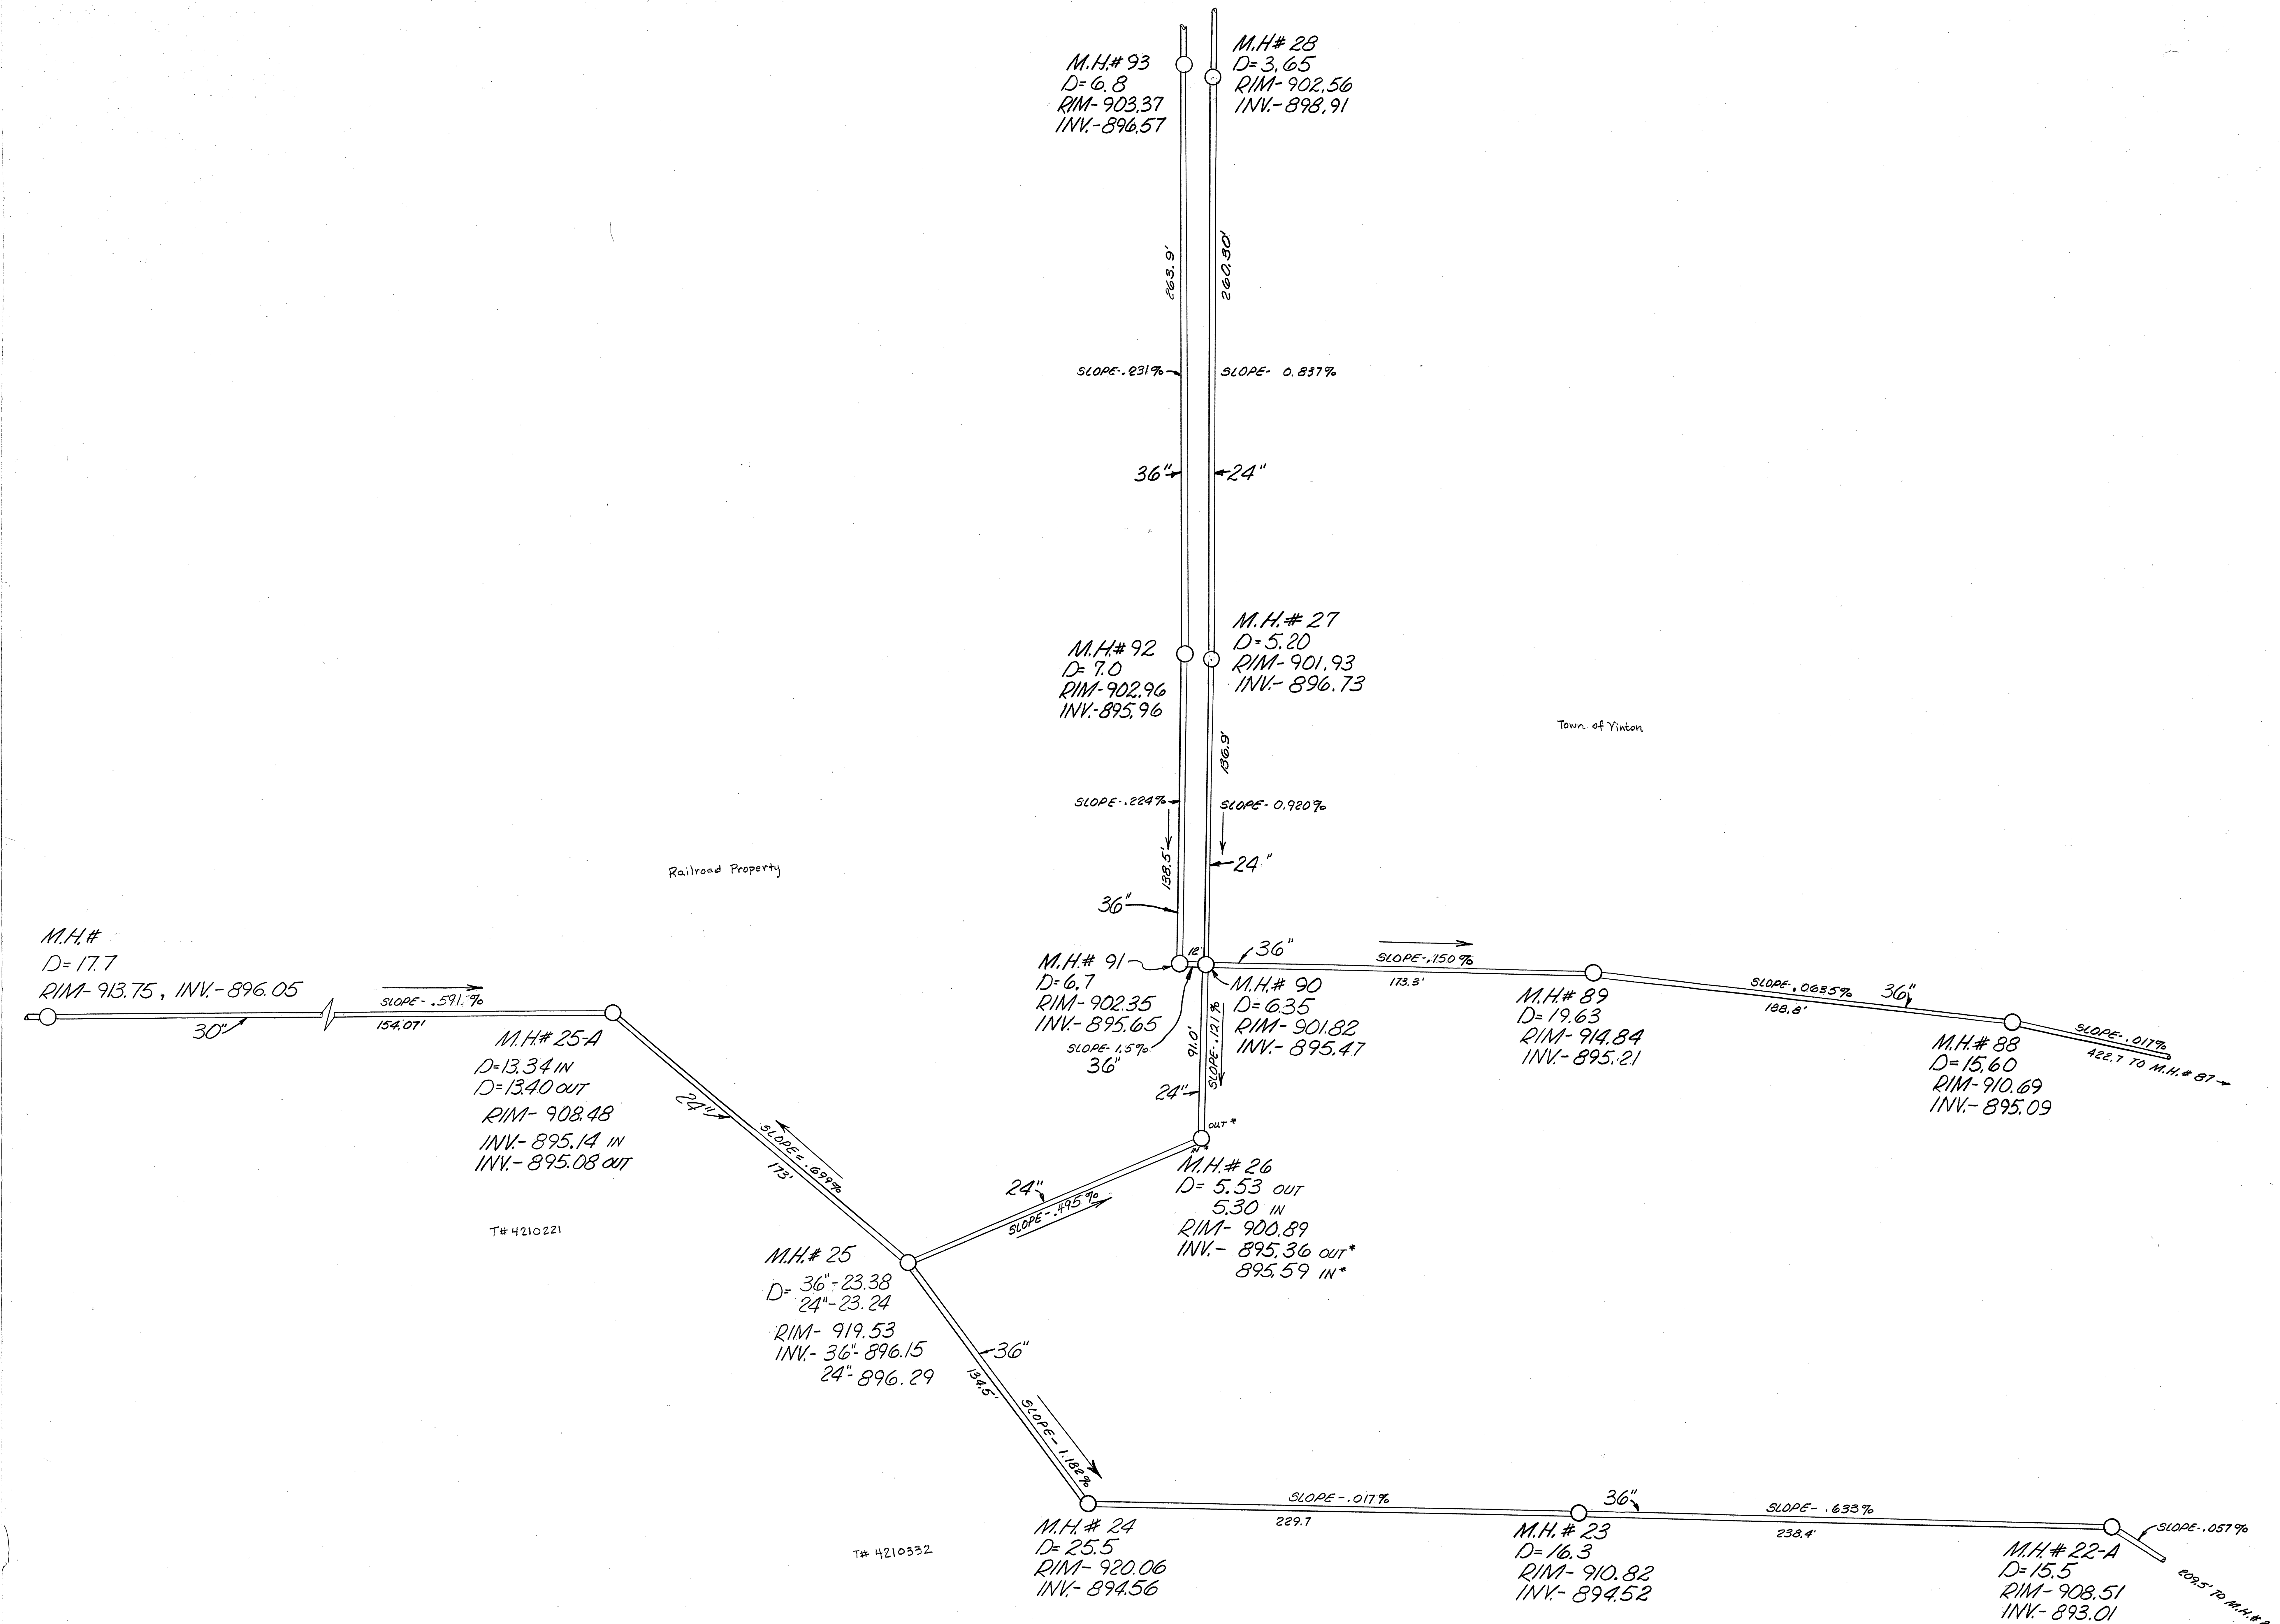

INTERSECTION OF NORFOLK AVE.
& TINKER CREEK INTERCEPTORS

SCALE - 1" = 25' DATE - NOV. 30, 1976
F.B. - 609 & 577