



PROJECT NO. WPC-VA-266

INTERCEPTOR SEWERS

PROJECT NO. 1

TINKER CREEK — LICK RUN

CITY OF
ROANOKE, VIRGINIA

INDEX OF DRAWINGS

SHEET NO.	DESCRIPTION
1	TITLE SHEET
2-11	PLAN & PROFILE
12-18	DETAILS
(SHEETS 16, 17 & 18 DELETED FROM CONTRACT)	

NOTES:

1. ALL DISTANCES AND INVERTS ARE Q. OF MANHOLE.
2. ALL DISTANCES SHOWN ARE HORIZONTAL MEASUREMENTS.
3. LOCATION AND DEPTHS OF UTILITIES ARE APPROXIMATE AND THE CONTRACTOR IS RESPONSIBLE FOR DETERMINING EXACT LOCATIONS AND DEPTHS.
4. FOR ADDITIONAL DETAILS SEE SPECS.

LEGEND

- NEW SANITARY SEWER & MANHOLE
- EXISTING SANITARY SEWER
- EXISTING STORM DRAIN
- EXISTING GAS LINE
- EXISTING WATER LINE
- SEWER LINE TO BE ABANDONED
- BANK
- EXISTING UTILITY POLE
- EXISTING MANHOLE
- TREE OR SHRUB
- C-1 TEST BORING
- T-S-1 SEISMIC DETERMINATION (TINKER CREEK)
- L-S-1 SEISMIC DETERMINATION (LICK RUN)

PIPE SCHEDULE

- 1.1 STD STR VITRIFIED CLAY
- 1.2 EXT STR VITRIFIED CLAY
- 1.3 EXT STR VITRIFIED CLAY w/CONC BED
- 1.4 EXT STR VITRIFIED CLAY w/REINF CONC BED
- 2.1 EXT STR CONC
- 2.2 EXT STR CONC w/CONC BED
- 3.2 REINF CONC CLASS III
- 3.3 REINF CONC CLASS III
- 3.4 REINF CONC CLASS IV
- 3.5 REINF CONC CLASS V
- 4.1 ASBESTOS CEMENT CLASS 2400
- 4.2 ASBESTOS CEMENT CLASS 3300
- 4.3 ASBESTOS CEMENT CLASS 4000
- 4.4 ASBESTOS CEMENT CLASS 5000
- 4.5 ASBESTOS CEMENT CLASS 4000 w/CONC BED
- 4.6 ASBESTOS CEMENT CLASS 5000 w/CONC BED
- 4.7 ASBESTOS CEMENT CLASS 5000 w/REINF CONC BED

SHEET WHERE
DETAIL IS
SHOWN

2.3 ———— DETAIL NO.
4 ———— SHEET WHERE
DETAIL APPLIES

DIVISION I AND III


AS BUILT

APPROVED MAY 1969

APPROVED MAY 1969

H. Oliver Broyles
DIRECTOR OF PUBLIC WORKS

William F. Clark
CITY ENGINEER

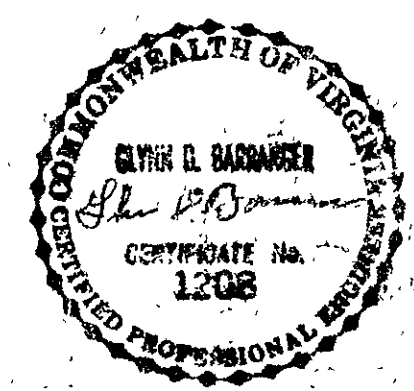

DESIGNED *LRD*
DRAWN *LRD*
CHECKED *MB*
APPROVED *MB*
SUBMITTED *MB*

INTERCEPTOR SEWERS
PROJECT NO. 1
TITLE SHEET

HAYES, SEAY, MATTERN & MATTERN
ARCHITECTS — ENGINEERS

SCALE AS NOTED
DATE DEC. 1967

COMM. NO. 3262
SHEET 1 OF 18