

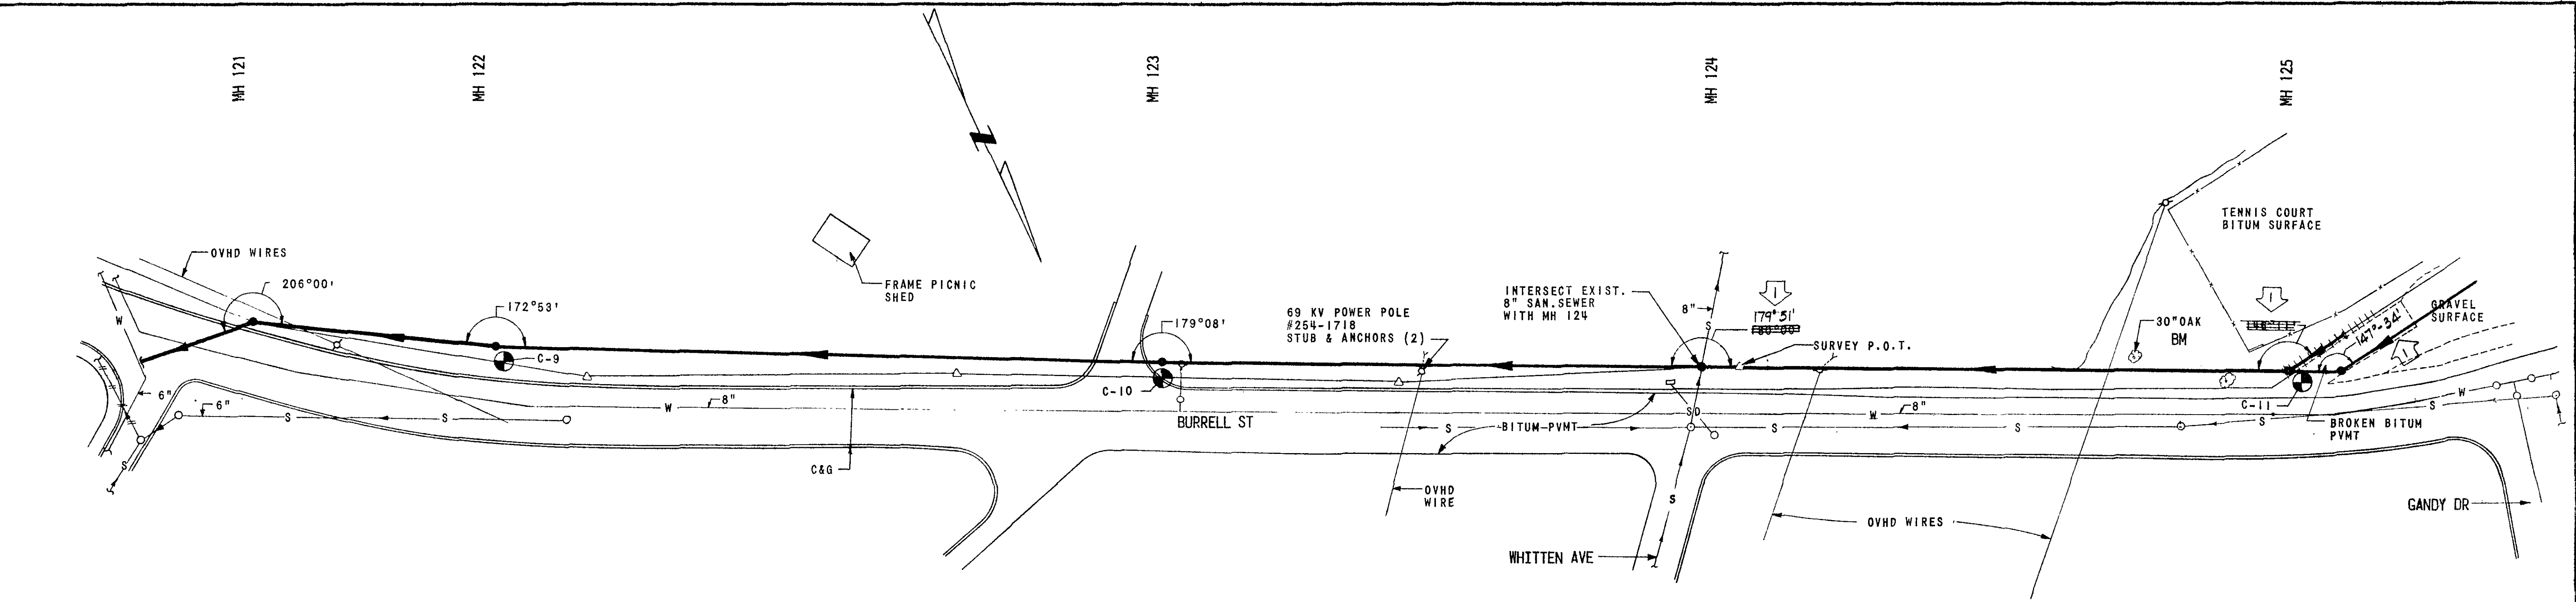



PLAN	SURVEYED	DATE
	PLOTTED	BY
NOTE BOOK	ALIGNMENT CHECKED	
	RT. OF WAY CHECKED	
No.		

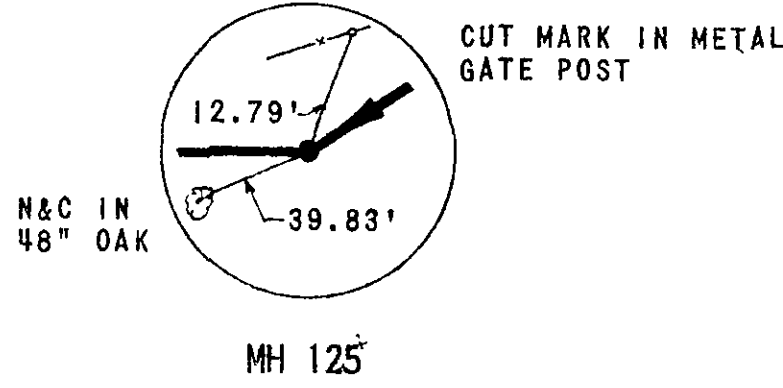

BM N&C IN ROOT 20" ELM 115'± LT STA 1+75
BETWEEN MH 122 & MH 123 BACK OF PICNIC SHELTER
@ TOP HILL - WEST SIDE BURRELL ST
ELEV 991.33

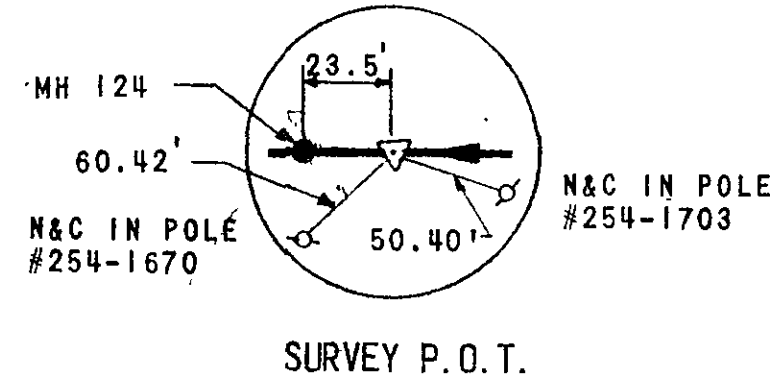

PROFILE	SURVEYED	DATE
	PLOTTED	BY
NOTE BOOK	GRADES CHECKED	
	STRUCTURE NOTATIONS CHECKED	
No.		

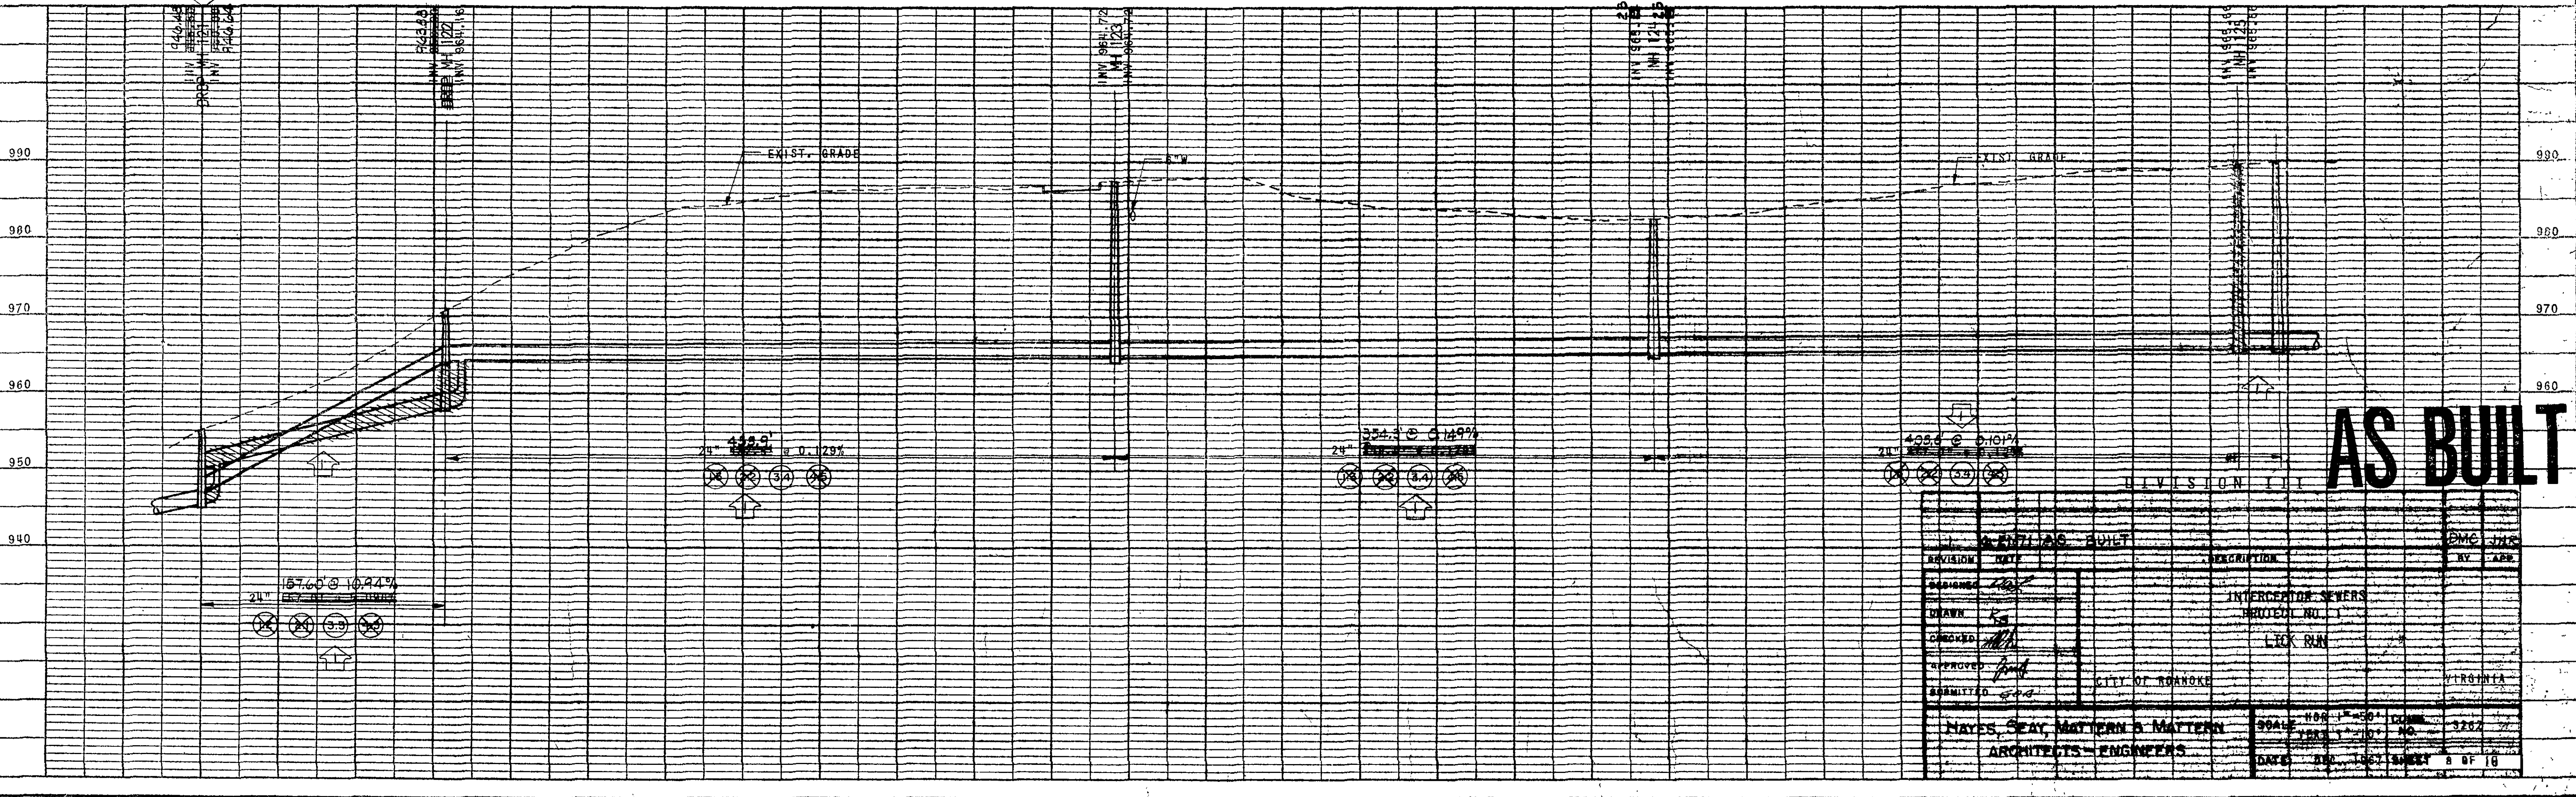

AS BUILT

REVISION	DATE	DESCRIPTION	BY	APP.
1		INTERCEPTOR SEWERS		
2		PROPOSED NO. 1		
3		LOCK RUN		
4				
5				
6				
7				
8				
9				
10				

CITY OF ROANOKE VIRGINIA

HAYES, SEAY, MATERN & MATERN ARCHITECTS-ENGINEERS

SCALE: HORIZ. 1"=50' VERT. 1"=10'

DATE: DEC. 1967 SHEET 8 OF 10