


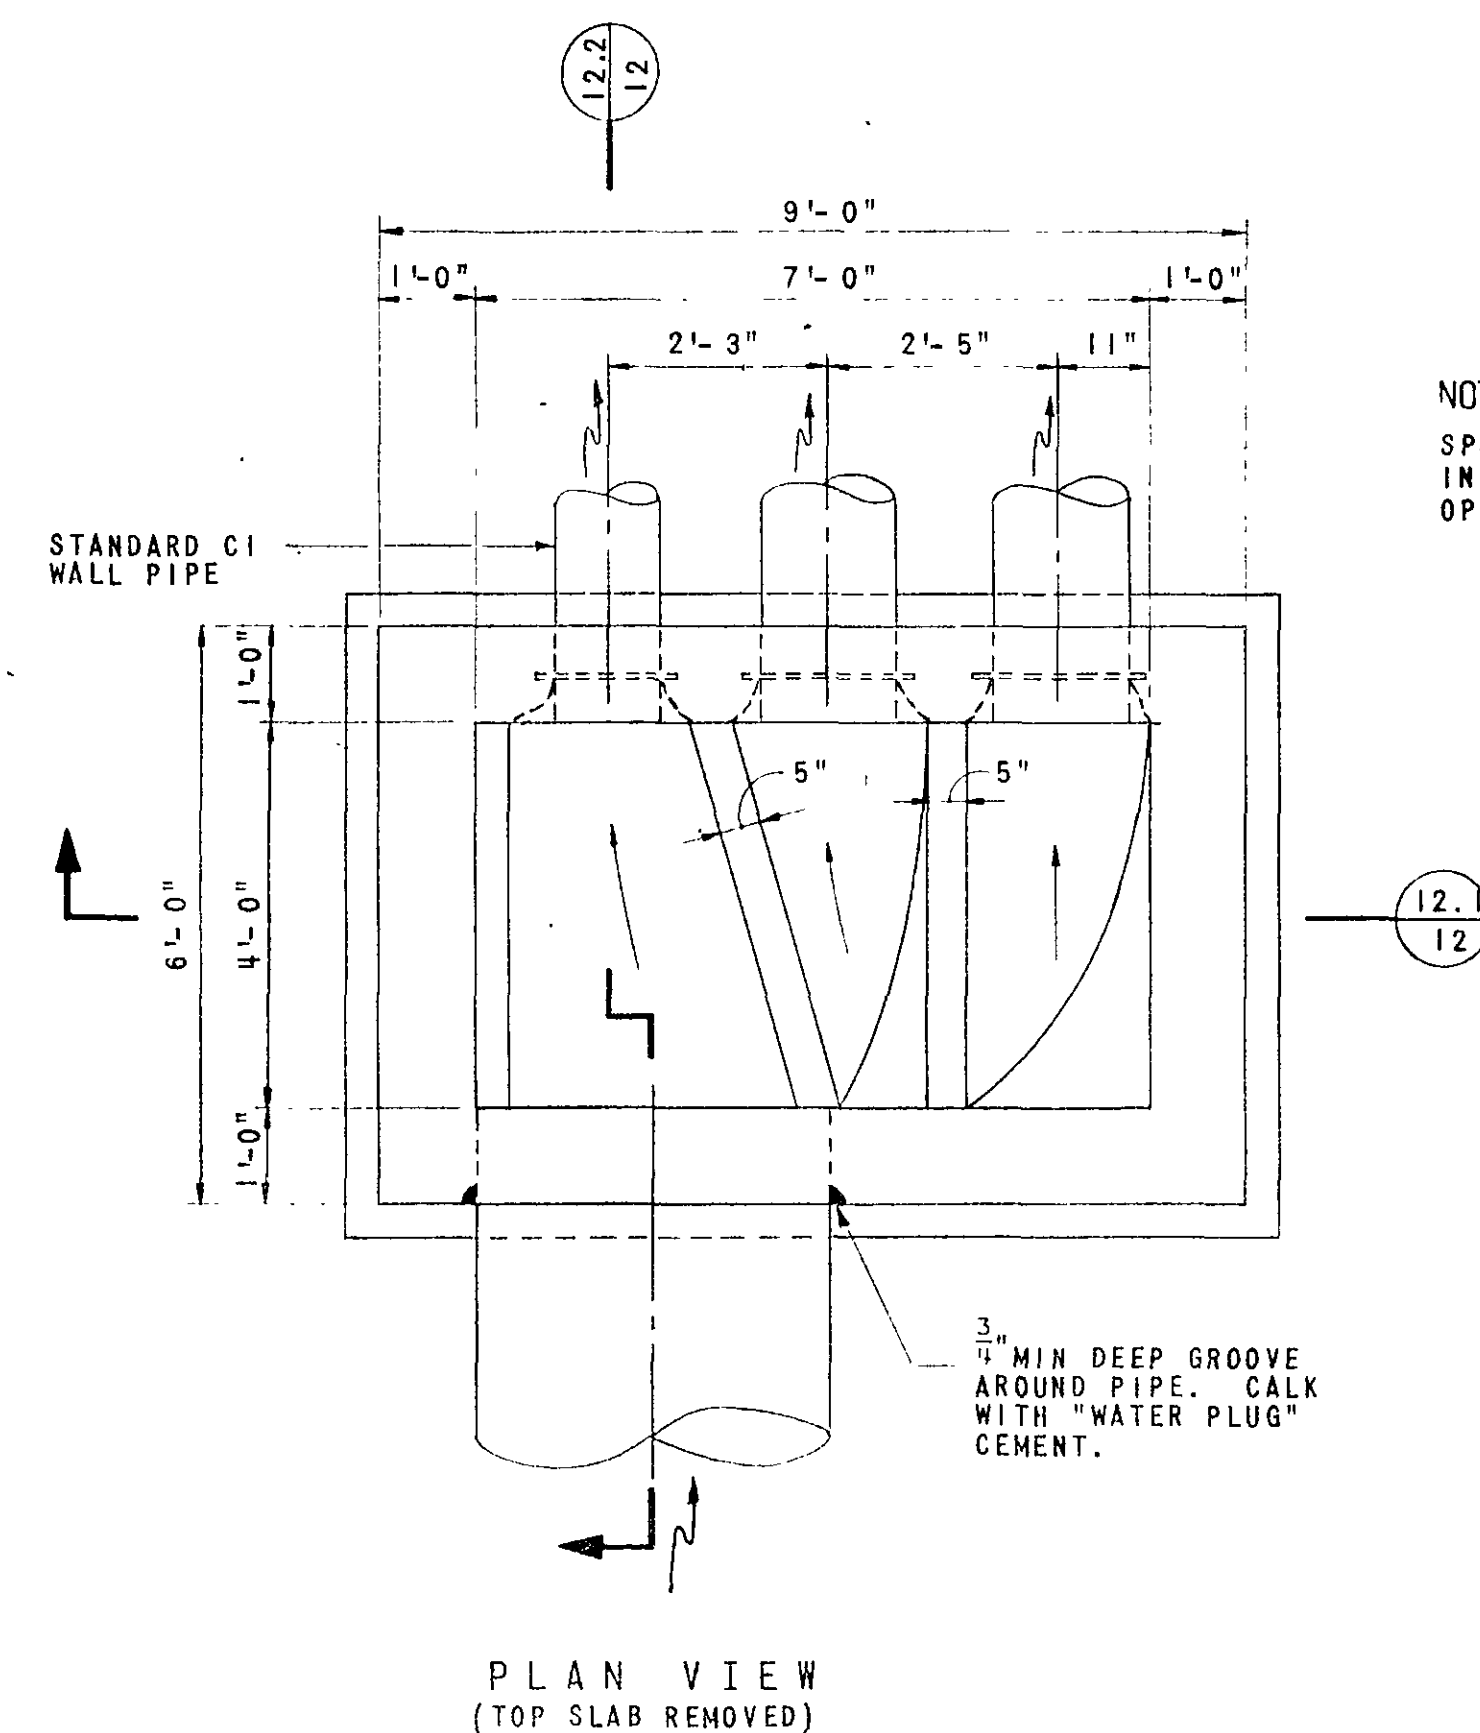
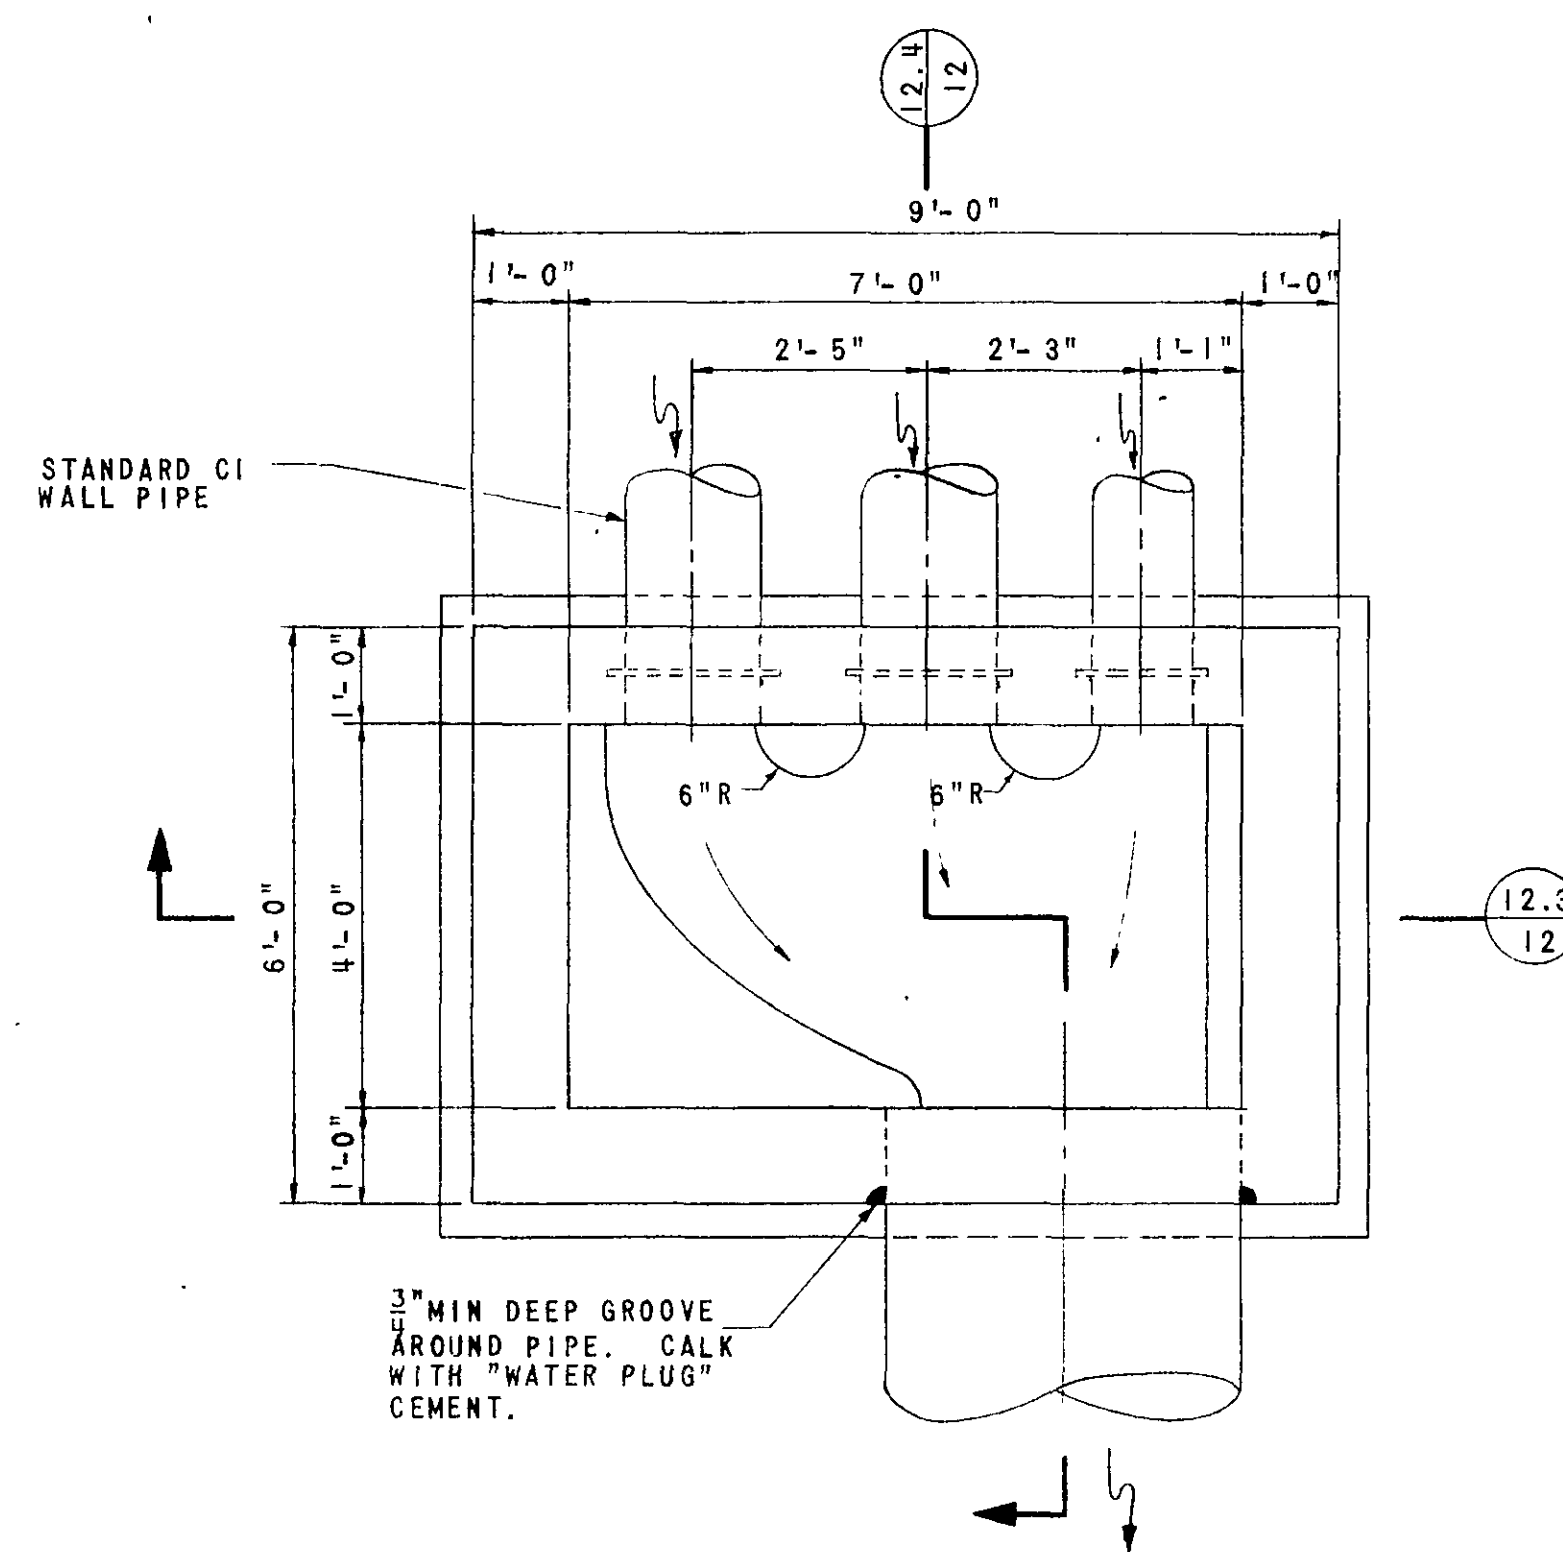


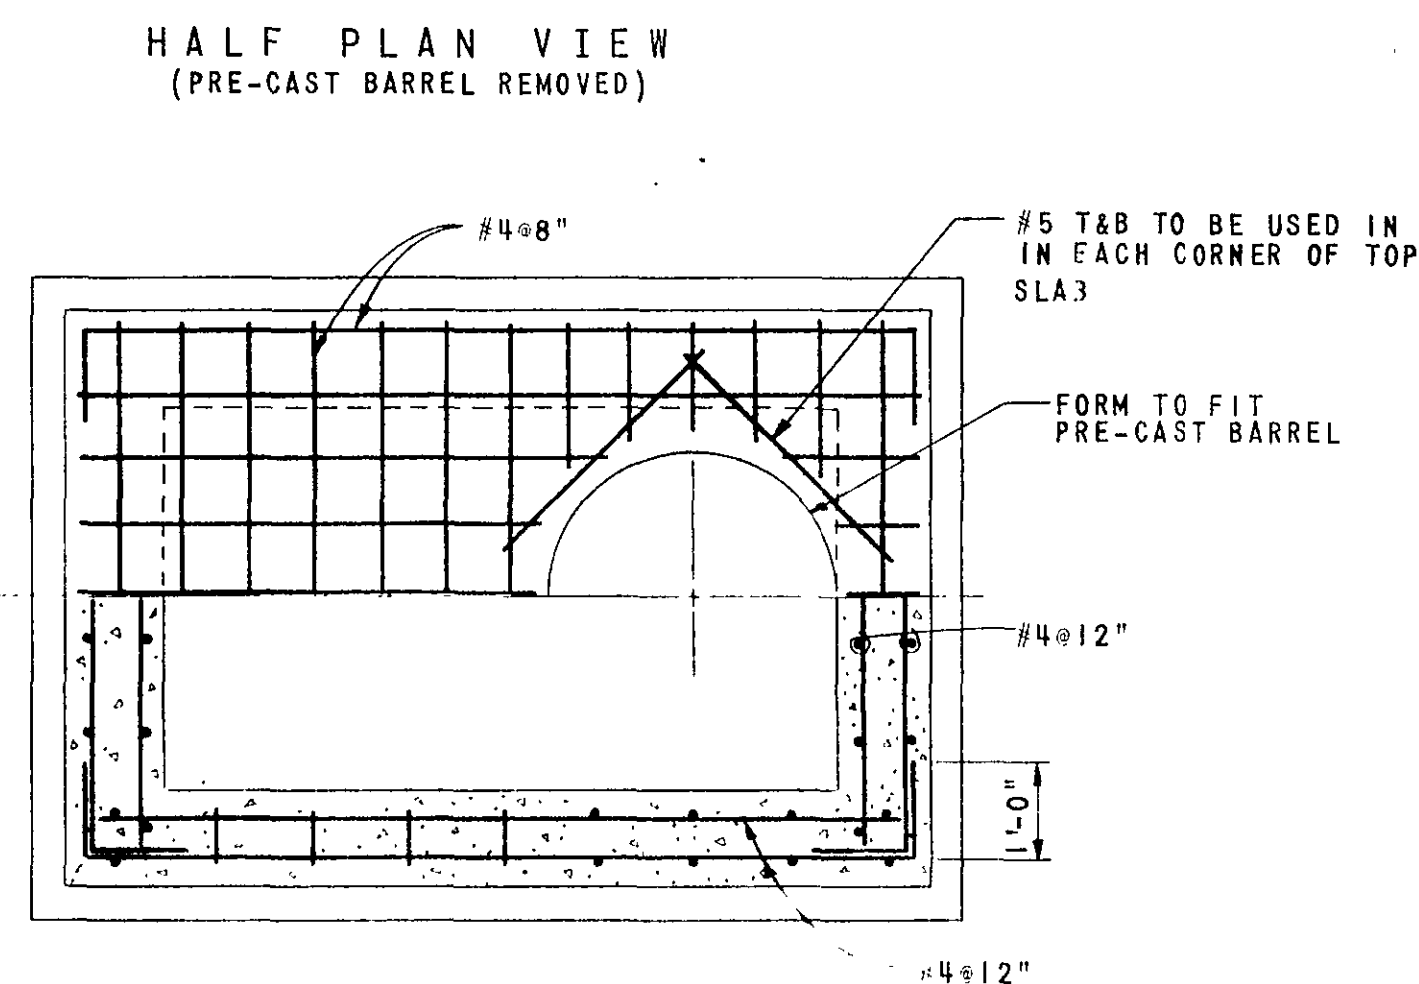



NOTE:
SPREAD BOTTOM REINF
IN TOP SLAB AROUND
OPENING. DO NOT CUT.

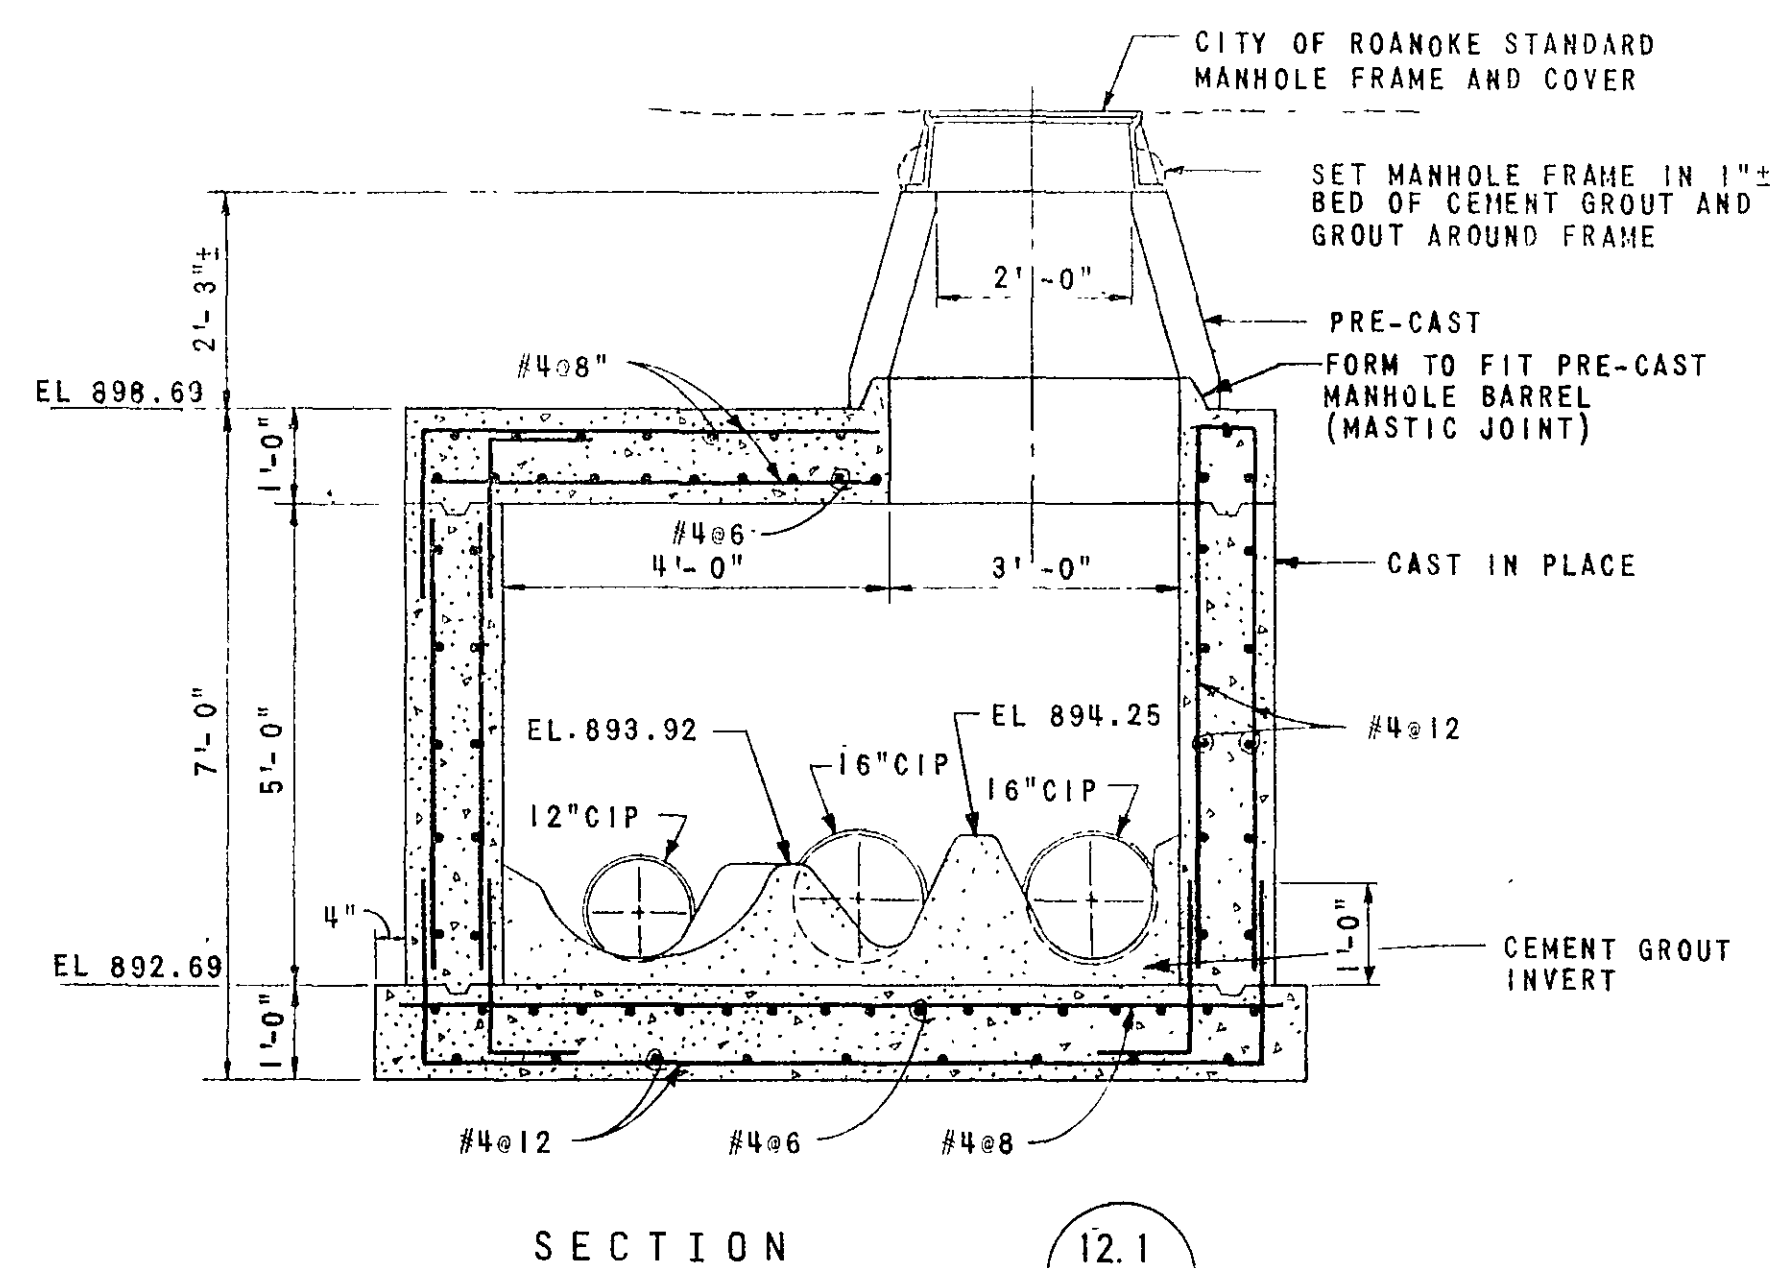


NOTE:
SPREAD BOTTOM REINF
IN TOP SLAB AROUND
OPENING. DO NOT CUT.

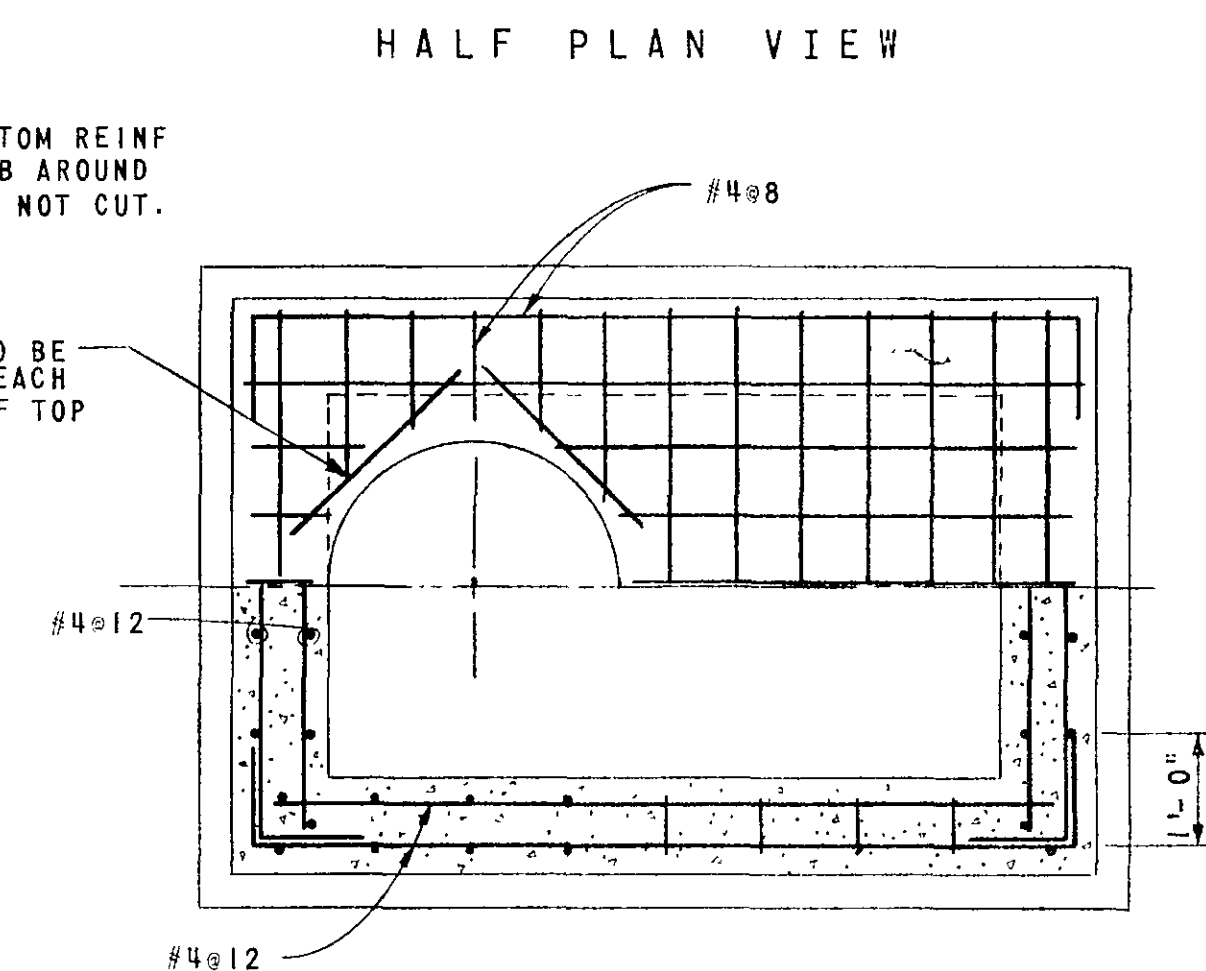

SIPHON NO. 1 INLET CHAMBER
SCALE: 1/2"=1'-0"

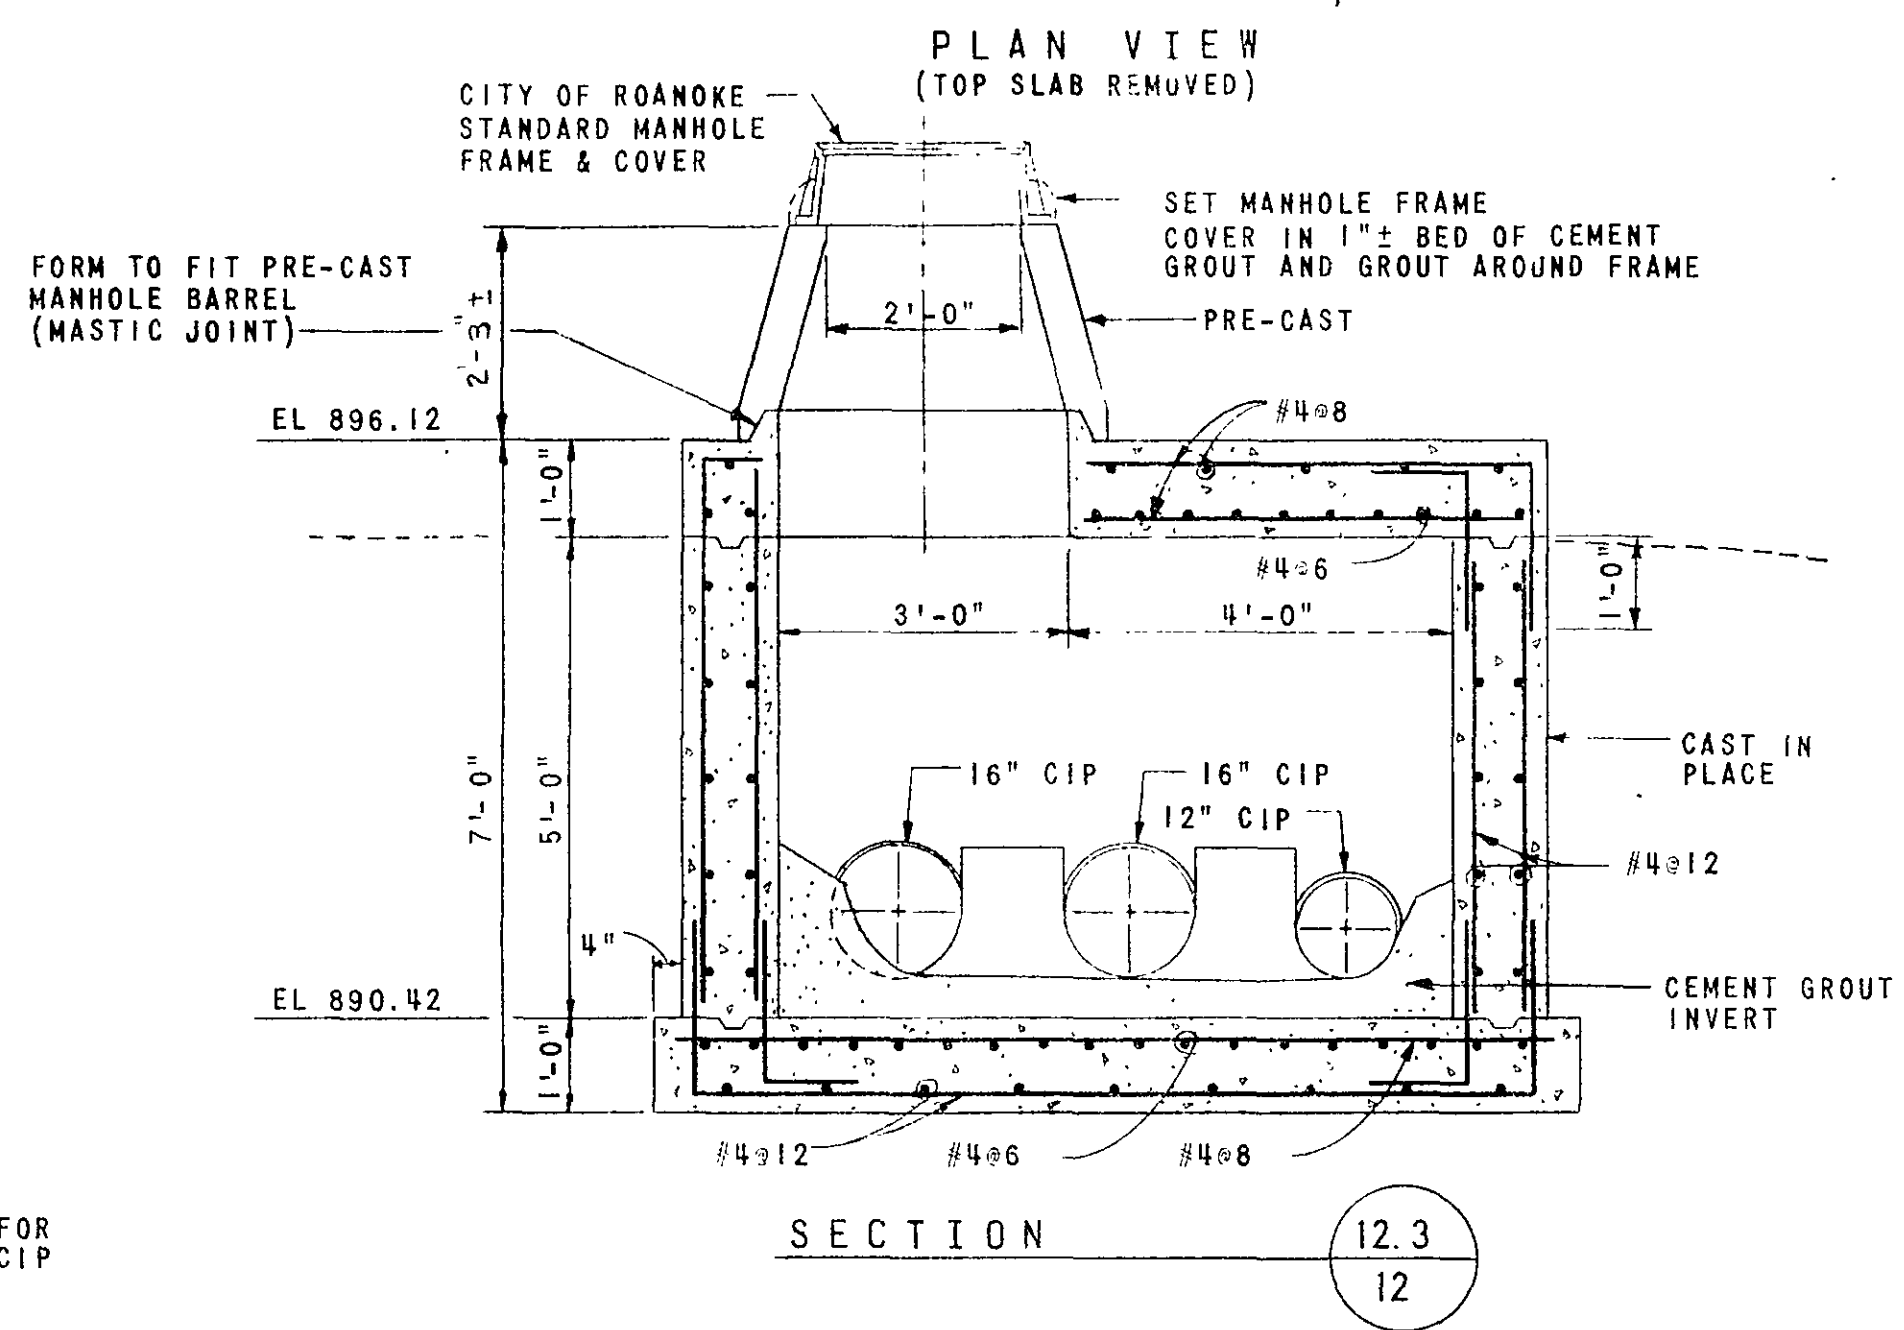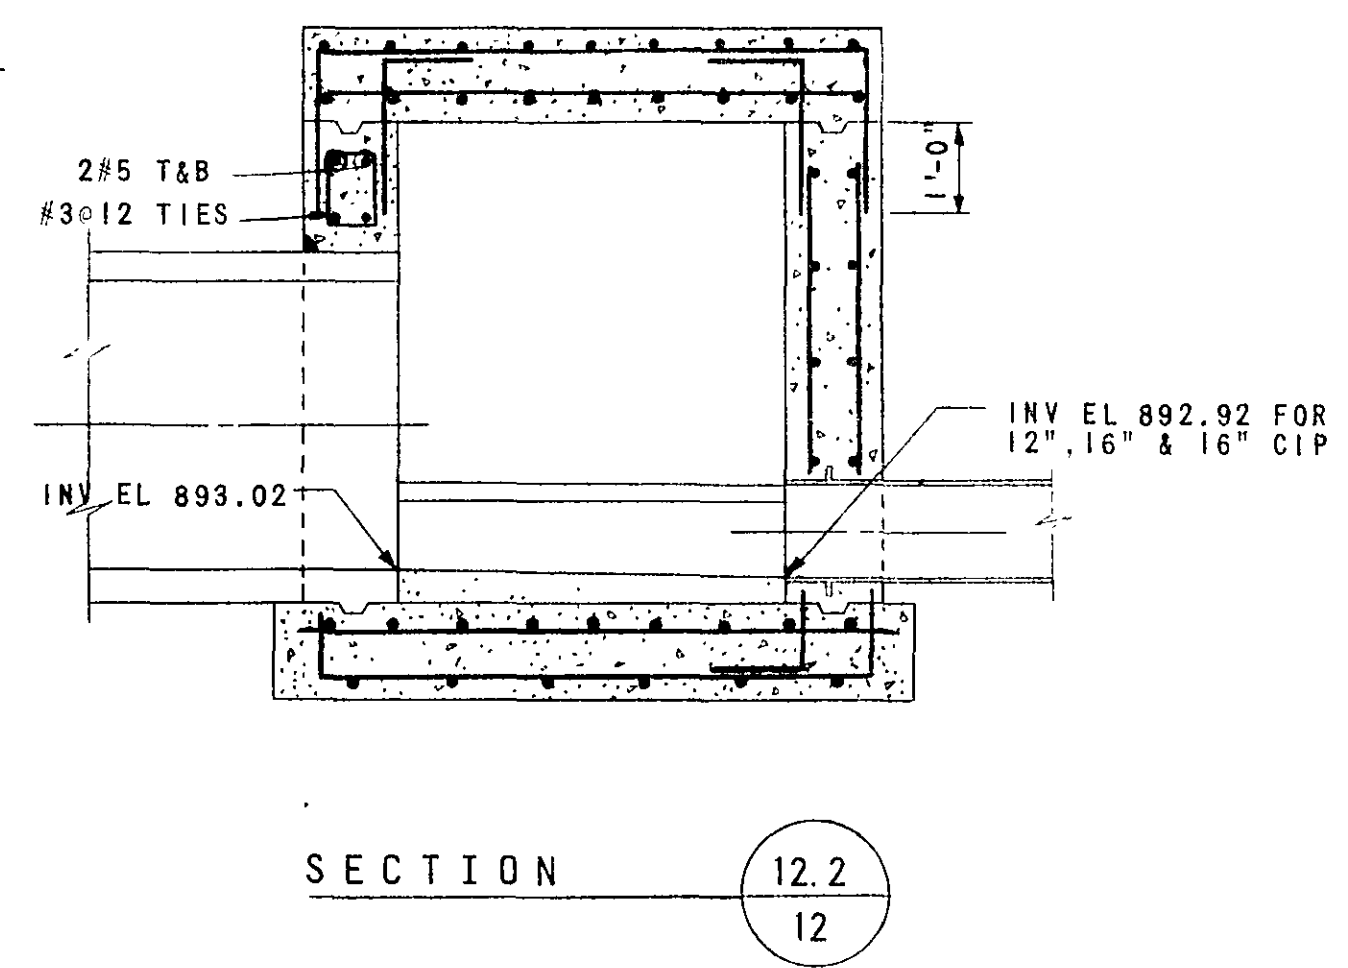

SIPHON NO. 1 OUTLET CHAMBER
SCALE: 1/2"=1'-0"

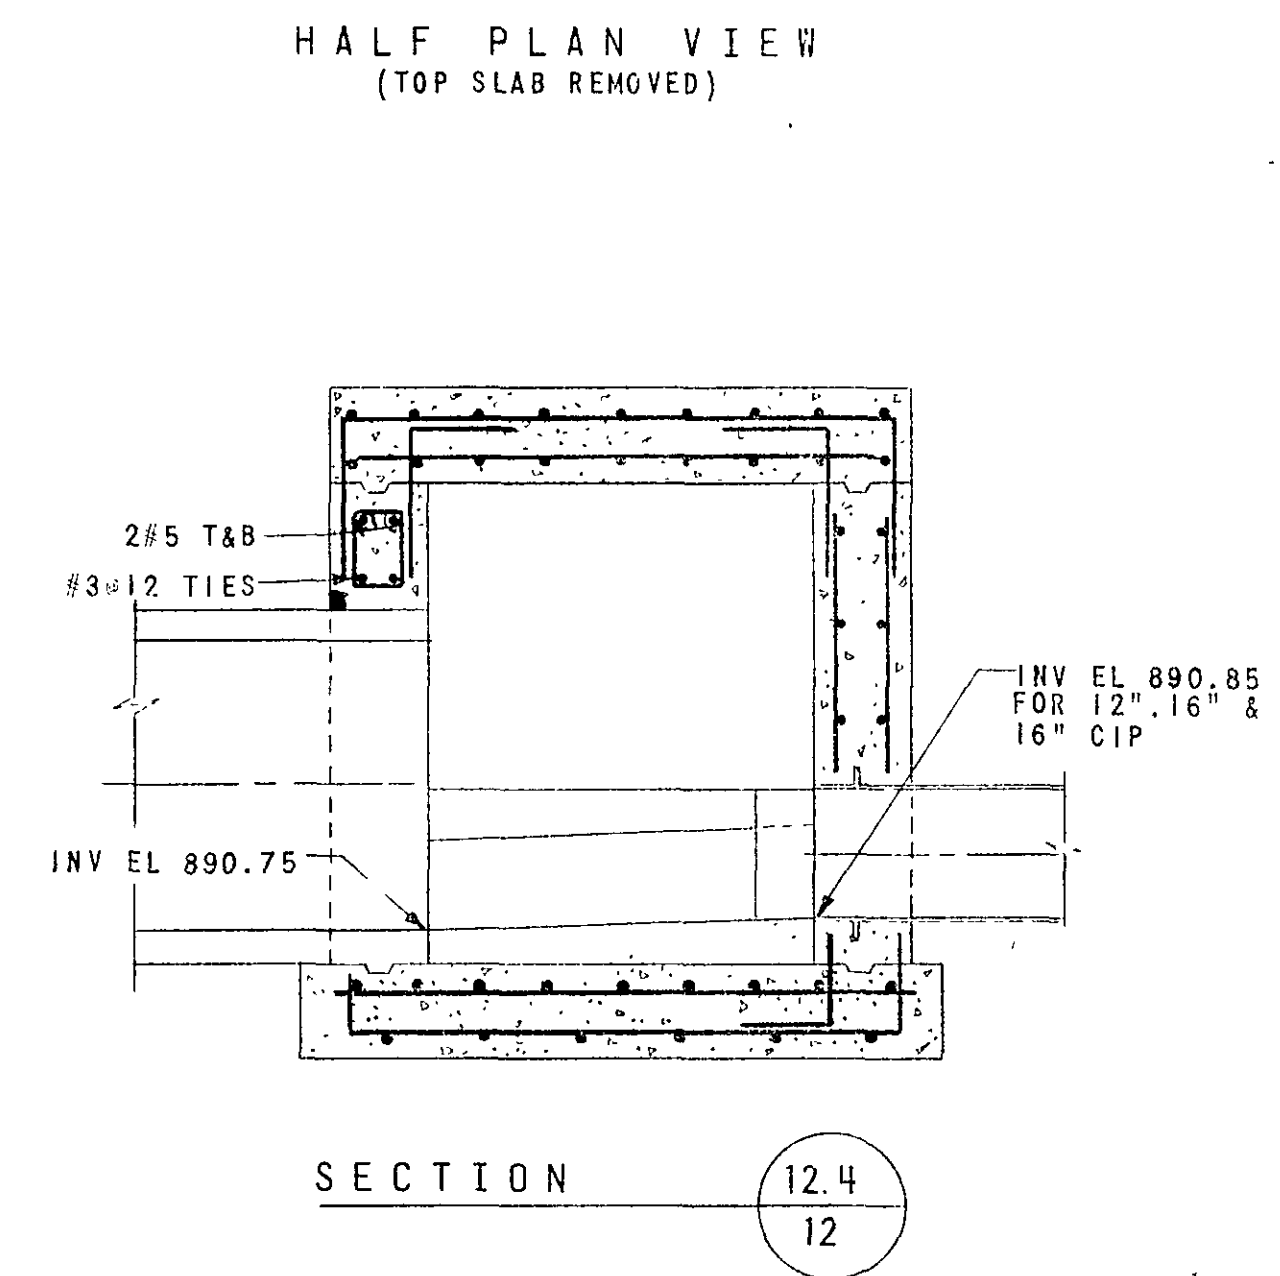

AS BUILT

DIVISION I				
1	6-21-71	AS BUILT	DMC	JHR
REVISION	DATE	DESCRIPTION	BY	APP.
DESIGNED	RAK	INTERCEPTOR SEWERS PROJECT NO. 1 TINKER CREEK DETAILS		
DRAWN	JT			
CHECKED	MR			
APPROVED	JMD			
SUBMITTED	GOB			
		CITY OF ROANOKE	VIRGINIA	
HAYES, SEAY, MATTERN & MATTERN ARCHITECTS — ENGINEERS			SCALE AS SHOWN	COMM. NO. 3262
			DATE DEC. 1967	SHEET 12 OF 18