



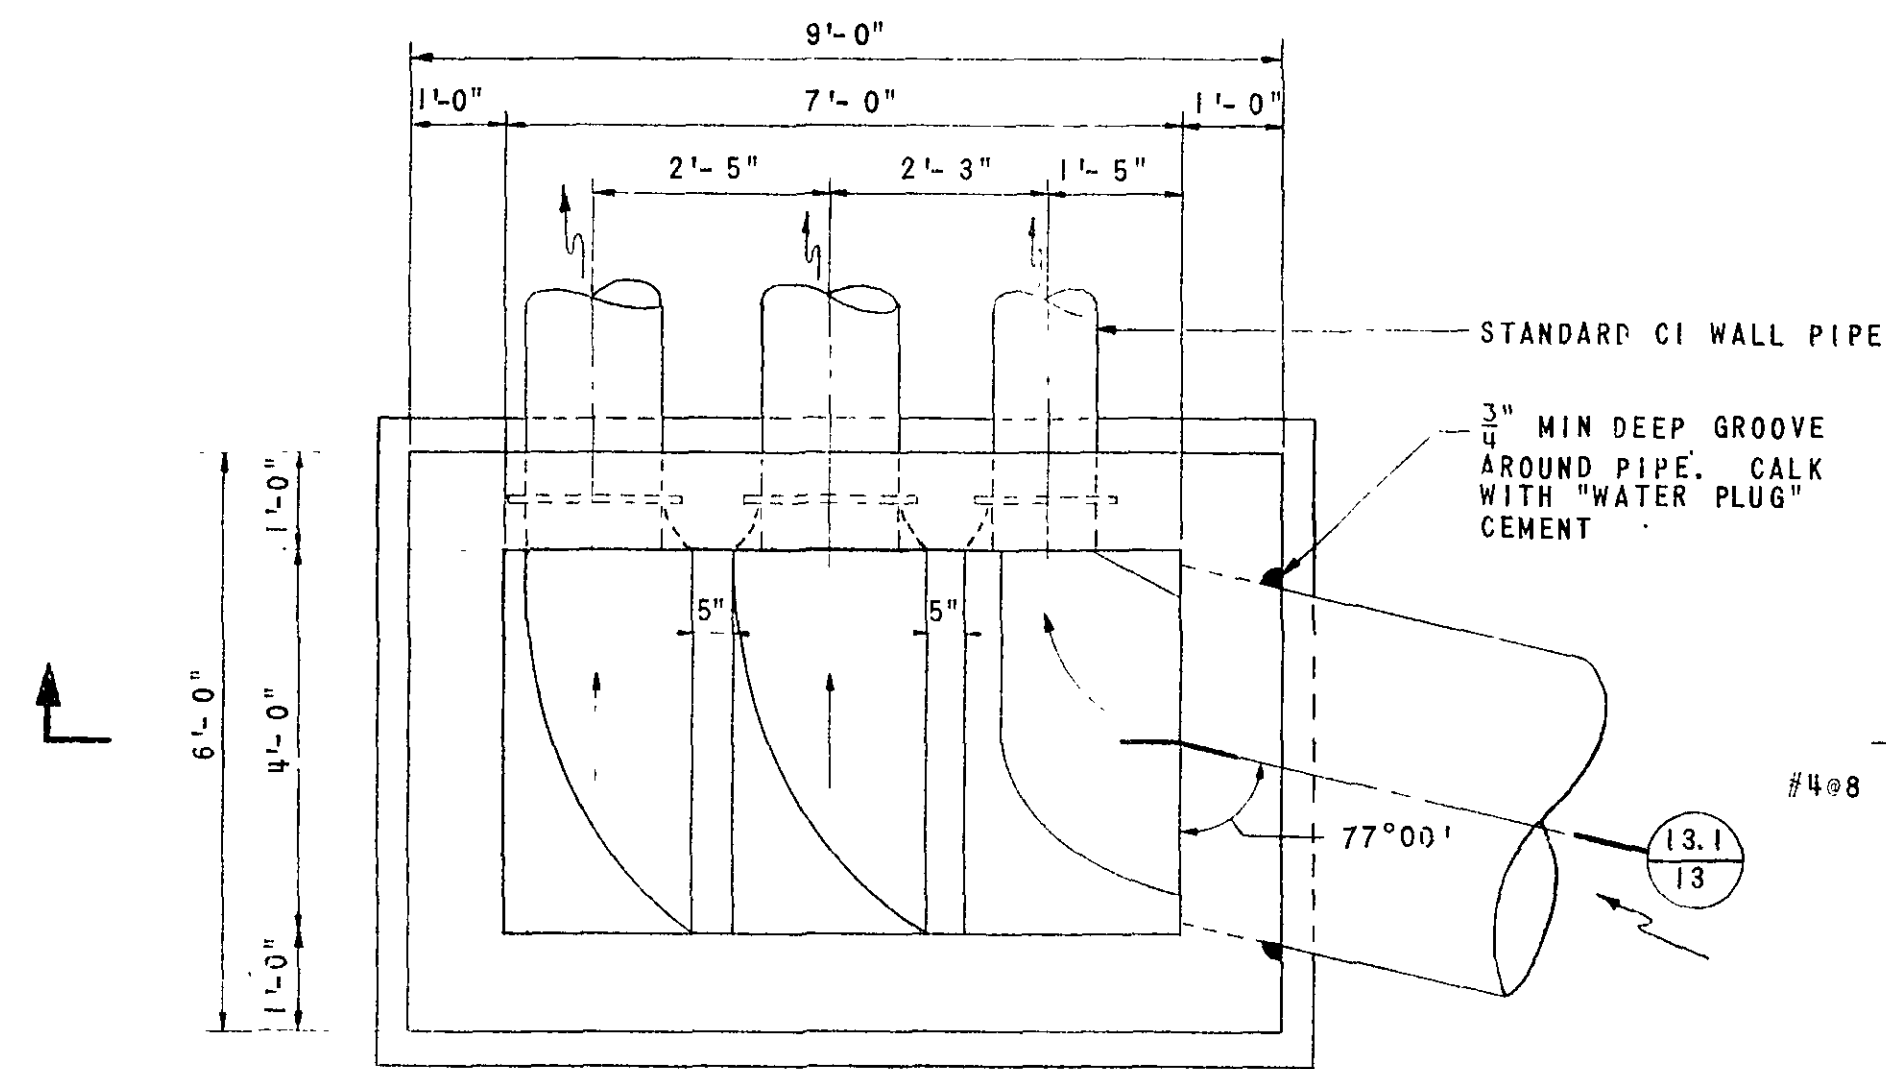

NOTE:  
SPREAD BOTTOM REINF  
IN TOP SLAB AROUND  
OPENING. DO NOT CUT.

PLAN VIEW  
(TOP SLAB REMOVED)

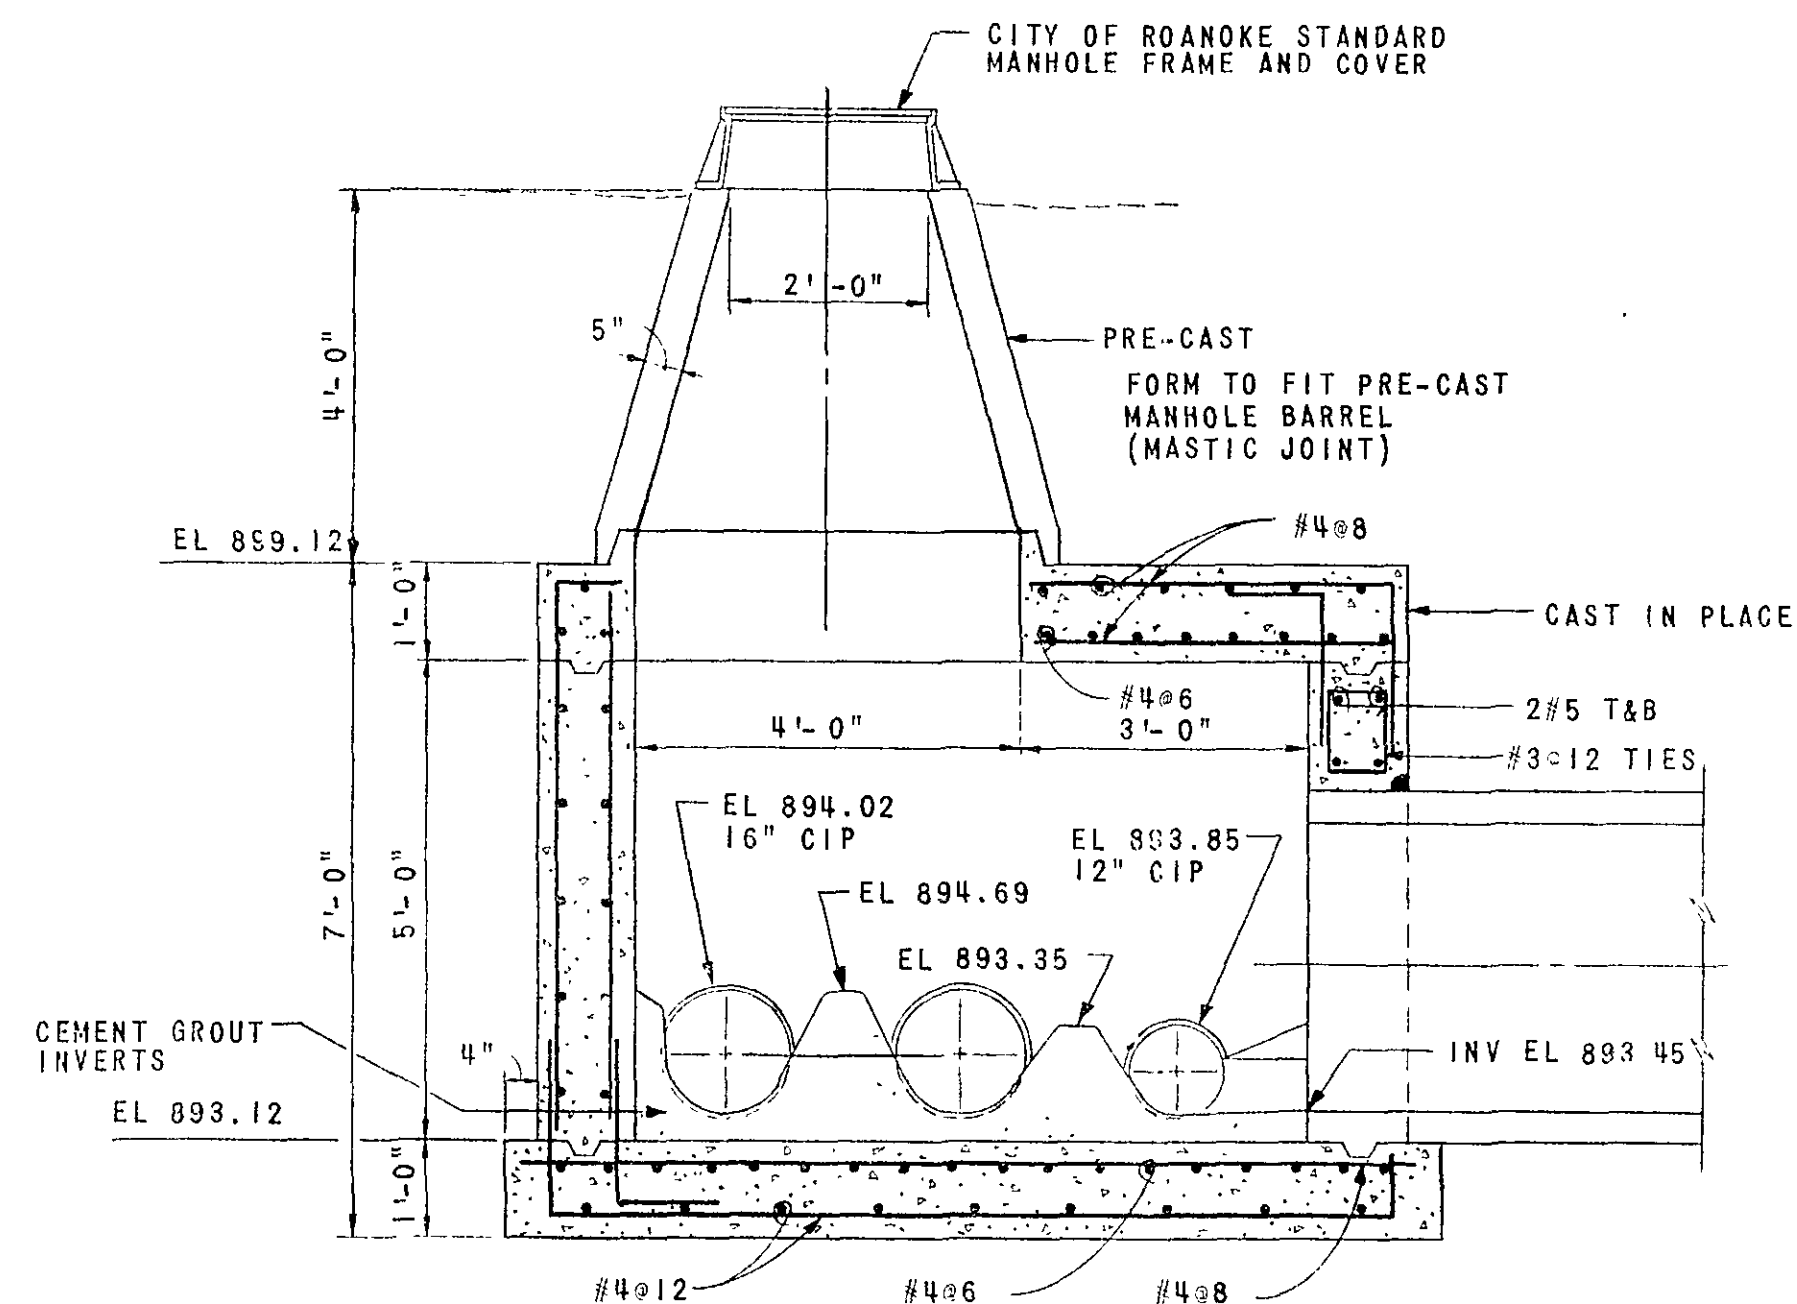


SECTION

13.1  
13


SIPHON NO. 1A INLET CHAMBER

SCALE:  $\frac{1}{2}'' = 1'-0''$

HALF PLAN VIEW  
(PRE-CAST BARREL REMOVED)

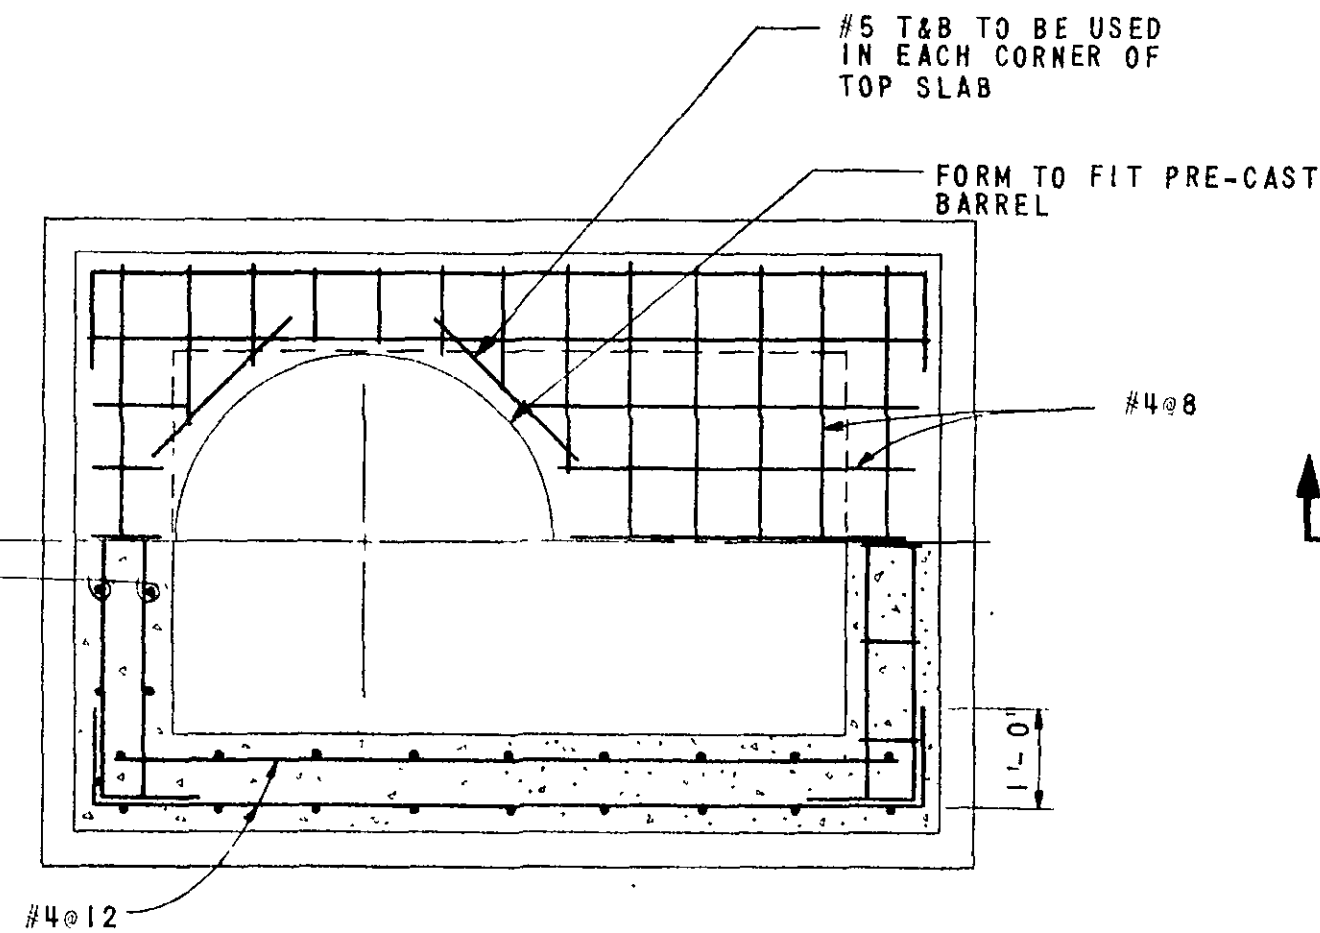


HALF PLAN VIEW  
(TOP SLAB REMOVED)

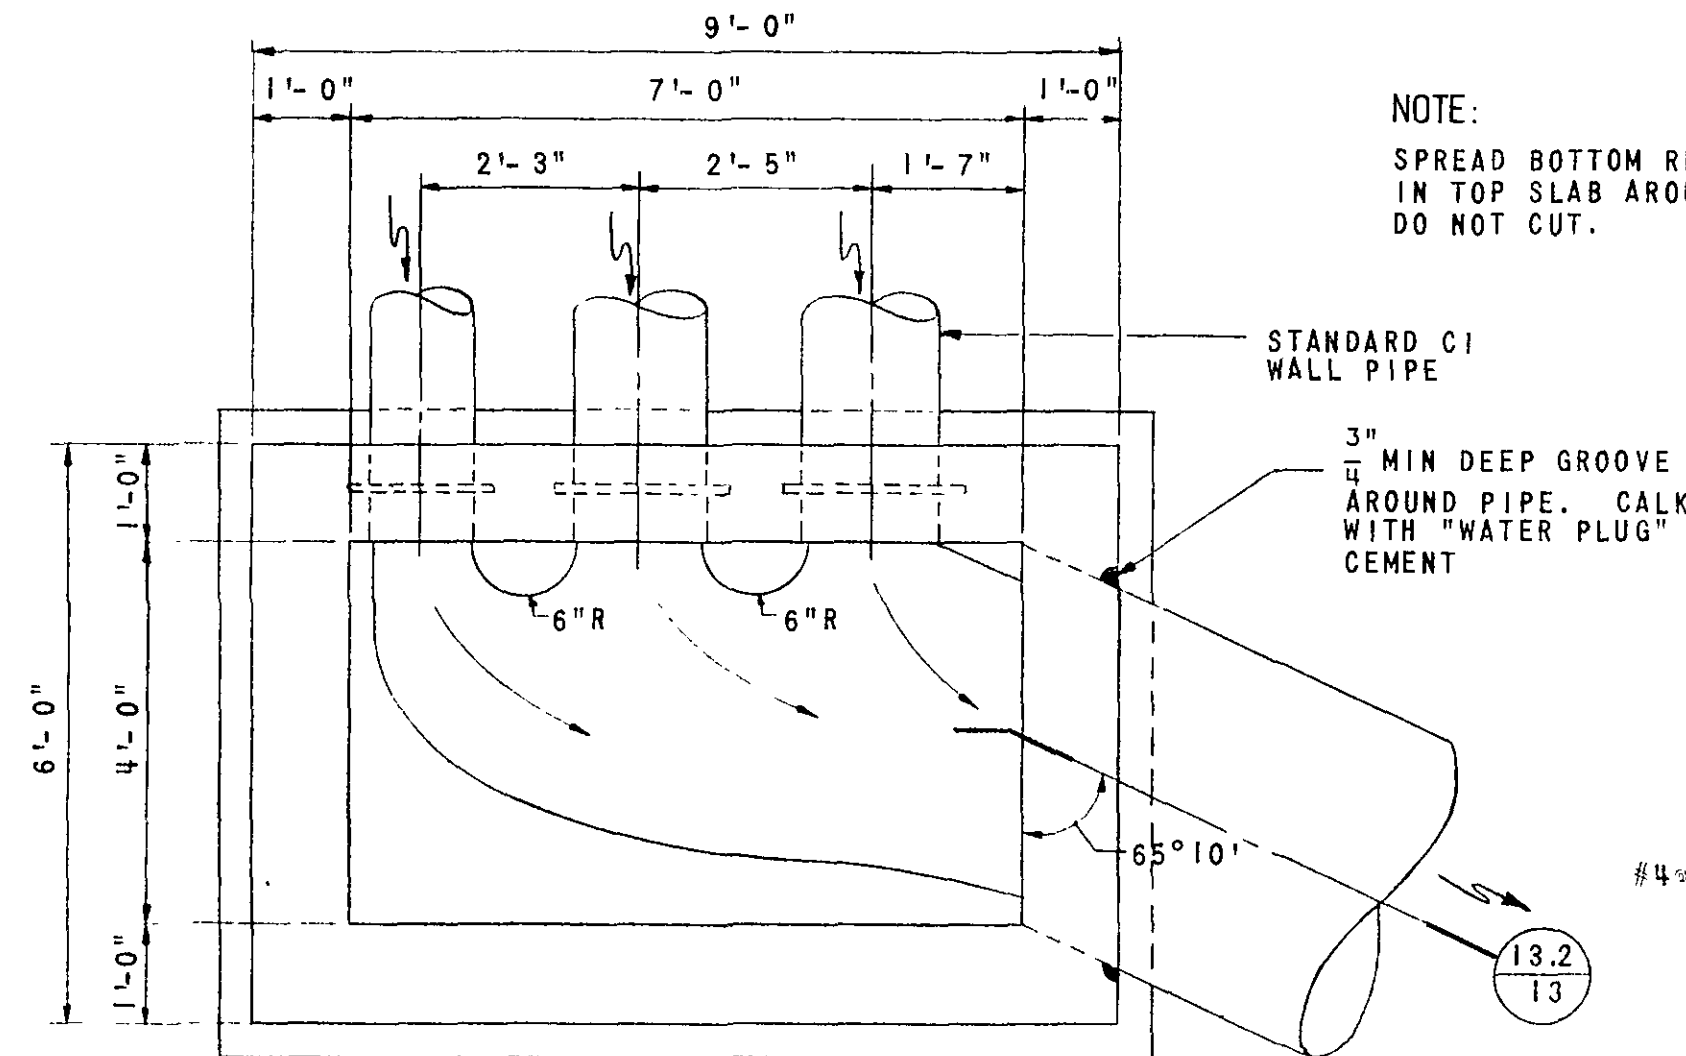

NOTE:  
SPREAD BOTTOM REINF  
IN TOP SLAB AROUND  
OPENING. DO NOT CUT.

PLAN VIEW  
(TOP SLAB REMOVED)

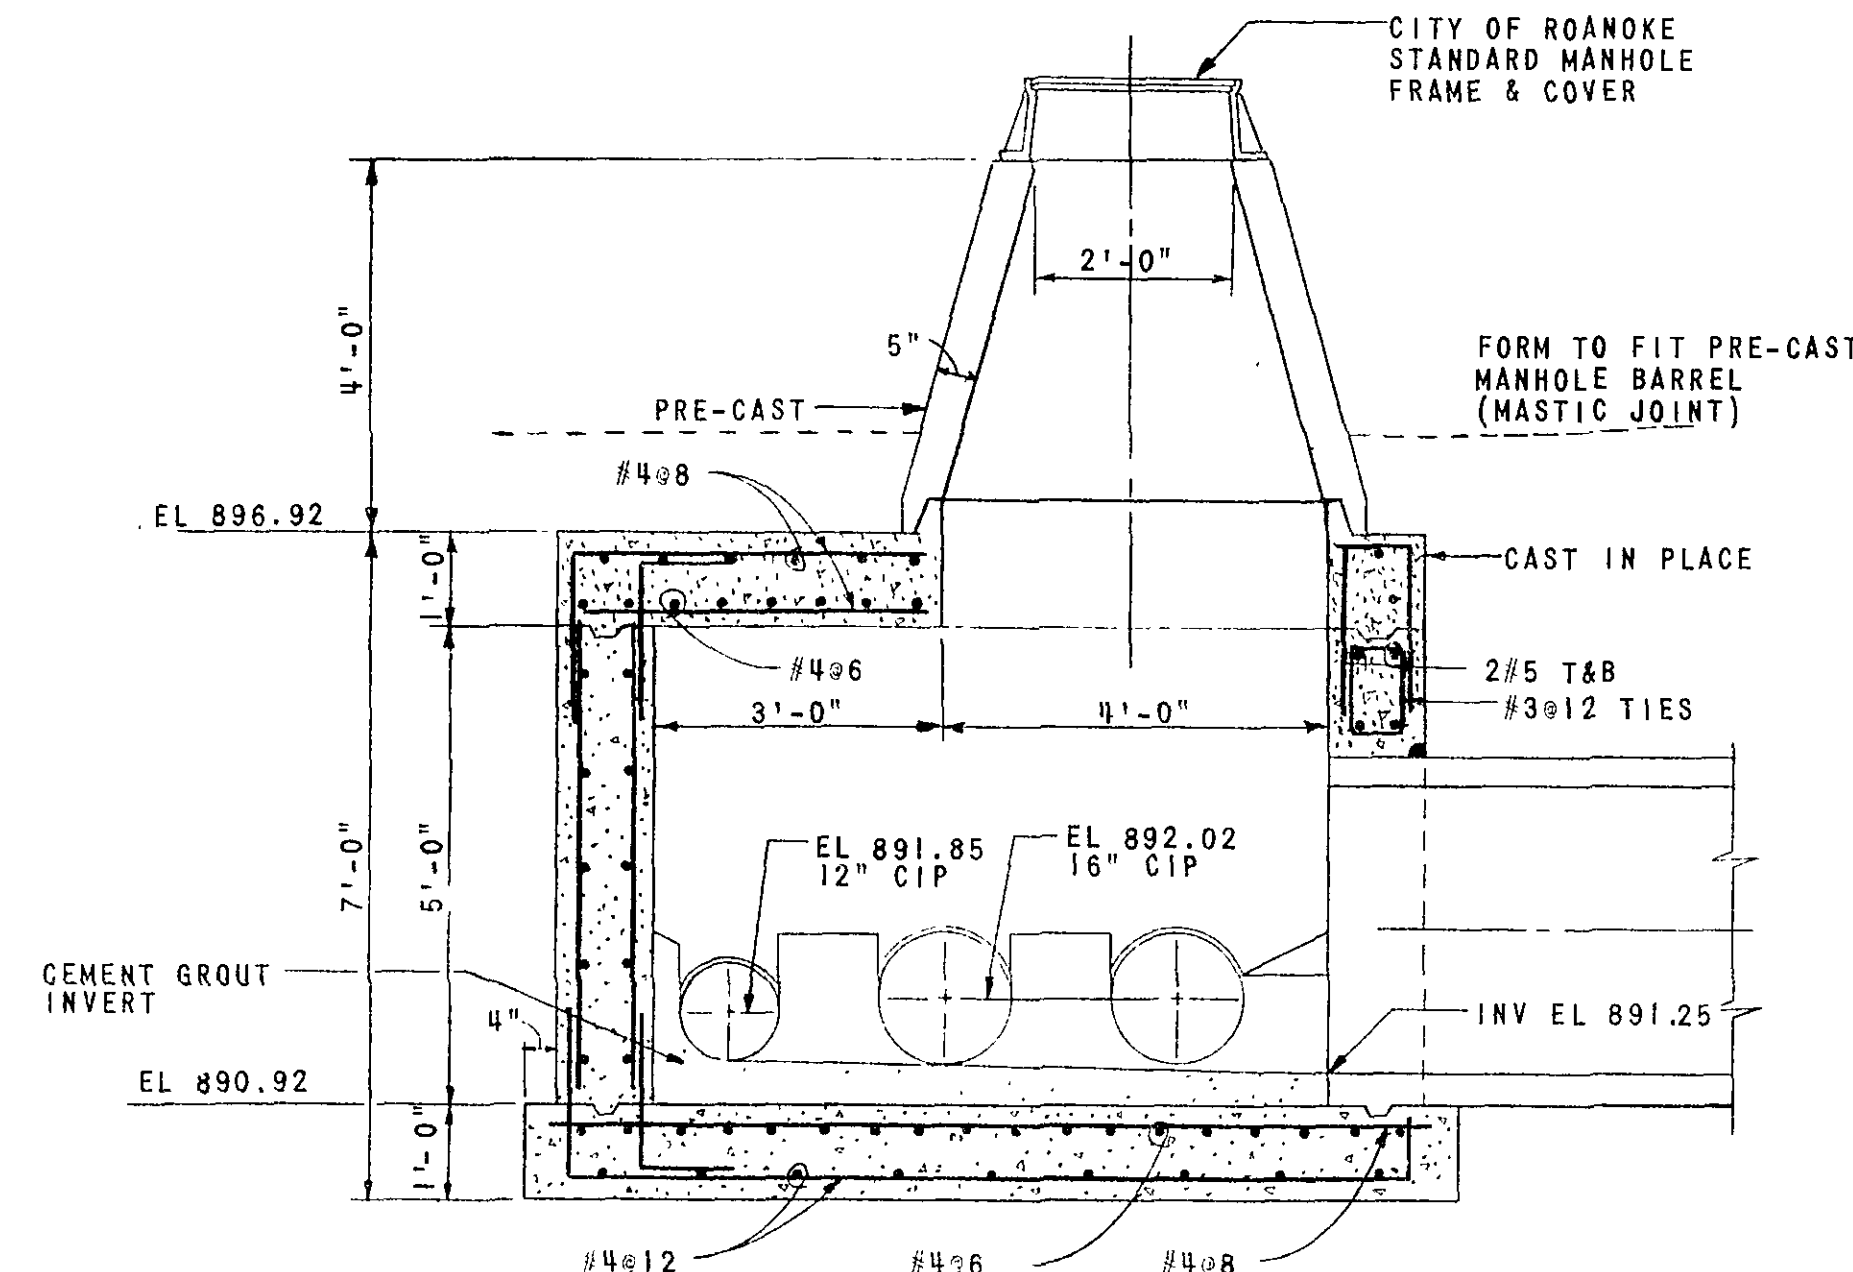


SECTION

13.2  
13

SIPHON NO. 1A OUTLET CHAMBER

SCALE:  $\frac{1}{2}'' = 1'-0''$

HALF PLAN VIEW

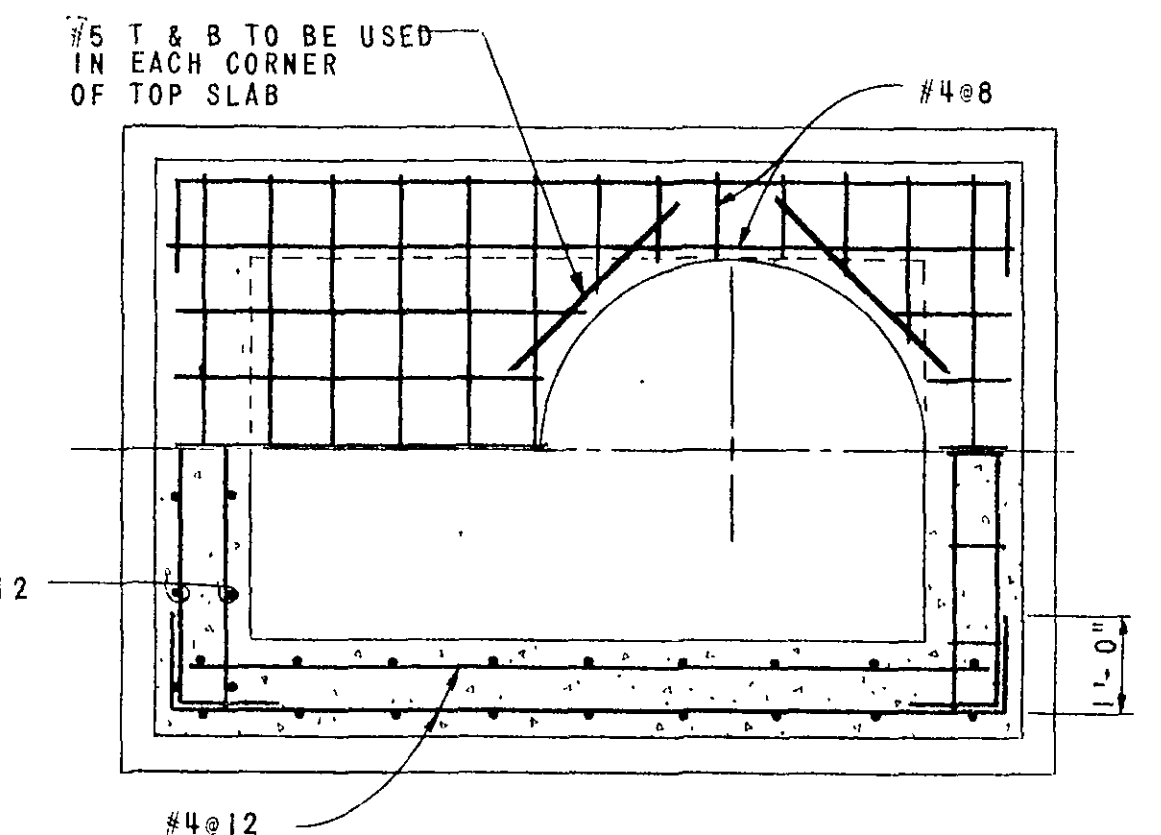

HALF PLAN VIEW  
(TOP SLAB REMOVED)

**AS BUILT**

| DIVISION I                                             |         |                                                                    |                |
|--------------------------------------------------------|---------|--------------------------------------------------------------------|----------------|
| REVISION                                               | DATE    | DESCRIPTION                                                        | BY             |
| 1                                                      | 6-21-71 | AS BUILT                                                           | DMC JHR        |
| DESIGNED                                               | ROD     | INTERCEPTOR SEWERS<br>PROJECT NO. 1<br><br>TINKER CREEK<br>DETAILS |                |
| DRAWN                                                  | JT      |                                                                    |                |
| CHECKED                                                | ML      |                                                                    |                |
| APPROVED                                               | ML      |                                                                    |                |
| SUBMITTED                                              | COB     | CITY OF ROANOKE VIRGINIA                                           |                |
| HAYES, SEAY, MATTERN & MATTERN<br>ARCHITECTS-ENGINEERS |         | SCALE AS SHOWN                                                     | COMM. NO. 3262 |
|                                                        |         | DATE DEC. 1967                                                     | SHEET 13 OF 18 |