




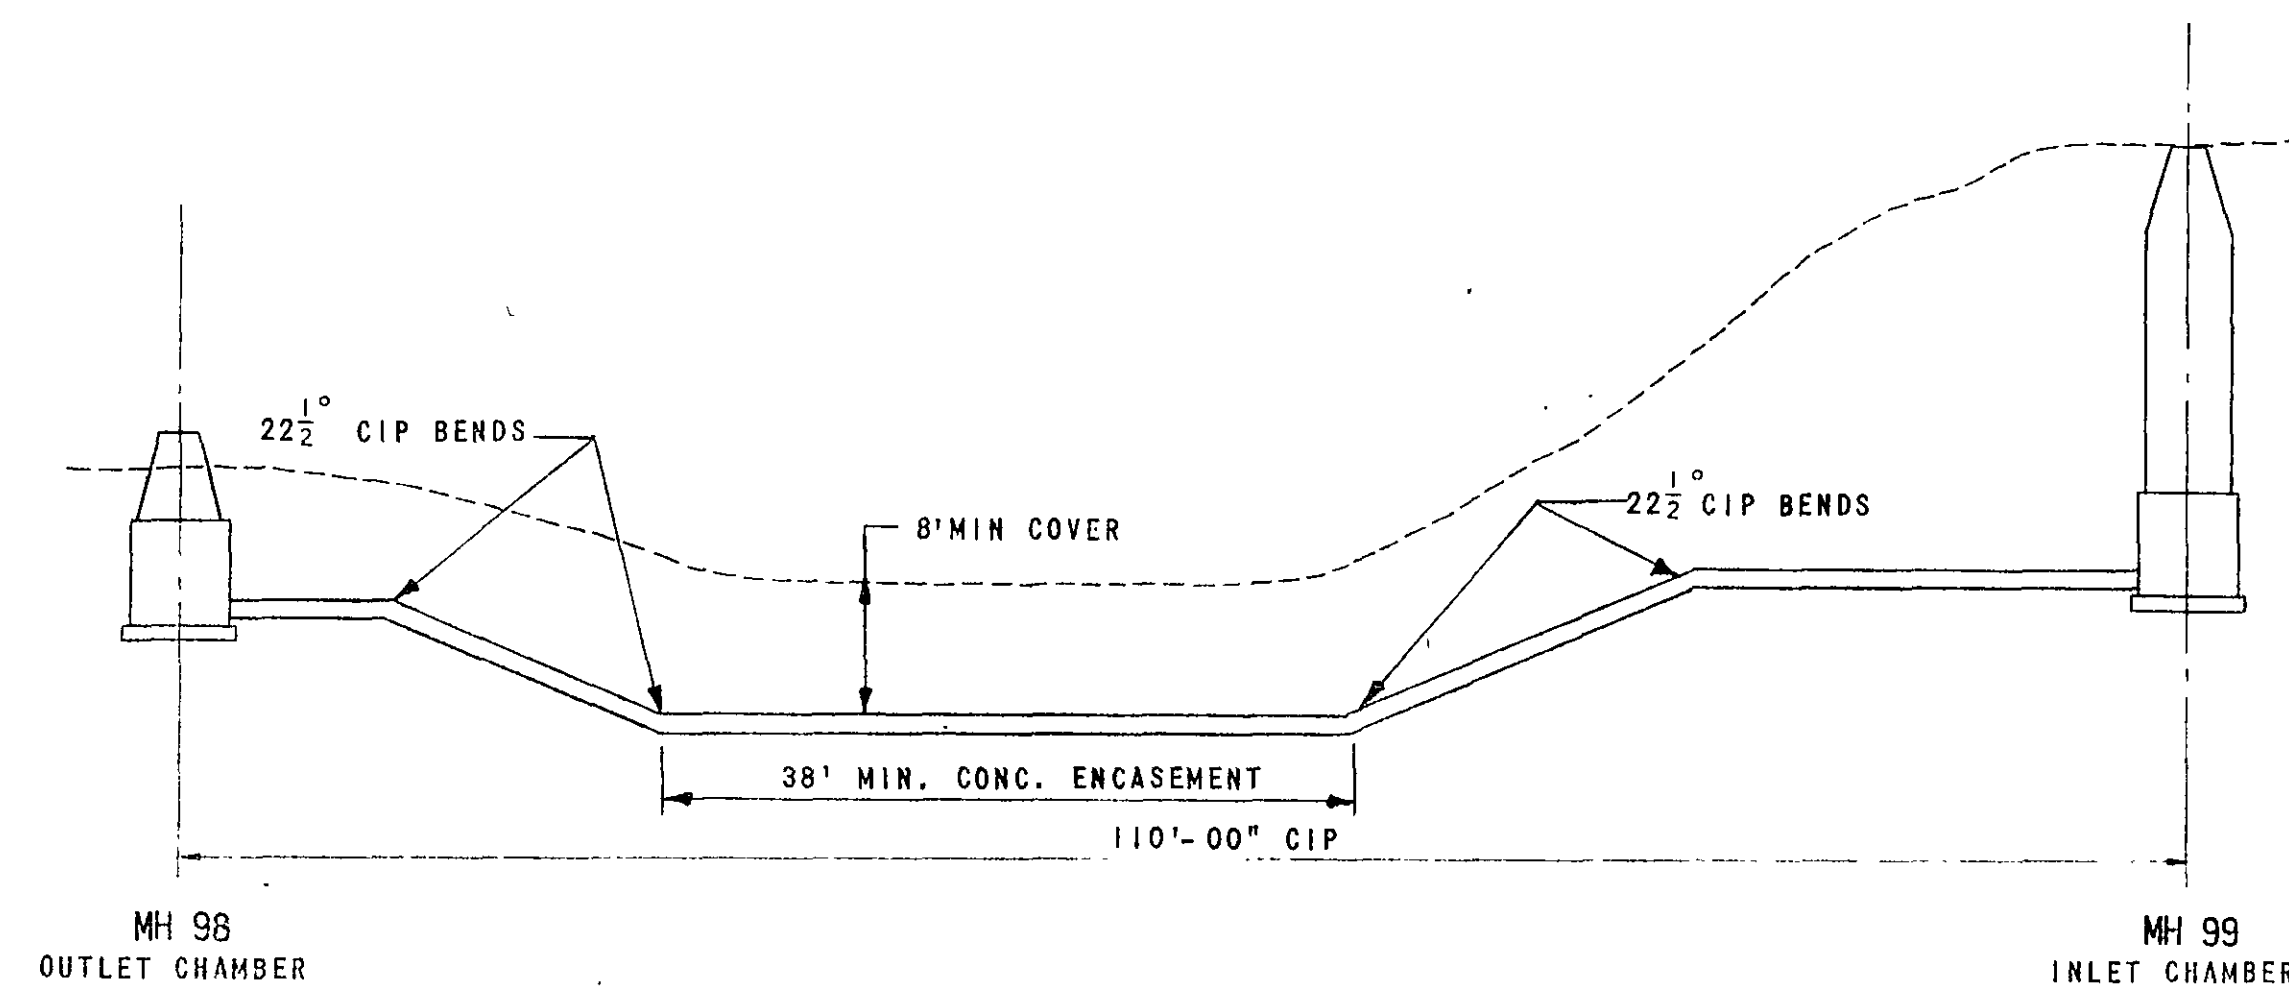




SIPHON NO. 2
SCALE: $\frac{3}{32} = 1' = 0"$

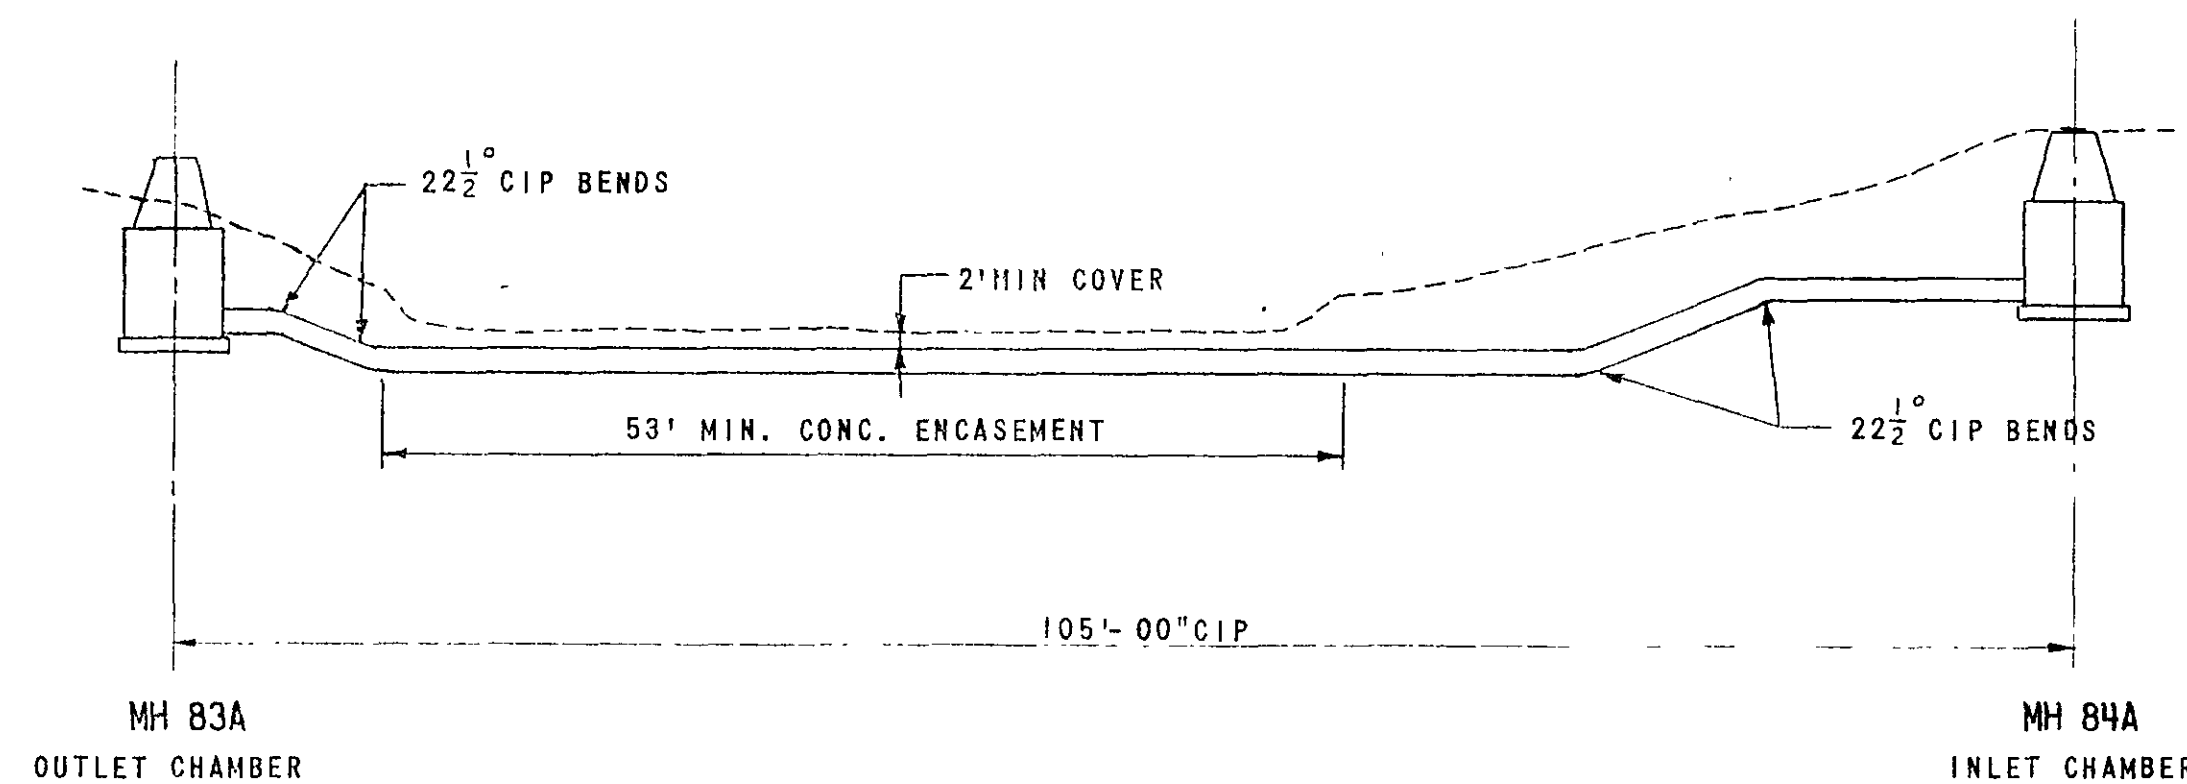

SIPHON NO. 1A
SCALE: $\frac{3}{32} = 1' = 0"$

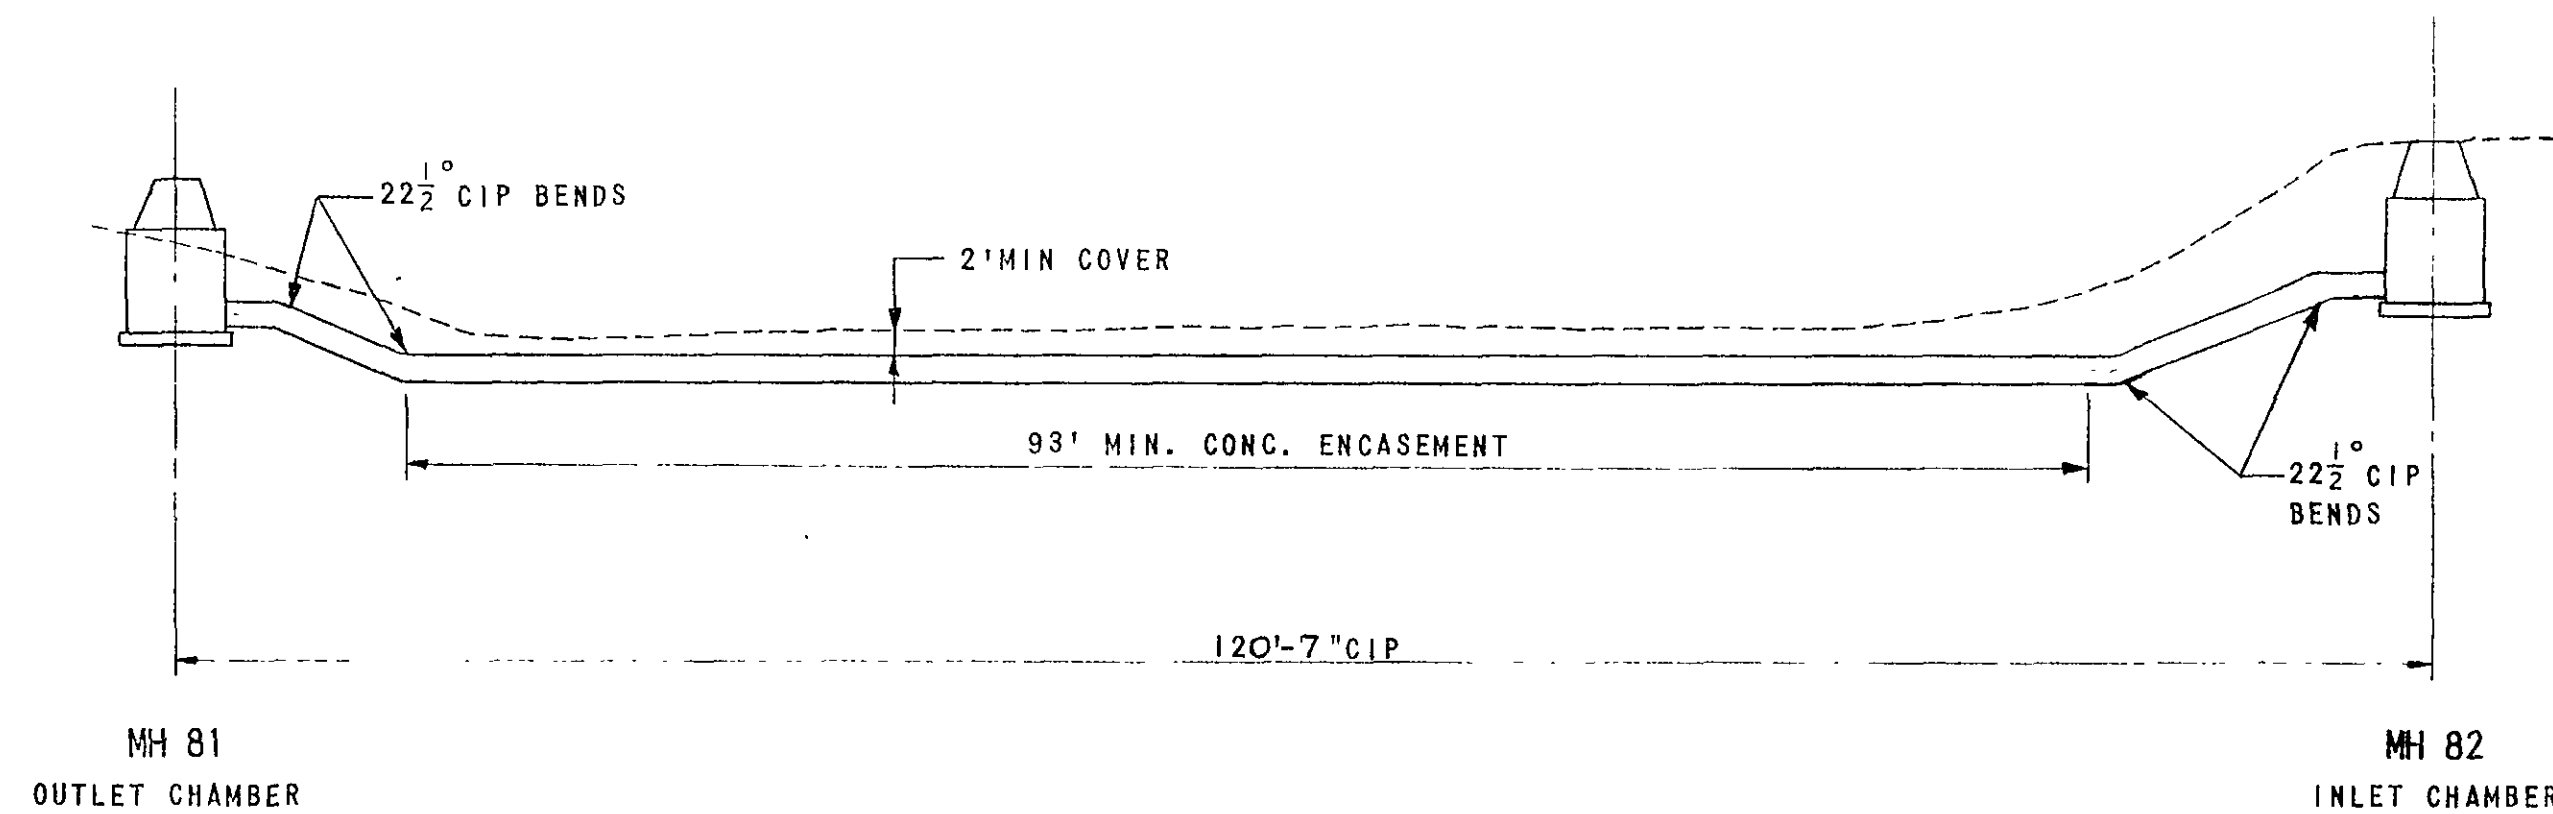

SIPHON NO. 1
SCALE: $\frac{3}{32} = 1' = 0"$

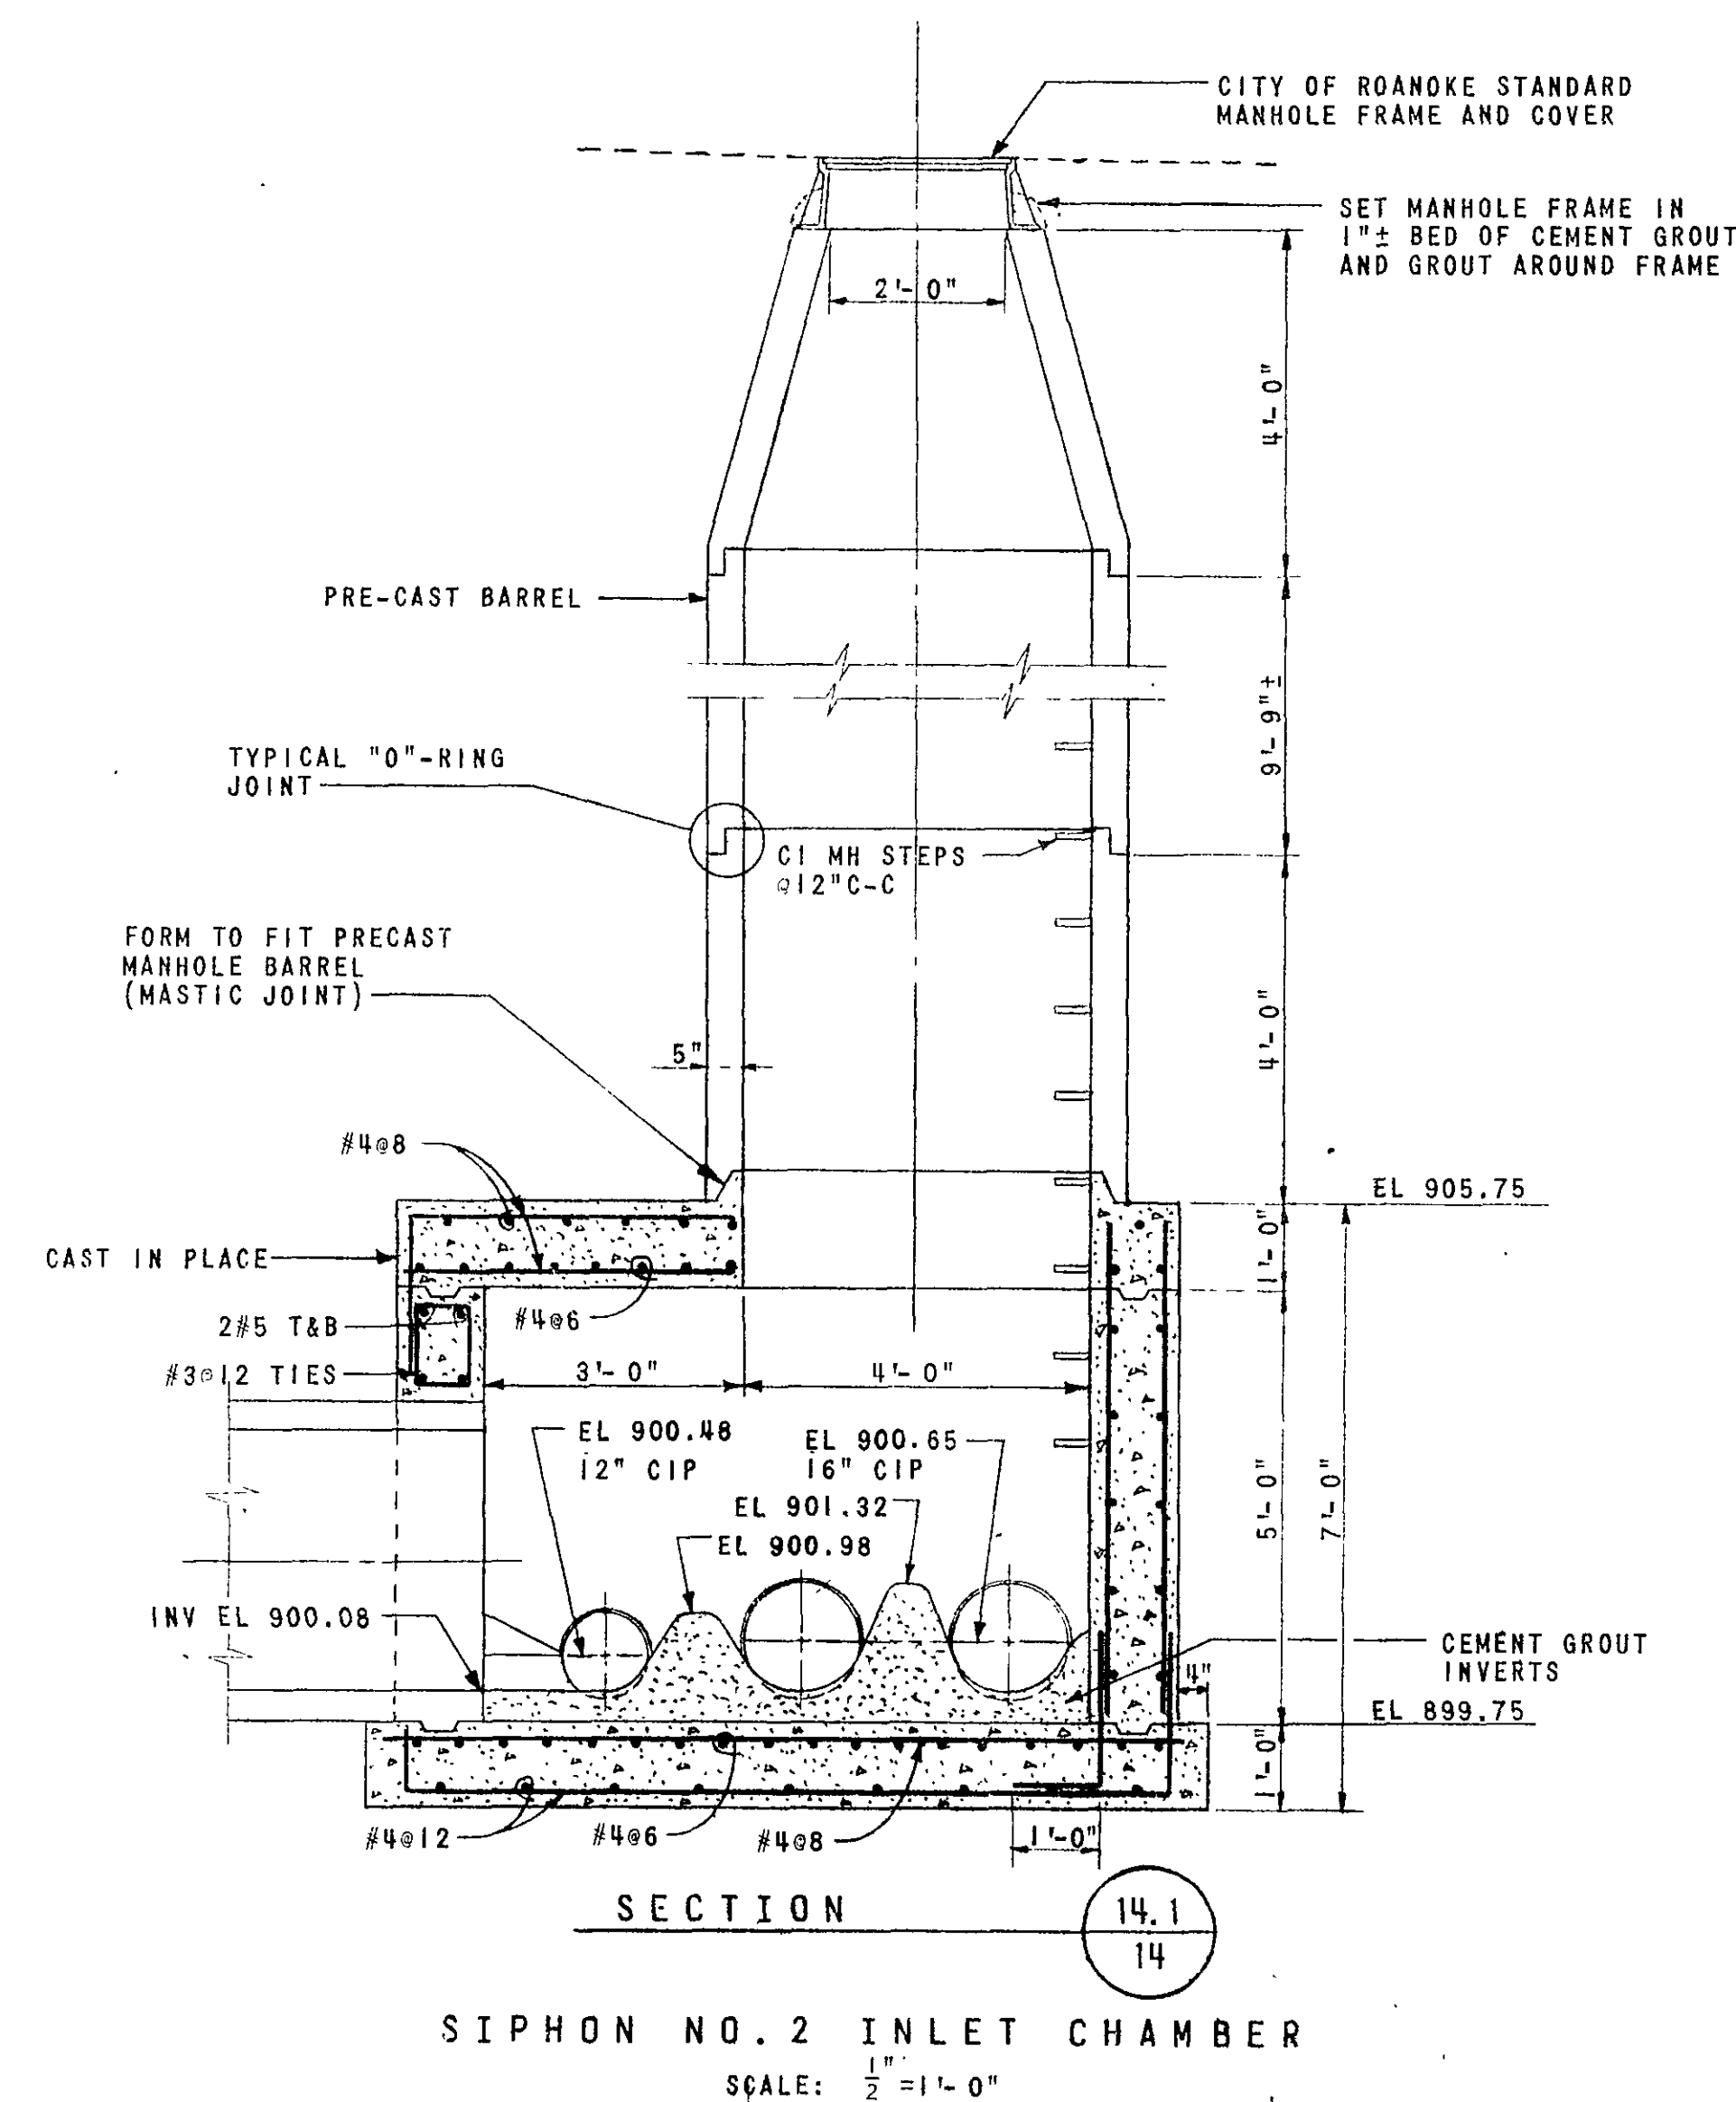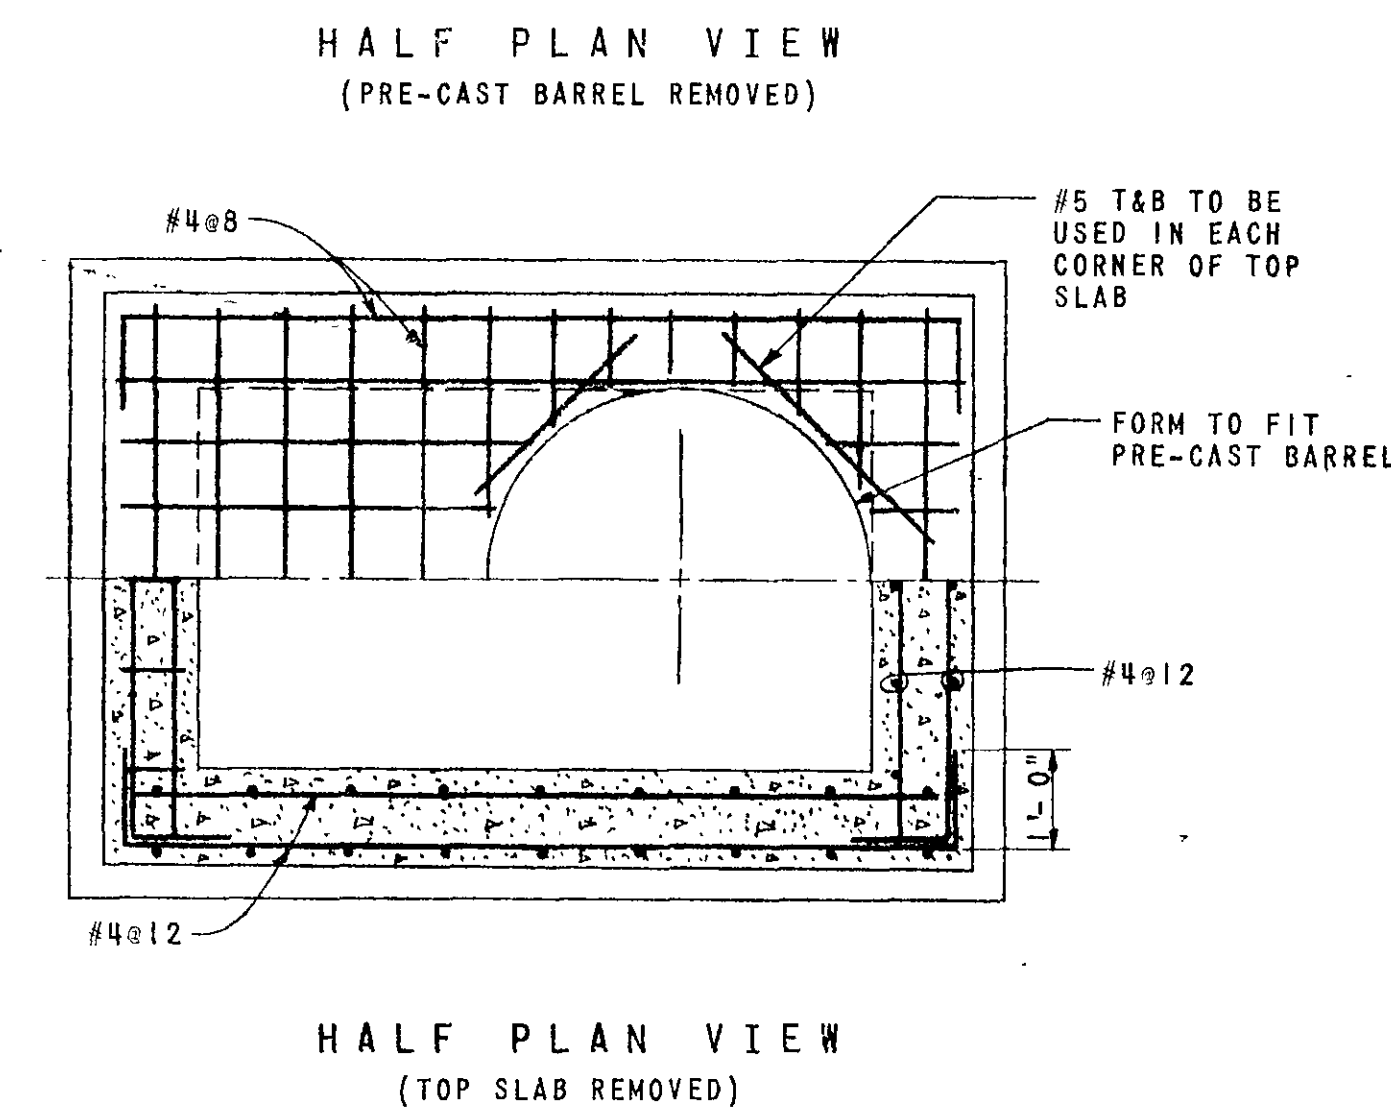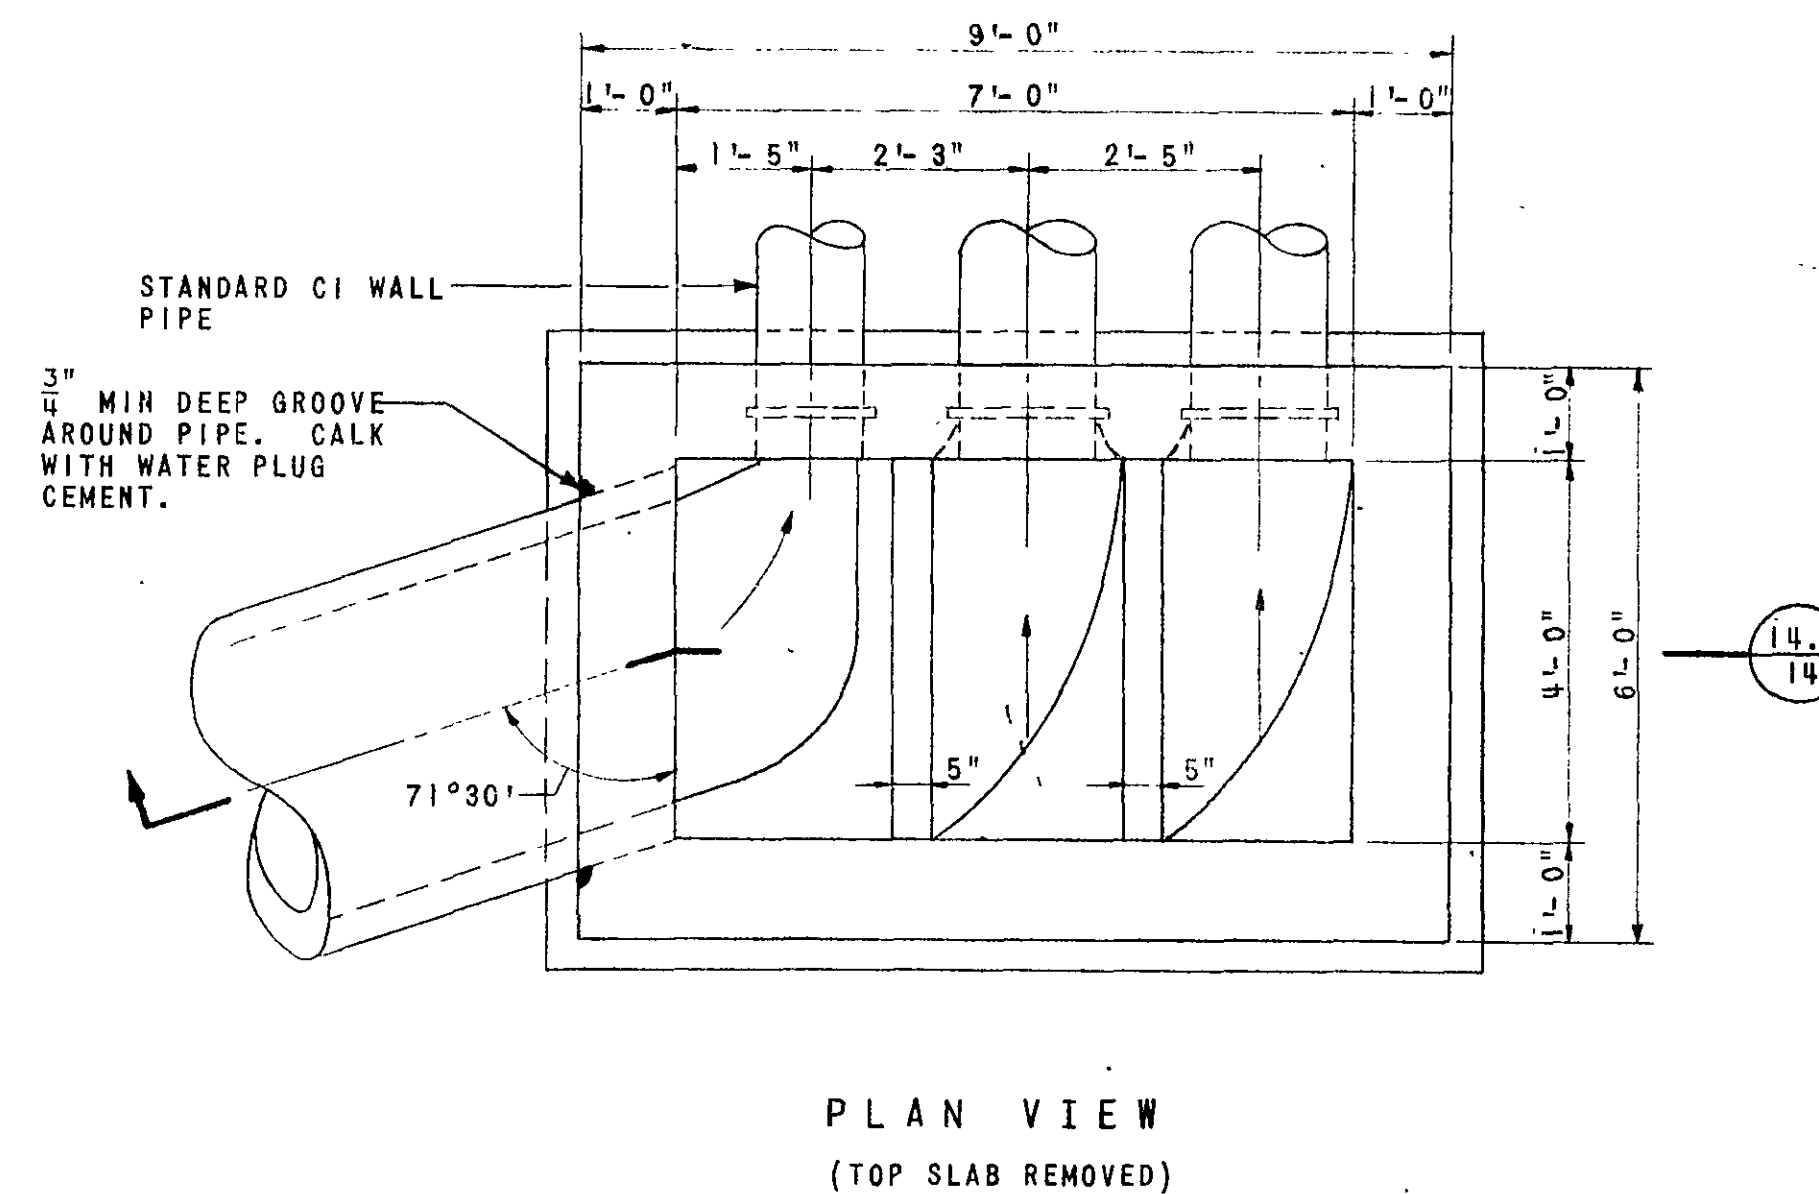

AS BUILT

DIVISION I			
DESIGNED	DATE	AS BUILT	BY
DRAWN	DATE	AS BUILT	BY
CHECKED	DATE	AS BUILT	BY
APPROVED	DATE	AS BUILT	BY
SUBMITTED	DATE	AS BUILT	BY
INTERCEPTOR SEWERS PROJECT NO. 1 TINKER CREEK DETAILS			
CITY OF ROANOKE VIRGINIA			
HAYES, SEAY, MATTERN & MATTERN ARCHITECTS-ENGINEERS		SCALE AS SHOWN	COMM. NO. 3262
DATE DEC. 1967		SHEET 14 OF 18	