




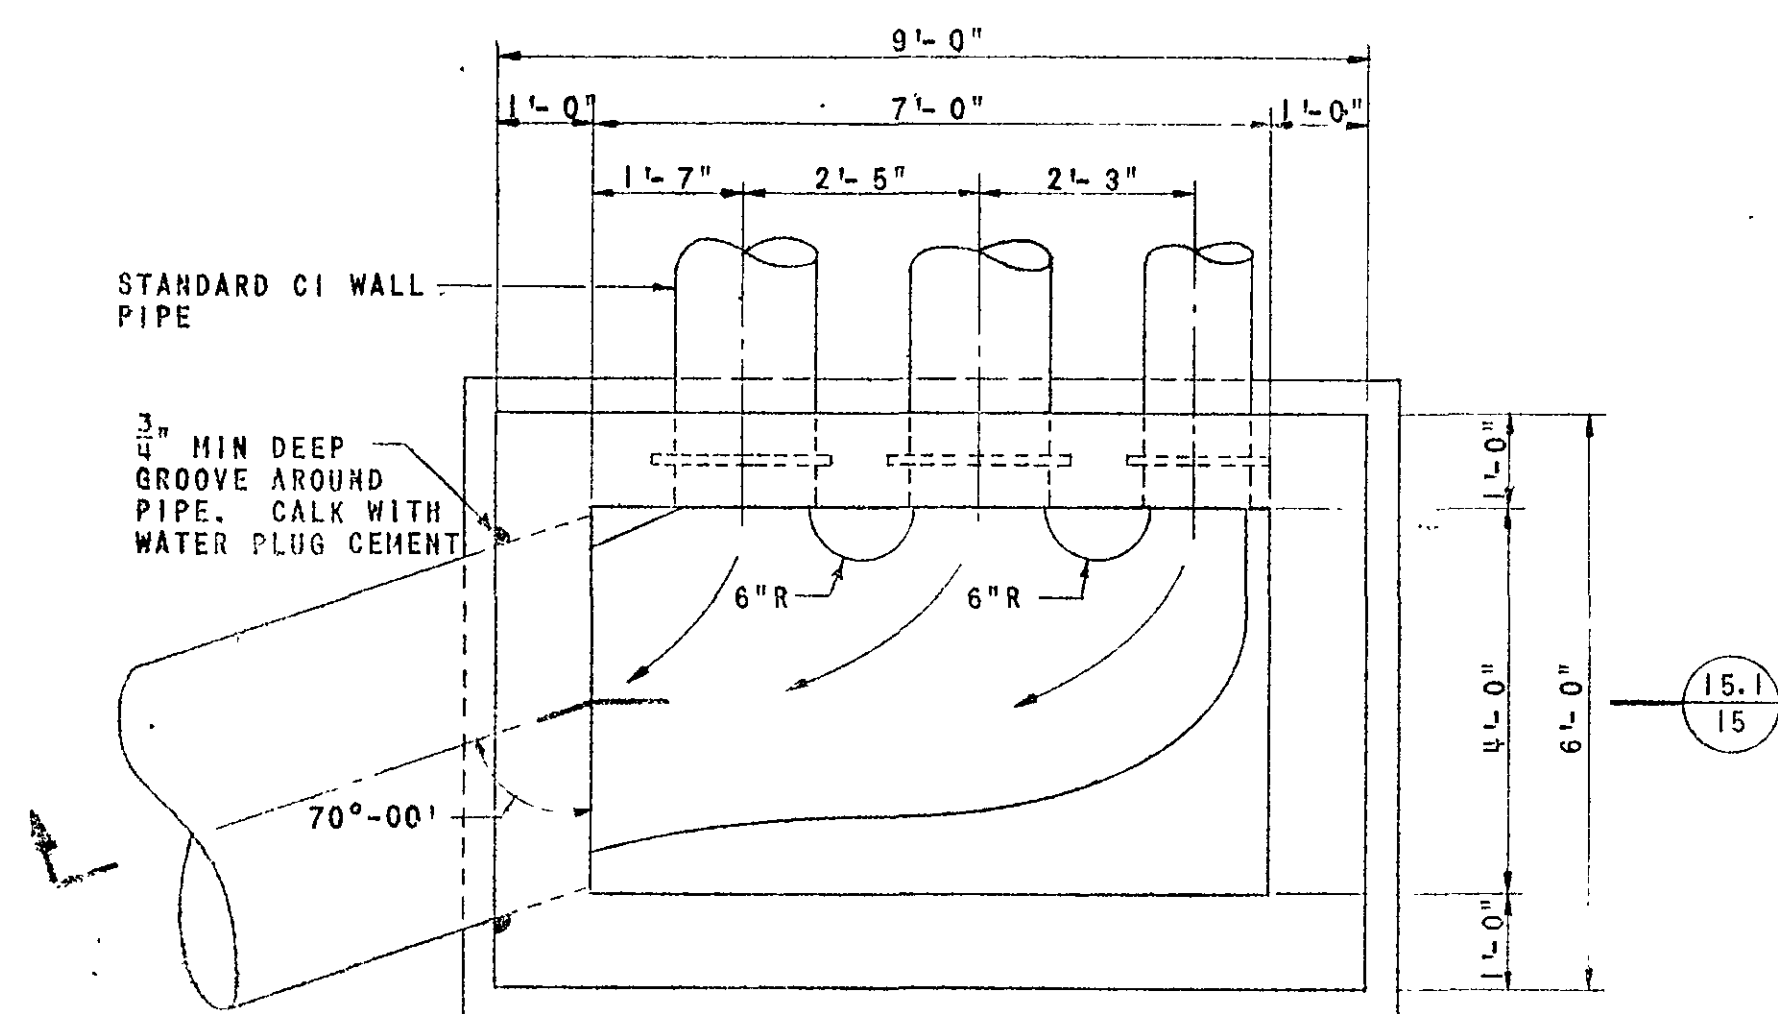

PLAN VIEW
(TOP SLAB REMOVED)

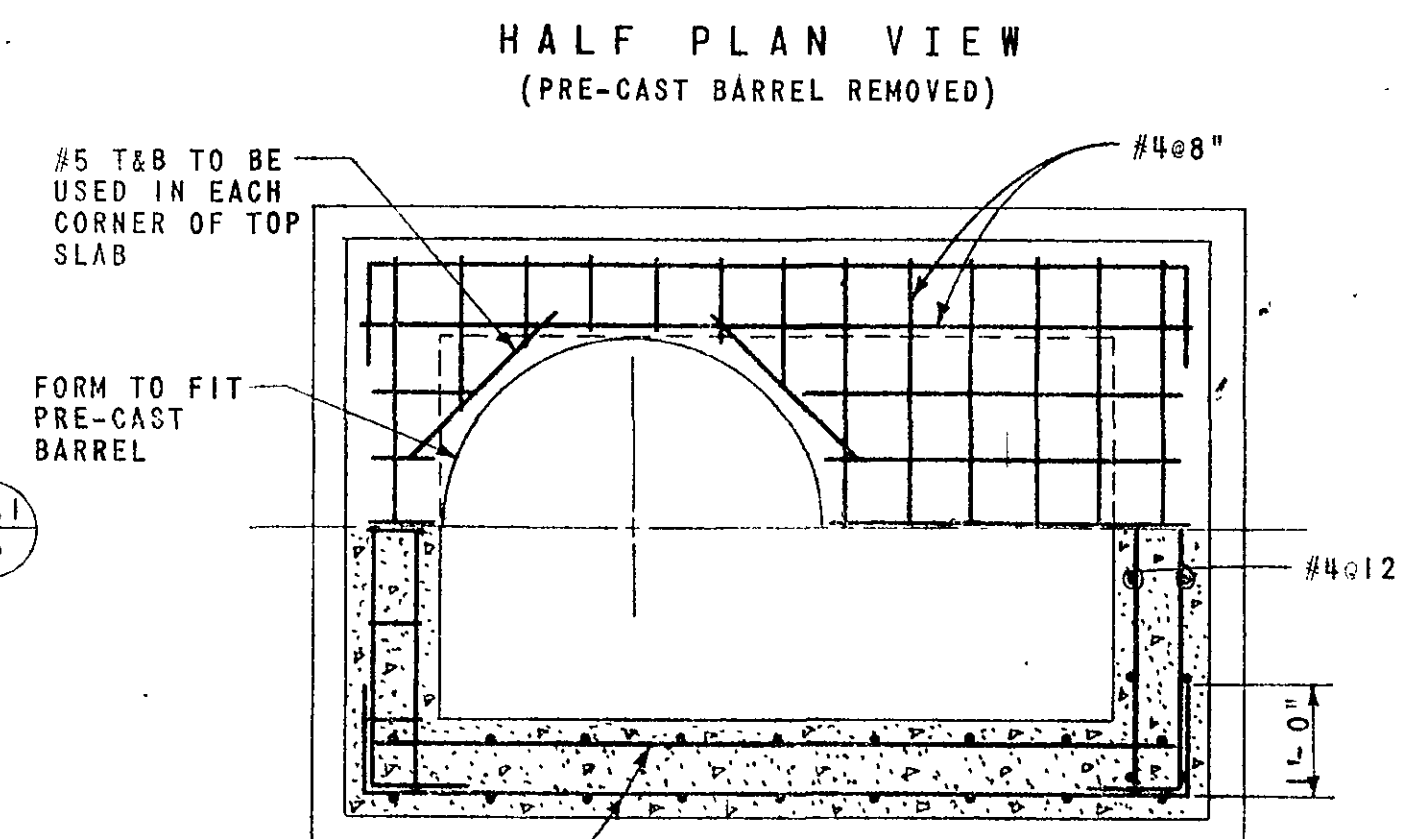


HALF PLAN VIEW
(TOP SLAB REMOVED)

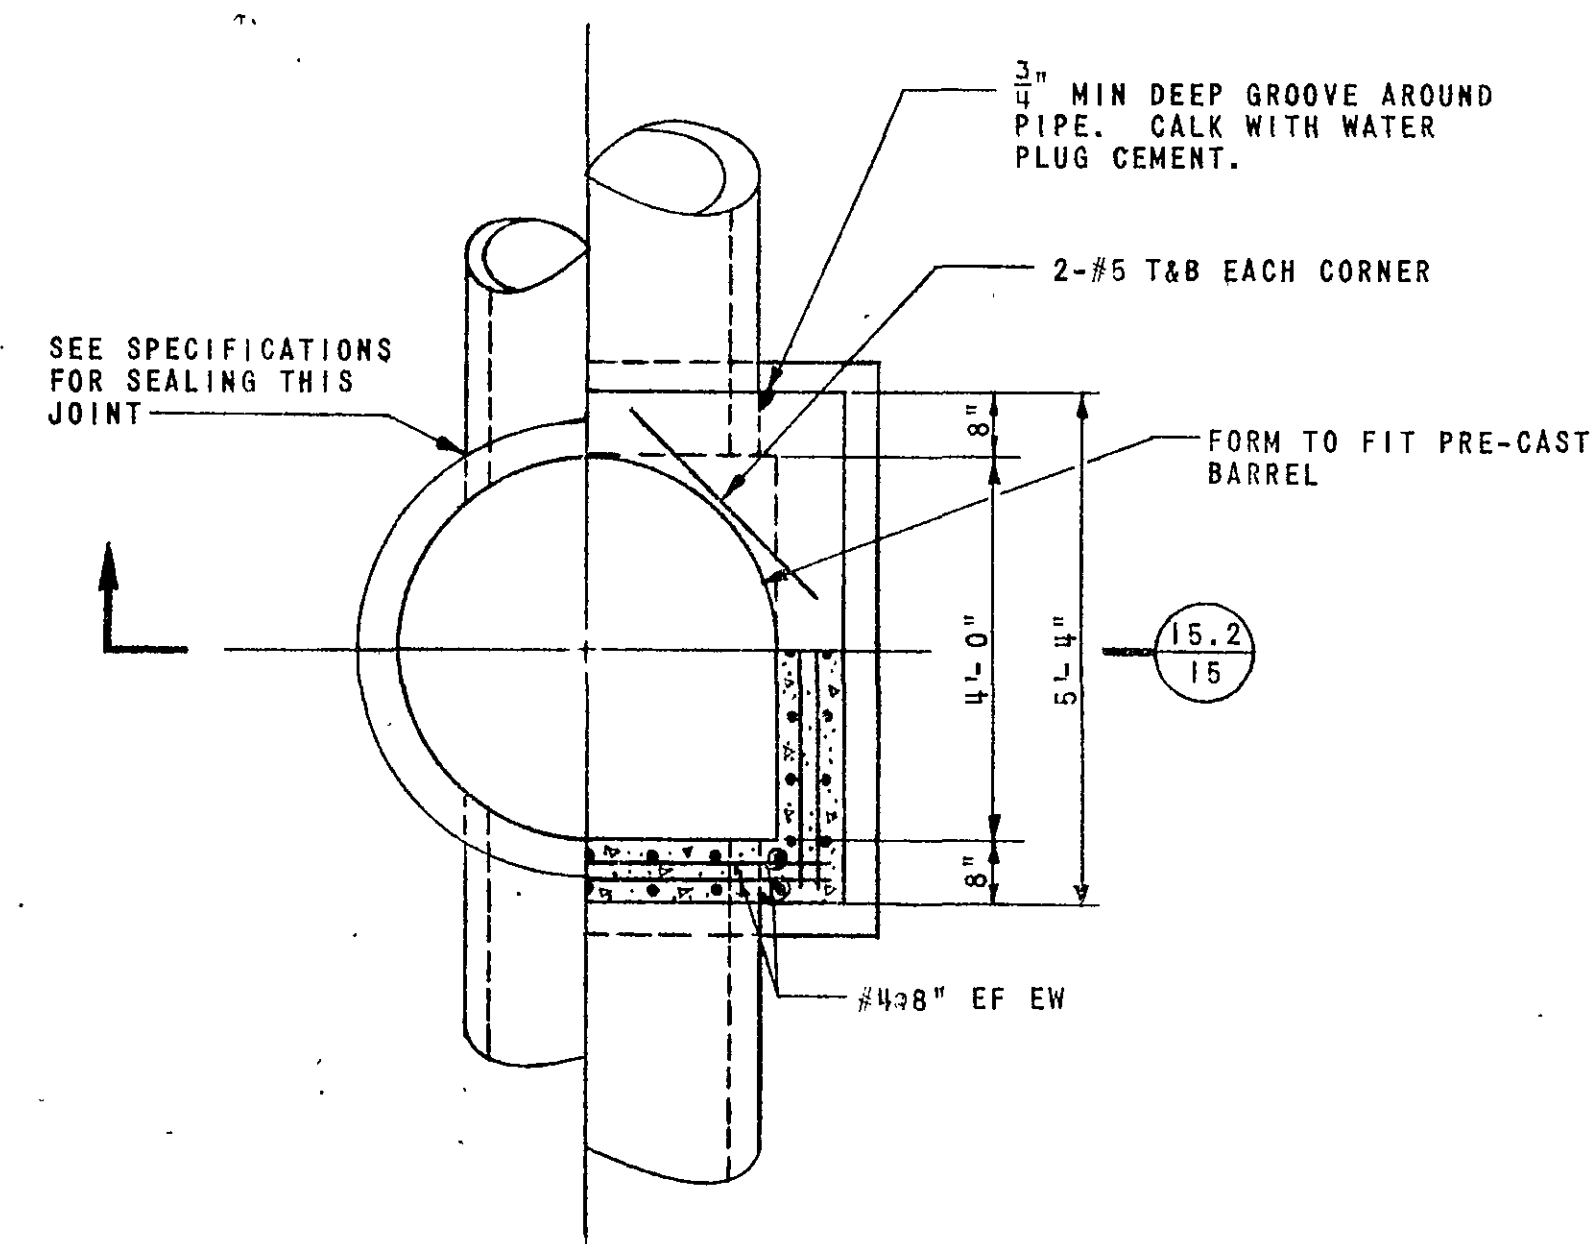

HALF PLAN VIEW


- NOTE:
1. WATERTIGHT MANHOLE FRAMES & COVERS SHALL BE SIMILAR TO "HEENAH" R-1919 WITH "O" RING RUBBER GASKETS & ANCHOR BOLTS
 2. PROVIDE SHALLOW MANHOLE TOP IF DEPTH IS LESS THAN 3'-10". SEE STD. DETAIL C-2.2.

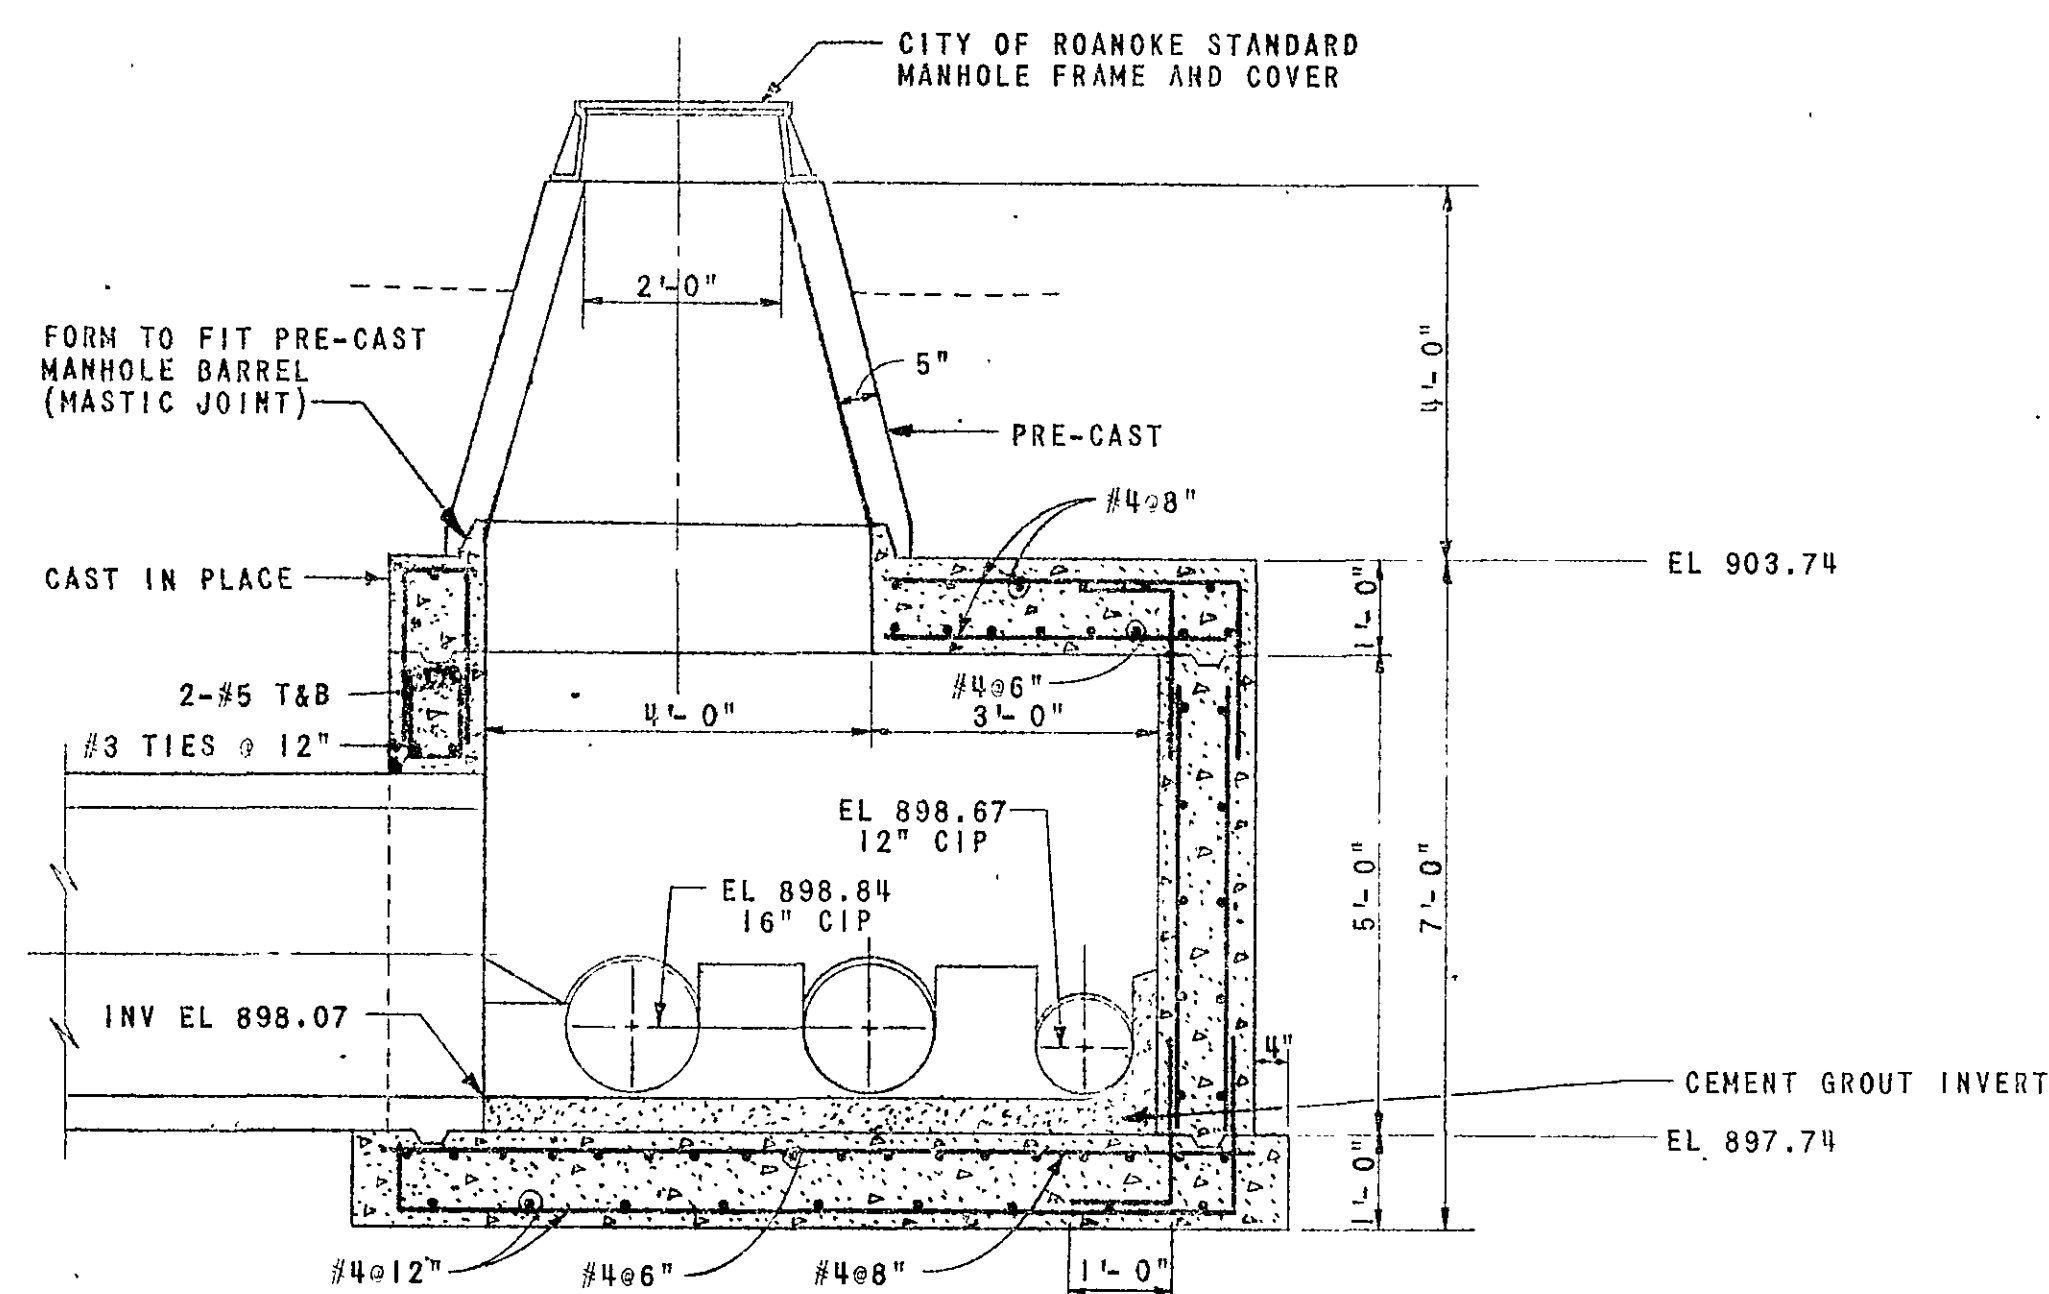

SECTION

SIPHON NO. 2 OUTLET CHAMBER
(DIVISION I)

SCALE: $\frac{1}{2}" = 1'-0"$

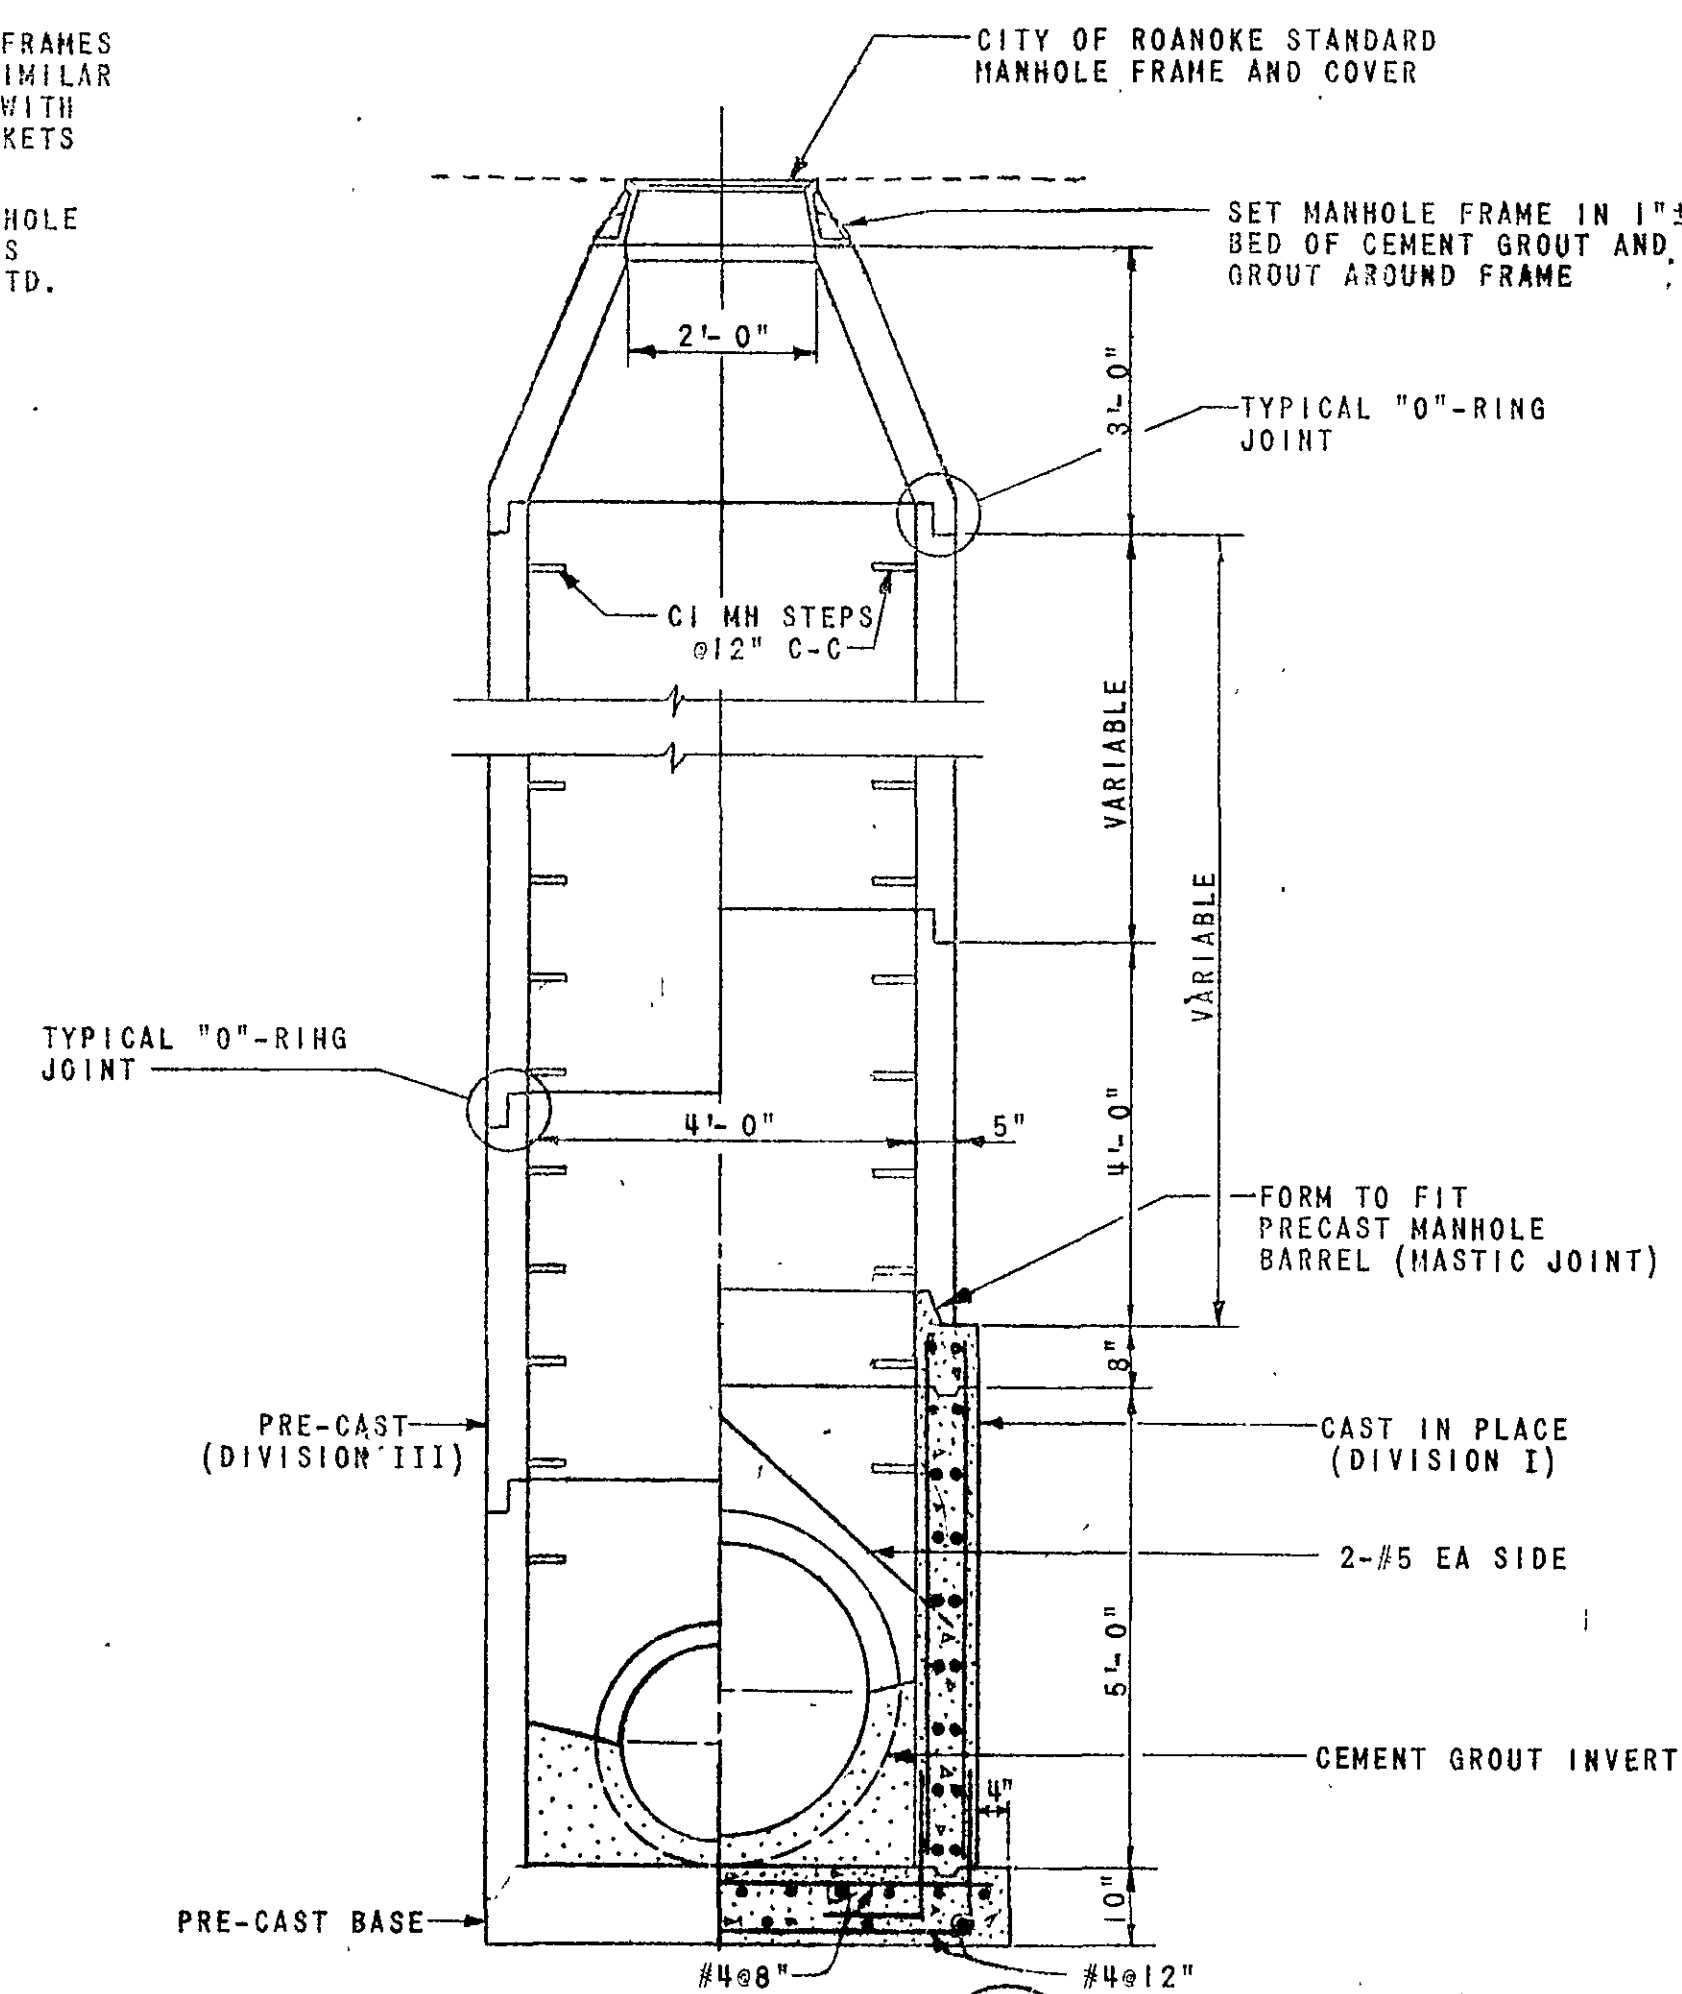

SECTION

TYPICAL MANHOLE DETAIL

SCALE: $\frac{1}{2}" = 1'-0"$

AS BUILT

DIVISION I AND III

REVISION	DATE	DESCRIPTION	BY	APP
1	6-21-71	AS BUILT	DMC	JNR
DESIGNED <i>Rac</i>				
DRAWN <i>AJP</i>				
CHECKED <i>MR</i>				
APPROVED <i>Jnd</i>				
SUBMITTED <i>GOB</i>				
HAYES, SEAY, MATTERN & MATTERN ARCHITECTS-ENGINEERS			SCALE AS SHOWN	COMM. NO. 3262
			DATE DEC. 1967	SHEET 15 OF 18