


REVISED 5-21-81
Revised 8-28-80

Sheet 11 of 18

Scale: HORIZ. 1" = 100'

Date: 9-28-79

Project: 7930

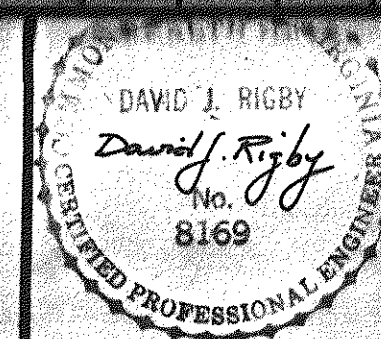


Designed: DJR-LHW
Drafted: WCB-LHW
Checked: LHW
Approved: DJR


Clean Water Engineers, Inc.

Fincastle, Virginia

PLAN VIEWS, SEWERLINE GRADES, MANHOLE INVERTS ARE ALL CORRECTED BASED ON APPROVED "CUT-SHEET" DATA AS SUPPLIED TO CLEAN WATER ENGINEERS, INC. BY THE CONTRACTOR. THE GROUND PROFILE WAS NOT ADJUSTED TO REFLECT AS-BUILT CONDITIONS THEREFORE THE PROFILES MAY NOT BE TO SCALE HORIZONTALLY OR VERTICALLY. REFER TO THE NUMERICAL NOTES FOR HORIZONTAL DISTANCE AND SEWERLINE GRADES, DO NOT SCALE.

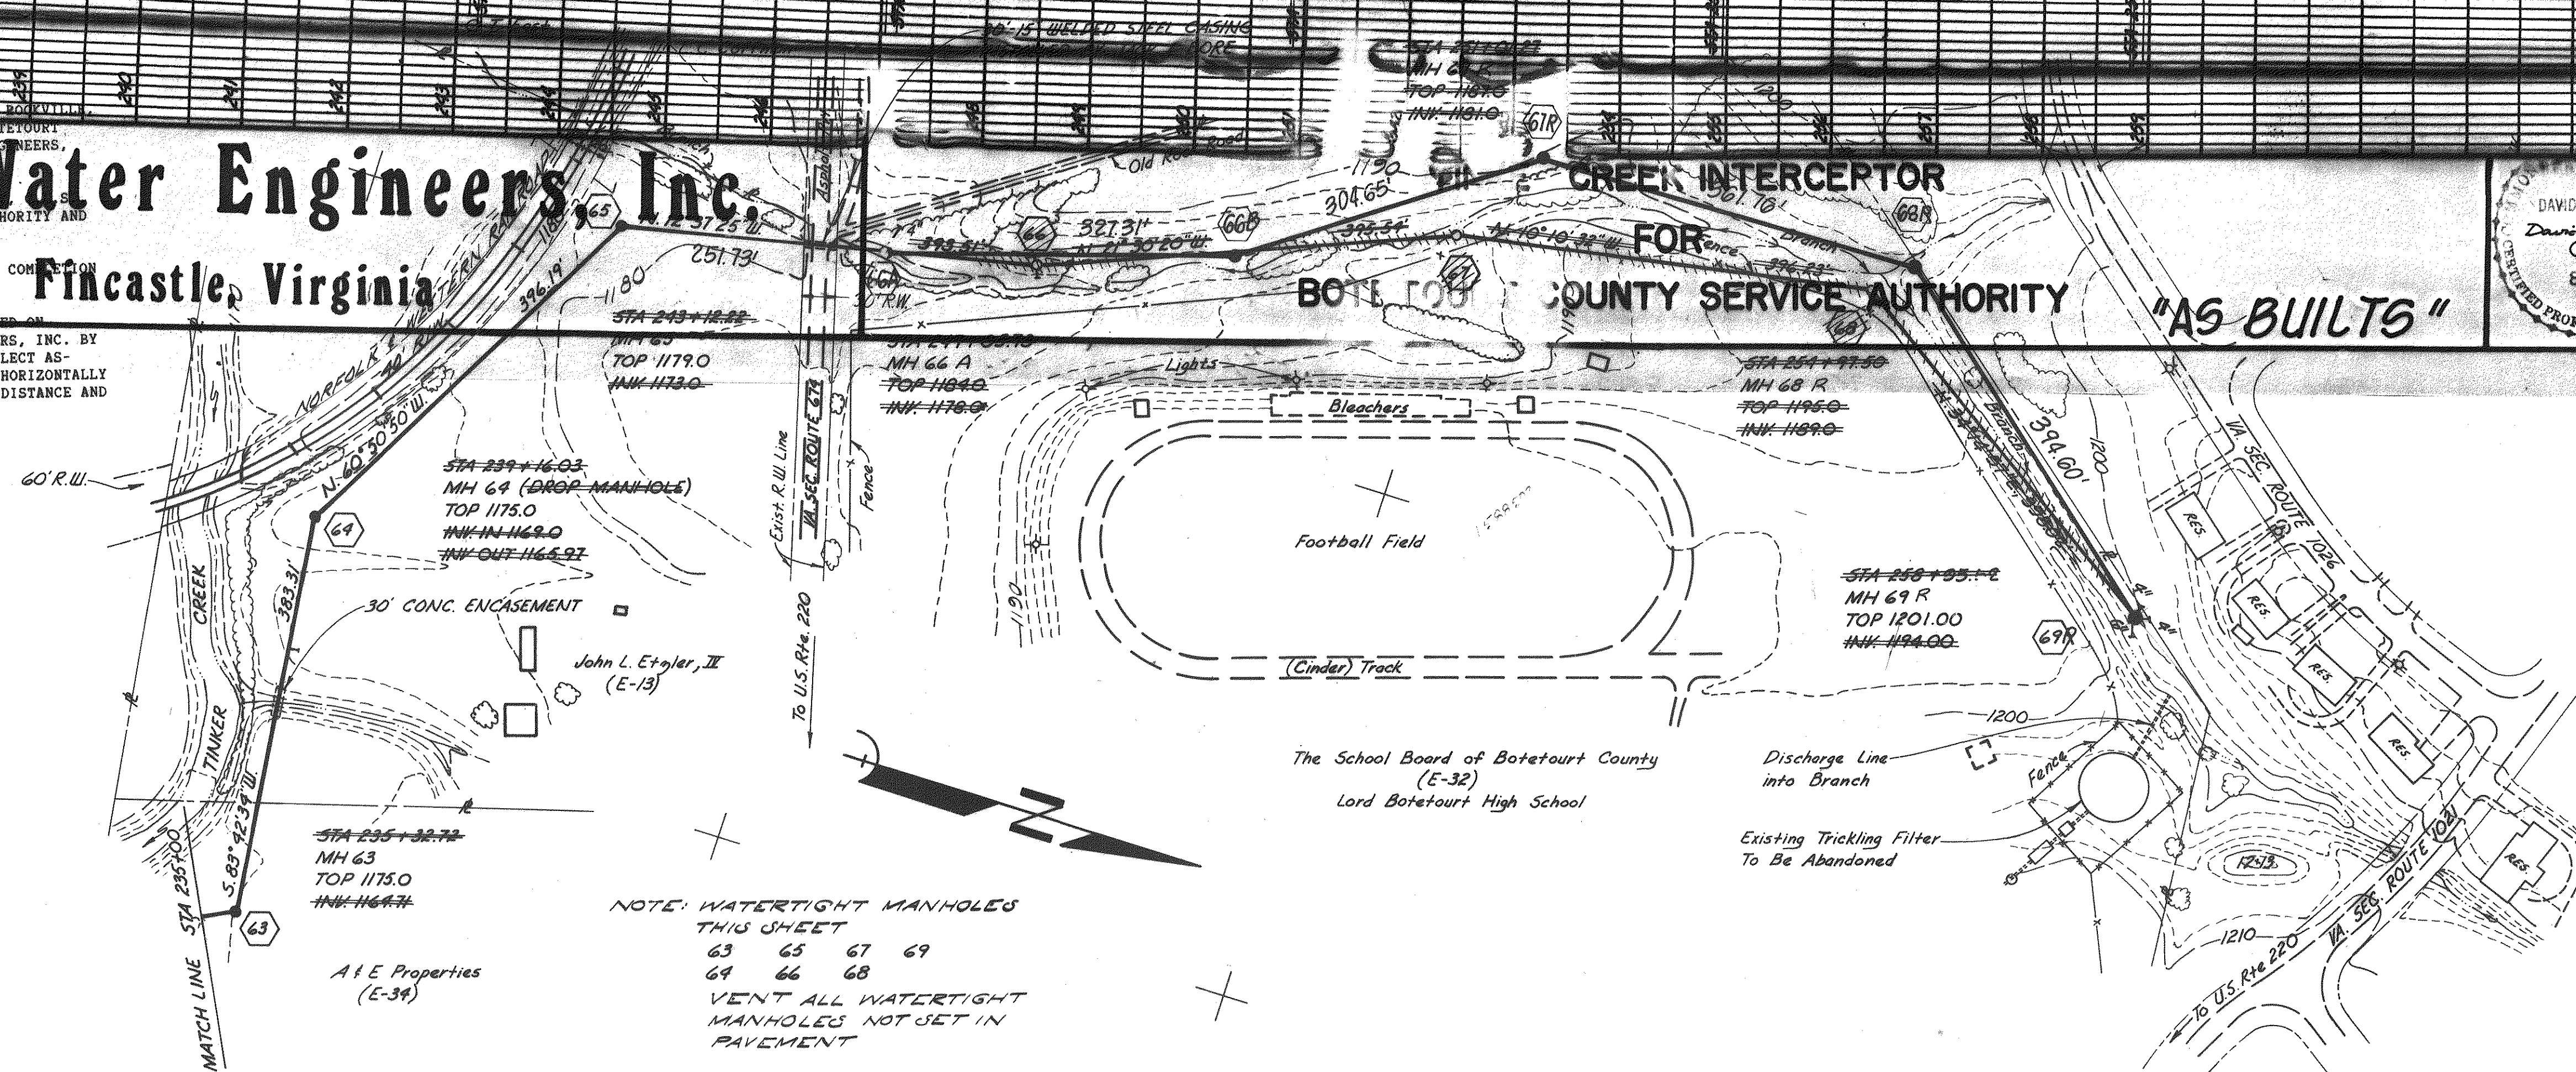

NOTE: WATERTIGHT MANHOLES THIS SHEET
63 65 67 69
64 66 68
VENT ALL WATERTIGHT MANHOLES NOT SET IN PAVEMENT

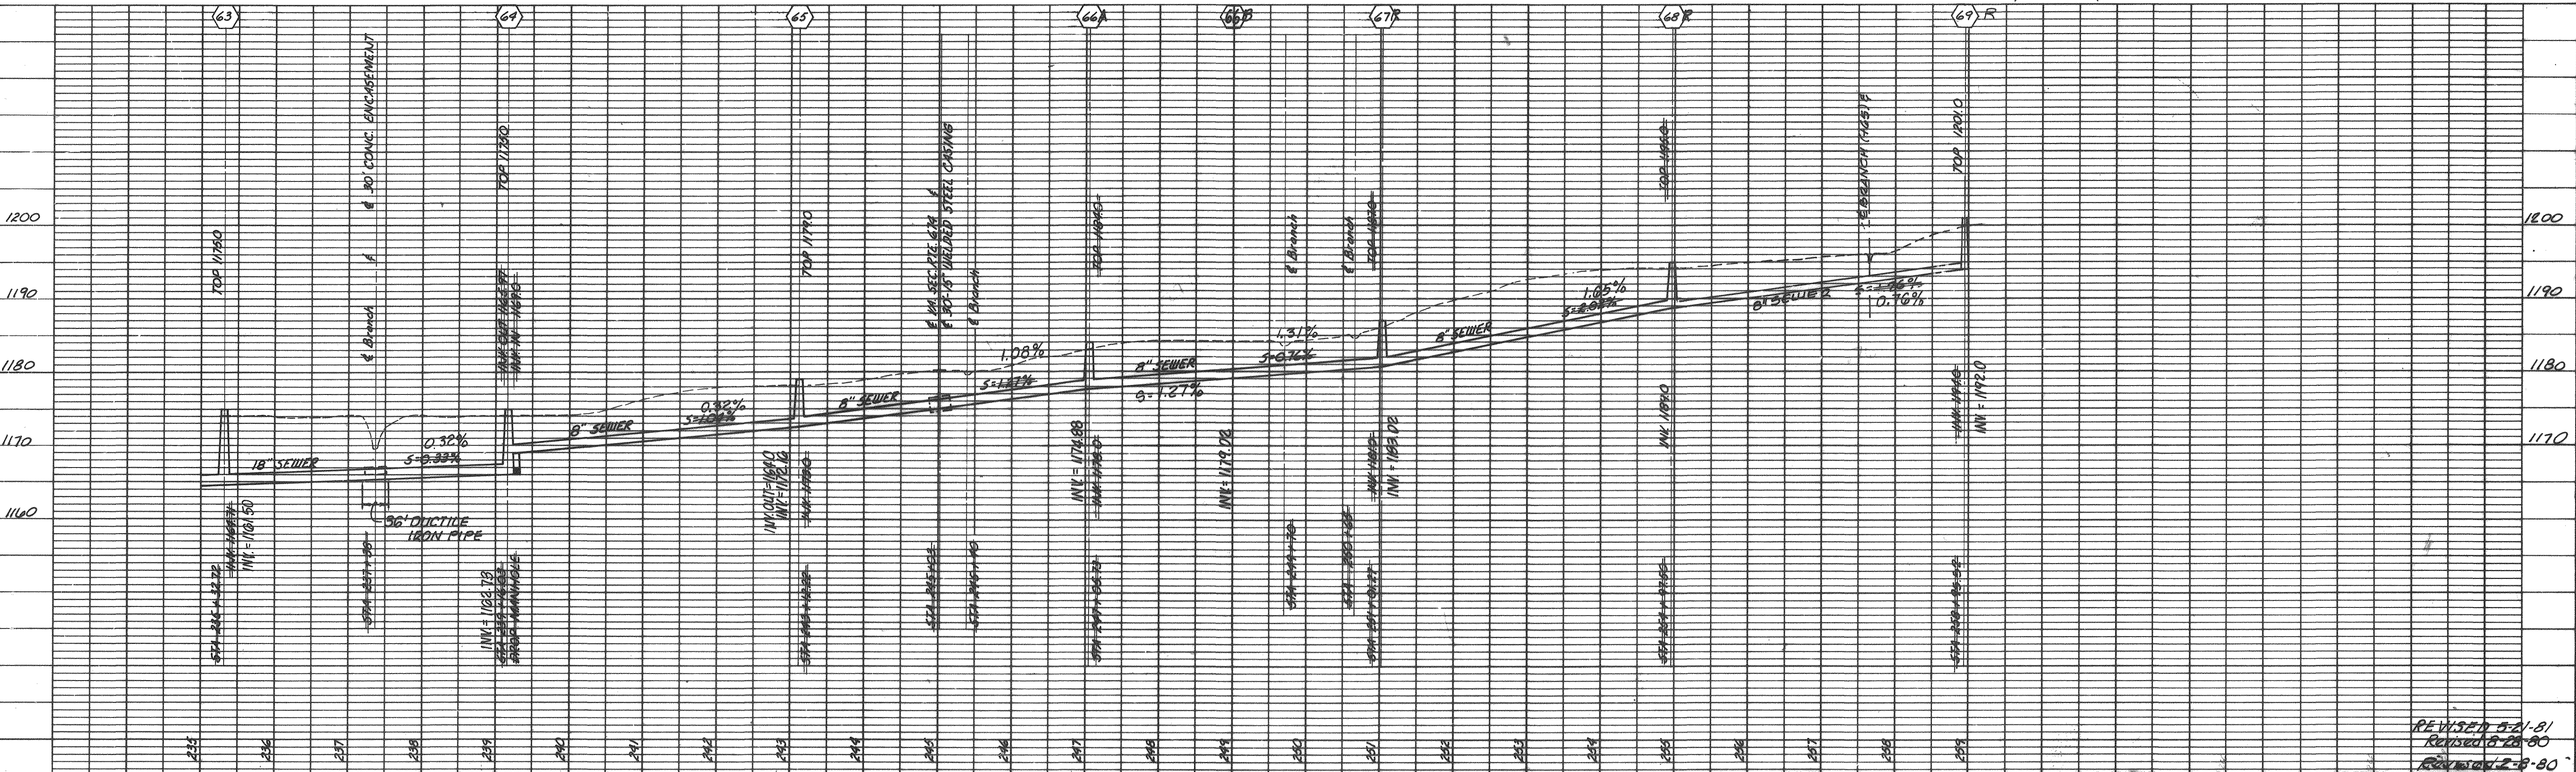


Designed: DJR-LHW
Drafted: WCB-LHW
Checked: LHW
Approved: DJR

Clean Water Engineers, Inc.

Fincastle, Virginia

TINKER CREEK INTERCEPTOR
FOR
BOTETOURT COUNTY SERVICE AUTHORITY

"AS BUILTS"

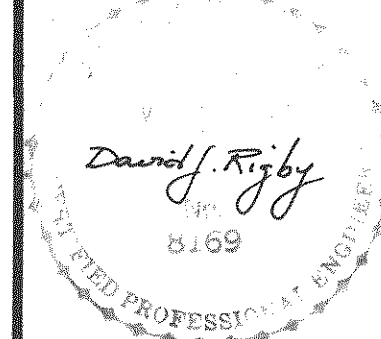

Sheet: 11 of 18

Scale: HORIZ. 1" = 100'

Date: 9-28-79

Project: 7930

REVISED 5-21-81
Revised 8-28-80
Revised 12-8-80