

See Sheet 5 of 1
for Continuation.


AERIAL TOPOGRAPHY MAPPING PREPARED BY UNIVERSAL ENGINEERING, ROCKVILLE, MARYLAND FLOWN AND MAPPED 1979, AS CONTRACTED BY THE BOTETOURT COUNTY SERVICE AUTHORITY AND SUPPLIED TO CLEAN WATER ENGINEERS, INC.

"AS-BUILT" INFORMATION WAS BASED ON EXISTING GROUND CONDITIONS AT COMPLETION OF CONSTRUCTION

CONTRACT II

VENT ALL WATERTIGHT
MANHOLES NOT SET IN
PAVEMENT

SCALE: 1" = 100'

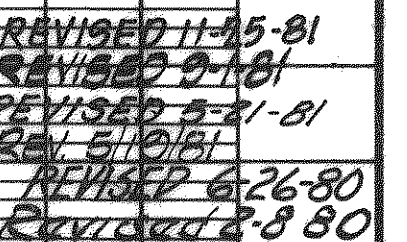

Sheet: 12 of 18
Scale: HORIZ. 1" = 100' VERT. 1" = 10'
Date: 9-28-79
Project: 7930