

NOTE:


PLANS WERE PREPARED BASED ON:

AERIAL TOPOGRAPHY MAPING PREPARED BY UNIVERSAL ENGINEERING, ROCKVILLE, MARYLAND FLOWN AND MAPPED 1979, AS CONTRACTED BY THE BOTETOURT COUNTY SERVICE AUTHORITY AND SUPPLIED TO CLEAN WATER ENGINEERS, INC.


HORIZONTAL AND VERTICAL GROUND CONTROL BY CHARLES R. MCMURRAY, C.L.S., 1979, AS CONTRACTED BY THE BOTETOURT COUNTY SERVICE AUTHORITY AND SUPPLIED TO CLEAN WATER ENGINEERS, INC.

AS-BUILT INFORMATION WAS BASED ON EXISTING GROUND CONDITIONS AT COMPLETION OF CONSTRUCTION

PLAN VIEWS, SEWERLINE GRADES, MANHOLE INVERTS ARE ALL CORRECT BASED ON APPROVED "CUT-SHEET" DATA AS SUPPLIED TO CLEAN WATER ENGINEERS, INC. BY THE CONTRACTOR. THE GROUND PROFILE WAS NOT ADJUSTED TO REFLECT AS-BUILT CONDITIONS THEREFORE THE PROFILES MAY NOT BE TO SCALE HORIZONTALLY OR VERTICALLY. REFER TO THE NUMERICAL NOTES FOR HORIZONTAL DISTANCE AND SEWERLINE GRADES, DO NOT SCALE.

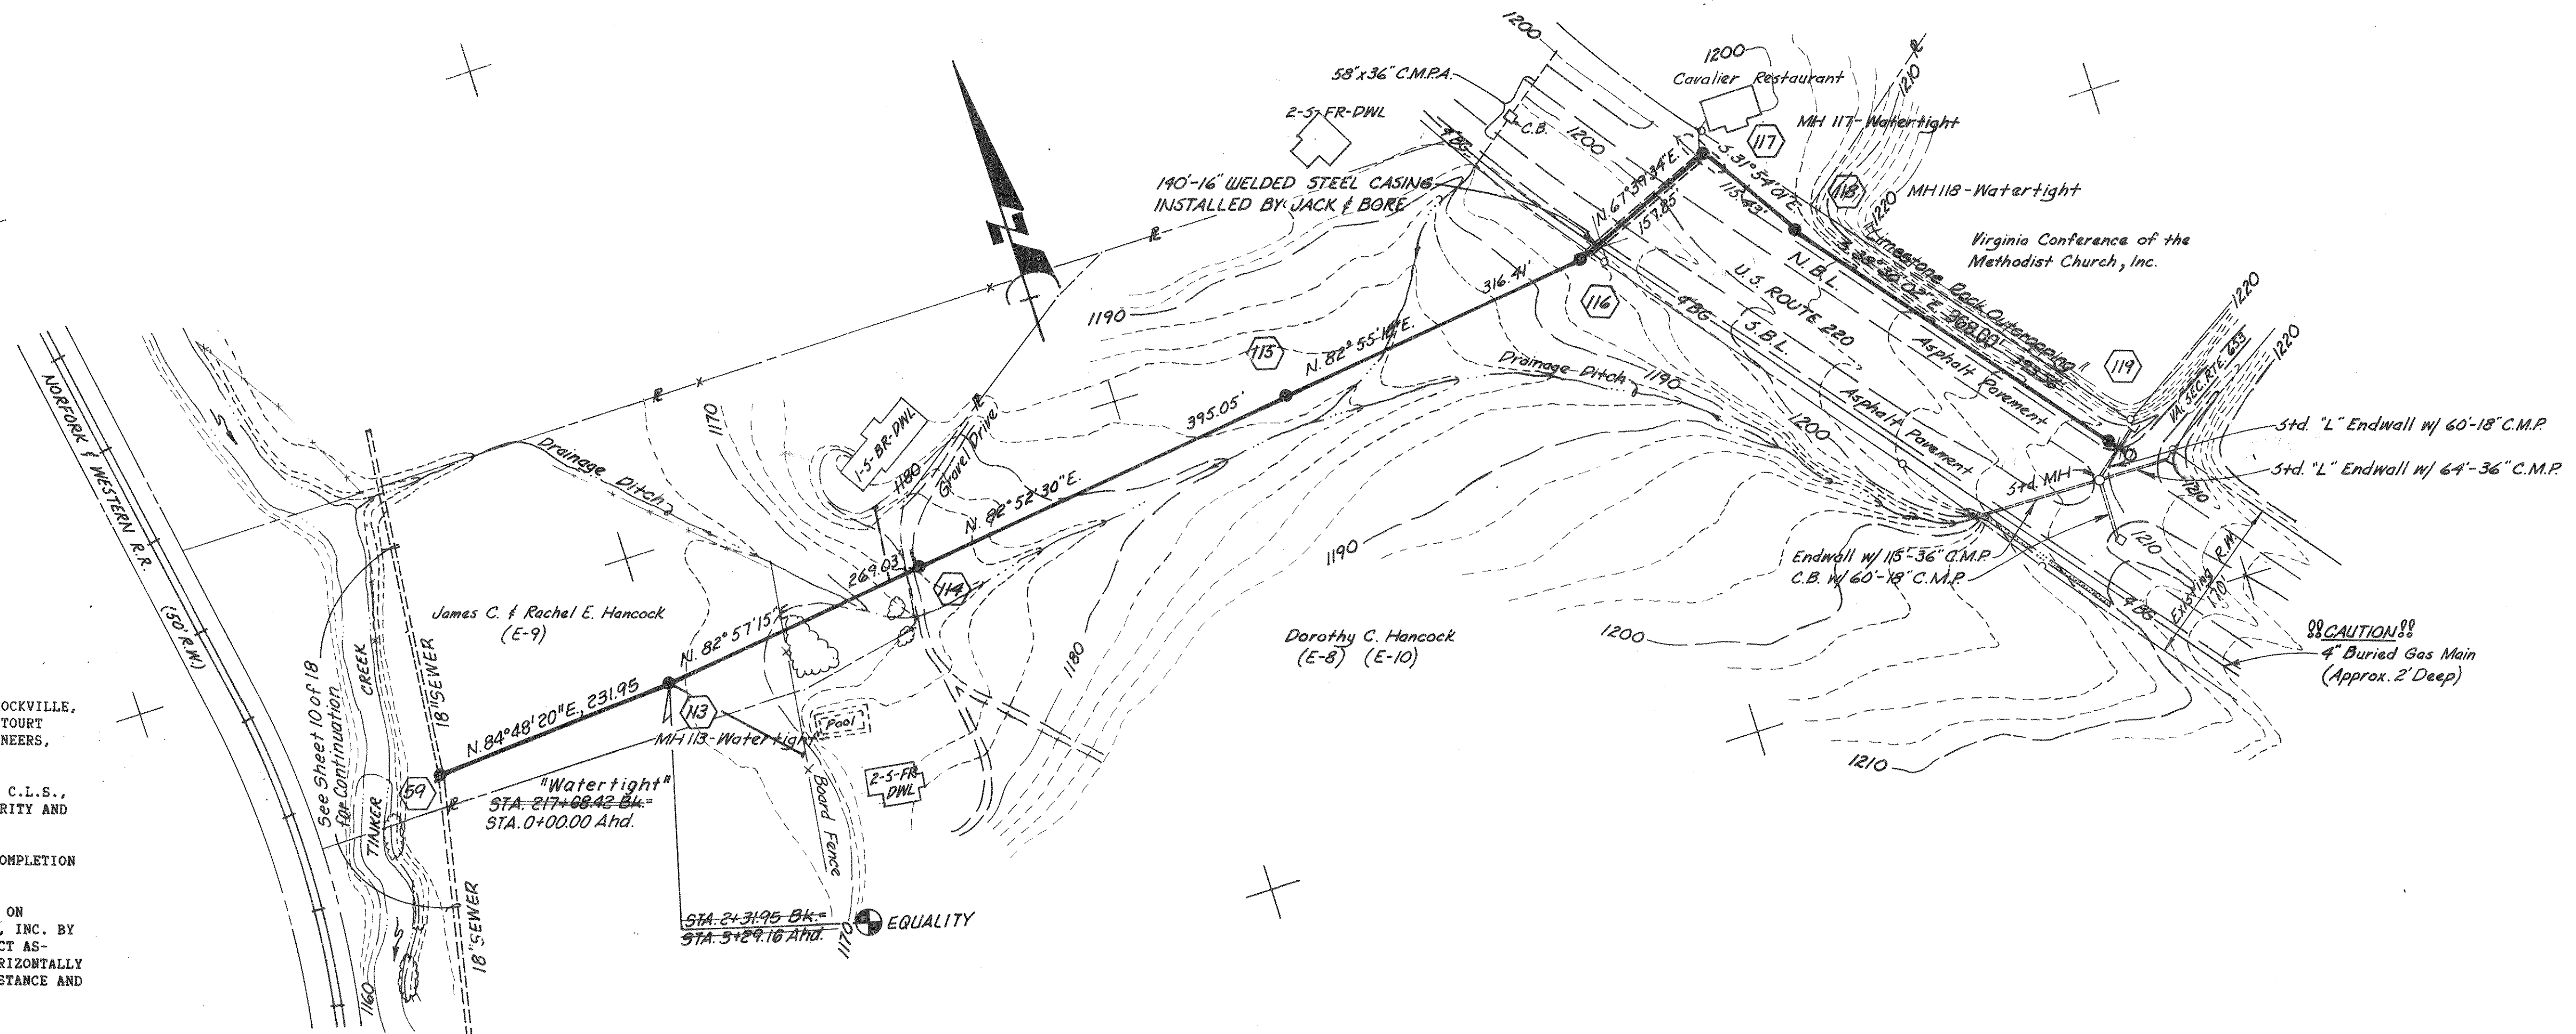

SCALE: 1"=100'
0' 50' 100' 200'

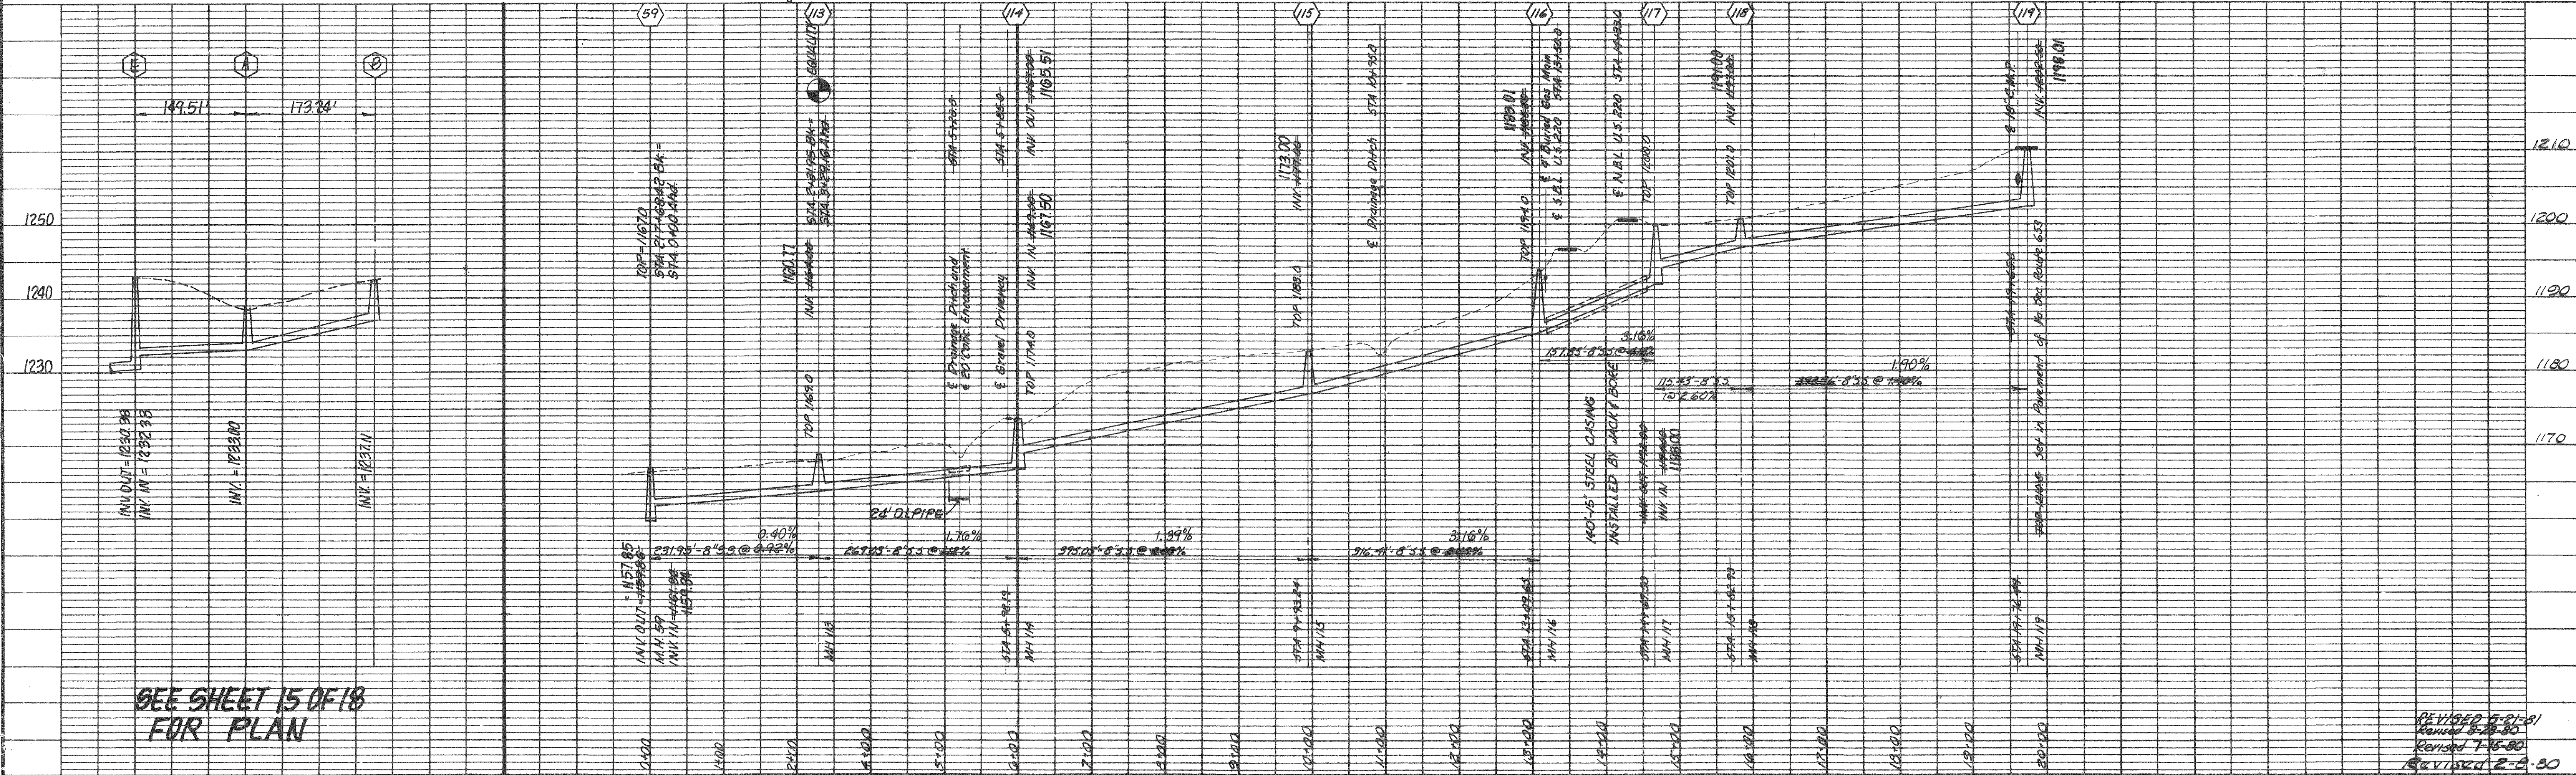

SEE SHEET 15 OF 18
FOR PLAN

REVISED 5-21-81
Revised 8-28-80
Revised 7-15-80
Revised 2-9-80

Designed: DJR	Clean Water Engineers, Inc. Fincastle, Virginia	TINKER CREEK INTERCEPTOR FOR BOTETOURT COUNTY SERVICE AUTHORITY "AS BUILTS"		Sheet: 16 of 18
Drafted: WCB				Scale: HORIZ. 1"=100' VERT. 1"=10'
Checked: CEP				Date: 11-27-79
Approved: DJR				Project: 7930