


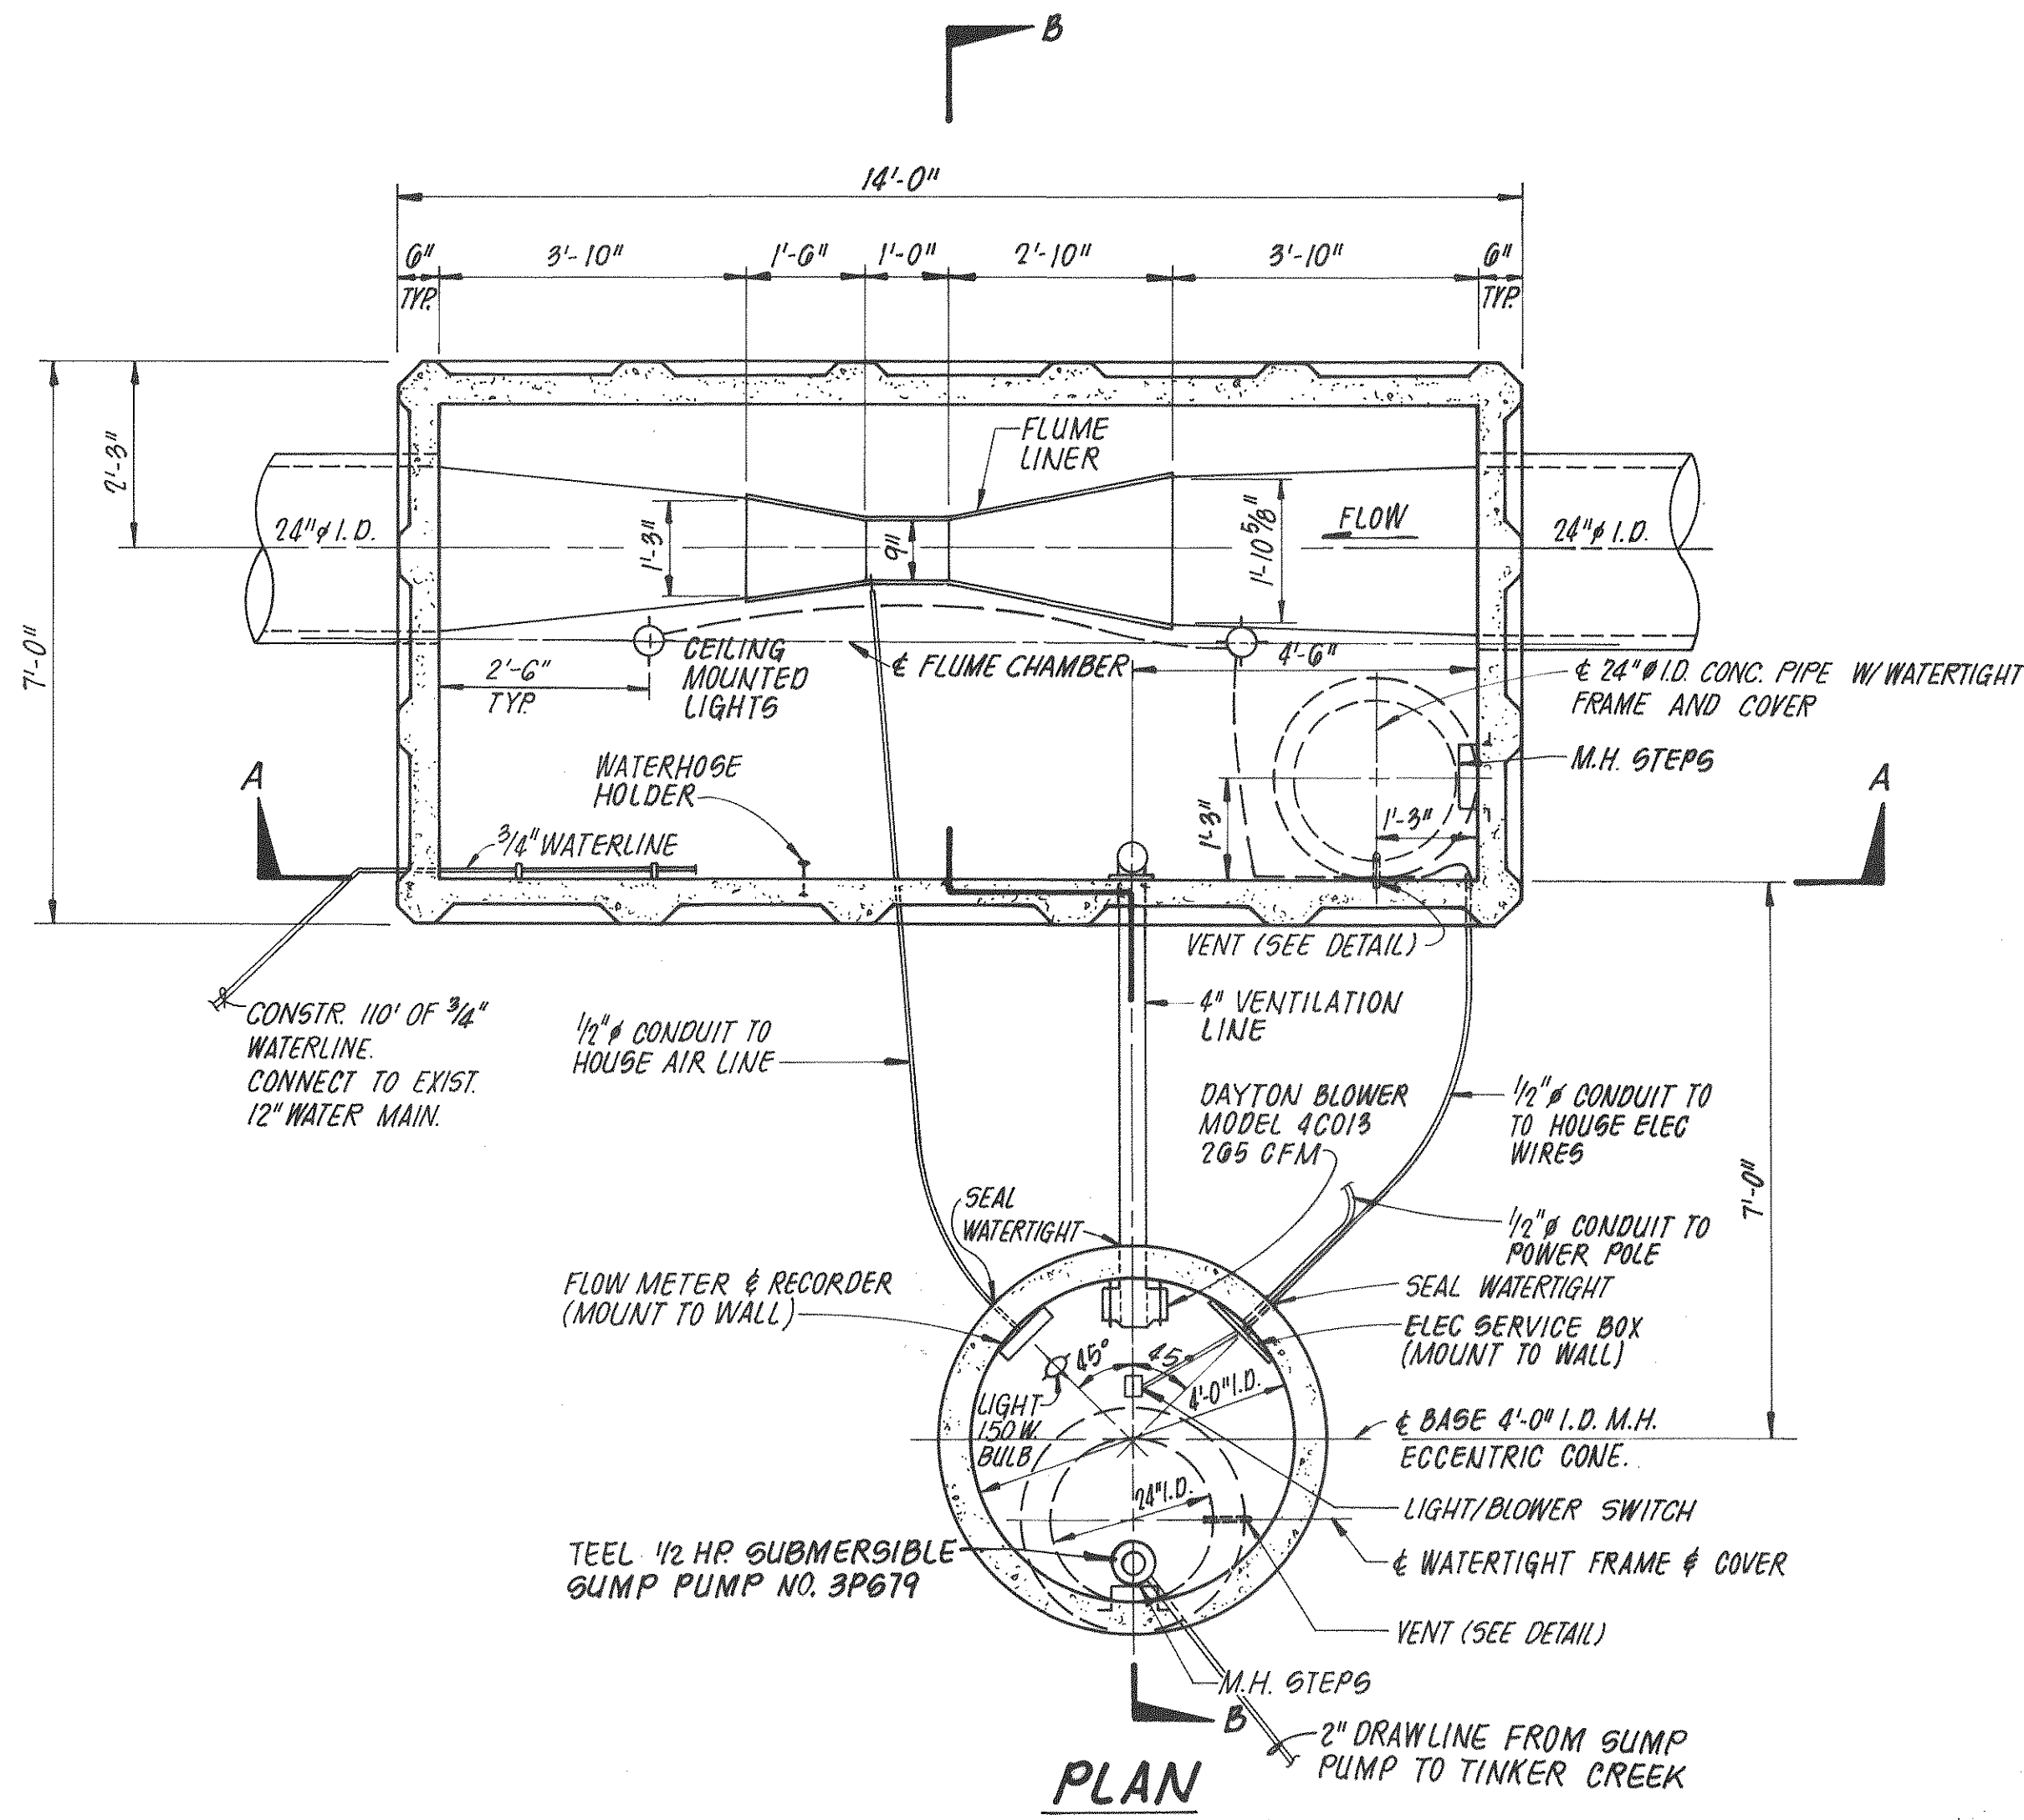
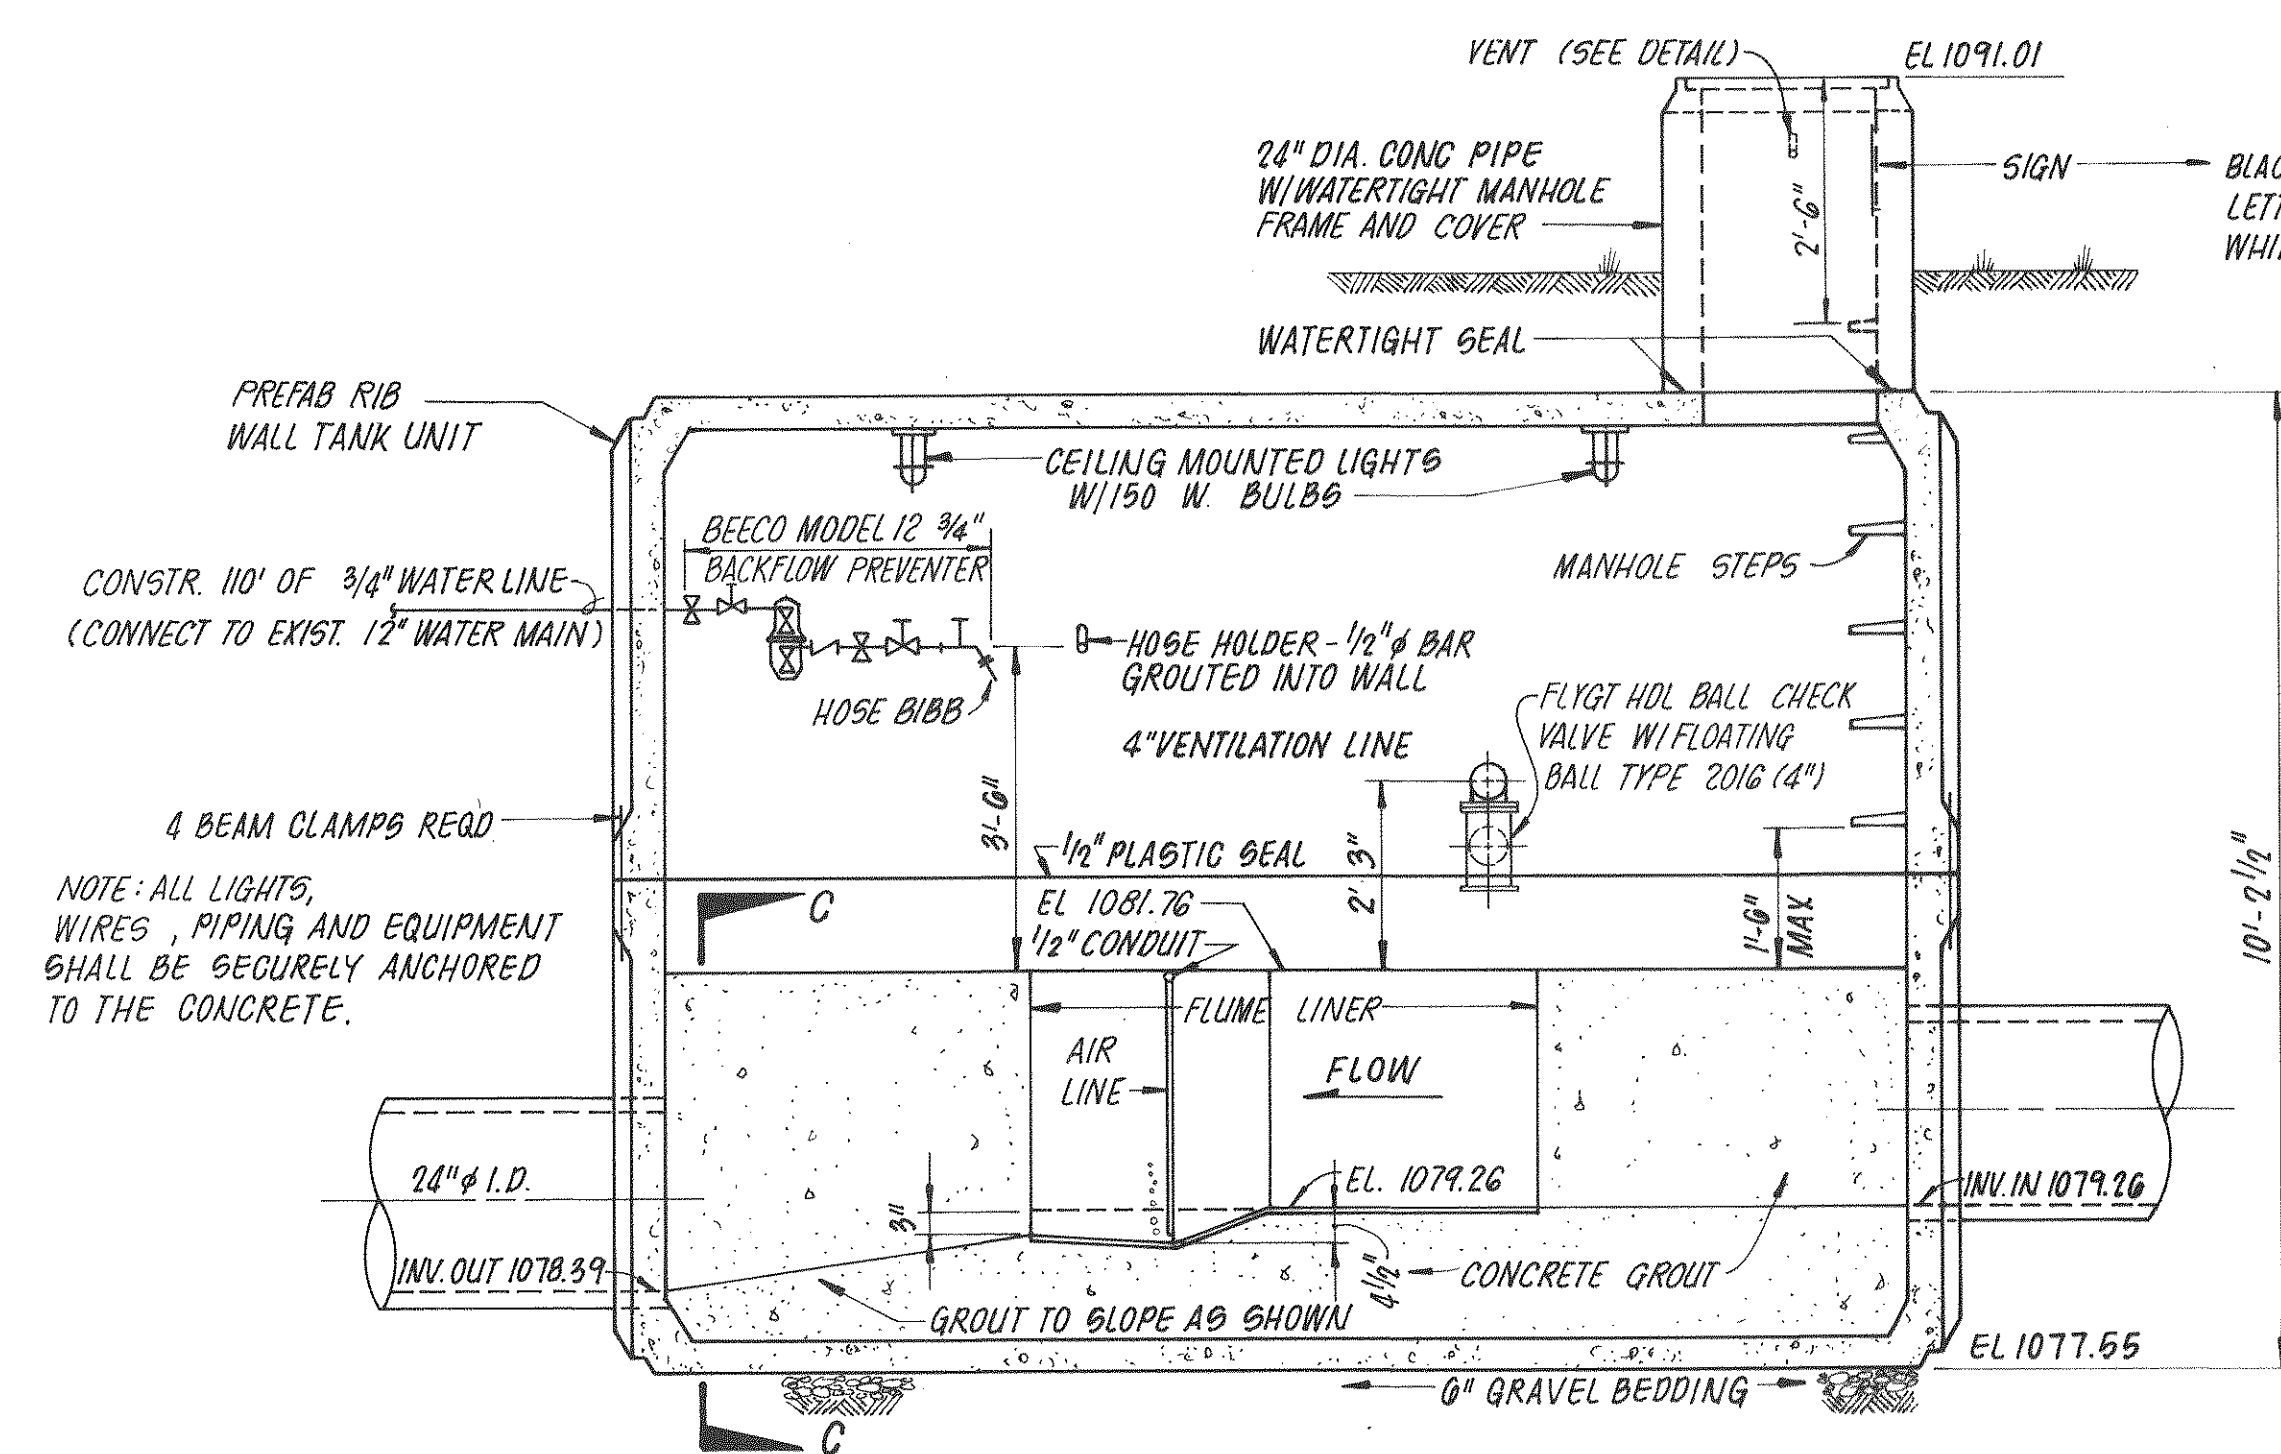


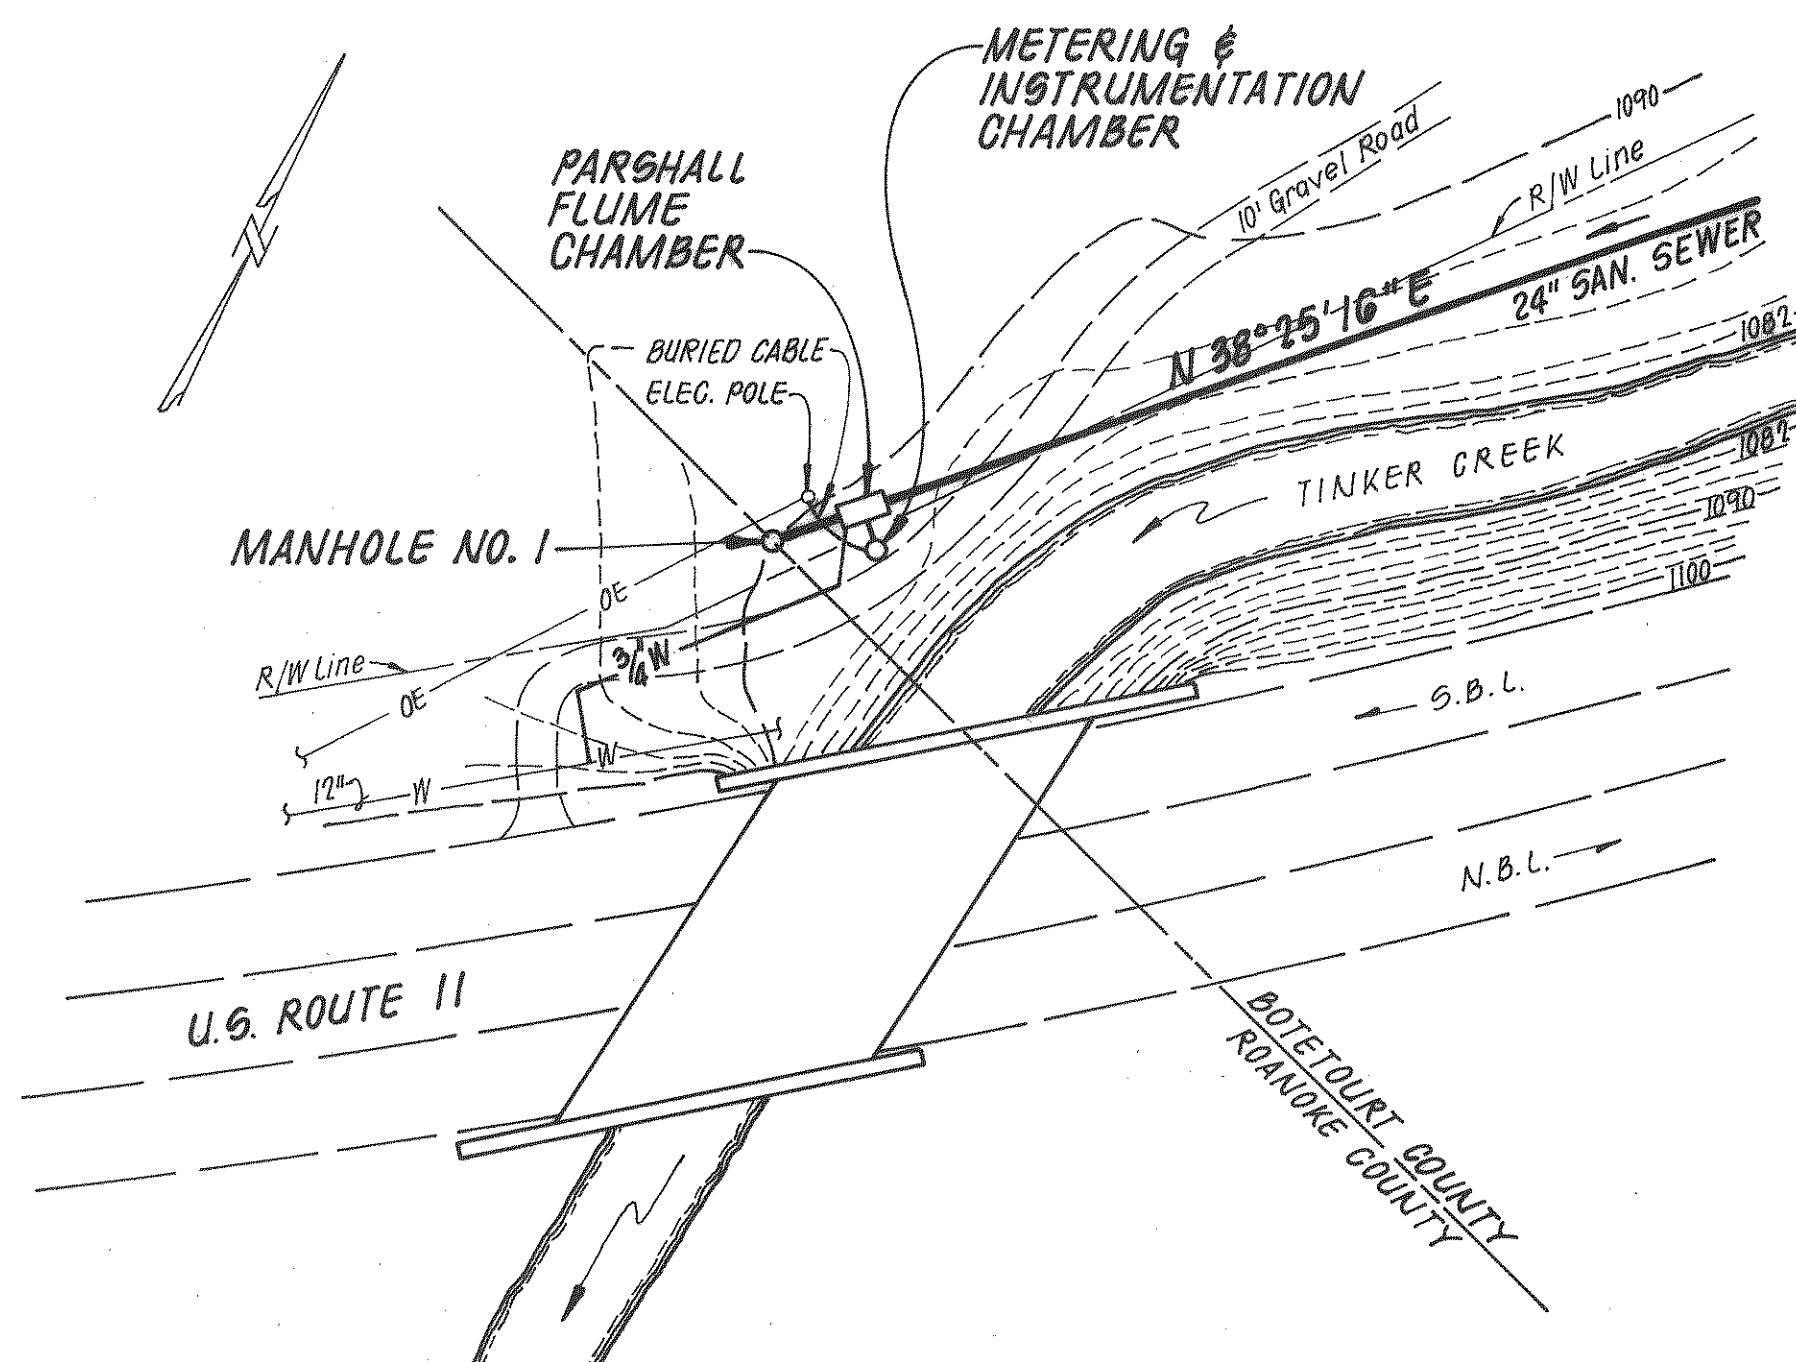

NOTE:
PLANS WERE PREPARED BASED ON:
AERIAL TOPOGRAPHY MAPPING PREPARED BY UNIVERSAL ENGINEERING, ROCKVILLE, MARYLAND FLOWN AND MAPPED 1979, AS CONTRACTED BY THE BOTETOURT COUNTY SERVICE AUTHORITY AND SUPPLIED TO CLEAN WATER ENGINEERS, INC.
HORIZONTAL AND VERTICAL GROUND CONTROL BY CHARLES R. McMURRAY, C.L.S., 1979, AS CONTRACTED BY THE BOTETOURT COUNTY SERVICE AUTHORITY AND SUPPLIED TO CLEAN WATER ENGINEERS, INC.
AS-BUILT INFORMATION WAS BASED ON EXISTING GROUND CONDITIONS AT COMPLETION OF CONSTRUCTION
PLAN VIEWS, SEWERLINE GRADES, MANHOLE INVERTS ARE ALL CORRECT BASED ON APPROVED "CUT-SHEET" DATA AS SUPPLIED TO CLEAN WATER ENGINEERS, INC. BY THE CONTRACTOR. THE GROUND PROFILE WAS NOT ADJUSTED TO REFLECT AS-BUILT CONDITIONS THEREFORE THE PROFILES MAY NOT BE TO SCALE HORIZONTALLY OR VERTICALLY. REFER TO THE NUMERICAL NOTES FOR HORIZONTAL DISTANCE AND SEWERLINE GRADES, DO NOT SCALE.

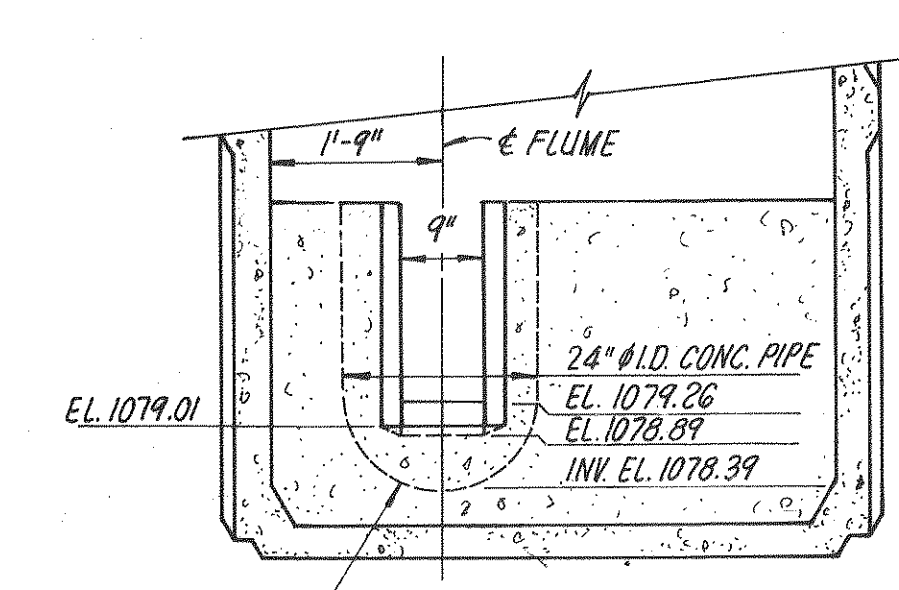

ALUM. SAFETY SIGN (MOUNTED TO WALL) TO READ:
CAUTION
DO NOT ENTER
VENTILATE
CHAMBER
BEFORE ENTERING
VENTILATION SWITCH
LOCATED IN
MANHOLE

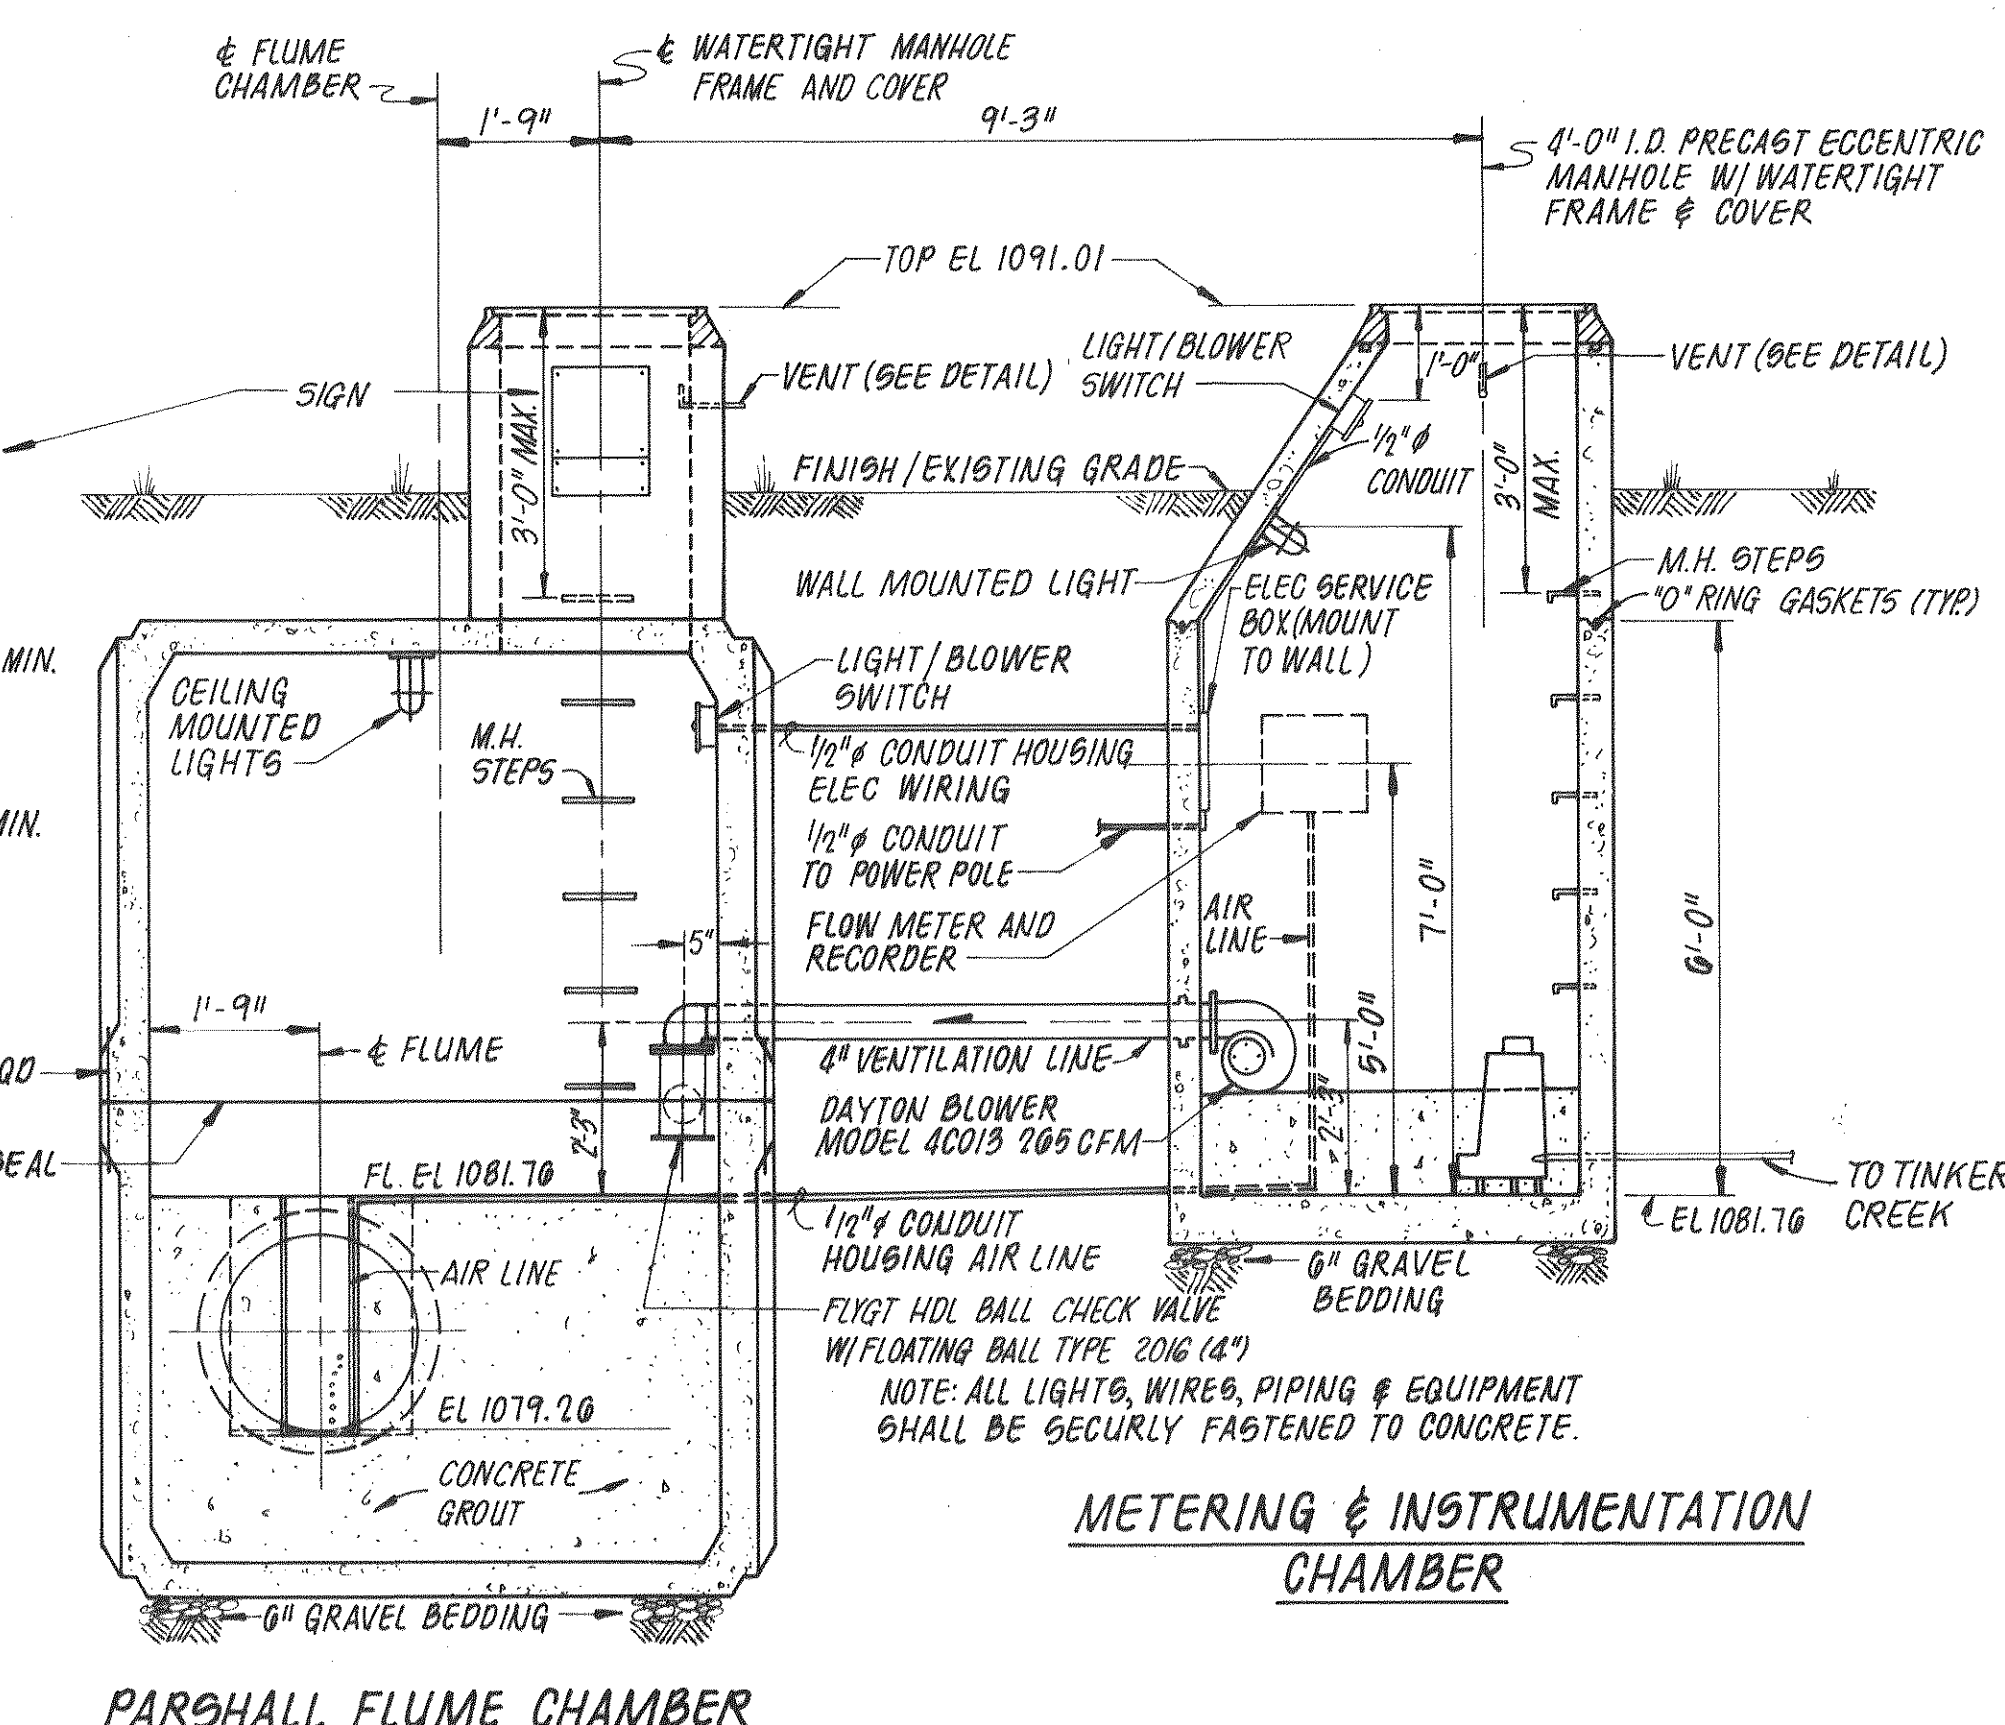

REVISED FROM
SHEET 17 OF 18 DATED 9-28-79

Designed: DJR/JMD
Drafted: RSM/CLA
Checked: CEP/JMD
Approved: DJR

Clean Water Engineers, Inc.
Fincastle, Virginia

TINKER CREEK INTERCEPTOR
FOR
BOTETOURT COUNTY SERVICE AUTHORITY
"AS BUILTS"

Sheet: 17 of 18
Scale: AS SHOWN
Date: 10-21-81
Project: 7930