
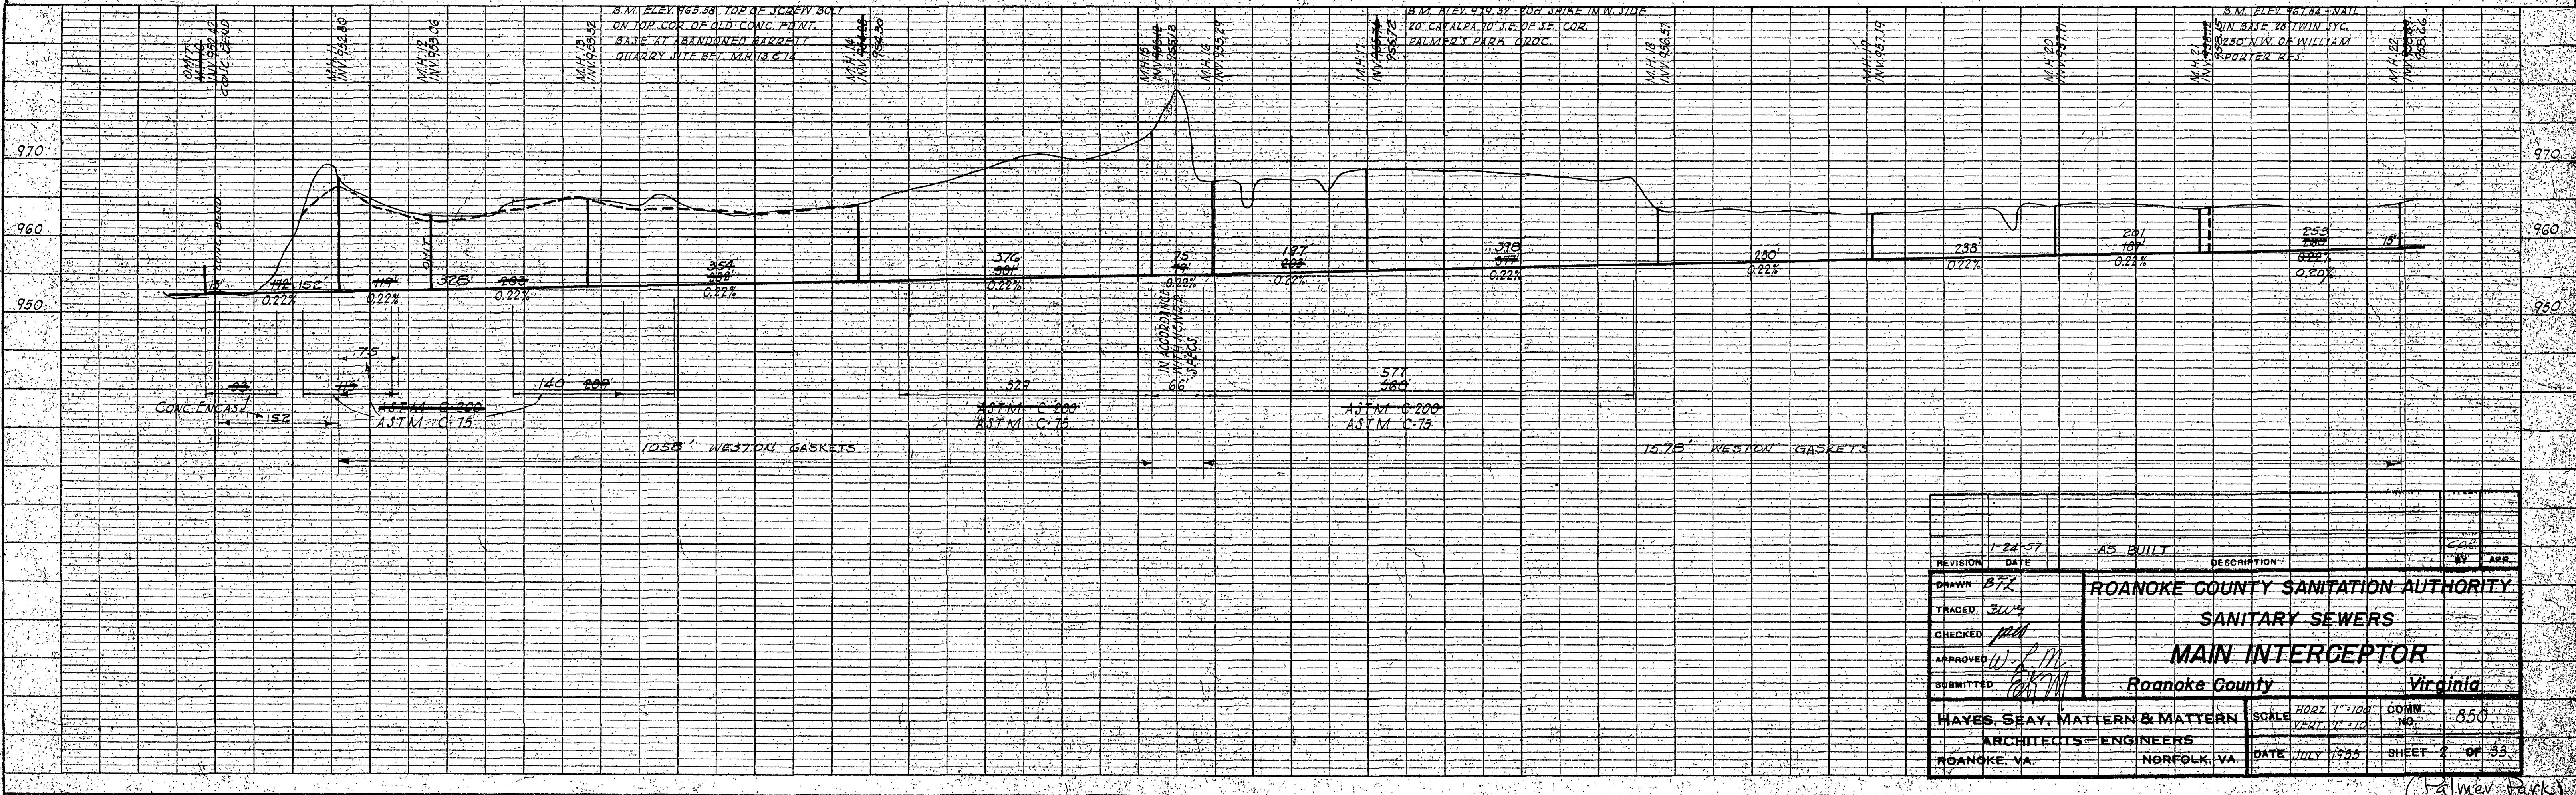


PLAN	DATE	
	BY	
	SURVEYED	
	NOTE BOOK	

PROFILE	DATE	
	BY	
	NOTED	
	NOTE BOOK	

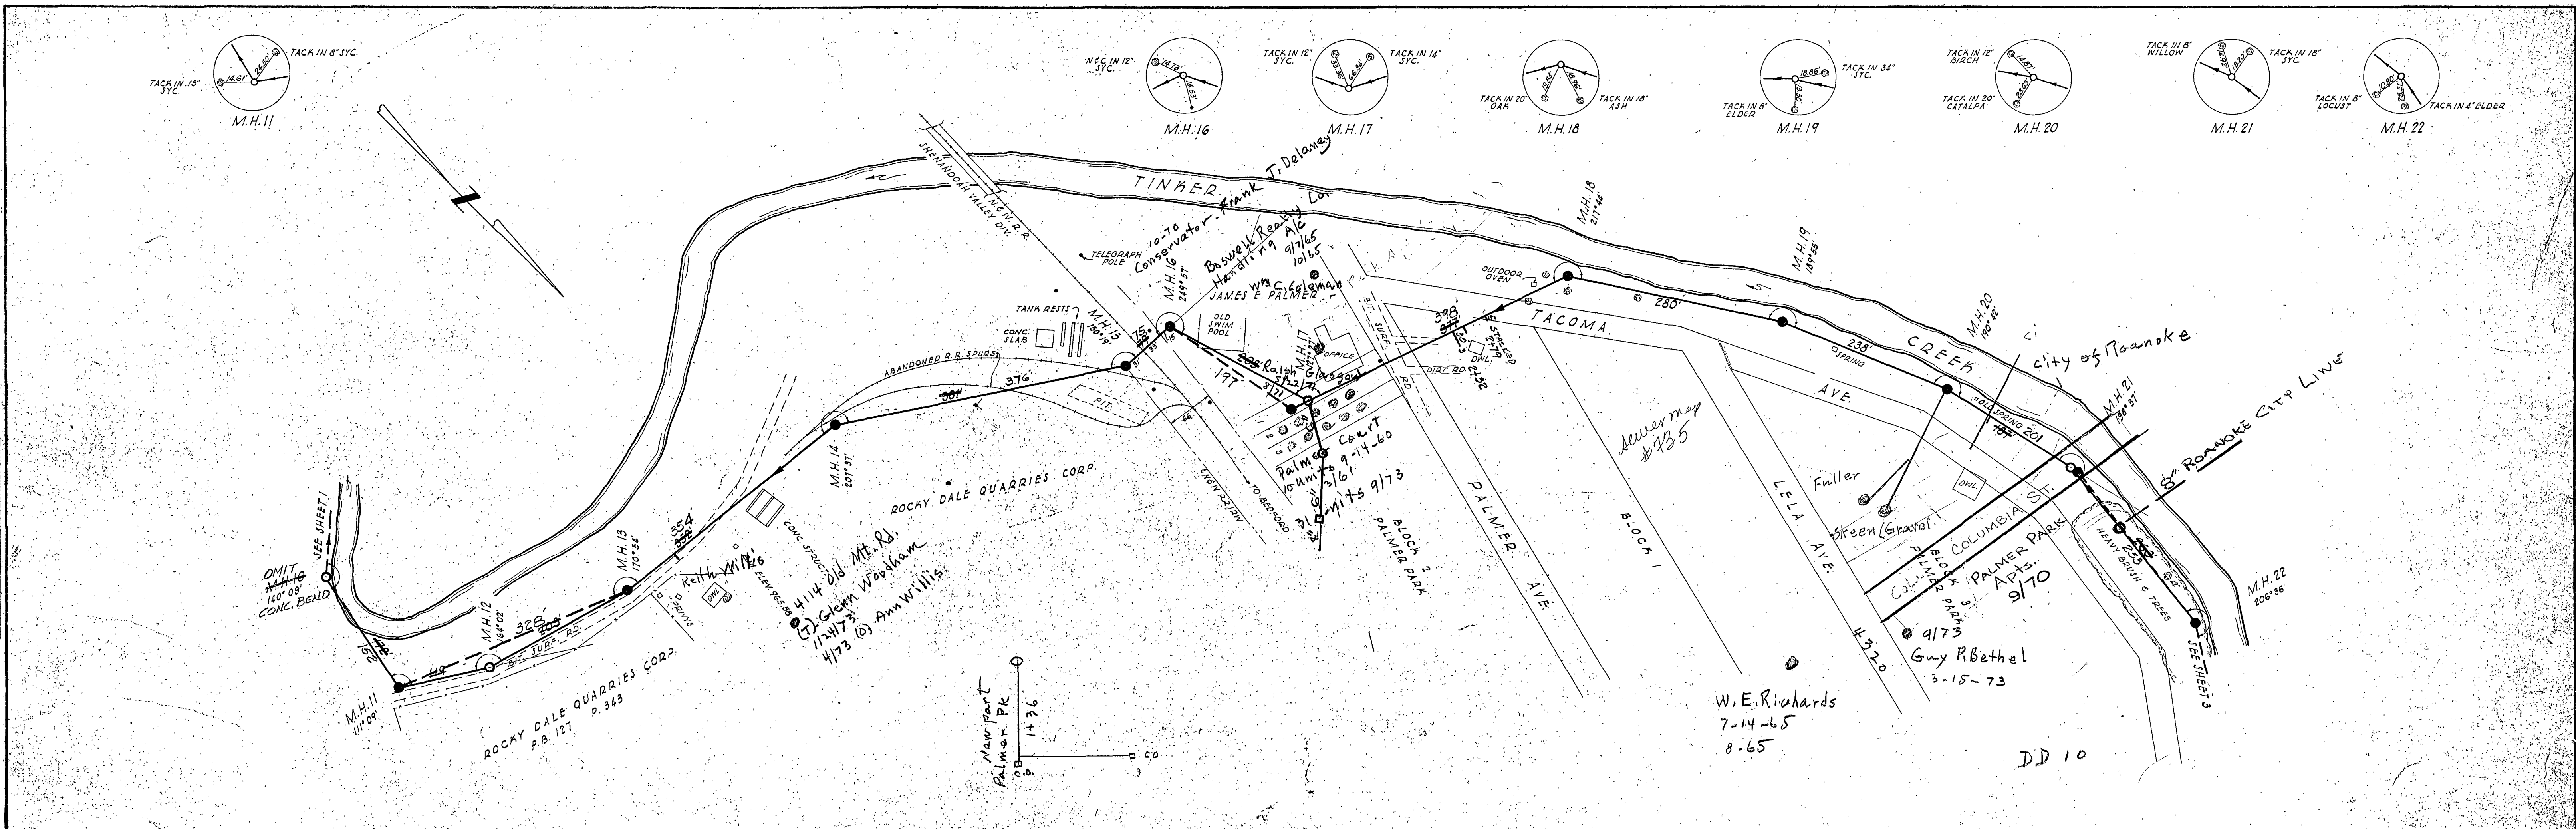

REVISION	DATE	DESCRIPTION	BY	APP.
1	7-24-37	AS BUILT		
ROANOKE COUNTY SANITATION AUTHORITY SANITARY SEWERS MAIN INTERCEPTOR Roanoke County, Virginia				
DRAWN BY <i>BTL</i> TRACED BY <i>BLW</i> CHECKED <i>W. E. Richards</i> APPROVED <i>W. E. Richards</i> SUBMITTED <i>W. E. Richards</i>		SCALE: HORIZ. 1" = 100' VERT. 1" = 10' DATE: JULY 1935 SHEET 2 OF 33		