



PLAN	SURVEYED	DATE
	PLOTTED	BY
	NOTE BOOK	CHECKED
	NO.	RT. OF WAY CHECKED

PROFILE	SURVEYED	DATE
	PLOTTED	BY
	NOTE BOOK	CHECKED
	NO.	STRUCTURE NOTATIONS CHKD

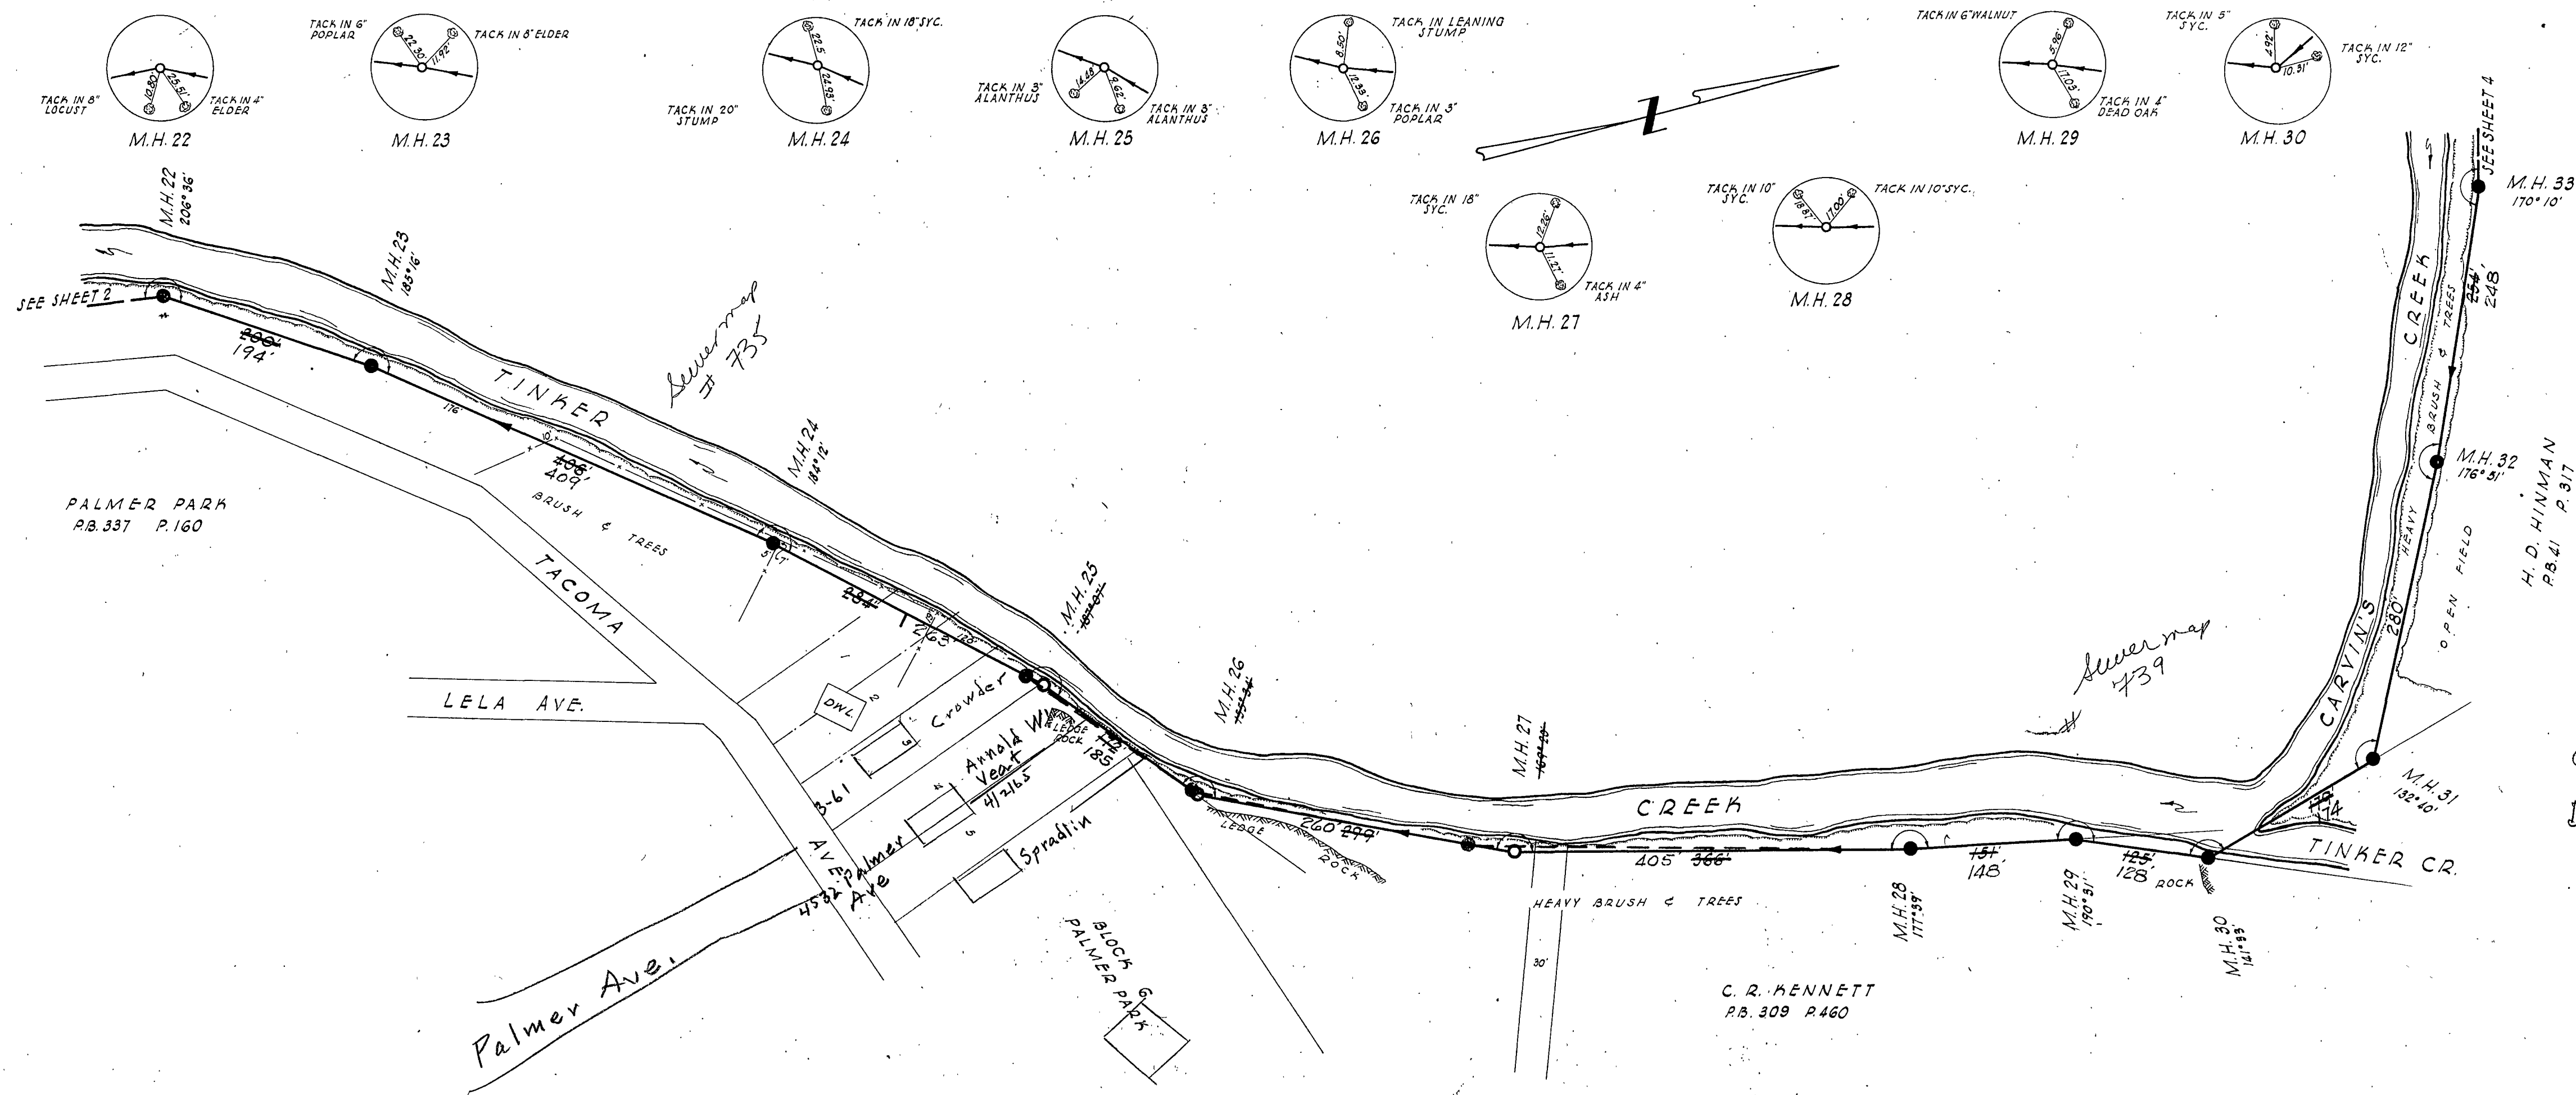

CC 10
DD 10

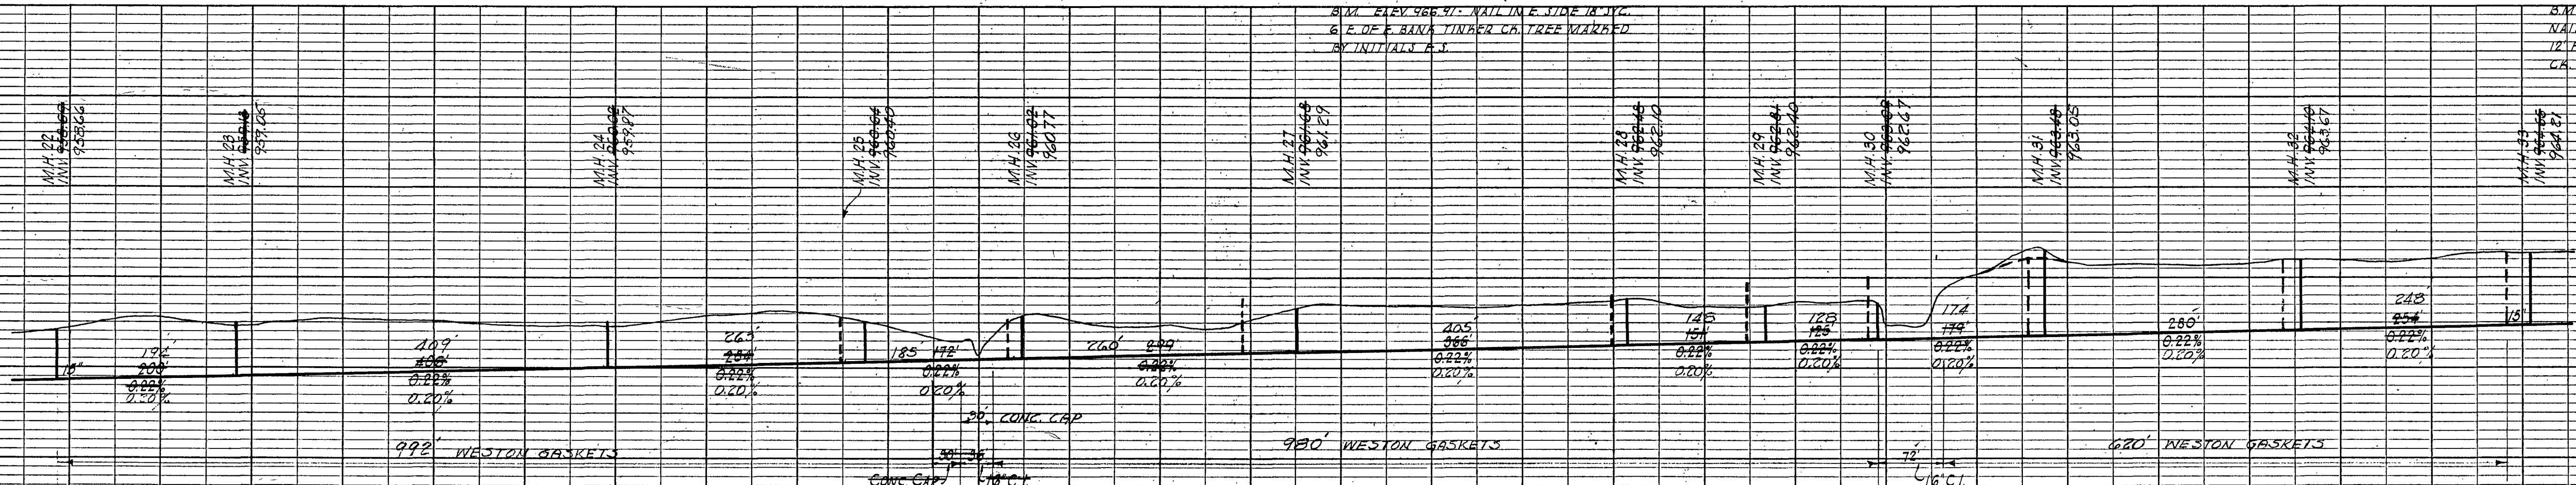

REVISION	DATE	DESCRIPTION	BY	APP.
1-24-57		AS BUILT		
DRAWN	BTX	ROANOKE COUNTY SANITATION AUTHORITY		
TRACED	SW	SANITARY SEWERS		
CHECKER	W. L. M.	MAIN INTERCEPTOR		
APPROVED	W. L. M.	Roanoke County		
SUBMITTED	W. L. M.	Virginia		
HAYES, SEAY, MATERN & MATERN		SCALE	HORIZ. 1"=100'	VERT. 1"=10'
ARCHITECTS - ENGINEERS		DATE	JULY 1955	SHEET 3 OF 33
ROANOKE, VA.		NORFOLK, VA.		

(Palmer Park)
Tinker Creek