


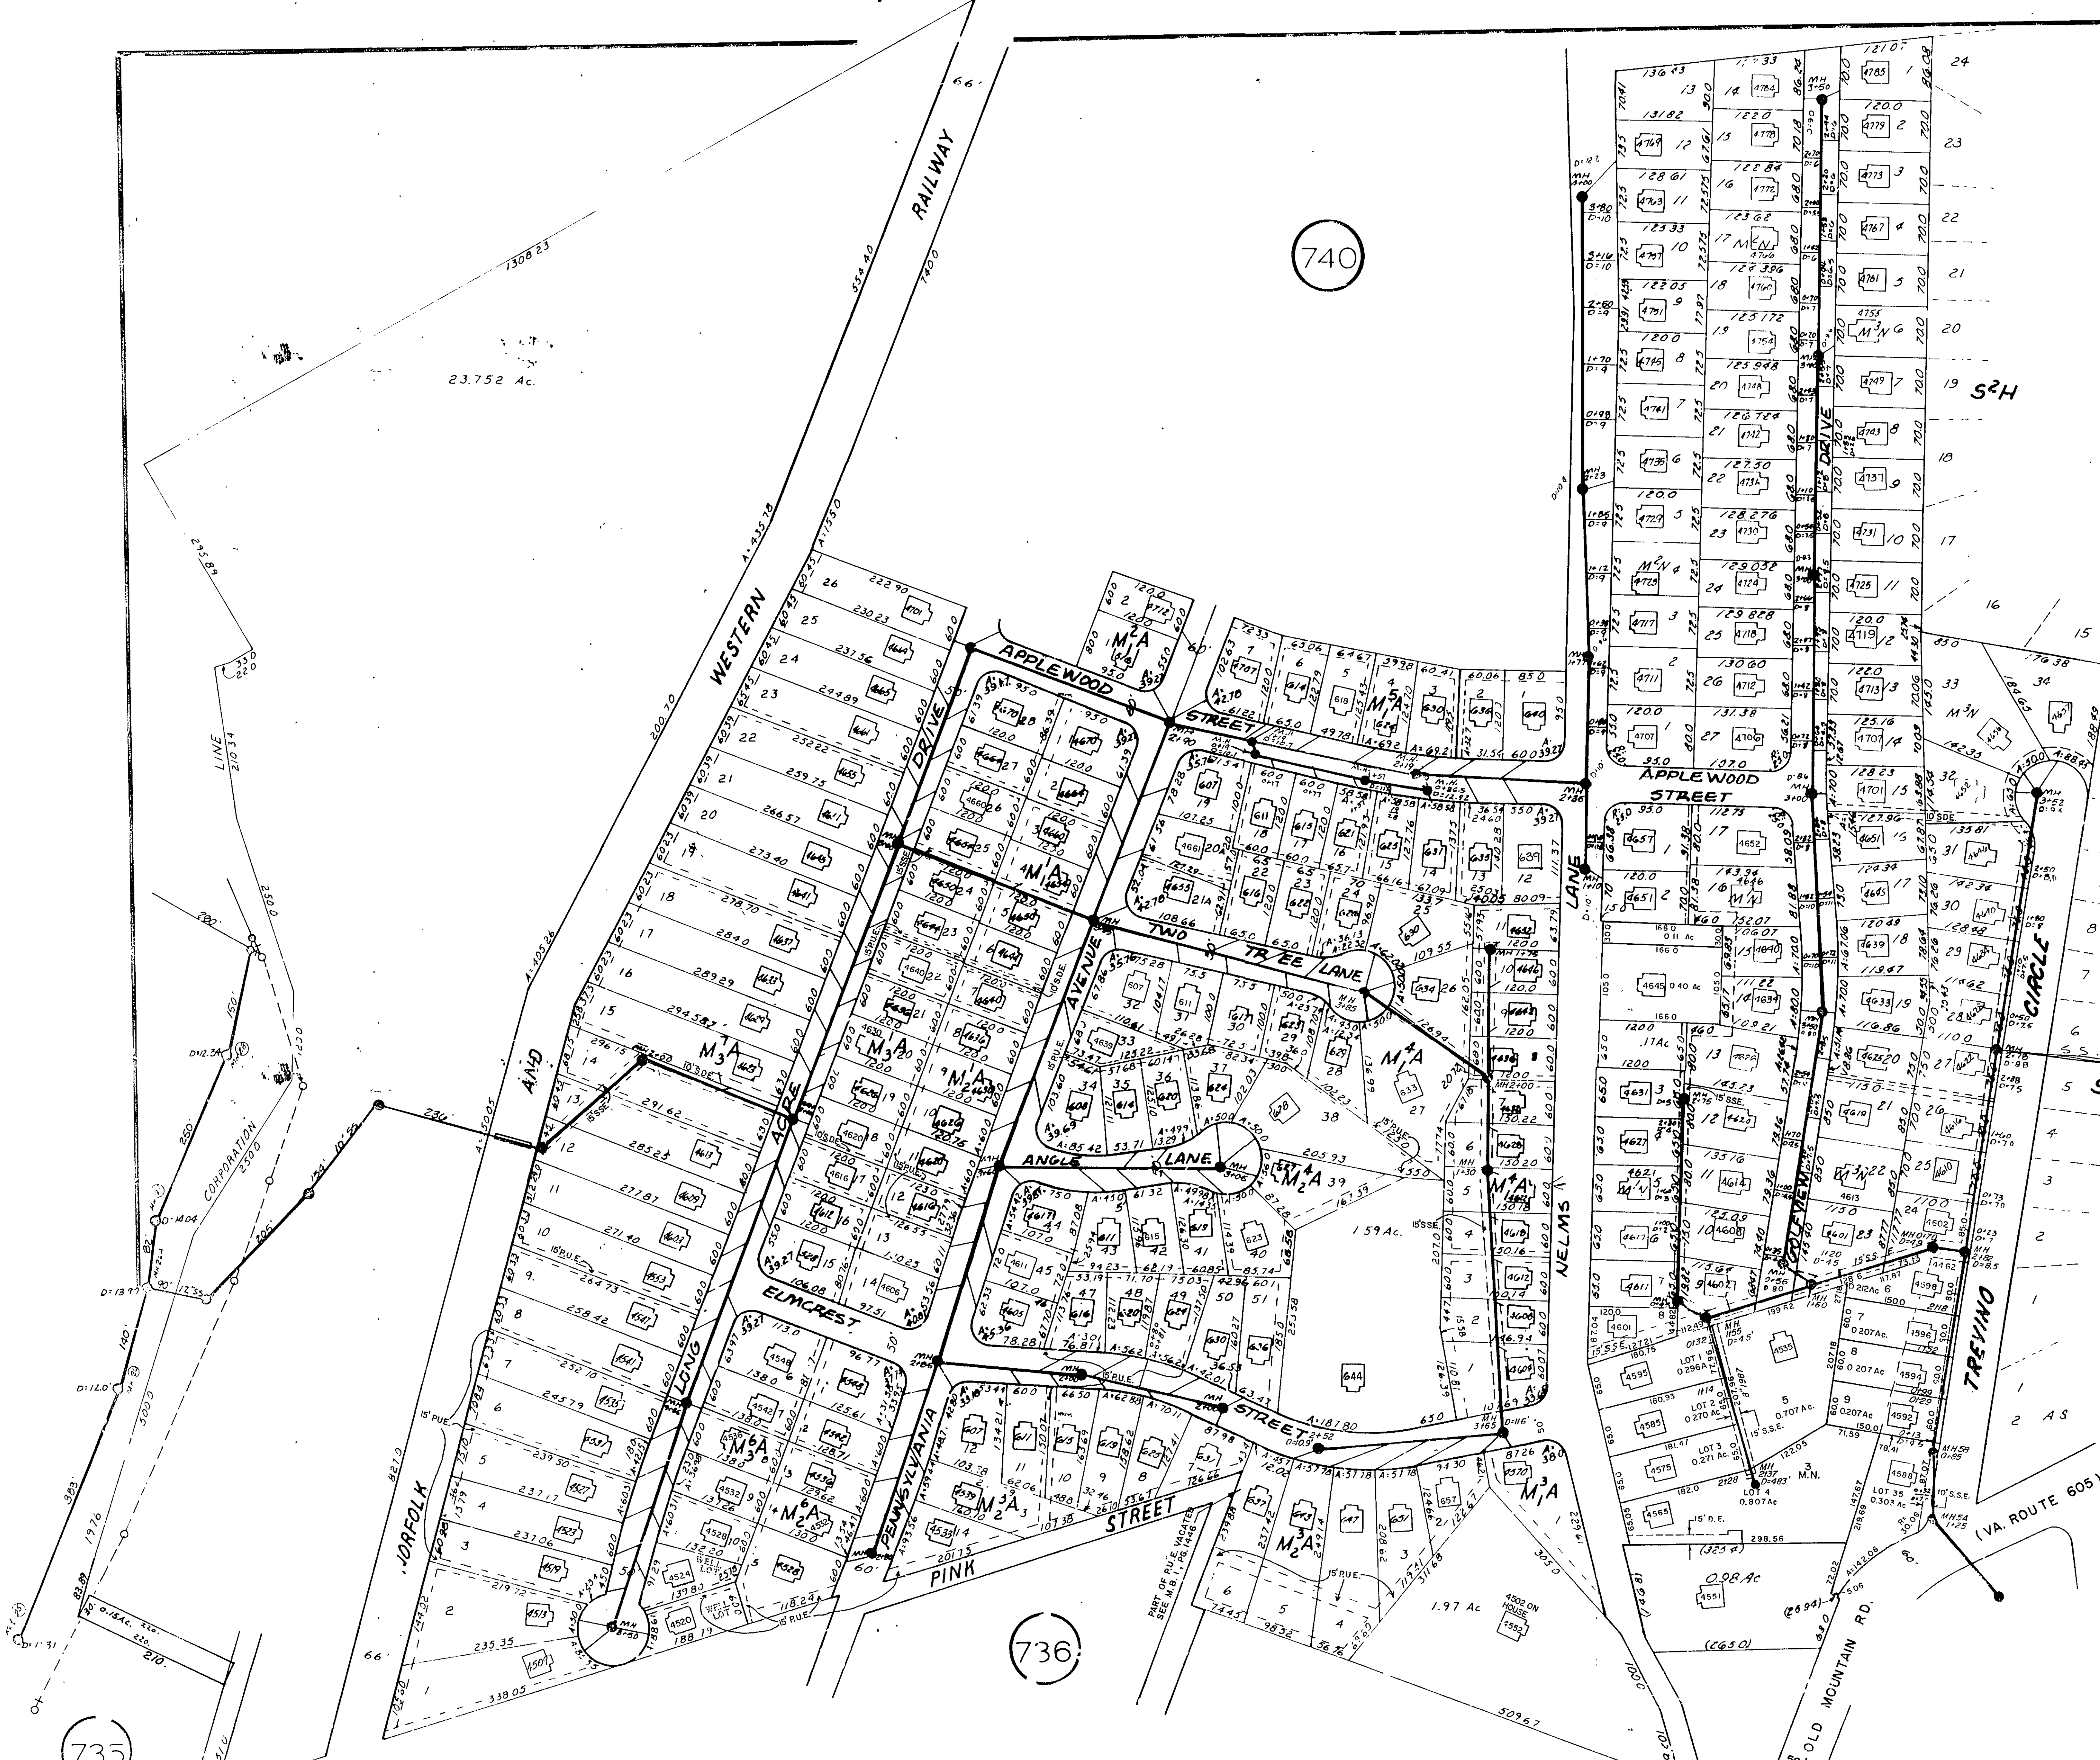

3. (SECTION THREE) 6308
M.N. - MONTEREY NORTH, M.B.I., PG. 633 - PLAN NO. 6040
A.S. - ASHBURY SUB PB 3, PG. 79
M.A. - MEADOWVIEW ACRES SEC. 1, PB 8, PG. 28
M₂A. " " SEC. 2, PB 8, PG. 42
M₃A. " " SEC. 3, PB 8, PG. 50
M.N. - MONTEREY NORTH PB 3 PG. 53
S.H. - SLEEPY HOLLOW PB 9, PG. 46
() - DISTANCE TO POINT IN ROAD

SEWER MAP
CITY OF ROANOKE VA.
SHEET NO 739
OFFICE OF THE CITY ENGINEER

DRAWN BY	DATE
FIELD WORK BY	DATE
RECORD WORK BY	DATE
CHECKED BY	DATE
SCALE 1"=100'	REVISED

CITY ENGINEER