

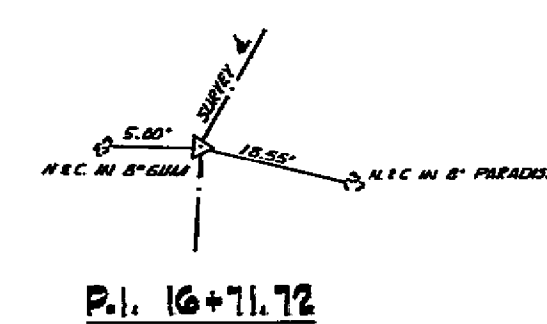
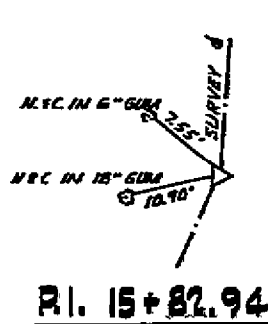
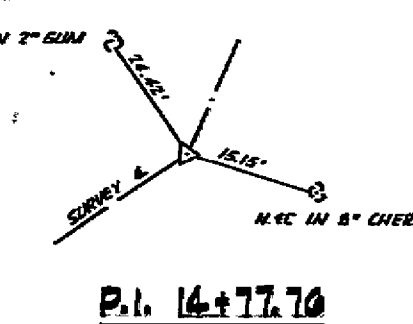
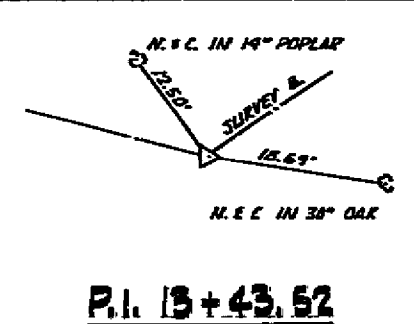
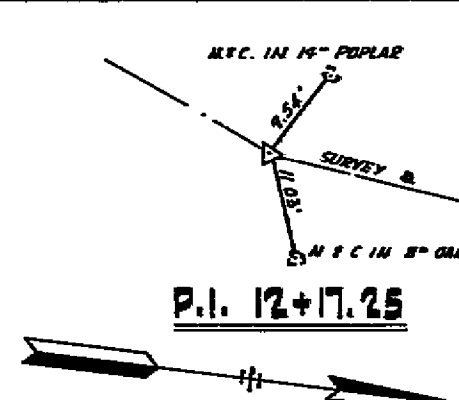
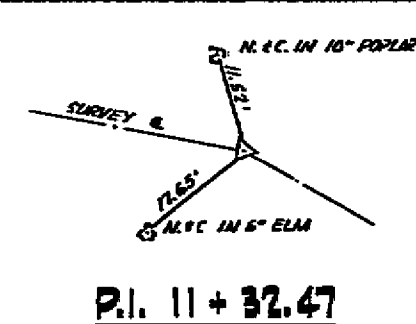
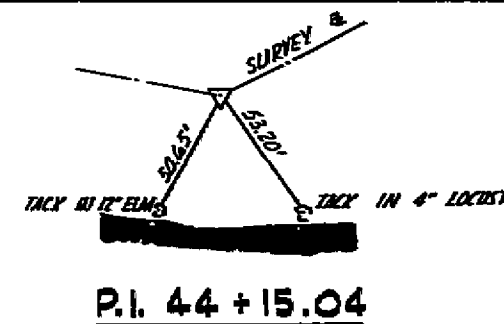



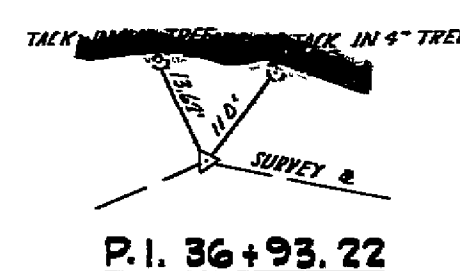


TAX MAP #
38.08-3-28

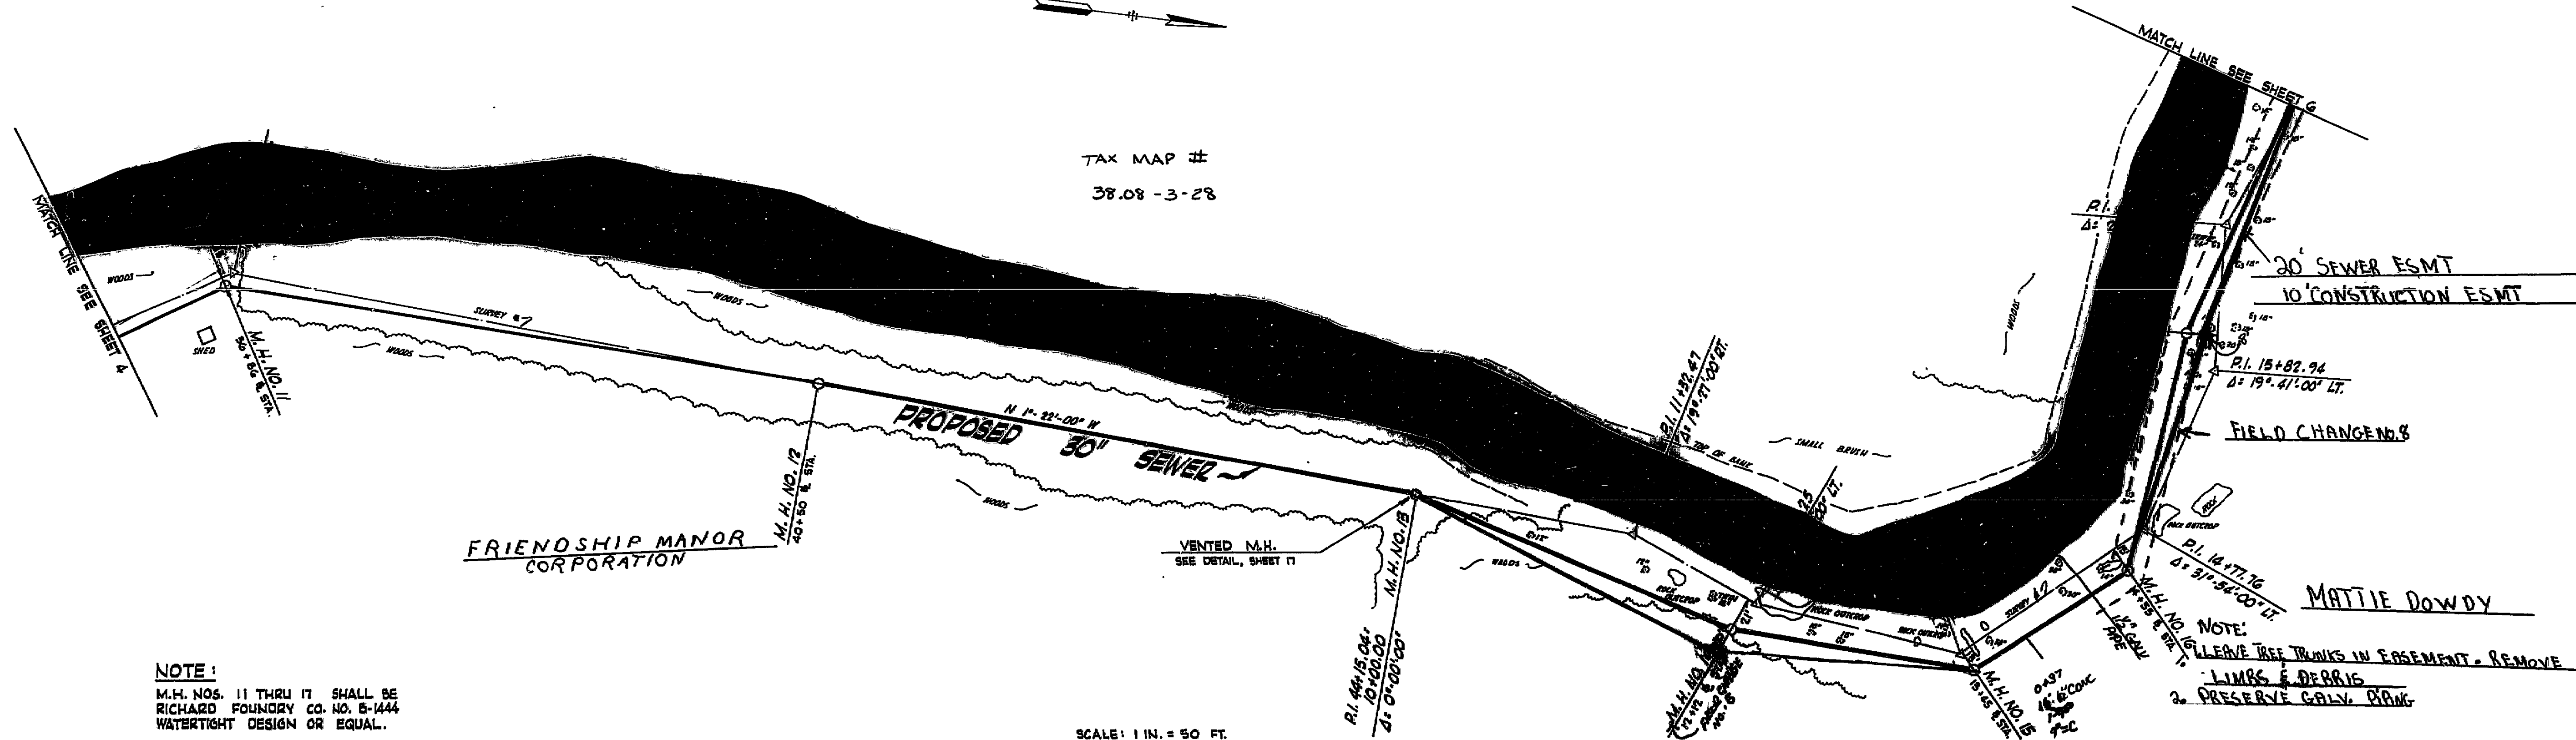

NOTE:
M.H. NOS. 11 THRU 17 SHALL BE
RICHARD FOUNDRY CO. NO. 8-1444
WATERTIGHT DESIGN OR EQUAL.

SCALE: 1 IN. = 50 FT.

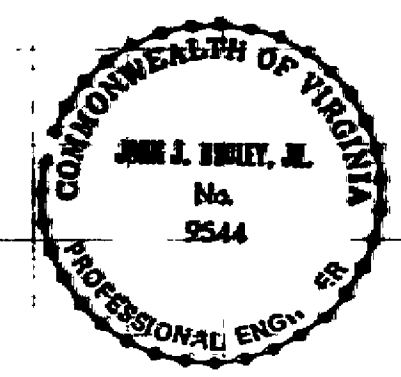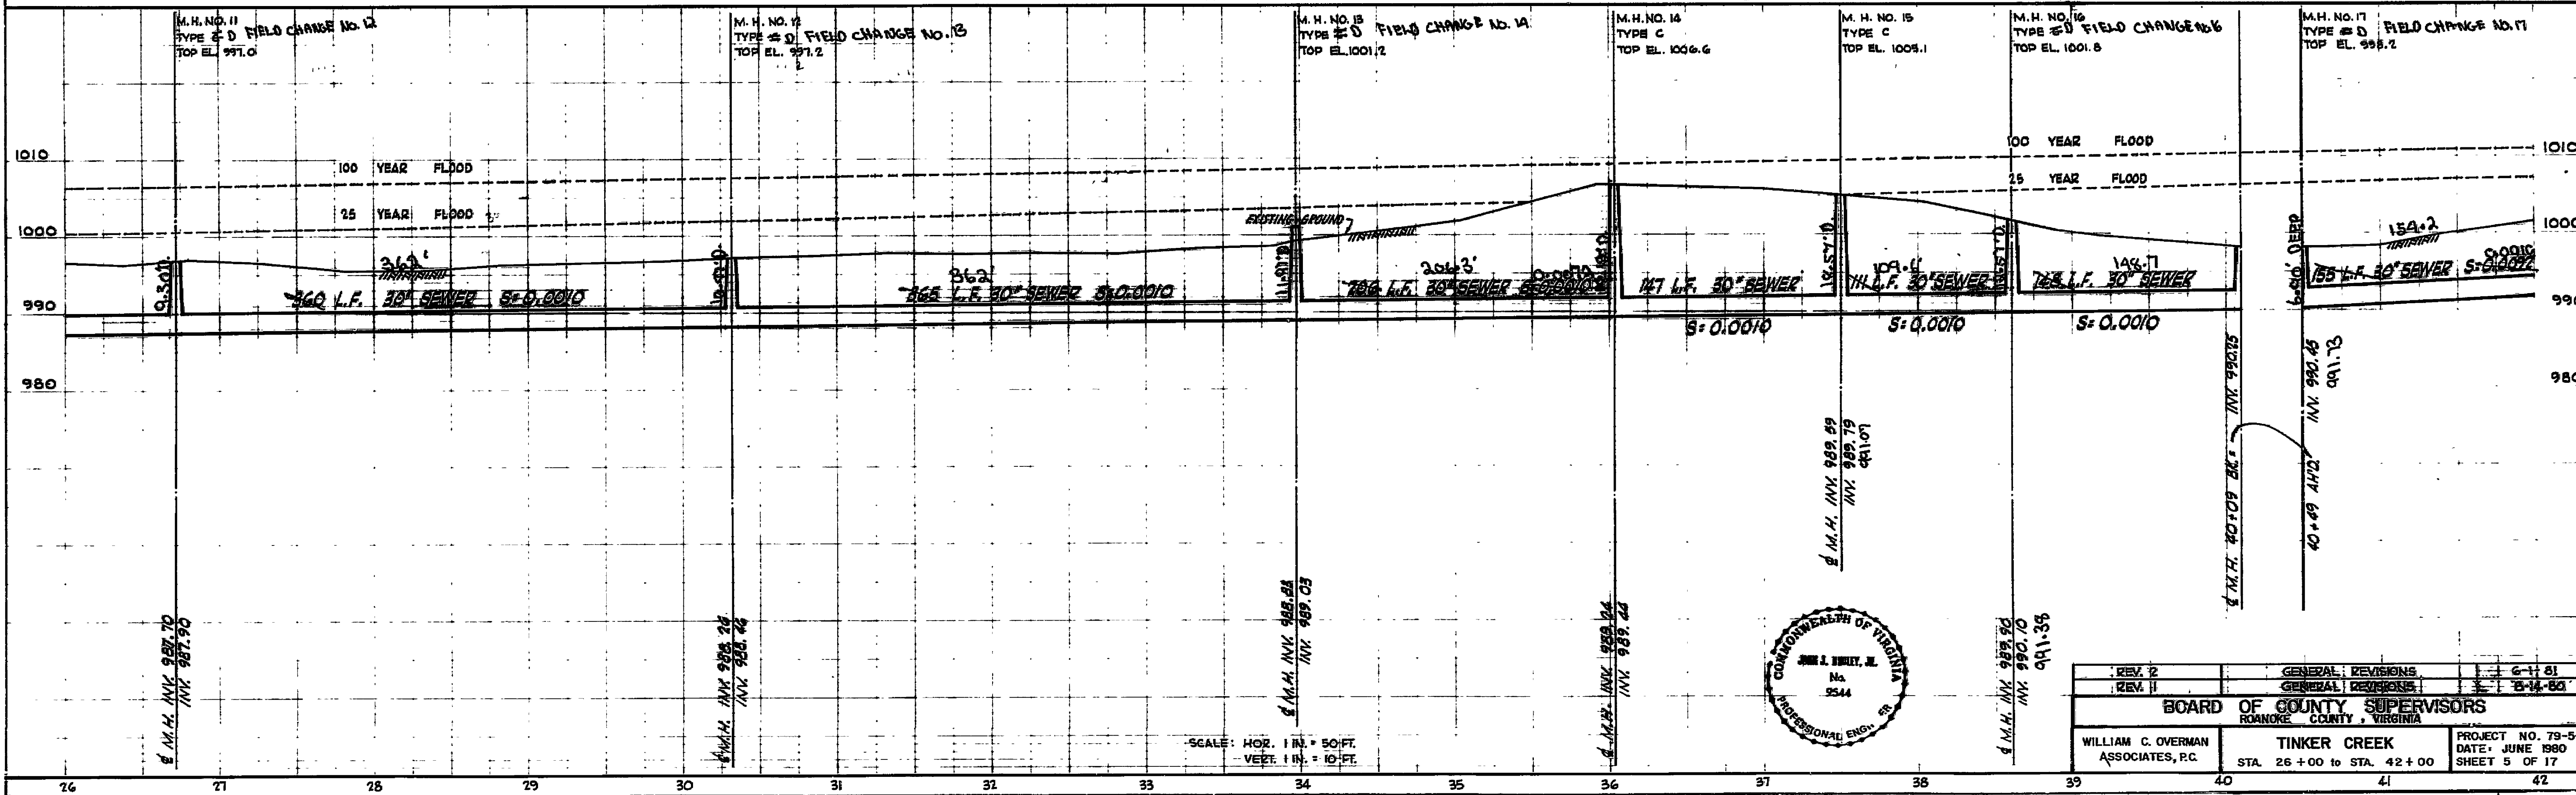

REV.	DESCRIPTION	DATE
REV. 2	GENERAL REVISIONS	6-11-81
REV. 1	GENERAL REVISIONS	5-14-80
BOARD OF COUNTY SUPERVISORS		
ROANOKE COUNTY, VIRGINIA		
WILLIAM C. OVERMAN	TINKER CREEK	PROJECT NO. 79-5-S
ASSOCIATES, P.C.	STA. 26+00 TO STA. 42+00	DATE: JUNE 1980
		SHEET 5 OF 17

BUTLER BLUEPRINT
Norfolk Va. - Virginia Beach Va.

C-510535-03
SI- 0081