

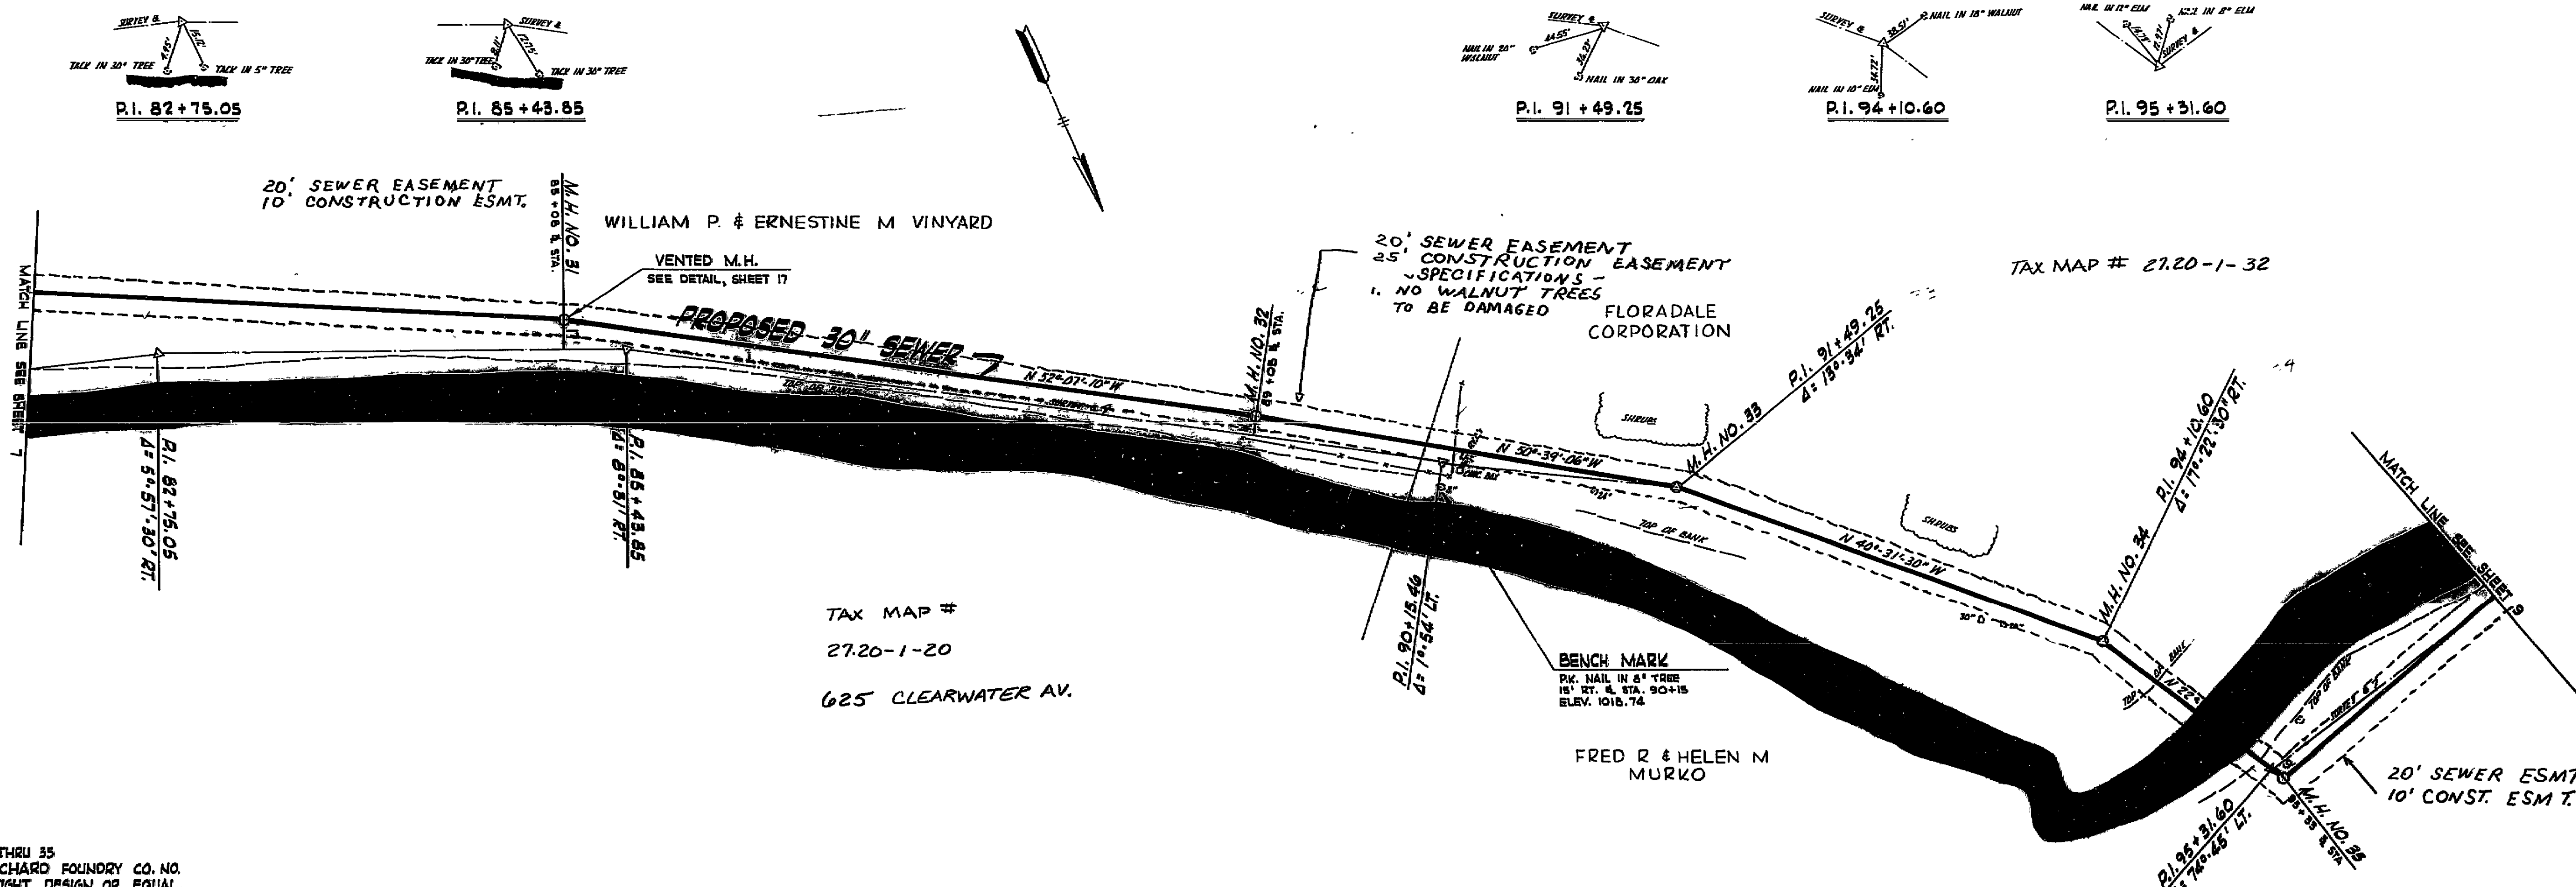


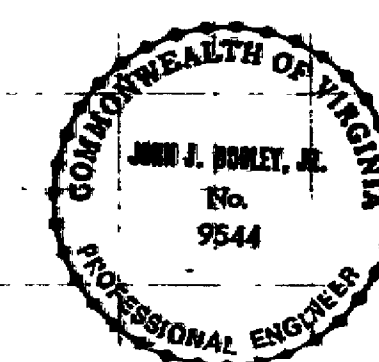

NOTE:
M.H. NOS. 31 THRU 35
SHALL BE RICHARD ROUNDRY CO. NO.
B-1444 WATER TIGHT DESIGN OR EQUAL.

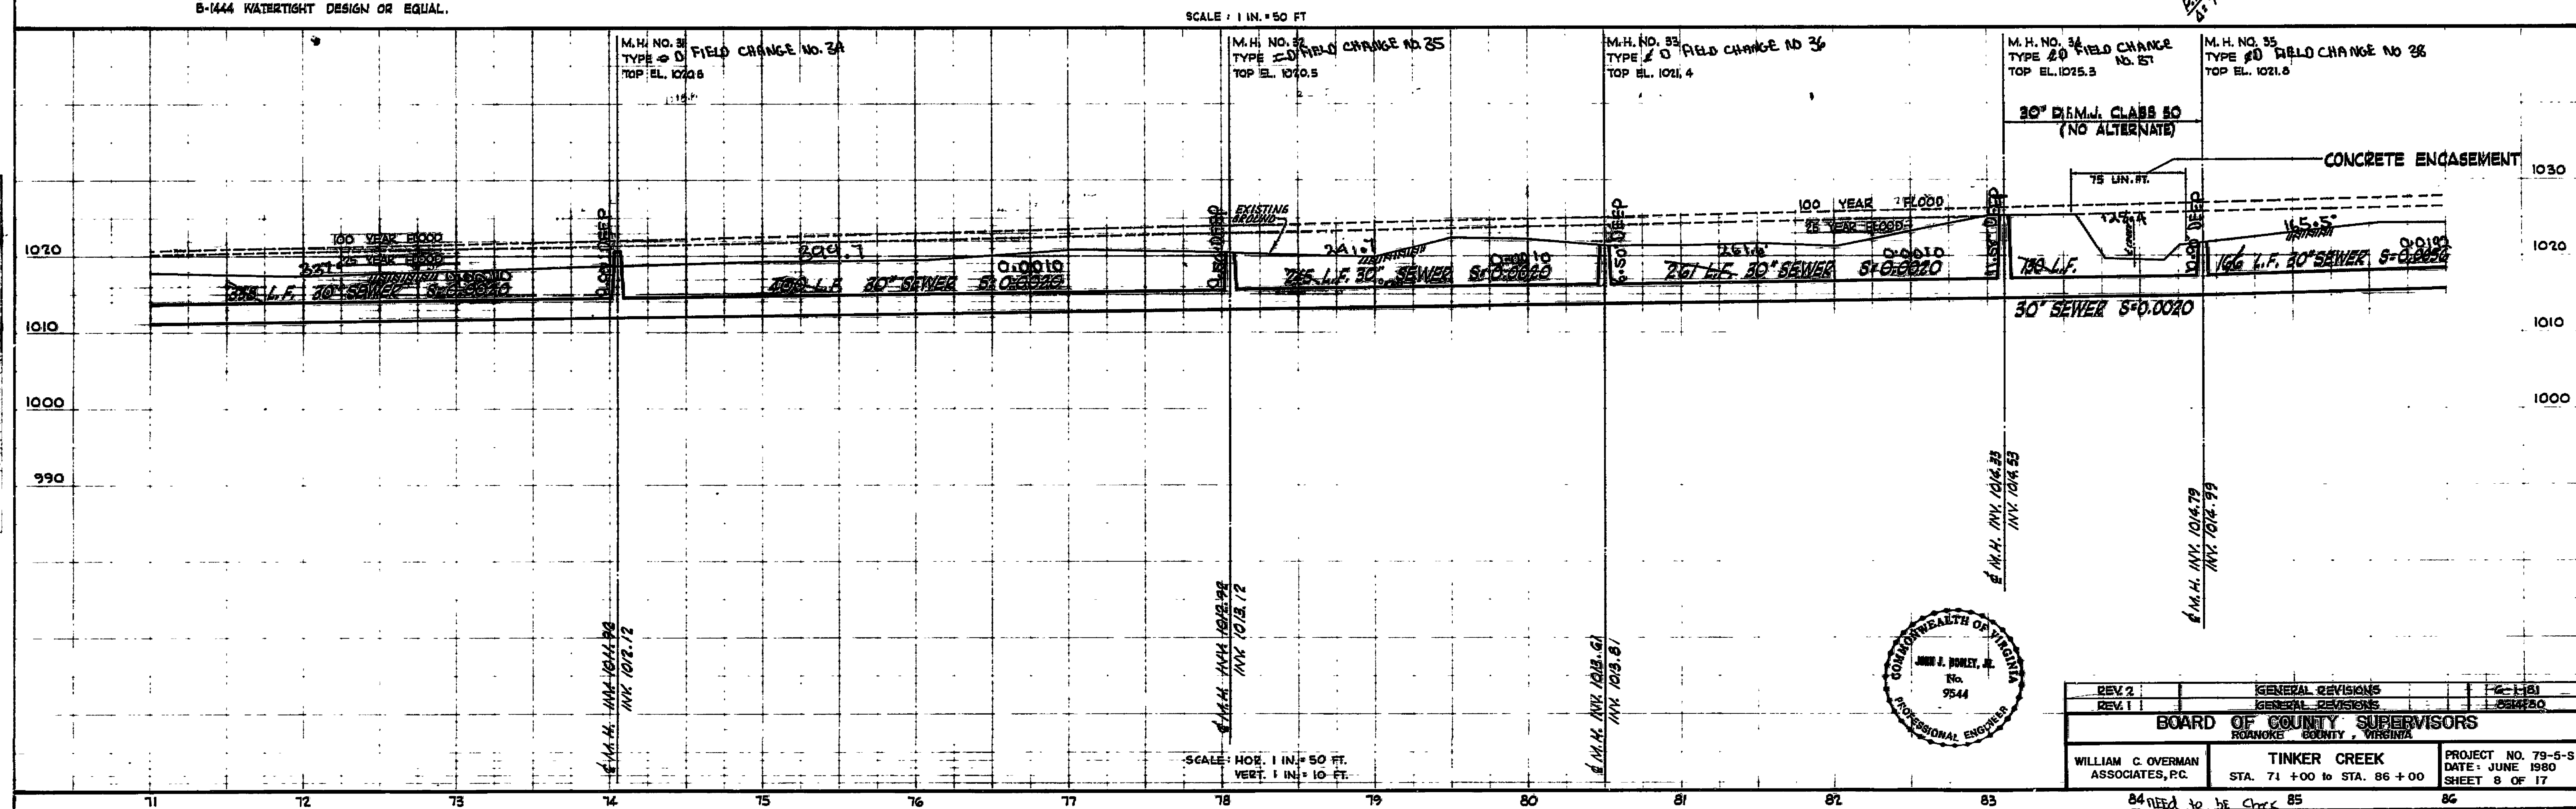

REV.	DESCRIPTION	DATE
REV. 2	GENERAL REVISIONS	2-1-81
REV. 1	GENERAL REVISIONS	2-1-81
BOARD OF COUNTY SUPERVISORS		
ROANOKE COUNTY, VIRGINIA		
WILLIAM C. OVERMAN	TINKER CREEK	PROJECT NO. 79-5-S
ASSOCIATES, P.C.	STA. 71+00 TO STA. 86+00	DATE: JUNE 1980
		SHEET 8 OF 17

C-510535-03

SI-0084