

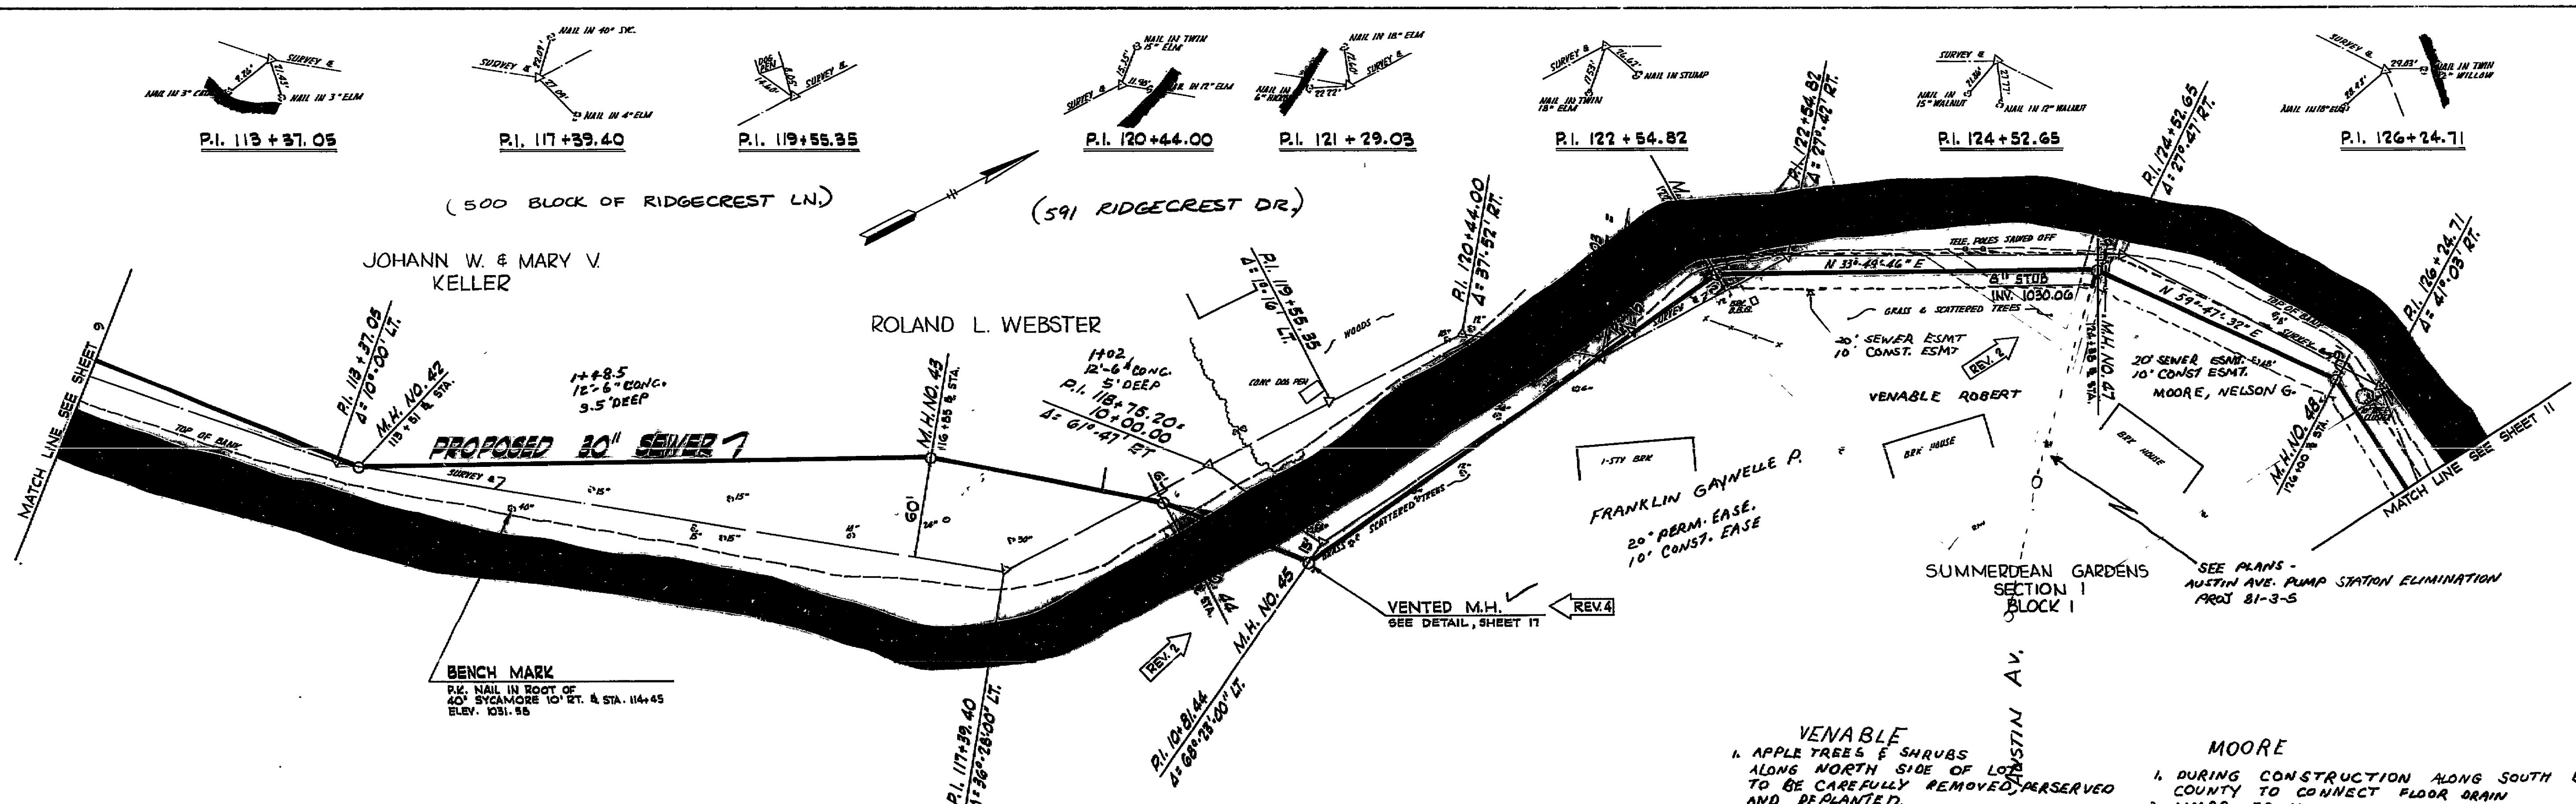


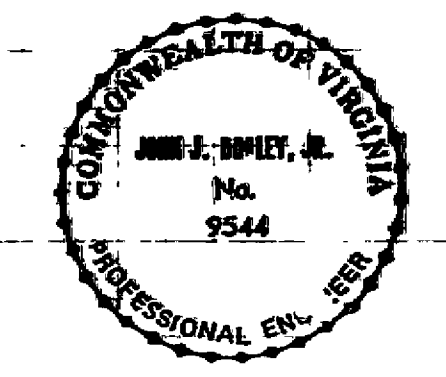

NOTE:
M.H. NOS. 42 THRU 46 SHALL BE
RICHARD FOUNDRY CO. NO. 5-1444
WATERTIGHT DESIGN OR EQUAL.

VENABLE
1. APPLE TREES & SHRUBS
ALONG NORTH SIDE OF LOT
TO BE CAREFULLY REMOVED, PRESERVED
AND REPLANTED.
2. NO LARGE TREES TO BE DISTURBED

MOORE
1. DURING CONSTRUCTION ALONG SOUTH BOUNDARY
COUNTY TO CONNECT FLOOR DRAIN
2. LIMBS FROM ORANGE TREE ARE
NOT TO BE CUT.
3. ANY TREE LIMBS CUT THAT FALL IN CREEK
OR ELSEWHERE ARE TO BE REMOVED.
4. ONLY ACCESS TO SEWER LINE ALONG

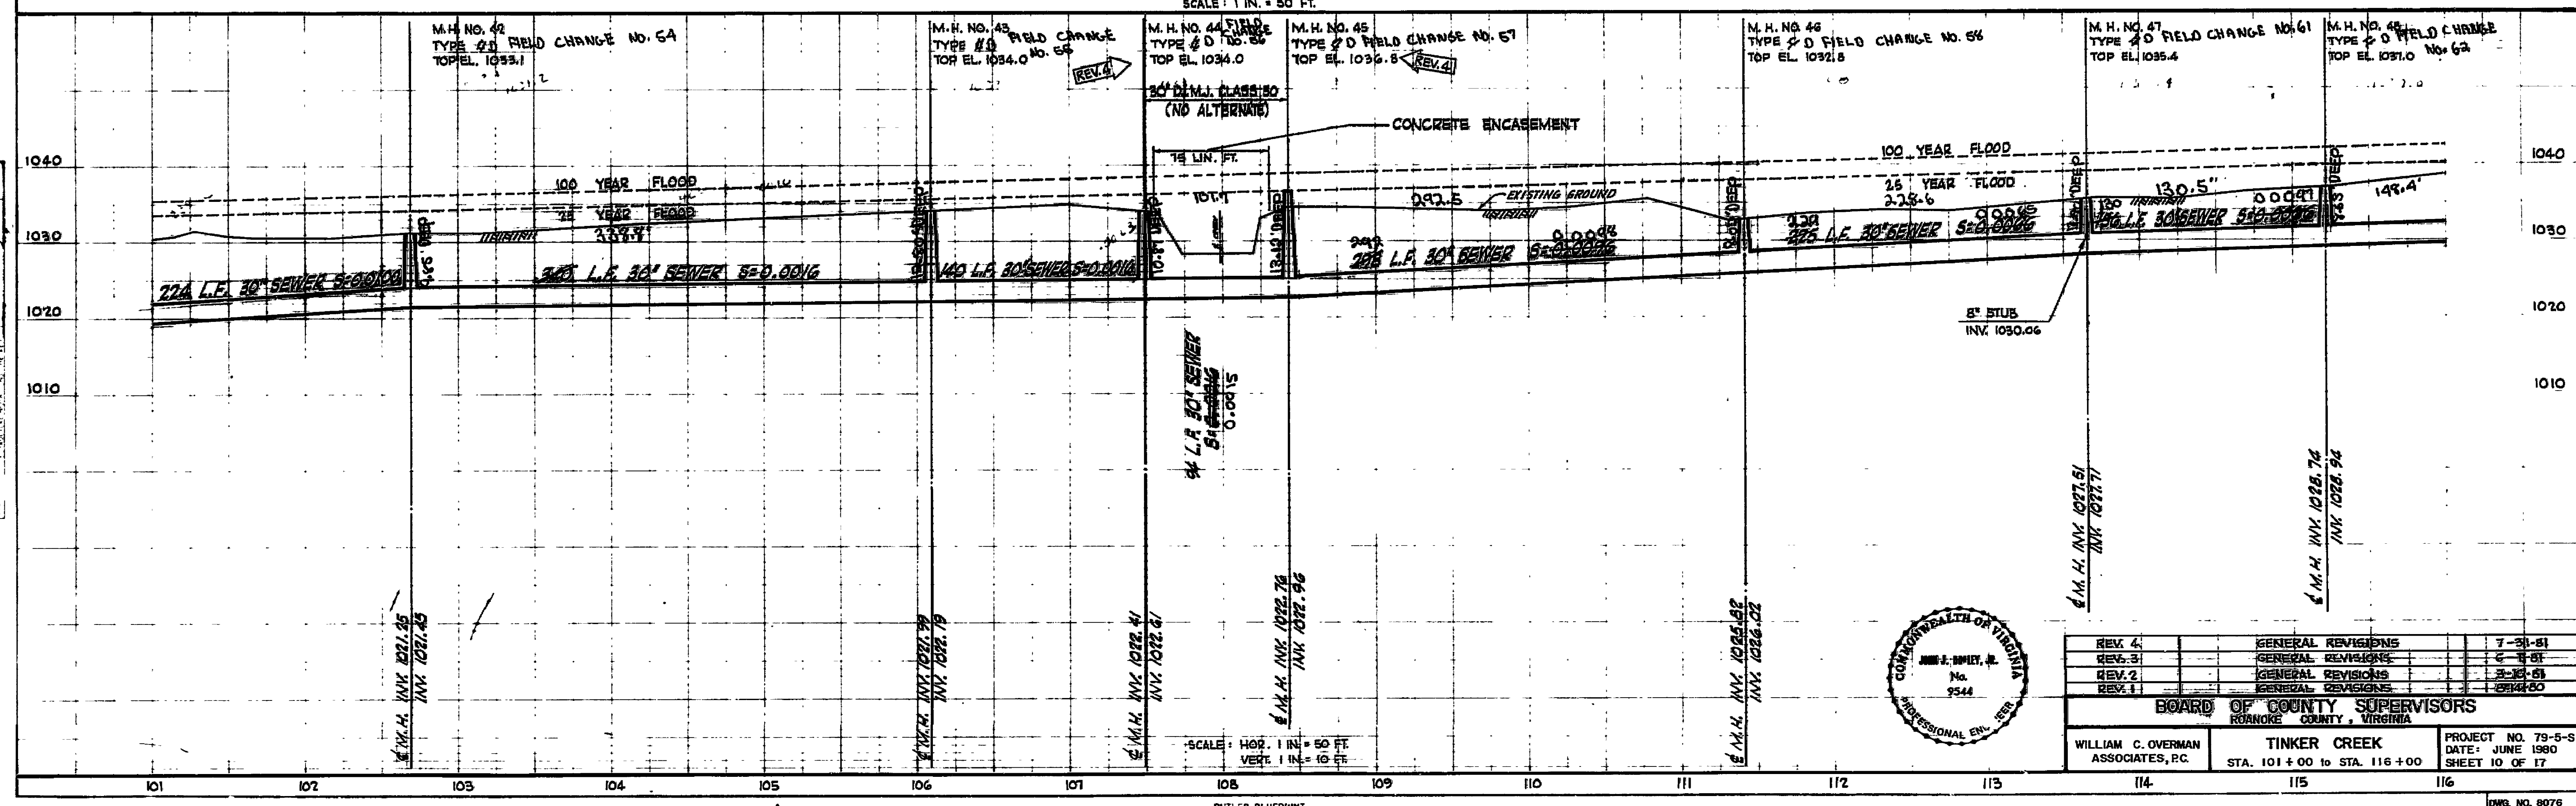

REV.	GENERAL REVISIONS	DATE
REV. 4	GENERAL REVISIONS	7-31-81
REV. 3	GENERAL REVISIONS	6-1-81
REV. 2	GENERAL REVISIONS	3-18-81
REV. 1	GENERAL REVISIONS	1-29-80

BOARD OF COUNTY SUPERVISORS
ROANOKE COUNTY, VIRGINIA

WILLIAM C. OVERMAN ASSOCIATES, P.C.	TINKER CREEK STA. 101+00 TO STA. 116+00	PROJECT NO. 79-5-S DATE: JUNE 1980 SHEET 10 OF 17
--	--	---

Need to Check
C-510535-03
SI-0086