




NOTE:
M.H. NOS. 56 THRU 63 SHALL BE
RICHARD FOUNDRY CO. NO. B-1444
WATERTIGHT DESIGN OR EQUAL.

SCALE: 1 IN. = 50 FT.

SCALE: HOR. 1 IN. = 50 FT.
VERT. 1 IN. = 10 FT.

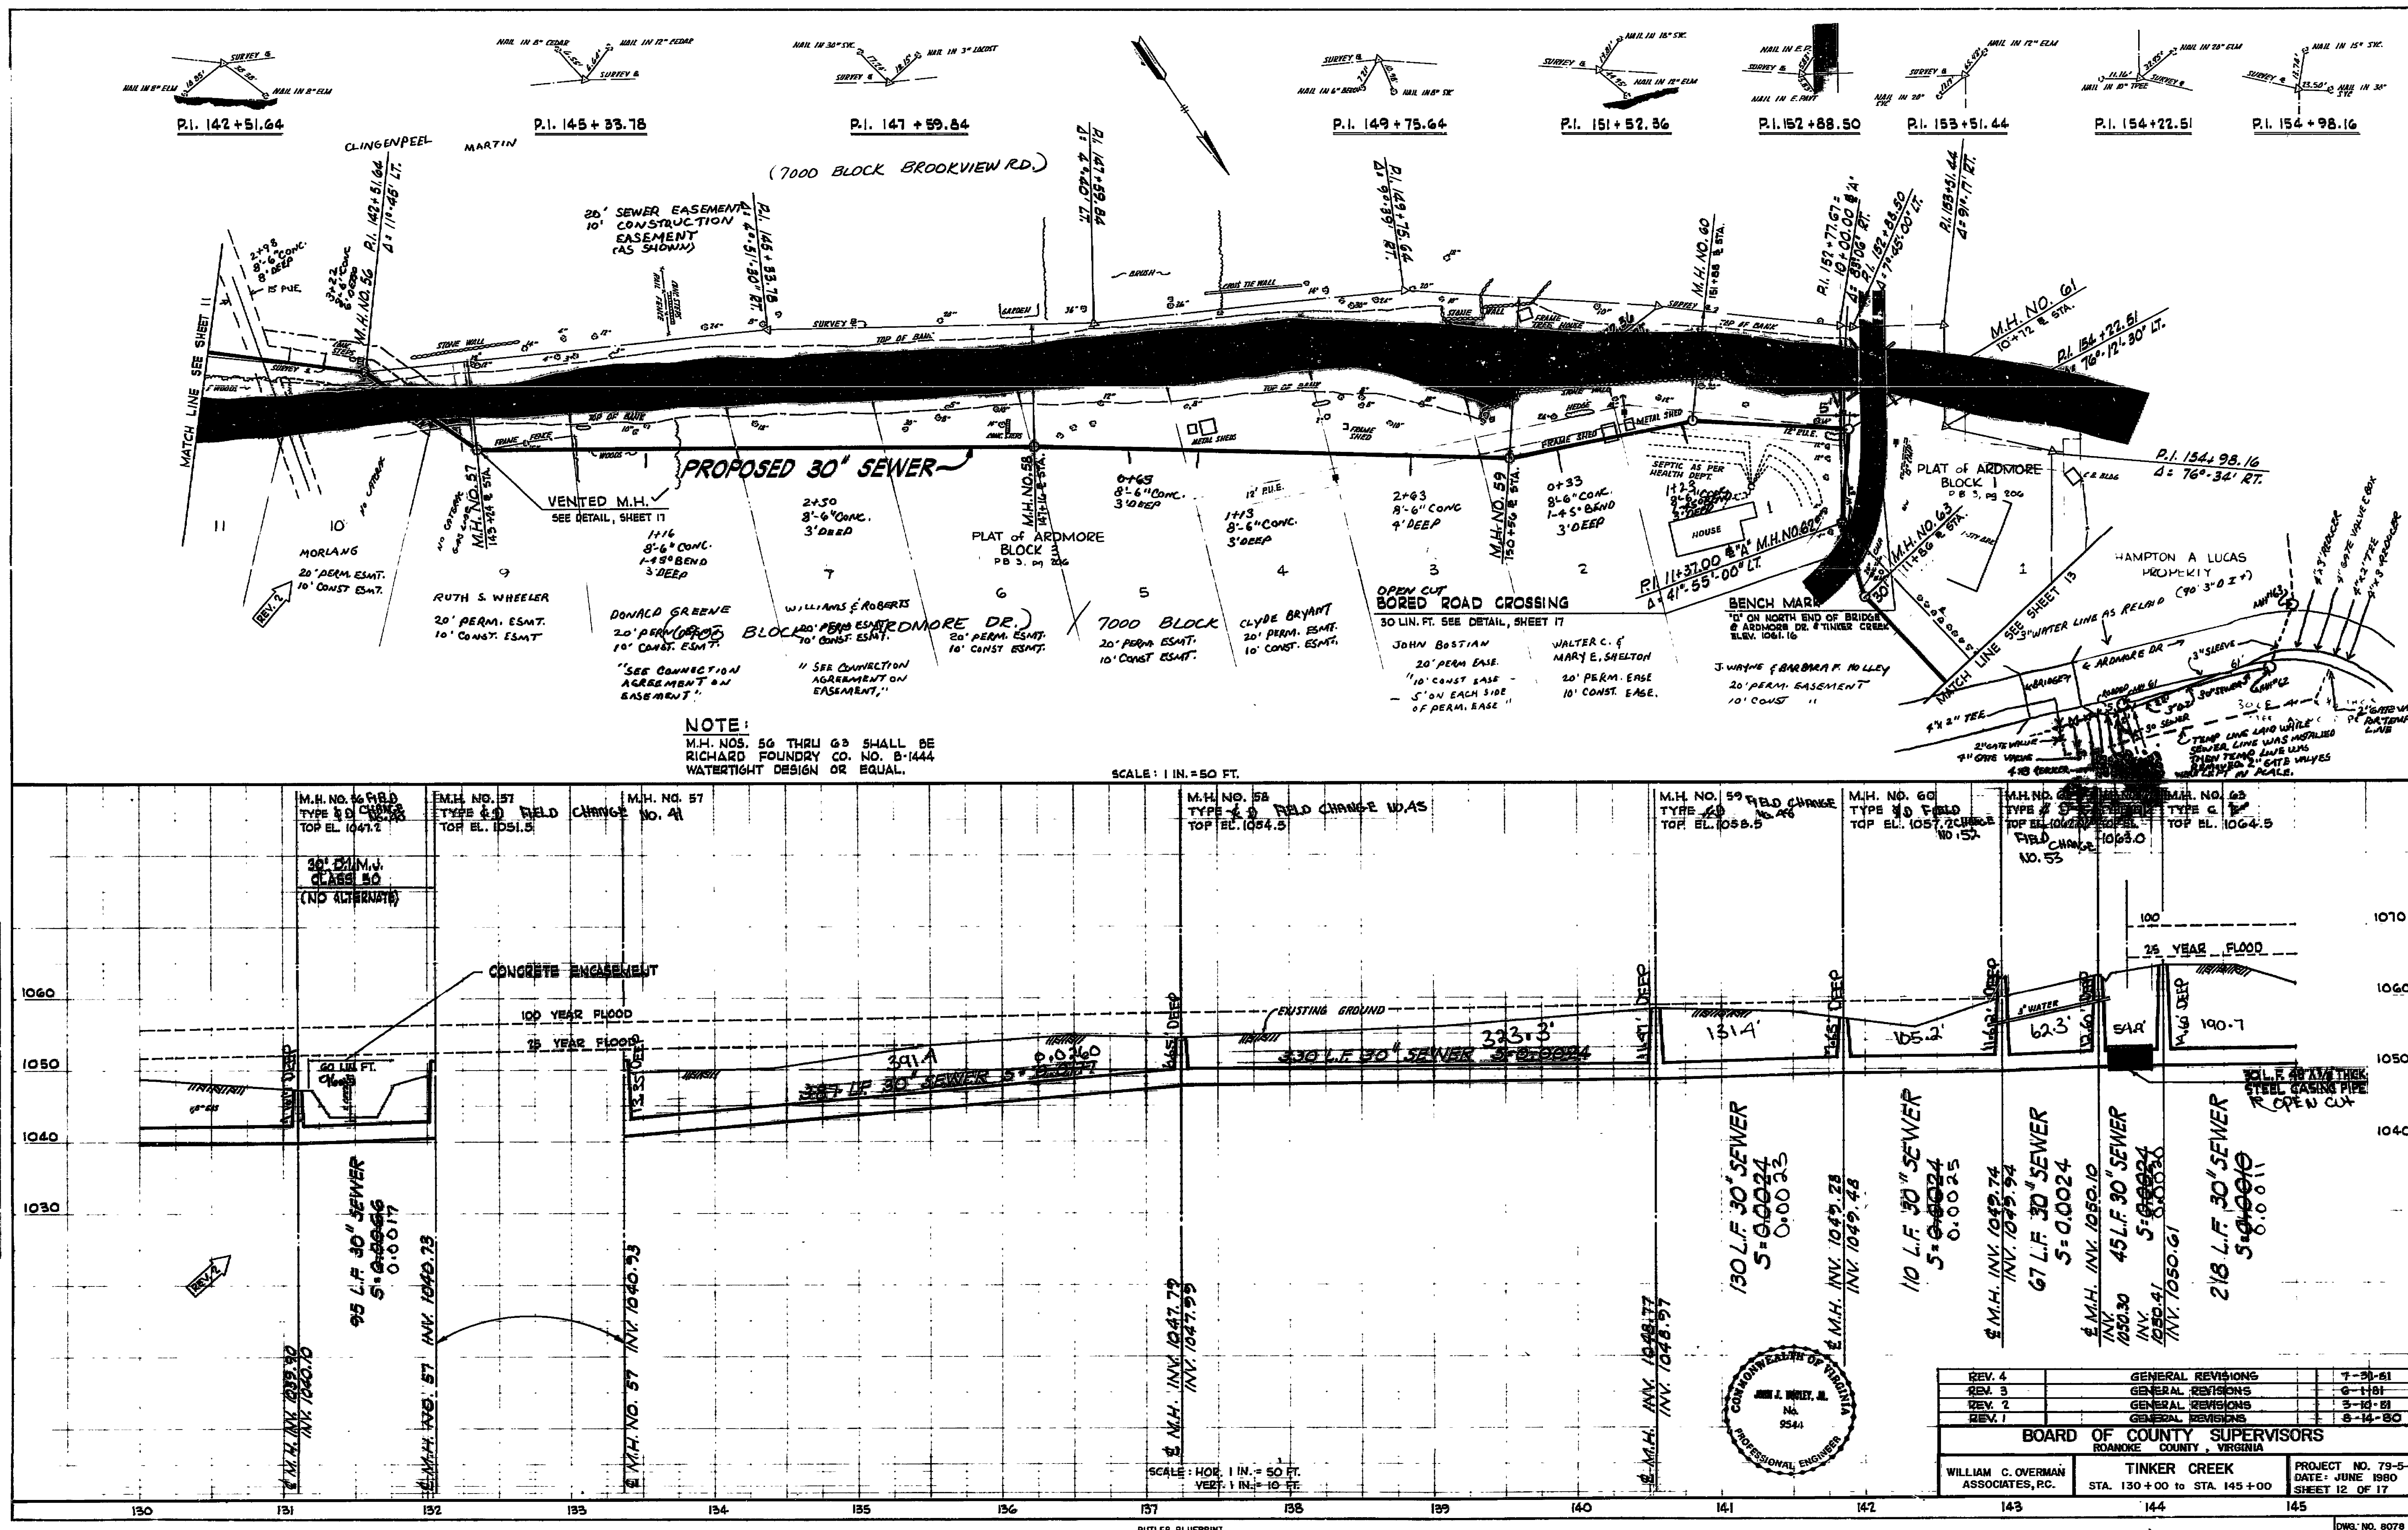

REV. 4	GENERAL REVISIONS	7-30-61
REV. 3	GENERAL REVISIONS	6-11-61
REV. 2	GENERAL REVISIONS	5-10-61
REV. 1	GENERAL REVISIONS	8-14-60

BOARD OF COUNTY SUPERVISORS	
ROANOKE COUNTY, VIRGINIA	
WILLIAM C. OVERMAN ASSOCIATES, P.C.	TINKER CREEK STA. 130+00 TO STA. 145+00
PROJECT NO. 79-5-S DATE: JUNE 1960 SHEET 12 OF 17	

Need to check
C-510535-03
SI-0088