



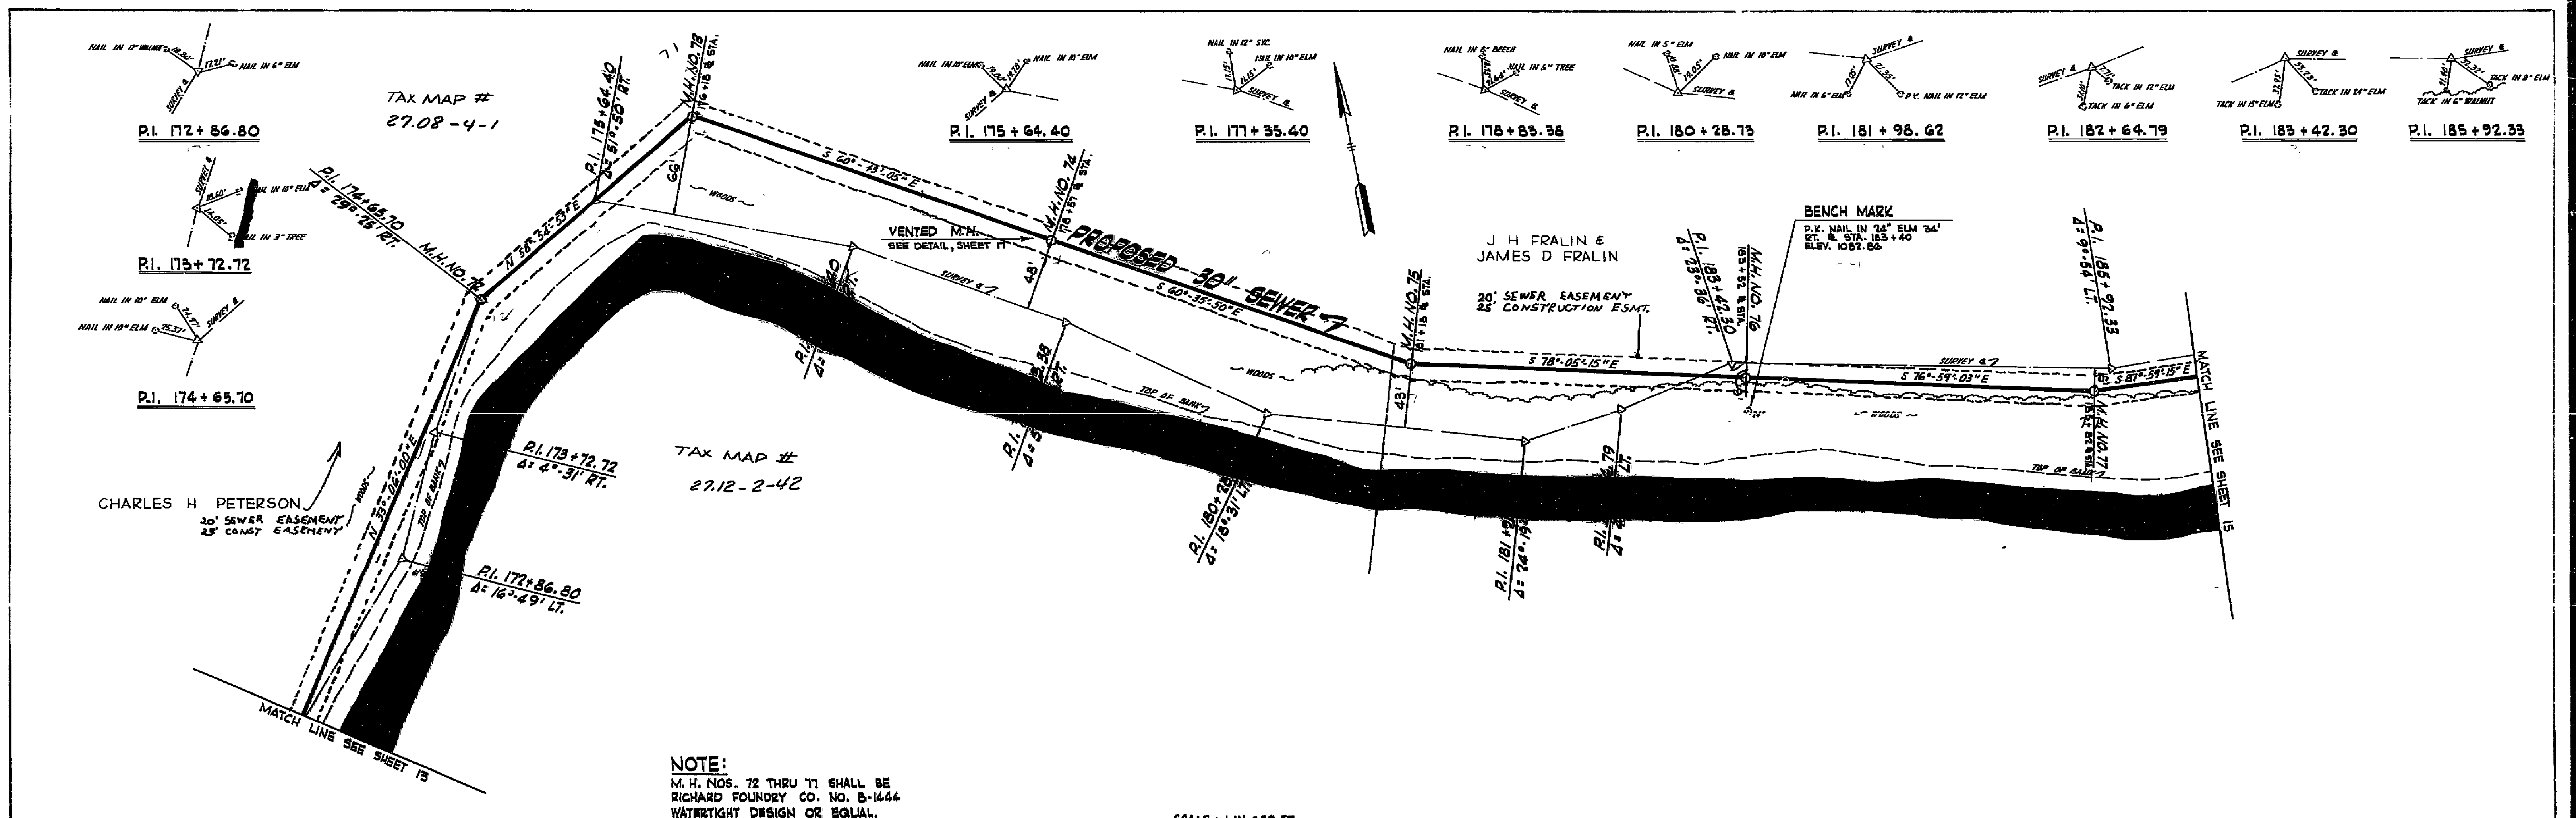

NOTE:
M.H. NOS. 72 THRU 77 SHALL BE
RICHARD FOUNDRY CO. NO. B-1444
WATERTIGHT DESIGN OR EQUAL.

SCALE: 1 IN. = 50 FT.

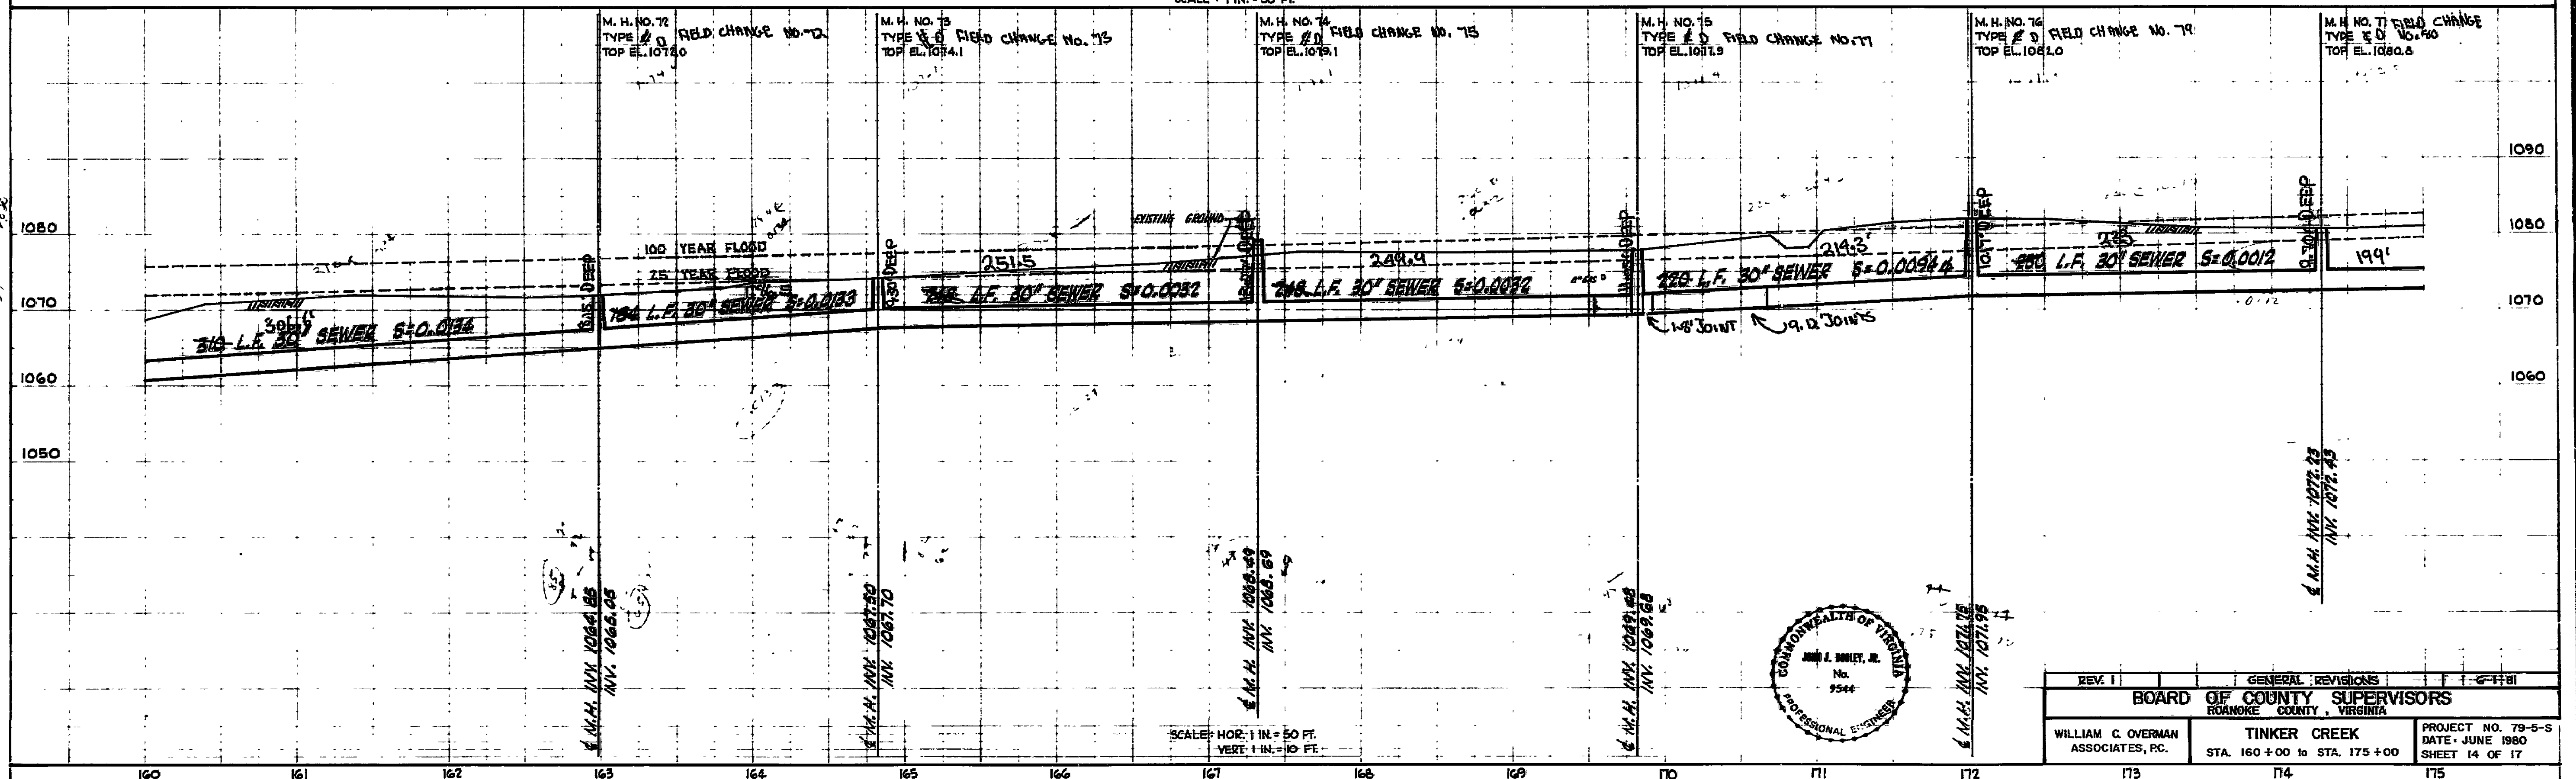

SCALE: HOR. 1 IN. = 50 FT.
VERT. 1 IN. = 10 FT.



REV.	GENERAL REVISIONS	DATE
1	1	6-11-81

BOARD OF COUNTY SUPERVISORS		
ROANOKE COUNTY, VIRGINIA		
WILLIAM C. OVERMAN ASSOCIATES, P.C.	TINKER CREEK STA. 160+00 to STA. 175+00	PROJECT NO. 79-5-S DATE: JUNE 1980 SHEET 14 OF 17

C-510535-03 SI-0090