


PLAN

NOT TO SCALE
SEE SHEET 14

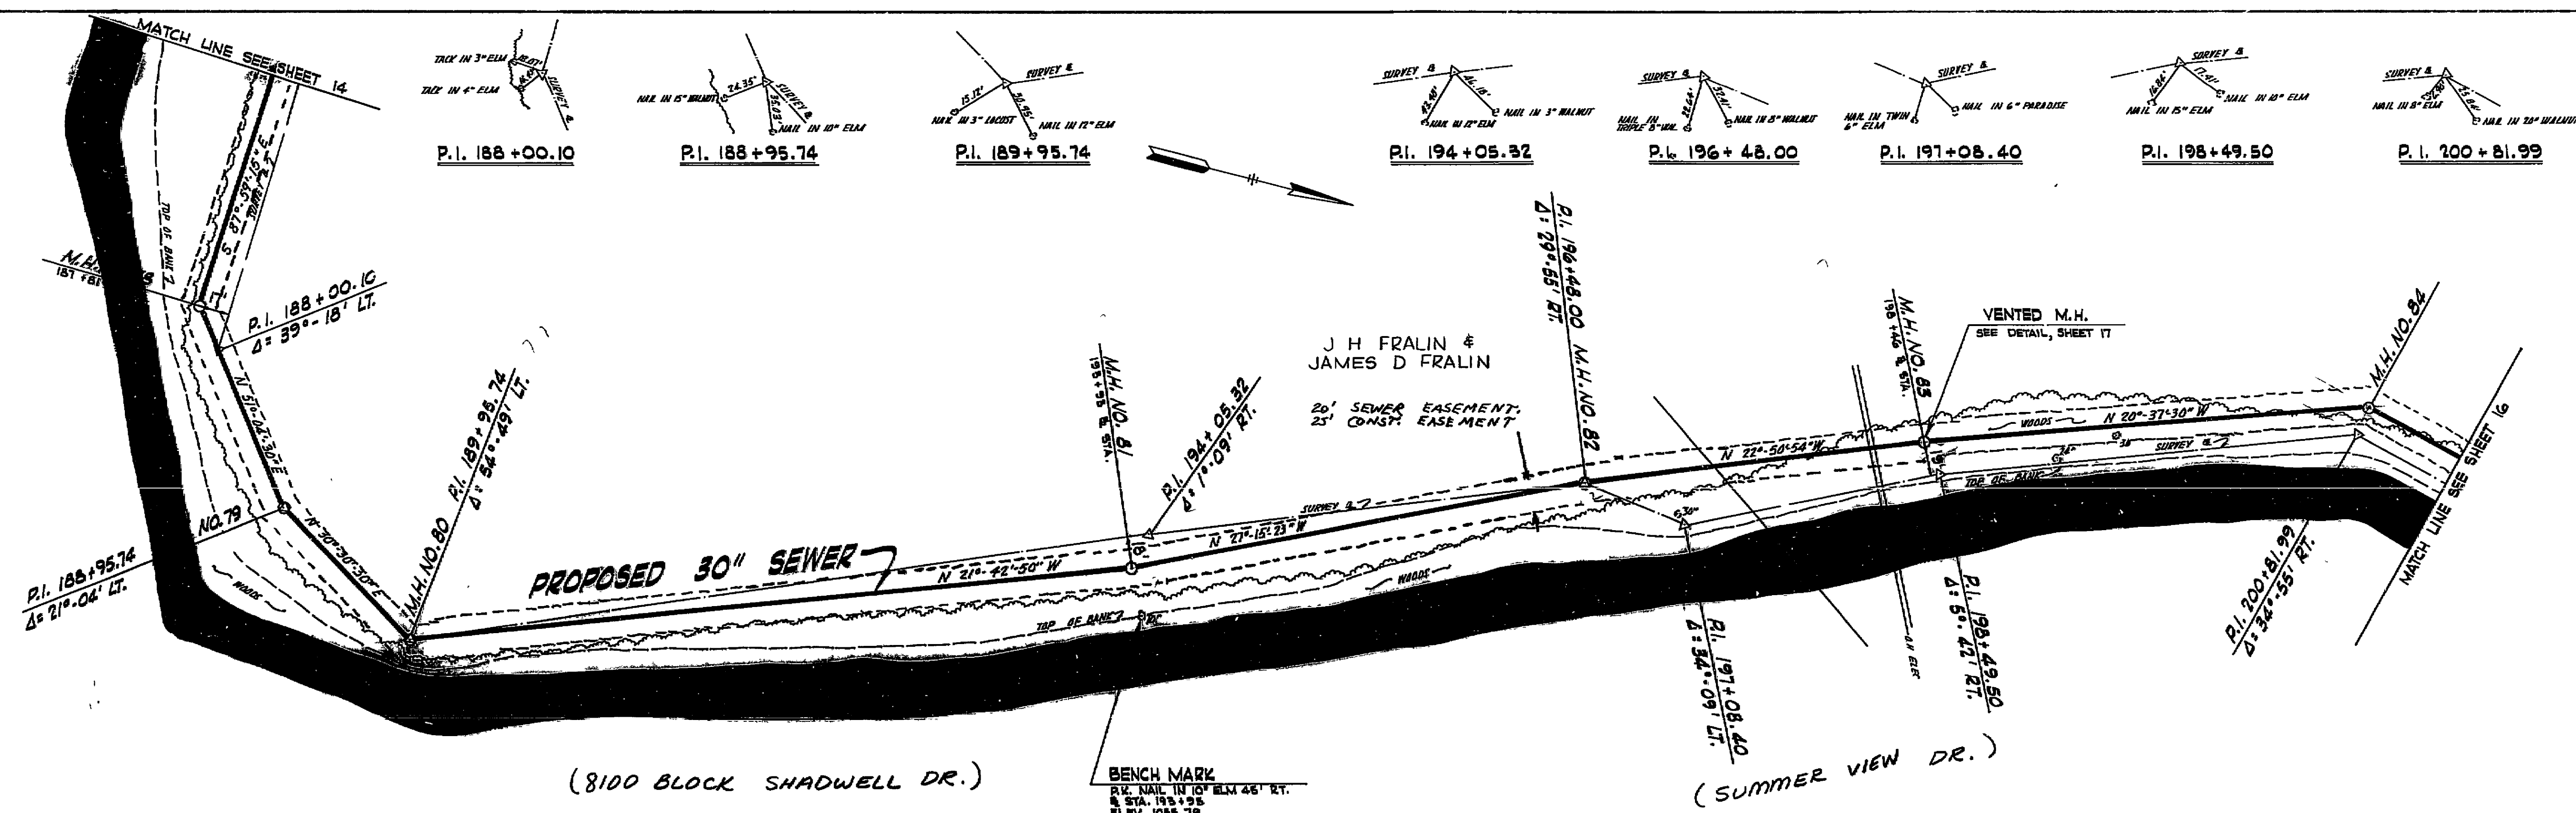


NOTE:


M.H. NOS. 78 THRU 84 SHALL BE
RICHARD FOUNDRY CO. NO. S-1444
WATERTIGHT DESIGN OR EQUAL.

SCALE: 1 IN. = 50 FT.

PROFILE
NOT TO SCALE
SEE SHEET 14

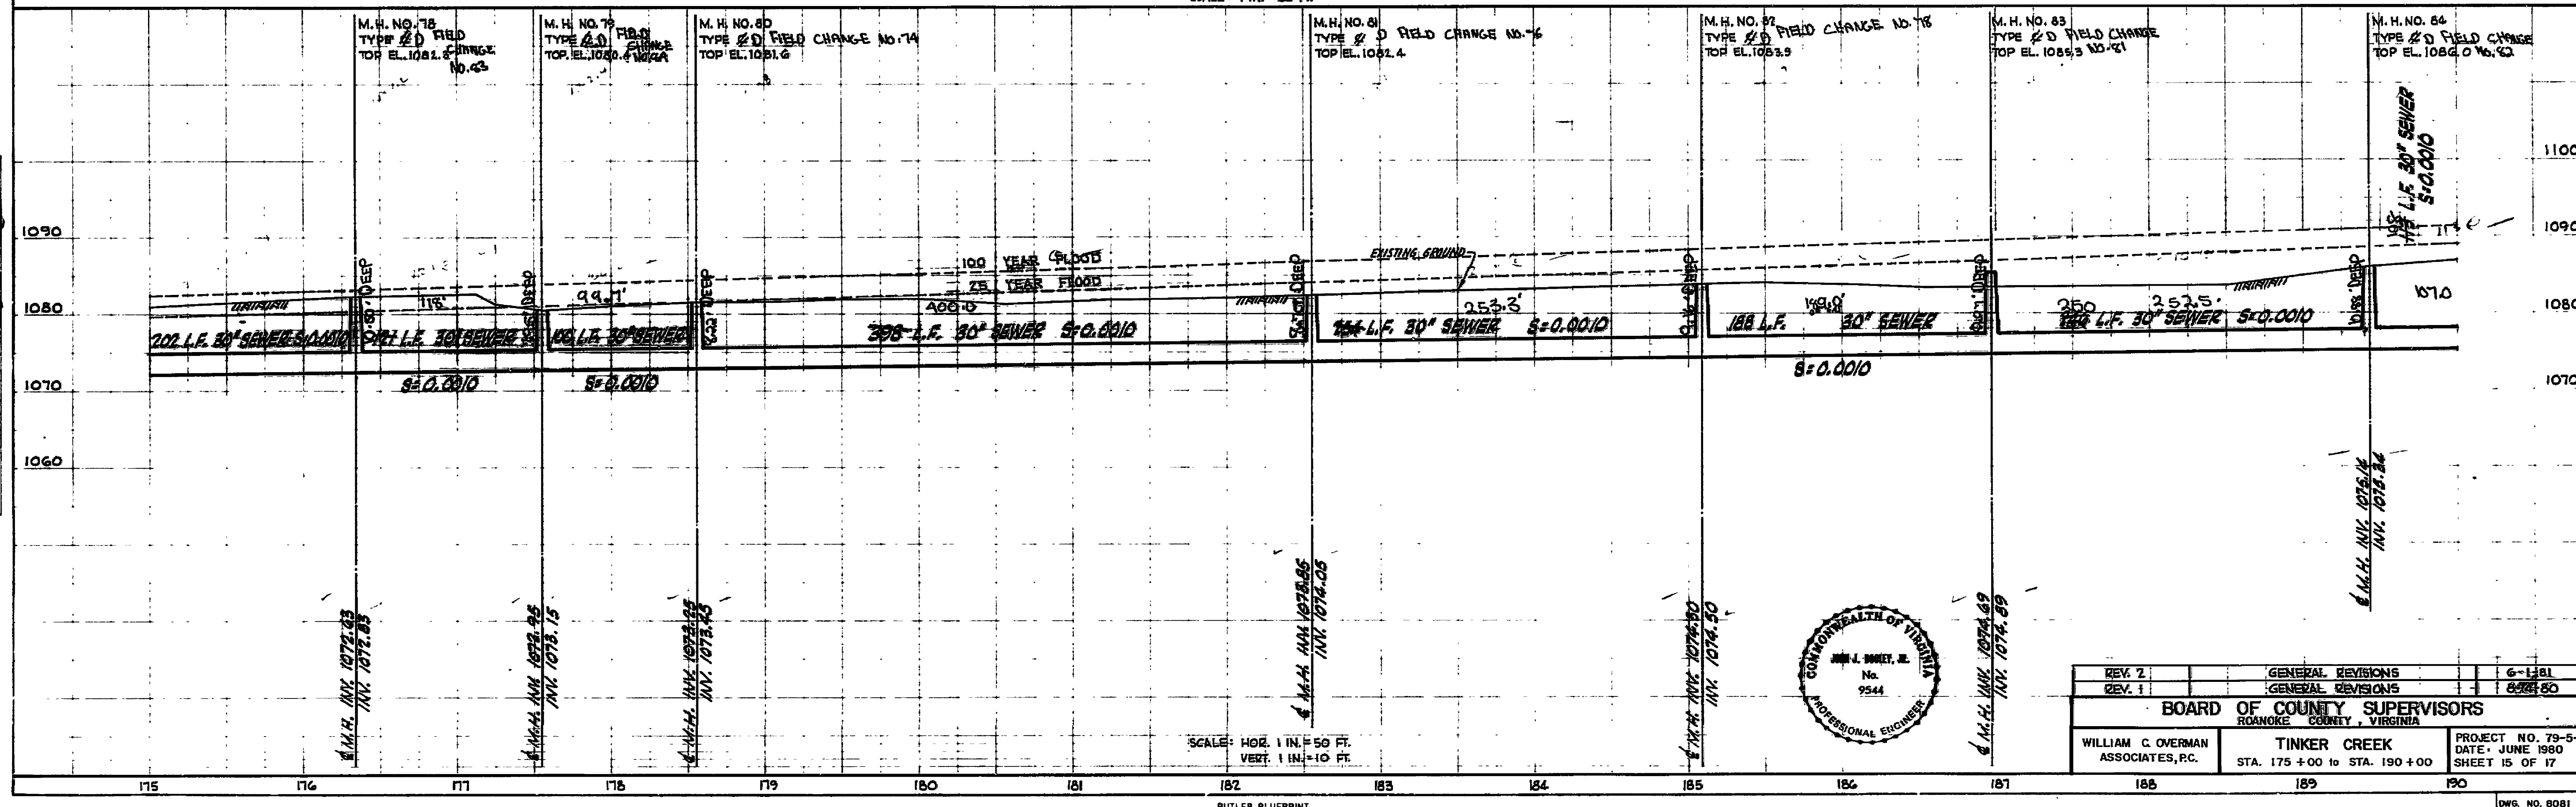

SCALE: HOR. 1 IN. = 50 FT.
VERT. 1 IN. = 10 FT.

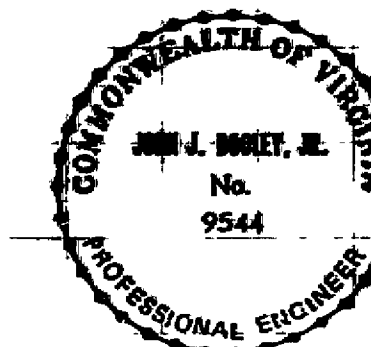

REV. 2	GENERAL REVISIONS	6-1-81
REV. 1	GENERAL REVISIONS	8-28-80
BOARD OF COUNTY SUPERVISORS ROANOKE COUNTY, VIRGINIA		
WILLIAM C. OVERMAN ASSOCIATES, P.C.	TINKER CREEK STA. 175+00 TO STA. 190+00	PROJECT NO. 79-5-S DATE: JUNE 1980 SHEET 15 OF 17
DWS. NO. 8081		

C-510535-03

SI-0091