



FILE NAME: S:\gwork\design\creek\sewer\sewer.dwg, PLOTTED: 0.000, MONITOR: 100%, YYY - HAM/ham

MANHOLE NUMBER	REQUIRED REHABILITATION/REPLACEMENT
MH 05A-3456.0	NO REHABILITATION
MH 05A-3451.0	CHIMNEY SEALANT AND INFLOW PROTECTION INSERT
MH 05A-3452.0	CHIMNEY SEALANT AND INFLOW PROTECTION INSERT
MH 05A-3453.0	CHIMNEY SEALANT AND INFLOW PROTECTION INSERT
MH 05A-3454.0	MANHOLE REHABILITATION AND INFLOW PROTECTION INSERT
MH 05A-3450.0	REBUILD BENCH AND CHANNEL, CHIMNEY SEALANT AND INFLOW PROTECTION INSERT
MH 05A-3449.0	REBUILD BENCH AND CHANNEL, CHIMNEY SEALANT AND INFLOW PROTECTION INSERT
MH 05A-3448.0	REBUILD BENCH AND CHANNEL, CHIMNEY SEALANT AND INFLOW PROTECTION INSERT

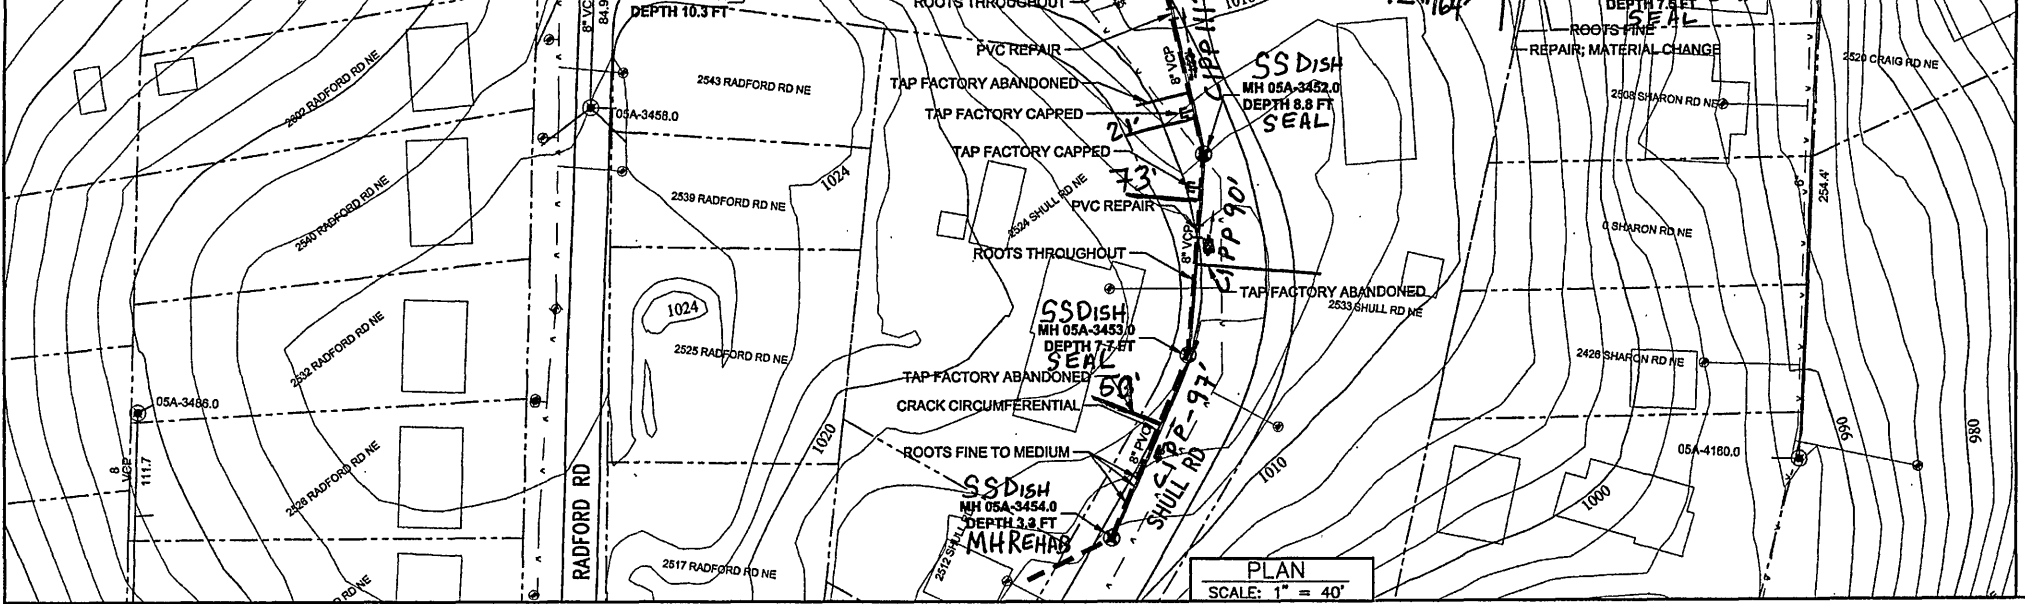


- NOTES:
1. ALL SEWER LINES WILL BE REHABILITATED USING CURED-IN-PLACE PIPE (CIPP) OR FOLD AND FORM.
 2. ALL POINT REPAIRS SHALL BE LINED THROUGH.
 3. CONTINUOUS SEWAGE FLOW MUST BE MAINTAINED AT ALL TIMES. FLOW-THROUGH PLUGS WILL BE ACCEPTABLE. CONTRACTOR IS RESPONSIBLE FOR BY-PASS PUMPING.
 4. REFER TO SHEET G-5 FOR TRAFFIC CONTROL.
 5. ALL ACTIVE SEWER SERVICE CONNECTIONS SHALL BE REINSTATED.
 6. ALL ABANDONED/CAPPED SEWER SERVICE CONNECTIONS SHALL NOT BE REINSTATED.
 7. NO SURVEY HAS BEEN PERFORMED. LOCATION OF ALL UTILITY INFORMATION ON THE PLANS IS FROM WESTERN VIRGINIA WATER AUTHORITY GIS.

MANHOLE NUMBER	REQUIRED REHABILITATION/REPLACEMENT
MH 05A-3479.0	CHIMNEY SEALANT AND INFLOW PROTECTION INSERT
MH 05A-3478.0	CHIMNEY SEALANT AND INFLOW PROTECTION INSERT

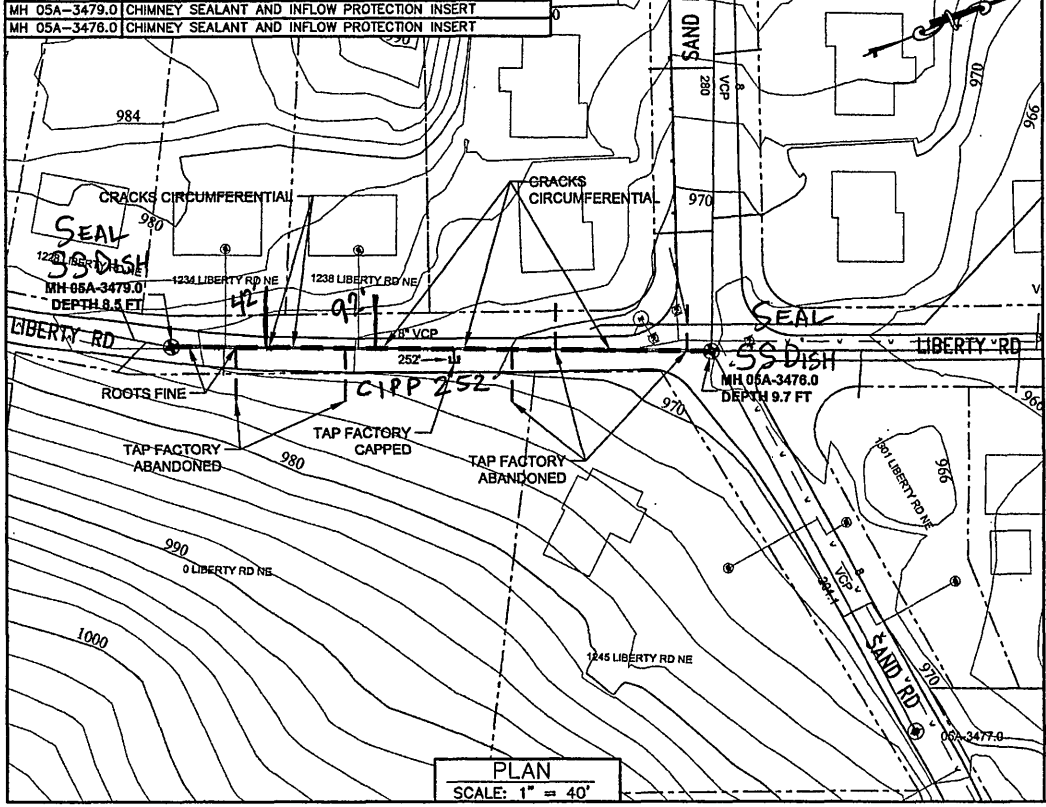

MANHOLE NUMBER	REQUIRED REHABILITATION/REPLACEMENT
MH 05A-3291.0	CHIMNEY SEALANT AND INFLOW PROTECTION INSERT
MH 05A-3290.0	CHIMNEY SEALANT AND INFLOW PROTECTION INSERT

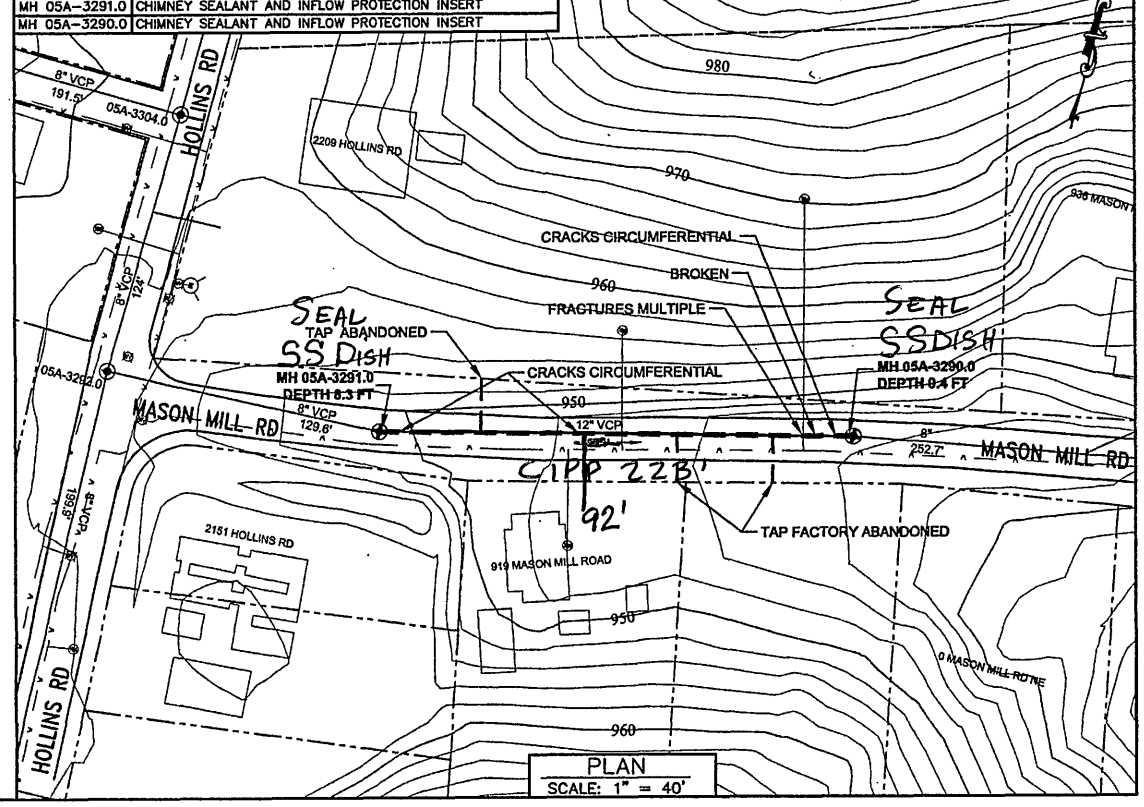



WESTERN VIRGINIA
WATER AUTHORITY

As-Built

TINKER CREEK SEWER REHABILITATION

LIBERTY ROAD, MASON MILL ROAD, AND SHULL ROAD

DATE: DECEMBER 2011

JOB NO.: 11658086

LEAD ENGINEER: tkj

DRAWN BY: wlj

CHECKED: tkf

REVISION:

C-1

SHEET 6 OF 9